

IDAHO

DEPARTMENT OF ENVIRONMENTAL QUALITY



**HWMA STORAGE and
TREATMENT PERMIT for the
IDAHO NUCLEAR TECHNOLOGY and
ENGINEERING CENTER and the
RADIOACTIVE WASTE MANAGEMENT
COMPLEX**

on the

IDAHO NATIONAL LABORATORY

EPA ID NO. ID4890008952

Effective Date: April 27, 2009

Revision Date: December 20, 2019

Book 2 of 3

HWMA/RCRA PART B PERMIT
FOR THE IDAHO NATIONAL LABORATORY

Volume 18 – Idaho Nuclear Technology and Engineering Center

APPENDIX 1

Debris Treatment Processes
Holdup and Collection Tanks
CPP-659/-1659 Storage
CPP-666 FDP Cell Container Storage and Slab Tank Storage
Other Miscellaneous Treatment Processes
RMWSF (CPP-1617) Container Storage Area and CPP-2725

FACILITY PHOTOGRAPHS

Revision Date: March 29, 2017

PHOTOGRAPH LIST

Page Number	Photo Number	Description of Photo
1	PN-96-98-1-5	CPP-1659 Exterior Looking North East
2	PN-96-98-1-0	Vehicle Entry CPP-659 Room 417 Looking East
3	PN-99-0082-1-15	Decontamination Sinks Enclosure CPP-659 Looking South East
4	PN-99-0082-1-17	Decontaminations Sinks Enclosure CPP-659 Room 415 Looking East
5	PN-99-0082-1-24	Entrance into Decontamination Sinks Enclosure CPP-659 Room 415 Looking East
6	PN-96-243-1-30	Decontamination Sinks CPP-659 Room 415 Looking South East
7	PN-96-243-1-35	Interior Decontamination Sinks Enclosure CPP-659 Room 415 Looking South
8	PN-96-243-1-31	Ultrasonic Cleaner Sink CPP-659 Room 415 Looking South
9	PN-96-98-2-28	Low-Level Decontamination Shielded Storage CPP-659 Room 415 Looking South
10	PN-99-0082-1-25	Curb Around Chemical Make-up Tanks CPP-659 Room 415 Looking North West
11	No Photo Number Available	VAC PAC (w/o Head and Hose)
12	PN-96-0098-2-17	Exterior Steam Spray Booth (w/o Glove Box) CPP-659 Room 418 Looking North West
13	PN-96-243-1-12	Interior Steam Spray Booth (w/o False Floor) CPP-659 Room 418 Looking South
14	PN-99-0082-1-3	Exterior Steam Spray Booth (w/Glove Box) CPP-659 Room 418 Looking North West
15	PN-99-0082-1-10	Interior Steam Spray Booth w/False Floor) CPP-659 Room 418 Looking South

Page Number	Photo Number	Description of Photo
16	PN-99-0082-1-7	Glove Box CPP-659 Room 418 Looking North West
17	PN-99-0082-1-8	Glove Box CPP-659 Room 418 Looking South West
18	PN-81-4767	Valve Cubicle CPP-659 Looking West
19	PN-96-98-1-19	Filter Cell CPP-659 Looking South
20	PN-81-4278	CPP-659 Room 308 Overhead Crane and Room 323 Hatch Covers Looking East
21	PN-82-5127	Looking at a transfer into CPP-659 Room 309 from the Crane Maintenance and Transfer Area Room 323
22	PN-96-85-1-12	CPP-659 HEPA Filter Leaching System Room 309 Looking South
23	PN-82-5131	CPP-659 Room 308 Decontamination Cell Looking West
24	PN-96-98-1-7	CPP-666 FAST Building Exterior Looking South East
25	PN-96-84-1-9	CPP-666 FDP Cell Container Storage -13'-0' Level Looking East
26	1617-16	RMWSF Main Gate CPP-1617 Storage Area Looking South
27	1617-01	RMWSF Inside CPP-1617 Temporary Structure Looking East
28	1617-11	RMWSF Mixed Waste Storage Boxes Paved Area Looking North East
29	98-546-2-2	RMWSF High Radiation Storage Area with Radioactive and Mixed Waste Boxes (with covers) Paved Area Looking East
30	1617-14	RMWSF Cargo Containers Paved Area Looking North
31	89-566-1-15	RMWSF CPP-1617 Exterior Looking North East
32	1617-07	RMWSF CPP-1617 Building Looking North West

Page Number	Photo Number	Description of Photo
33	95-1015-1-8	RMWSF Interior Cargo Container, Drip Pan, Inspector, and Liquid Waste Electric Base Board Heater Lower Left Looking West
34	1617-09	RMWSF Heated Cargo Containers Paved Area Looking South West
35	ILTSF 003.jpg	External View of an Interim Storage Container
36	ILTSF 001.jpg	View of Empty Interim Storage Container
37	ILTSF 005.jpg	Example of Shielded Overpack Container
38	Not Available (N/A)	RH TRU Cask Loading Platform
39	N/A	RH TRU Removable Lid Container (RLC) Inspection Stand (empty)
40	N/A	RH TRU Cask Loading and RLC Inspection Areas
41	N/A	RH TRU View of Overhead Crane
42	N/A	RH TRU RLC Inspection Station with Empty RLC
43	N/A	RH TRU RLC with Lid Removed and Placed on Lid Inspection Stand
44	N/A	RH TRU Personnel Operating Station
45	N/A	RH TRU Lag Storage Rack
46	N/A	RH TRU Cask Storage Rack and Impact Limiter Staging Stand (both empty)
47	N/A	RH TRU Funnel for Loading Inserts into Casks
48	N/A	RH TRU Transport Trailer with 72B Shipping Cask
49	N/A	RH TRU Decon Cell with Repackaged Drum

Page Number	Photo Number	Description of Photo
50	N/A	RH TRU Decon Cell with Turntable/Sorting Table with Downdraft Repackage Waste Container
51	N/A	RH TRU Crane Maintenance and Transfer Area (Room 323)
52	N/A	RH TRU Real-Time Radiography (RTR) Access Port into Room 306
53	N/A	RH TRU RTR Equipment
54	N/A	RH TRU Decontamination Access Tent into Remote Decon Cell (Room 308)
55	N/A	RH TRU Port Cover over Remote Decon Cell (Room 308) located in Decontamination Access Tent
56	N/A	RH TRU Shielded Operating Area in the Equipment Decon Room
57	N/A	RH TRU Equipment Decon Room (418) Overpack Area - 55-gallon Waste Drum
58	N/A	Argon Repackaging Station (ARS) unit for use in CPP-659 Room 308
59	N/A	ARS unit showing a lexan wall with a drum out port. The wall is replaceable with either a wall with a drum out port or a solid wall. The ARS unit will be installed in CPP-659, Room 308
60	N/A	ARS 1 unit prior to installation into the CPP-666 FDP Cell
61	N/A	ARS 2 unit prior to installation into the CPP-666 FDP Cell
62	N/A	ARS 2 unit with empty waste containers prior to installation into the CPP-666 FDP Cell

Page Number	Photo Number	Description of Photo
63	20161201_140323	Interior of Building CPP-2725 looking North
64	20161201_140445	Exterior of Building CPP-2725 from the South
65	20161201_140618	Exterior of Building CPP-2725 from the Southwest corner



CPP-1659 Exterior
Looking North East

PN-96-98-1-5



Vehicle Entry
CPP-659 Room 417
Looking East

PN-96-98-1-0



Decontamination Sinks Enclosure
CPP-659
Looking South East

PN 99-0082-1-15



Decontamination Sinks Enclosure
CPP-659 Room 415
Looking East

PN-99-0082-1-17



Entrance into Decontamination Sinks Enclosure
CPP-659 Room 415
Looking East

PN-99-0082-1-24



Decontamination Sinks
CPP-659 Room 415
Looking South East

PN-96-243-1-30



Interior Decontamination Sinks Enclosure
CPP-659 Room 415
Looking South

PN-96-243-1-35




Ultrasonic Cleaner Sink
CPP-659 Room 415
Looking South

PN-96-243-1-31




Low-Level Decontamination Shielded Storage
CPP-659 Room 415
Looking South

PN-96-96-2-28

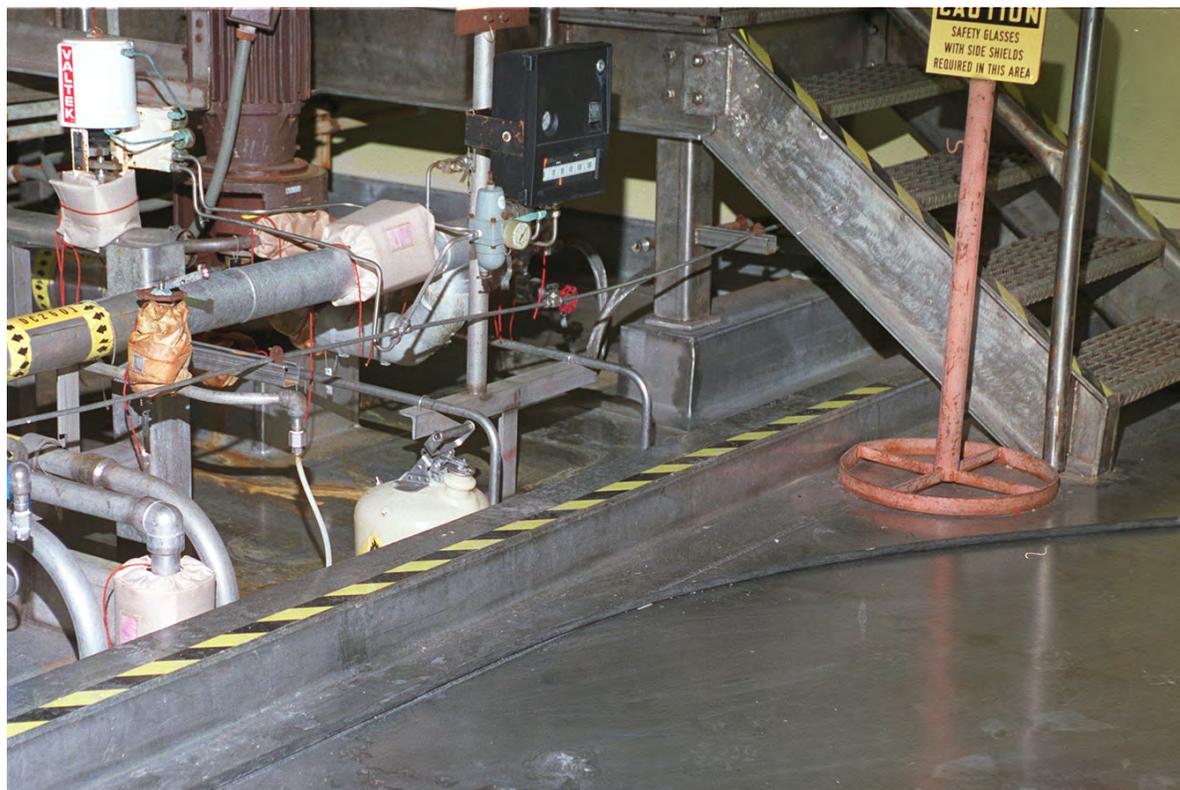

Curb Around Chemical Make-up Tanks
CPP-659 Room 415
Looking North West

PN-99-0082-1-25

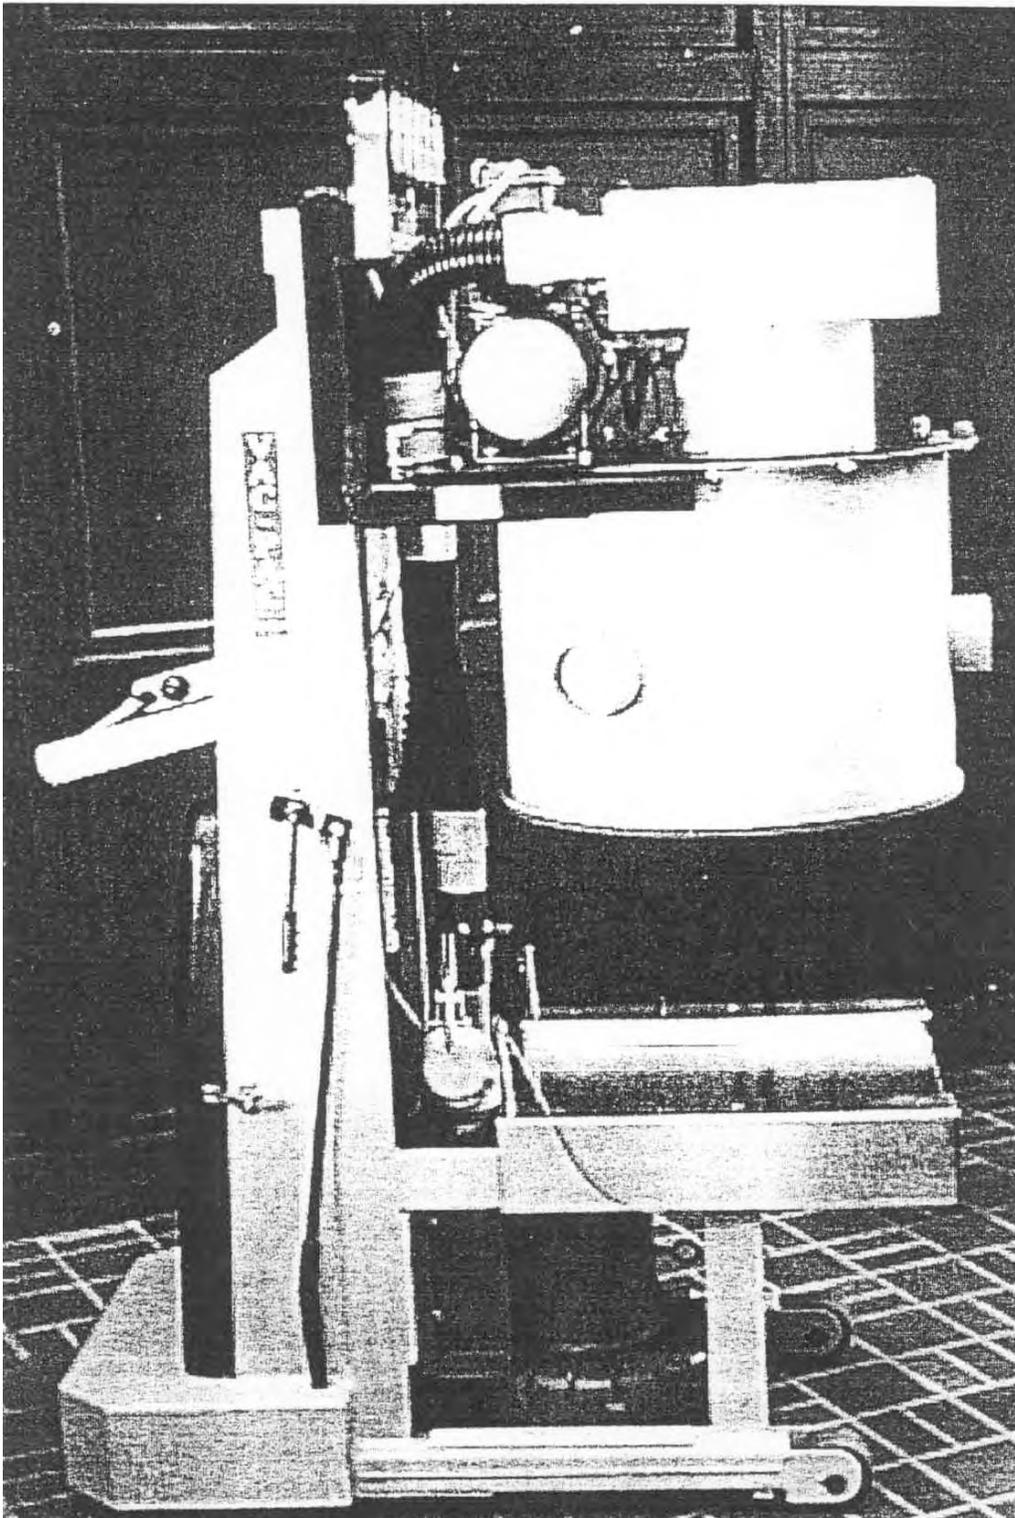

VAC PAC System (w/o Head and Hose)

(Photocopy)



Exterior Steam Spray Booth (w/o Glove Box)
CPP-659 Room 418
Looking North West

PN-96-0098-2-17



Interior Steam Spray Booth (w/o false floor)
CPP-659 Room 418
Looking South

PN-96-243-1-12



Exterior Steam Spray Booth (w/Glove Box)
CPP-659 Room 418
Looking North West

PN-99-0082-1-3




Interior Steam Spray Booth (w/False floor)
CPP-659 Room 418
Looking South

PN-99-0082-1-10



Glove Box
CPP-659 Room 418
Looking North West

PN-99-0082-1-7

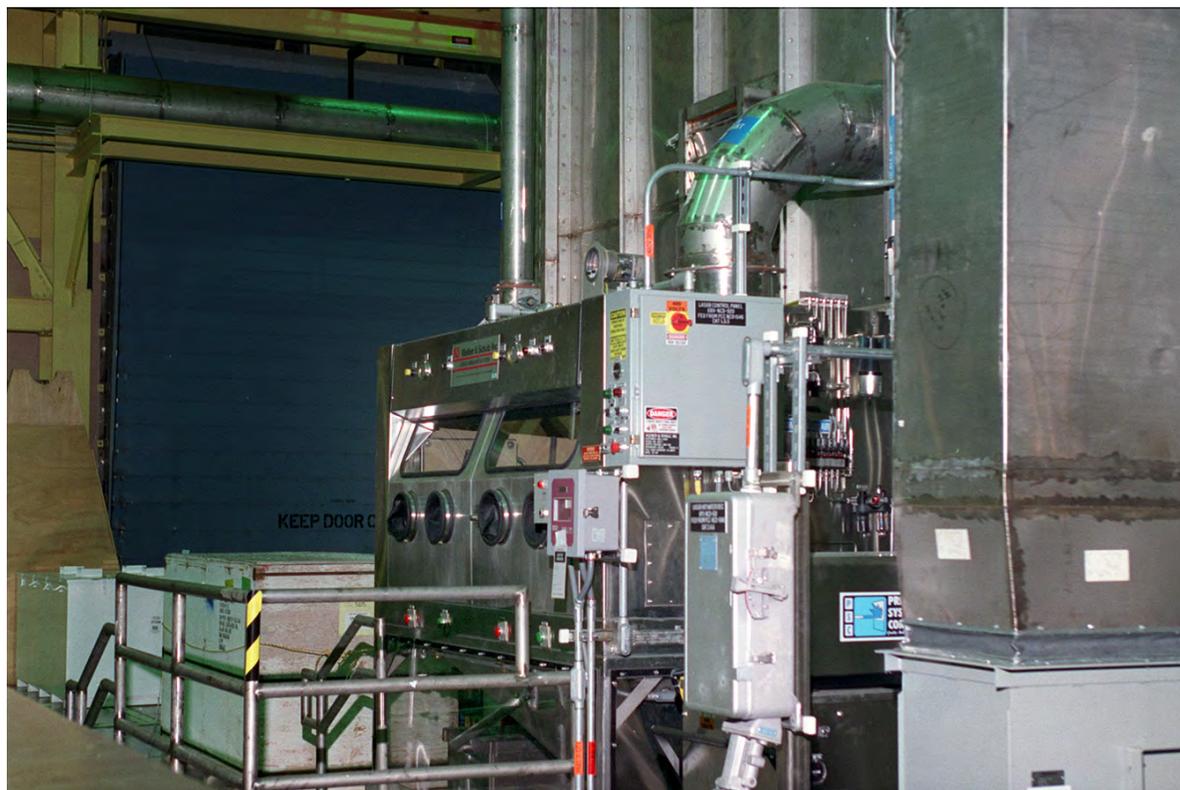


Glove Box
CPP-659 Room 418
Looking South West

PN-99-0082-1-8



Valve Cubicle
CPP-659
Looking West
PN-81-4767

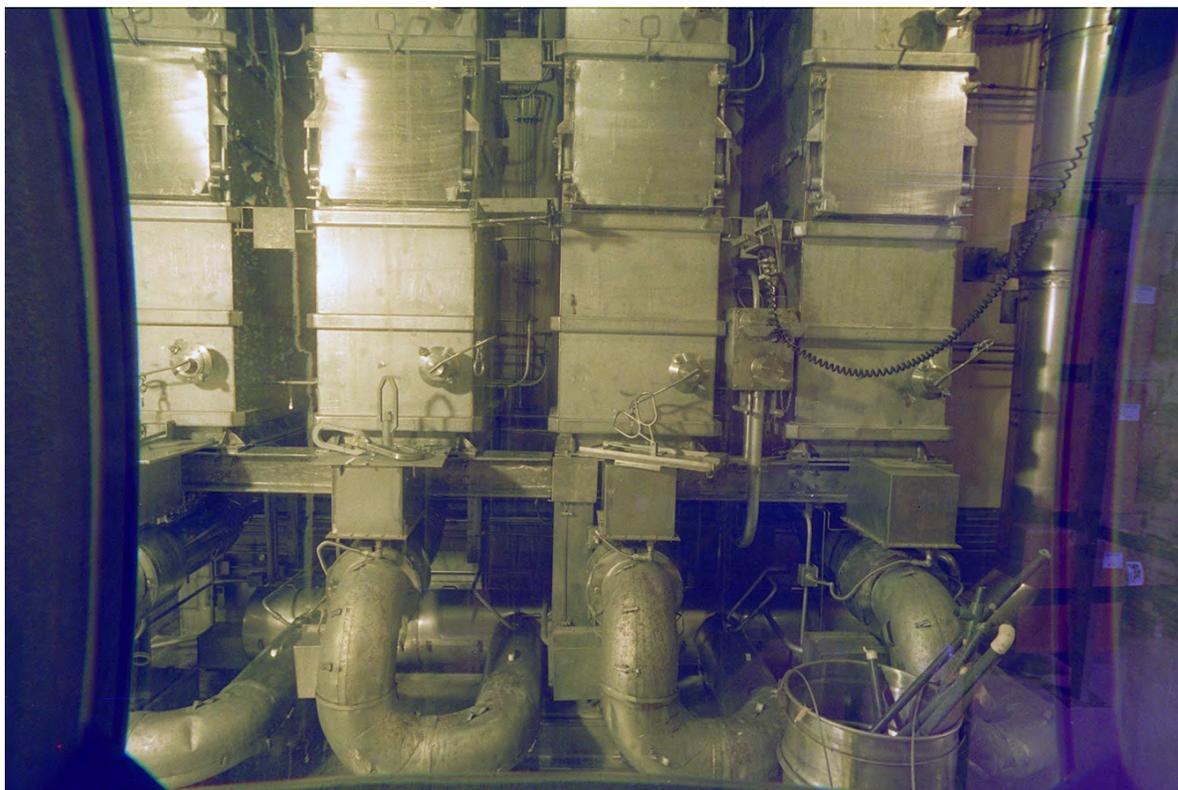


Filter Cell
CPP-659
Looking South

PN-96-98-1-19




CPP-659 Room 308 Overhead Crane and Room 323 Hatch Covers
Looking East

PN-81-4278

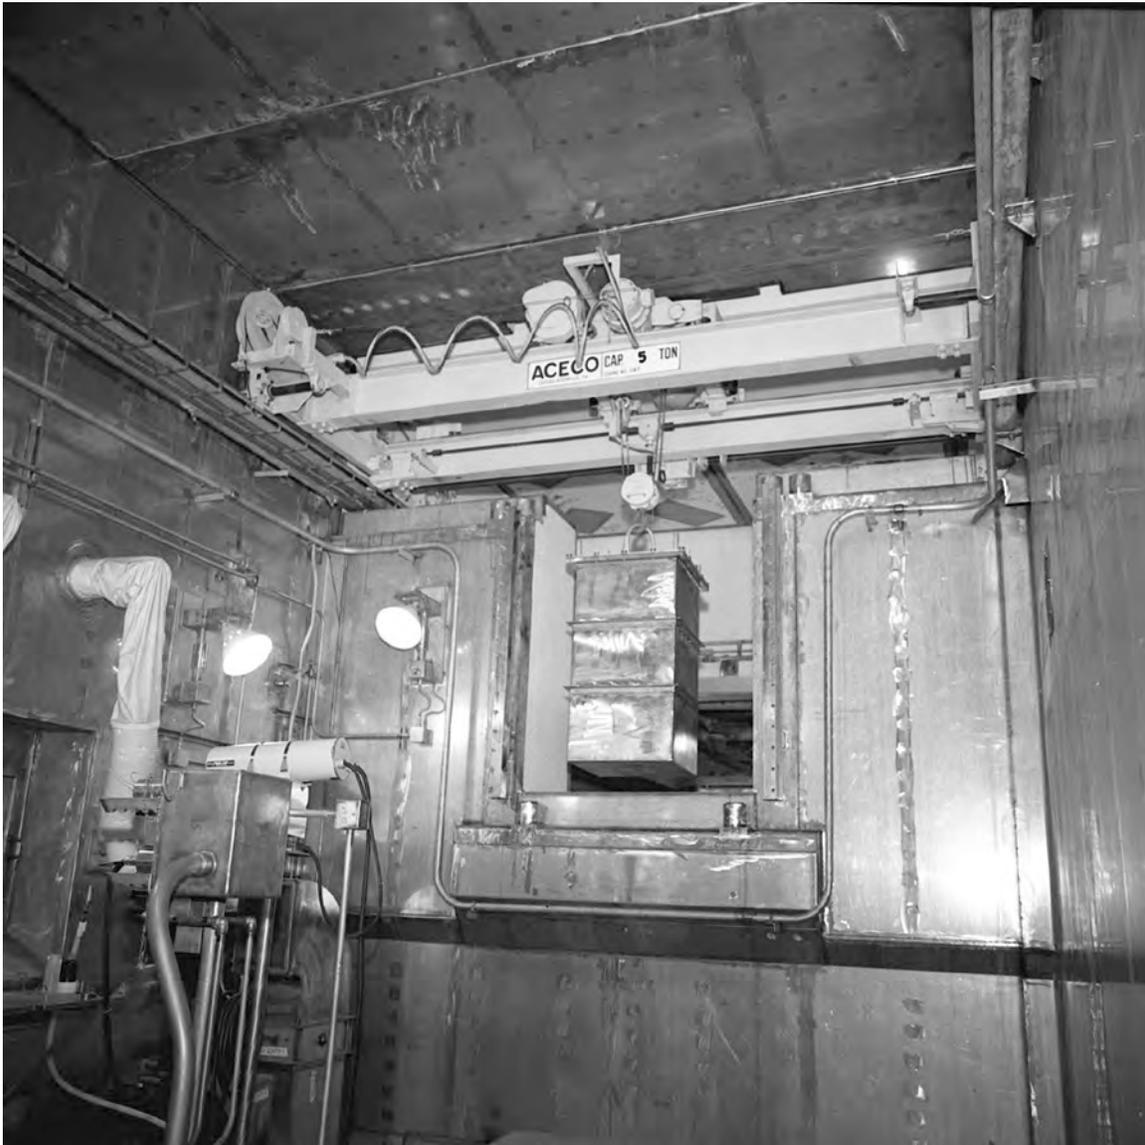


Looking at a transfer into CPP-659 Room 308
from the Crane Maintenance and Transfer Area Room 323

PN-82-5127

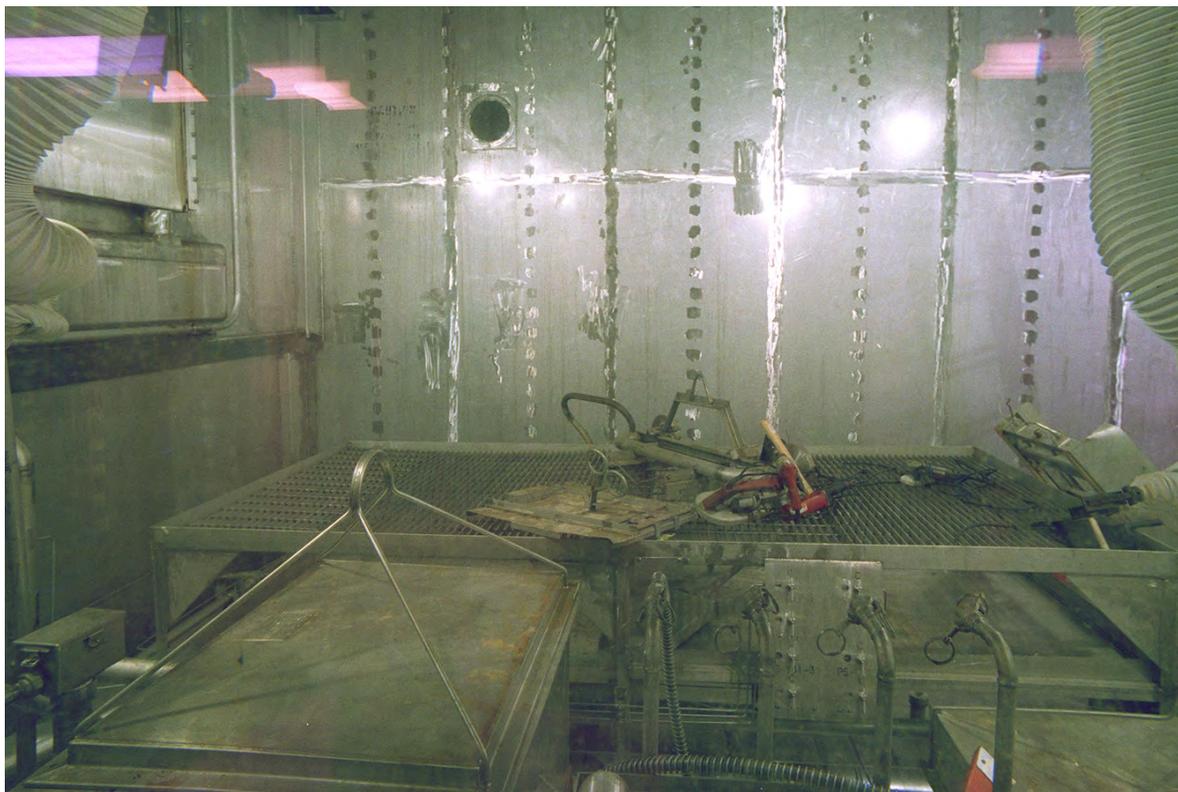

CPP-659 HEPA Filter Leaching System
Room 309
Looking South

PN-96-85-1-12

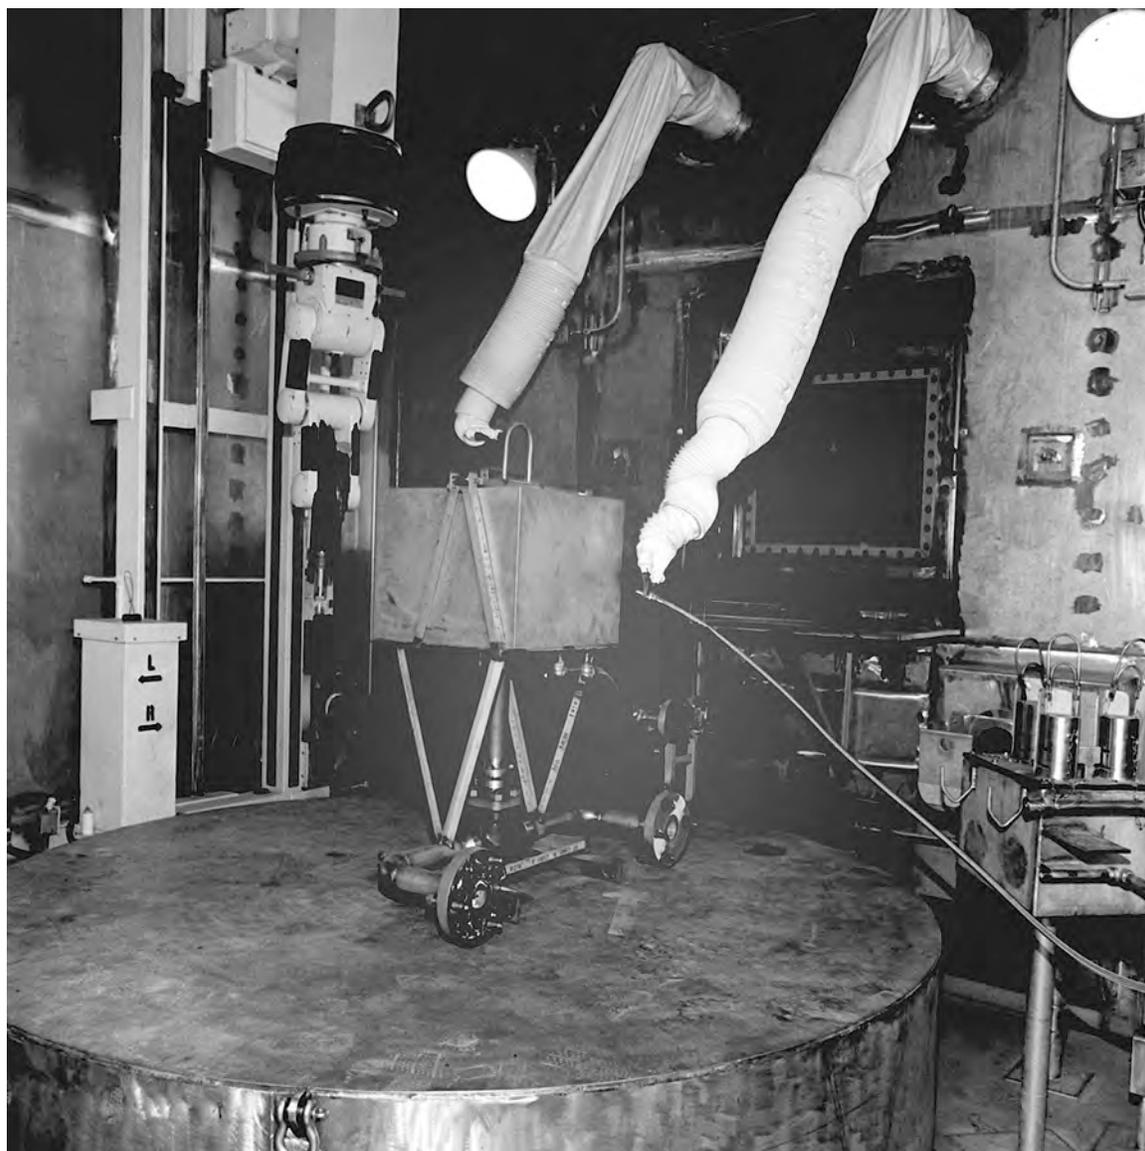


CPP-659 Room 308
Decontamination Cell
Looking West

PN-82-5131



CPP-666 FAST Building Exterior
Looking South East

PN-96-98-1-7

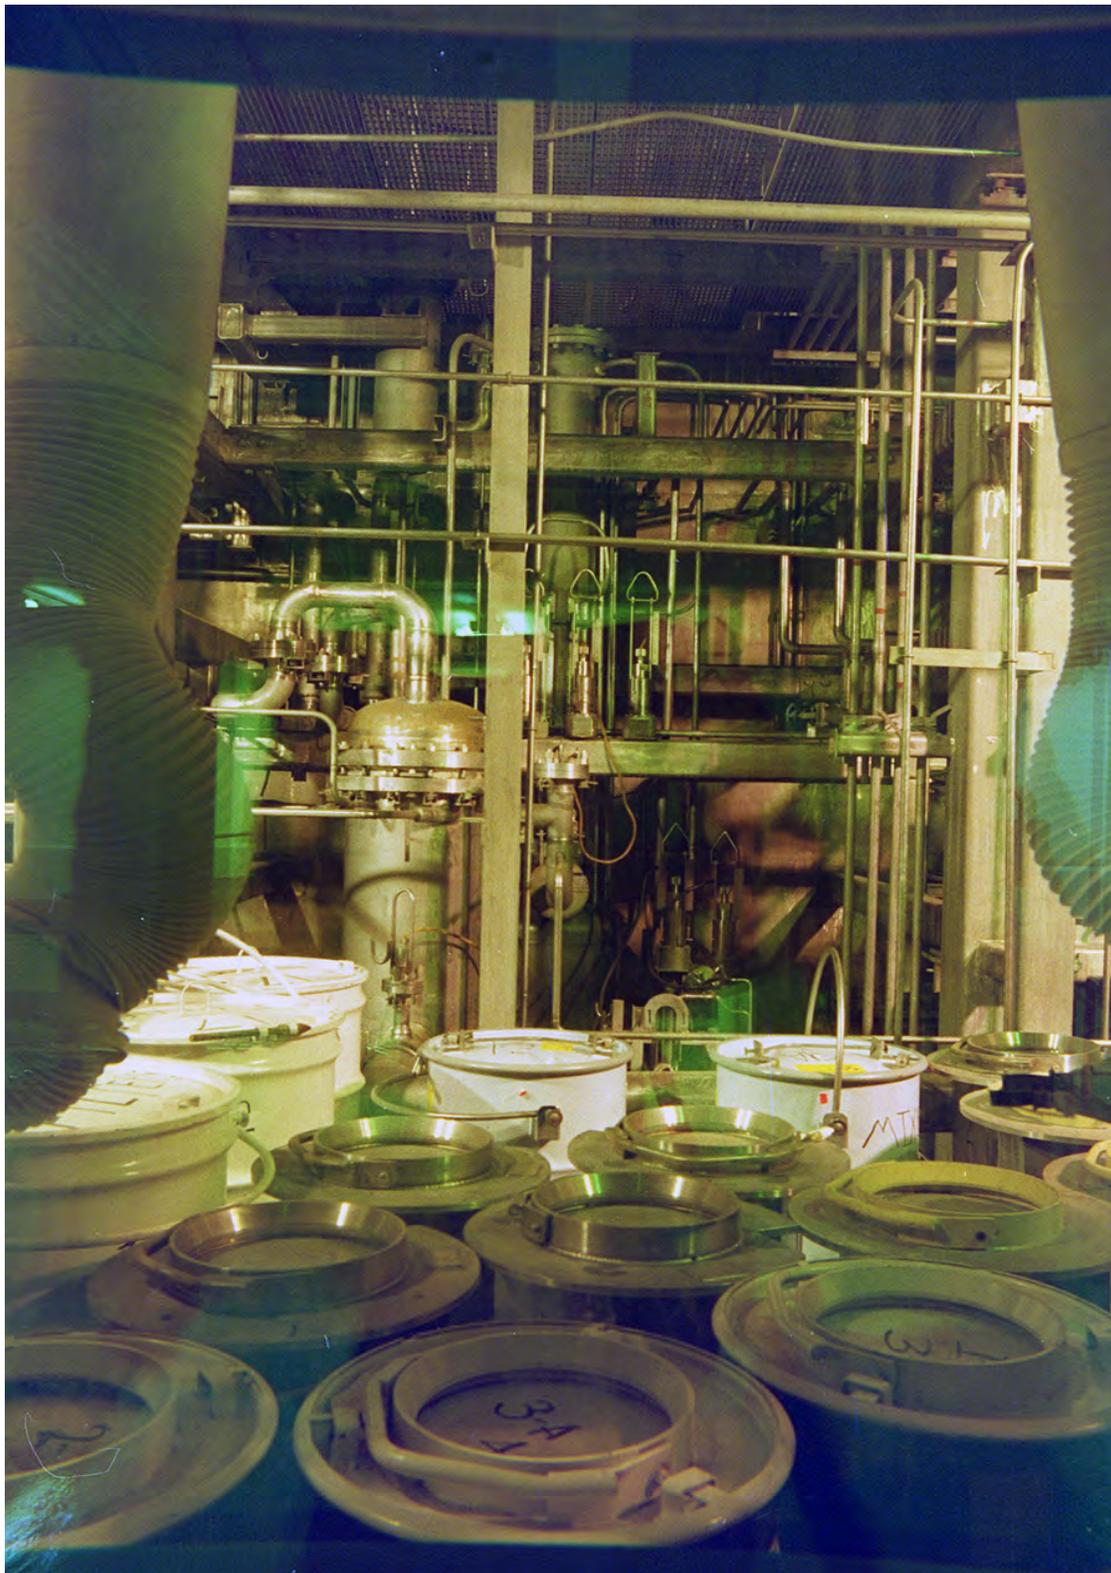

CPP-666 FDP Cell Container Storage
-13'-0" Level
Looking East

PN-96-84-1-9



03-06-02
RMWSF
Main Gate CPP-1617
Storage Area
Looking South

Photo number: 1617-16



03-06-02
RMWSF
Inside CPP-1617
Temporary Structure
Looking East

Photo Number: 1617-01



03-06-02
RMWSF
Mixed Waste Storage Boxes
Paved Area
Looking North East

Photo Number: 1617-11



9-29-98
RMWSF
High Radiation Storage Area with Radioactive and Mixed Waste Boxes (with covers)
Paved Area
Looking East

Photo Number: 98-546-2-2



03-03-02
RMWSF
Cargo Containers
Paved Area
Looking North

Photo Number: 1617-14



1989
RMWSF
CPP-1617 Exterior
Looking North East

Photo Number: 89-566-1-15



03-06-02
RMWSF
CPP-1617 Building
Looking North West

Photo Number: 1617-07



1995
RMWSF
Interior Cargo Container, Drip Pan, Inspector, and Liquid Waste
Electric Base Board Heater Lower Left
Looking West

Photo Number: 95-1015-1-8



03-06-02
RMWSF
Heated Cargo Containers
Paved Area
Looking South West

Photo Number: 1617-09



06-07-04
External View of an Interim Storage Container

Photo Number: ILSTF 003.jpg




06-07-04
View of Empty Interim Storage Container

Photo Number: ILTSF 001.jpg



09-23-04
Example of Shielded Overpack Container

Photo Number: ILTSF 005.jpg

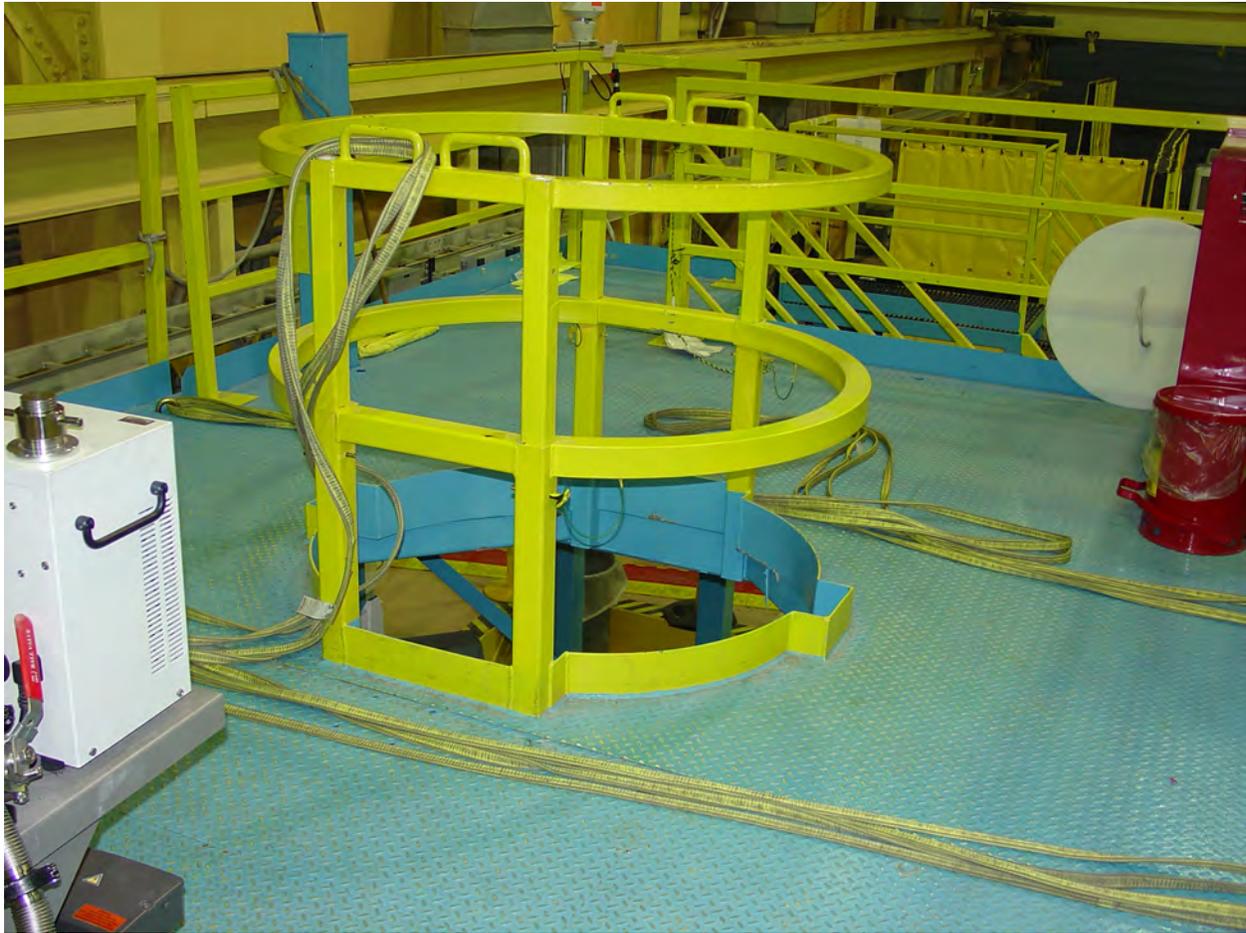

01-21-09
RH TRU Cask Loading Platform
CPP-659, Room 428

Photo Number: N/A



01-21-09
RH TRU Removable Lid Container (RLC) Inspection Stand (empty)
CPP-659, Room 428

Photo Number: N/A



01-21-09
RH TRU Cask Loading and RLC Inspection Areas
CPP-659, Room 428

Photo Number: N/A



01-21-09
RH TRU View of Overhead Crane
CPP-659, Room 428 Looking West

Photo Number: N/A



01-21-09
RH TRU RLC Inspection Station with Empty RLC
CPP-659, Room 428

Photo Number: N/A




01-21-09
RH TRU RLC with Lid Removed and Placed on Lid Inspection Stand
CPP-659, Room 428

Photo Number: N/A



01-21-09
RH TRU Personnel Operating Station
CPP-659, Room 428

Photo Number: N/A

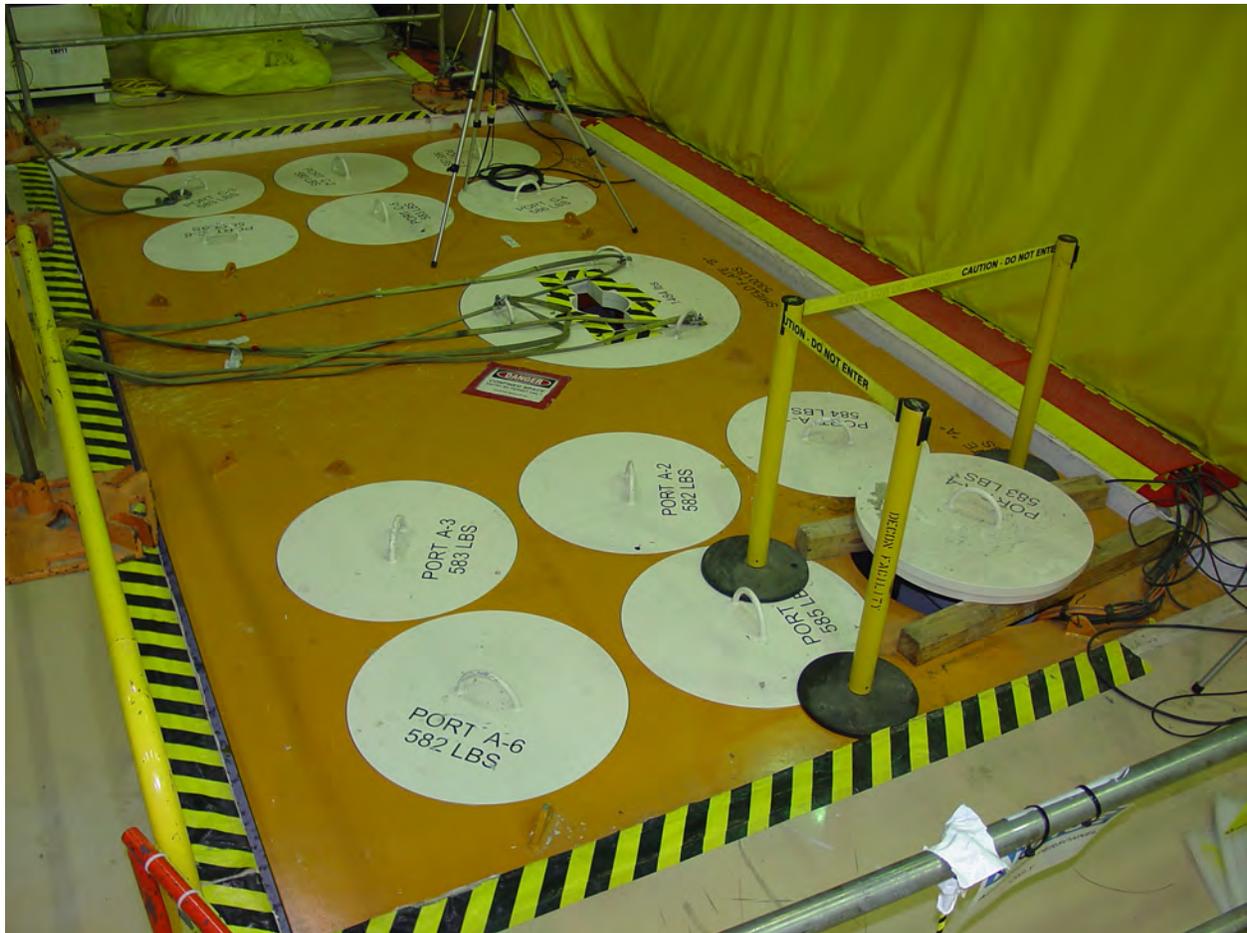

01-21-09
RH TRU Lag Storage Rack
CPP-659, Room 428

Photo Number: N/A



01-21-09
RH TRU Cask Storage Rack and Impact Limiter Staging Stand (both empty)
CPP-659, Room 428

Photo Number: N/A



01-21-09
RH TRU Funnel for Loading Inserts into Casks
CPP-659, Room 428

Photo Number: N/A



01-21-09
RH TRU Transport Trailer with 72B Shipping Cask
Located east of CPP-659

Photo Number: N/A



01-21-09
RH TRU Decon Cell with Repackaged Drum
CPP-659, Room 208

Photo Number: N/A



01-21-09
RH TRU Decon Cell with Turntable/Sorting Table with Downdraft Repackage Waste Container
CPP-659, Room 208

Photo Number: N/A




01-21-09
RH TRU Crane Maintenance and Transfer Area
CPP-659, Room 323

Photo Number: N/A



01-21-09
RH TRU Real-Time Radiography (RTR) Access Port into Room 306
CPP-659, Room 418

Photo Number: N/A

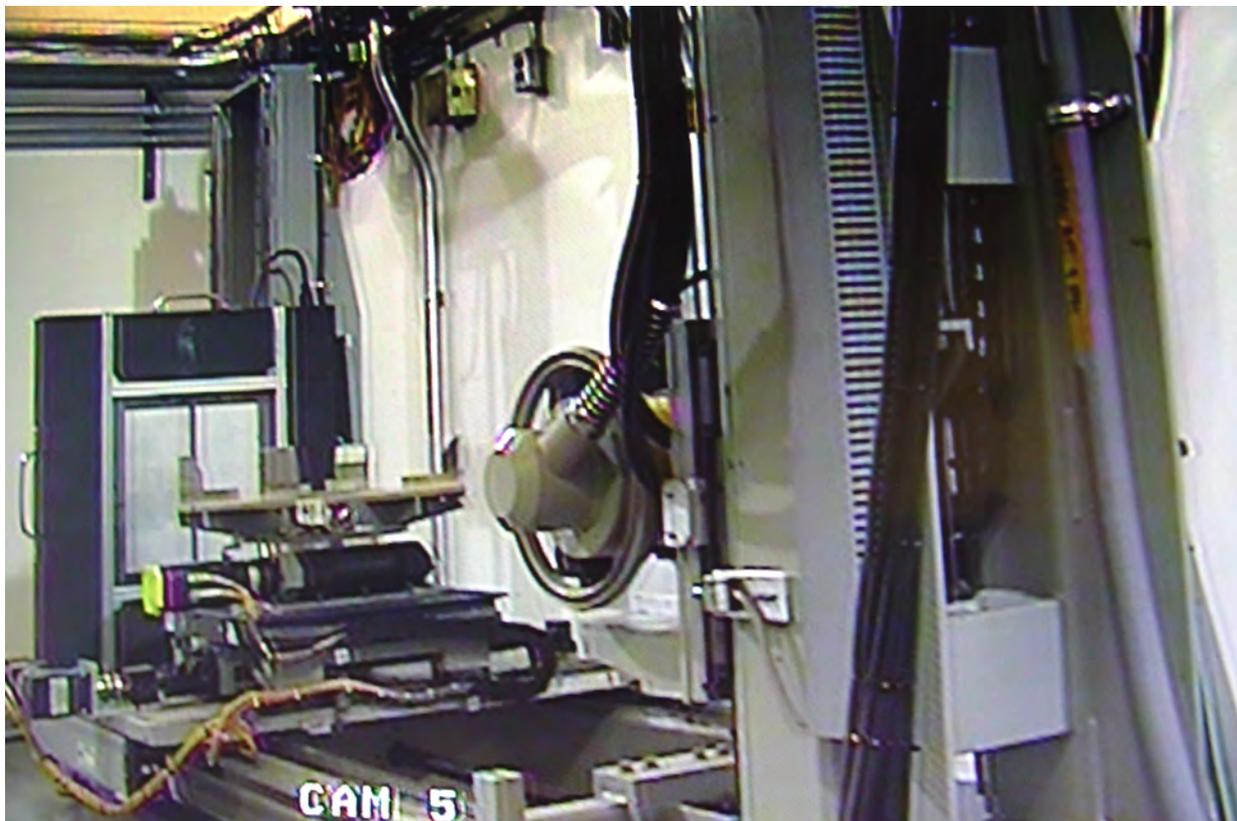


01-21-09
RH TRU RTR Equipment
CPP-659, Room 306

Photo Number: N/A



01-21-09
RH TRU Decontamination Access Tent into Remote Decon Cell (Room 308)
CPP-659, Room 418

Photo Number: N/A

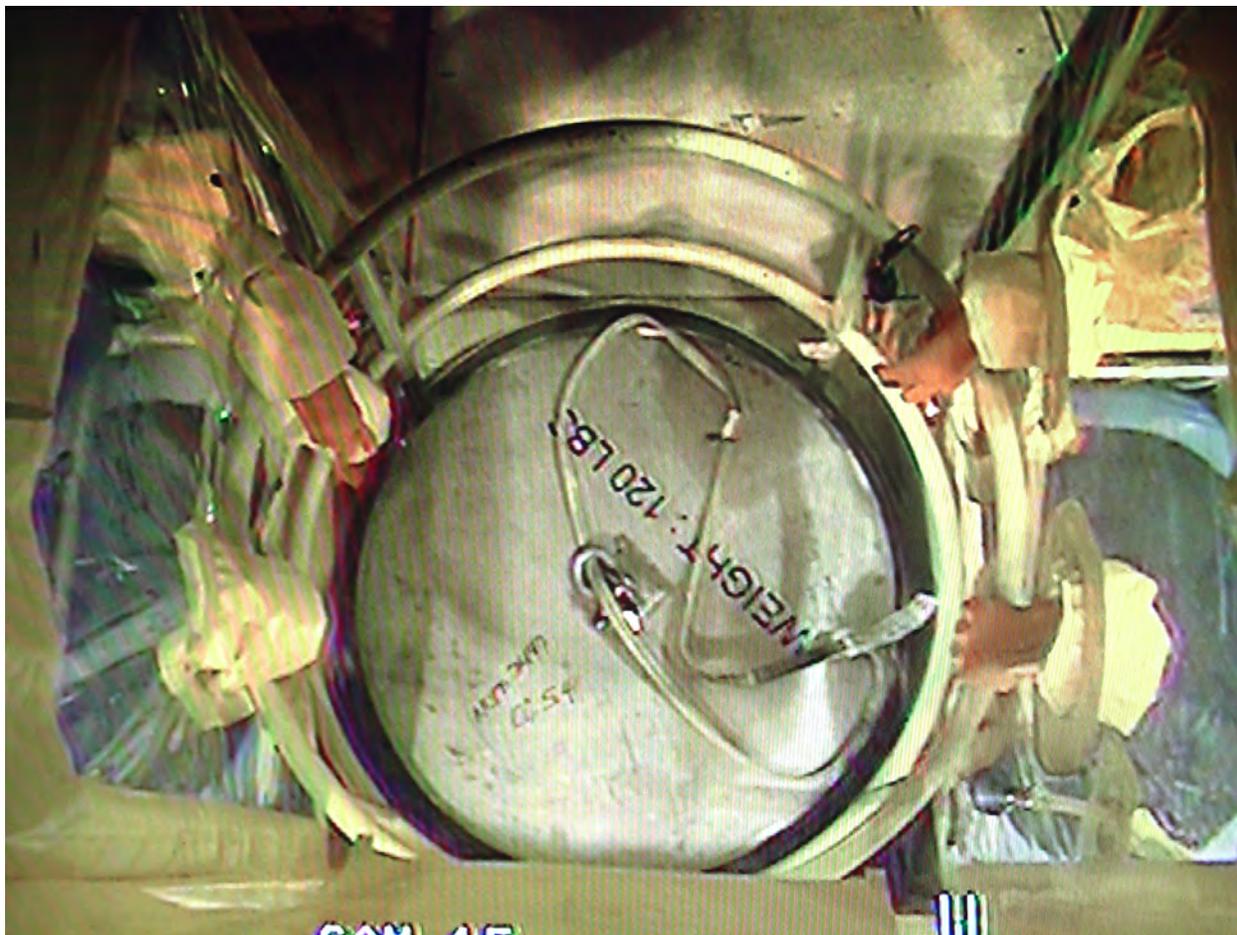


01-21-09
RH TRU Port Cover over Remote Decon Cell (Room 308) located in Decontamination Access
Tent
CPP-659, Room 418

Photo Number: N/A



01-21-09
RH TRU Shielded Operating Area in the Equipment Decon Room
CPP-659, Room 418

Photo Number: N/A

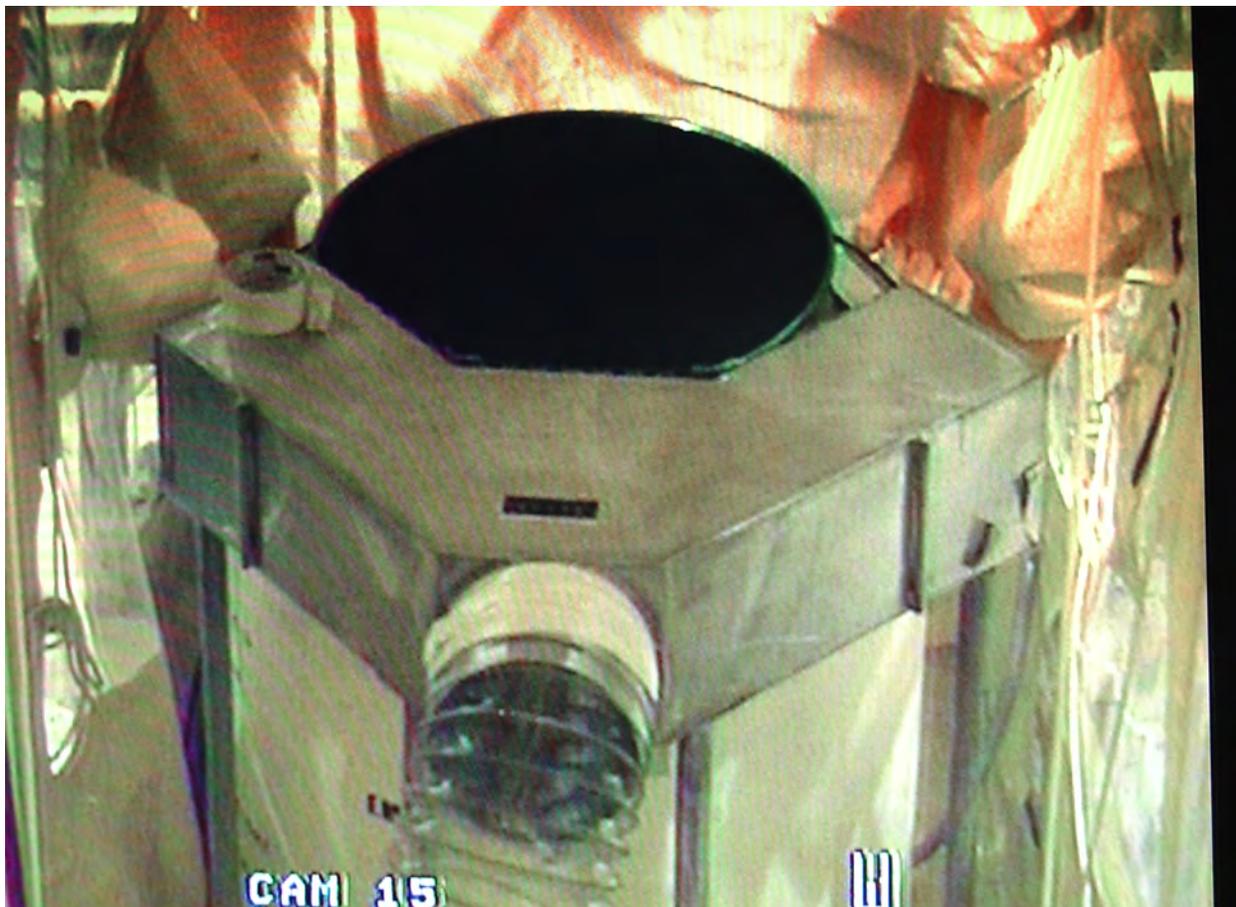

01-21-09
RH TRU Equipment Decon Room (418) Overpack Area -55-gallon Waste Drum
CPP-659, Room 418

Photo Number: N/A



04-09-2015
Argon Repackaging Station (ARS) unit for use in CPP-659 Room 308




04-09-2015

ARS unit showing a lexan wall with a drum out port. The wall is replaceable with either a wall with a drum out port or a solid wall.

The ARS unit will be installed in CPP-659, Room 308



ARS 1 Unit Prior to installation into the CPP-666 FDP Cell

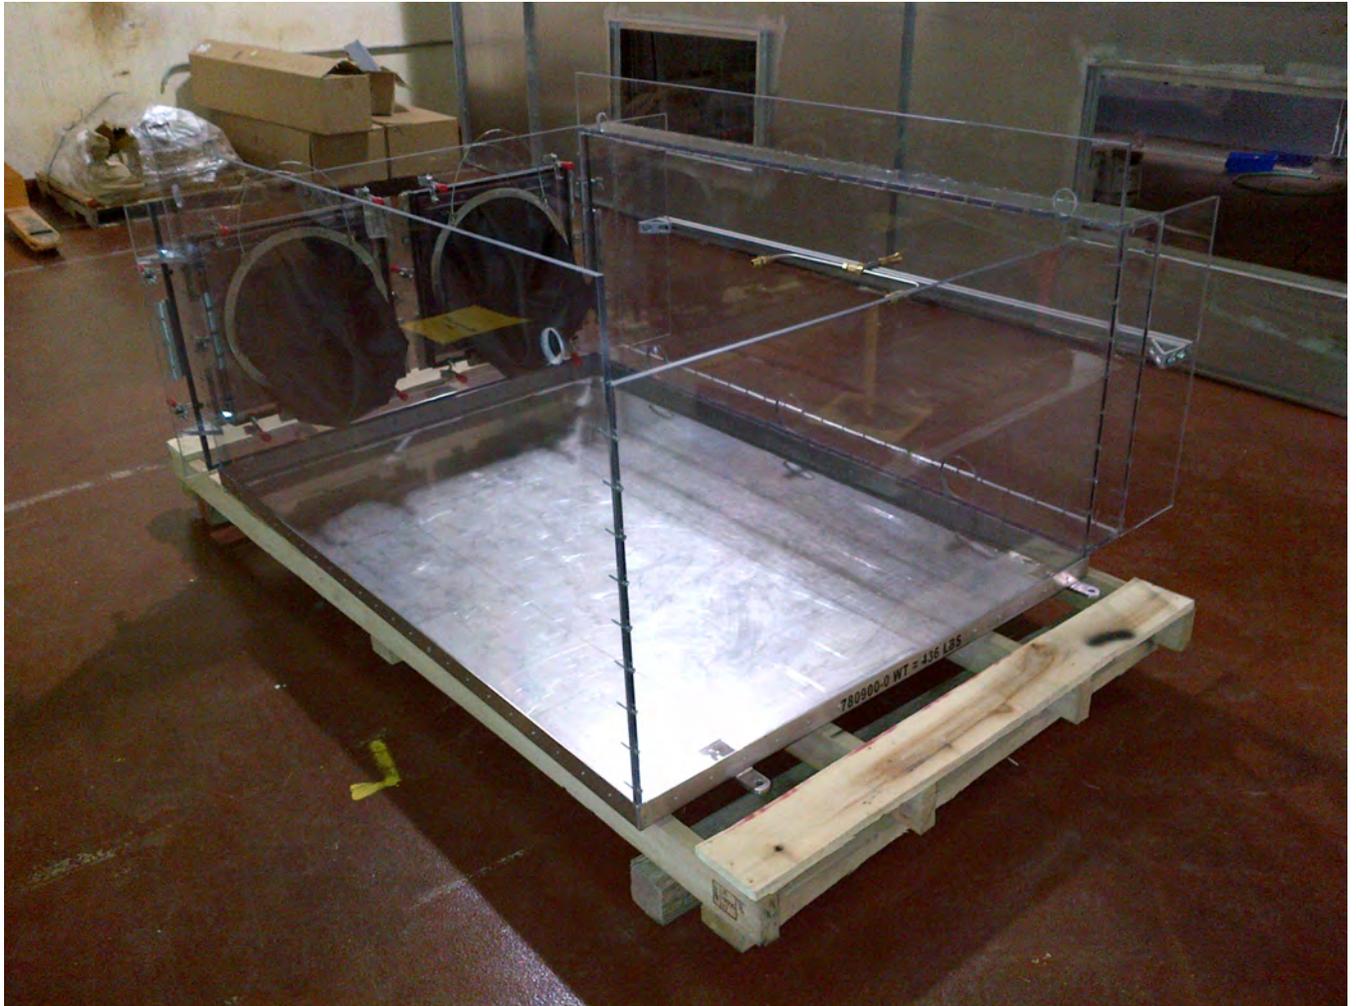

ARS 2 unit prior to installation into the CPP-666 FDP Cell



ARS 2 setup with empty waste containers prior to installation into the CPP-666 FDP Cell



12-01-16
Interior of Building CPP-2725 looking North
Photo Number: 20161201_140323



12-01-16
Exterior of Building CPP-2725 from the South

Photo Number: 20161201_140445



12-01-16
Exterior of Building CPP-2725 from the Southwest corner

Photo Number: 20161201_140618

HWMA/RCRA PART B PERMIT
FOR THE IDAHO NATIONAL LABORATORY

Volume 18 – Idaho Nuclear Technology and Engineering Center

APPENDIX 2

Debris Treatment Processes
Holdup and Collection Tanks
CPP-659/-1659 Storage
CPP-666 FDP Cell Container Storage and Slab Tank Storage
Other Miscellaneous Treatment Processes
RMWSF (CPP-1617) and CPP-2725

FACILITY DRAWINGS

Revision Date: May 17, 2018

DRAWING LIST

Drawing Number	Revision Number	Description
056381	22	CPP Piping & Instrument Legend, Symbols & Abbreviations
142644	3	Fluorinel and Storage Facility Mechanical Process Legend & Symbols
132378	2	3 rd Level Floor Slab Plan No. 3 Calcining Area
132464	6	1 st Level Floor & FDN Plan Decontamination Area
132545	1	Decon. Coll.Tank & Pump Cells Wall Sections Calcining Area
132797	1	Item No. VES-NCD-123 Decontamination Area Hold-Up Tk. Decon Area
132799	1	Item No. VES-NCD-129 Collection Tank Decon Area
133399	12	Utility Flow Diagram Process & Utility Drain Line @ Levels No, 1, 2, & 3, NWCF
133400	9	Utility Flow Diagram Process & Utility Drain Lines @ Levels No 1, 2, 3, NWCF
133401	12	Utility Flow Diagram Process & Utility Drain Lines @ Levels No 1, 2, 3, NWCF
133402	11	Utility Flow Diagram Process & Utility Drain Lines @ Levels No 1, 2, 3, NWCF
133408	28	Mechanical P&ID Hot Sump Tanks Cell, NWCF
133409	31	Mechanical P&ID Hot Sump Tanks Cell, NWCF
133443	23	Mechanical Flow Diagram Decontamination Area, NWCF
133444	20	Mechanical Flow Diagram Decontamination Area, NWCF
133445	23	Mechanical Flow Diagram Decontamination Area, NWCF
133446	23	Mechanical Flow Diagram Decontamination Area, NWCF
133447	28	Mechanical Flow Diagram Decontamination Area, NWCF
133448	28	Mechanical Flow Diagram Decontamination Area, NWCF
134621	2	Stainless Steel Floor Liner Plate Installation Floor Plan No. 3 Decon Area, NWCF

Drawing Number	Revision Number	Description
444389	7 Sheet P-3	HEPA Filter Leach System Process and Instrumentation Diagram
444390	3 Sheet P-4	Modifications to HEPA Filter Leach System Piping Plan
097870	3	CPP-659 NWCF Truck Bay Decon Spray Booth DSB-NC-601 P&ID
097877	2 Sheets 1 - 2 of 2	CPP-659 NWCF Truck Bay Decon Spray Booth and Glovebox DSB-NC-601 and GBX NCD-920 Configuration
097878	2	ICPP BLDG 659 NWCF Truck Bay Liquid Abrasive Spray Glove Box GBX-NCD-920 Component Arrangement
184190	5 Sheet V-1	ICPP BLDG 659 Spray Booth DSB-NC-601 and HVAC Air Flow and Control Diagram
184193	2 Sheet V-4	ICPP BLDG 659 Decon Spray Booth DSB-NC-601 1 st Level HVAC Plan View
384861	2	Debris Rule Compliance Project Steam Spray Booth Floor Plan, Sect. & Details
384870	8	DSB-NC-601 & GBX-NCD-920 Process Trench and Drain Flow Diagram
141706	6	Fluorinel and Storage Facility Architectural Enlarged Partial Plan EL -13'-0" -27'-0" -31'-0"
092723	1	CPP-659 Room # 415 Contamination Control Barrier Plan View
142404	4	Fluorinel and Storage Facility Mechanical Hatch Cover Waste Transfer Room
142423	3	Fluorinel and Storage Facility Mechanical Waste Transfer Shielded Box
143388	7	Fluorinel and Storage Facility Structural Dissolution Cell Wall Elevations and Sections Sht 1
143409	9	Fluorinel and Storage Facility Structural Dissolution Cell Sections Sht 2
143434	8	Fluorinel and Storage Facility Structural Dissolution Cell Sections Sht 3
143493	5	Fluorinel and Storage Facility Structural Typical Liner Plate Plan, Elevation, Section & Details

Drawing Number	Revision Number	Description
149885	2	FDP Cell Grating Modifications Steel Framing Plan @ EL -0'-2
149886	2	FDP Cell Grating Modifications Grating Plan @ EL -0'-0
141703	9	Fluorinel and Storage Facility Architectural Floor Plan EL 0'-0"
092443	4	CPP-666 Space Occupancy First Floor Plan
350205	1	Slab Tank VES-FC-184 Modify Cell Sump System
092700	7	CPP-666 Fluorinel Dissolution Process FM Area Noncontaminated Aqueous Waste Collection & Disposal P&ID
058061	20 Sheet 3	CPP-666 Fluorinel Dissolution Process Cell P & ID
142524	2	Fluorinel and Storage Facility Mechanical Remote Handling Air Filtration Cell Plywood Box
630299	1 Sheets 1 – 3 of 3	CPP-659 Remote Waste Box Bail Assembly CONT-NCM-16
625880	3	RWMC Remote Handling for TRU Waste Interim Storage System Interim Storage Container Assembly and Details
625881	2	RWMC Remote Handling for TRU Waste Interim Storage System Interim Storage Container Sections and Details
625882	3	RWMC Remote Handling for TRU Waste Interim Storage System Interim Storage Container Lid Assembly and Details
625883	1	RWMC Remote Handling for TRU Waste Interim Storage System Interim Storage Container Insert Assembly and Details
513174	4	Storage and Characterization Overpack for RH-TRU Waste Final Assembly
511342	4 Sheet 1 of 3	30 Gallon Storage and Characterization Overpack for RH-TRU Waste
455184	3 Sheets 1 – 4 of 4	Storage and Characterization Overpack for RH-TRU Waste (Bolted Base Construction)
133413	25	CPP-659 Mechanical Flow Diagram Blend & Hold Cell & Valve Cubicle New Waste Calcining Facility

Drawing Number	Revision Number	Description
635083	2 Sheet P-3	INTEC IWTU Modifications to NWCF Valve Cubicle P&ID
571621	1 Sheet P-1	CPP-666 RH TRU Distillation System Instrumentation Legend
571622	3 Sheet P-2	CPP-666 RH-TRU Distillation System Instrumentation Legend
571700	2 Sheets 1-6 of 6	CPP-666 RH-TRU Distillation Project Distillation Vessel Assembly VES-FC-101
571699	4 Sheets 1-4 of 4	CPP-666 RH-TRU Distillation System Collection Vessel Assembly VES-FC-85
571693	2 Sheets 1-2 of 2	CPP-666 RH-TRU Distillation System Spool Piece 1
571694	2 Sheets 1-2 of 2	CPP-666 RH-TRU Distillation System Spool Piece 2
571695	2 Sheets 1-4 of 4	CPP-666 RH-TRU Distillation System Spool Piece 3
571701	3 Sheets 1-2 of 2	CPP-666 RH-TRU Distillation System Spool Piece 5
571697	2 Sheets 1-2 of 2	INTEC-666 RH-TRU Distillation System Condenser Support Assembly
571718	2 Sheets 1-3 of 3	INTEC CPP-666 RH-TRU Distillation System DNI Room Secondary Containment Pan Assembly
571518	1	INTEC CPP-666 RH-TRU Distillation System DNI Room Secondary Containment Threshold
571623	4 Sheet P-7	INTEC-666 RH-TRU Sodium Distillation System Installation Thermal Fluid Skid P&ID


Drawing Number	Revision Number	Description
571515	2 Sheets 1-5 of 5	CPP-666 RH-TRU SODIUM DISTILLATION SYSTEM DISTILLATION ASSEMBLY MODIFICATION
571517	1	CPP-666 RH-TRU SODIUM DISTILLATION SYSTEM SPOOL PIECE 4 MODIFICATION
571505	1 Sheet PF-1	CPP-666 RH-TRU SODIUM DISTILLATION SYSTEM CONDENSER/COLLECTION VESSEL PROCESS FLOW DIAGRAM
571501	3 Sheet P-1	CPP-666 RH-TRU SODIUM DISTILLATION SYSTEM CONDENSER/COLLECTION VESSEL DISTILLATION VESSEL AND CONDENSER PIPING AND INSTRUMENTATION DIAGRAM
571502	1 Sheet P-2	CPP-666 RH-TRU SODIUM DISTILLATION SYSTEM CONDENSER/COLLECTION VESSEL TRANSFER VESSEL AND COLLECTION VESSEL PIPING AND INSTRUMENTATION DIAGRAM
571503	3 Sheet P-3	CPP-666 RH-TRU SODIUM DISTILLATION SYSTEM CONDENSER/COLLECTION VESSEL FILTER AND VACUUM PUMP PIPING AND INSTRUMENTATION DIAGRAM
786868	1 Sheets 1-5 of 5	CPP-666 RH-TRU DISTILLATION SYSTEM CONDENSER / COLLECTION VESSEL ASSEMBLY COND-FC-103A / VES-FC-85A
786869	1 Sheets 1-4 of 4	CPP-666 RH-TRU DISTILLATION SYSTEM CONDENSER / COLLECTION VESSEL ASSEMBLY INNER ASSEMBLY COND-FC-103A/VES-FC-85A
786870	1 Sheets 1-3 of 3	CPP-666 RH-TRU DISTILLATION SYSTEM CONDENSER / COLLECTION VESSEL OUTER SHELL ASSEMBLY
786871	0 Sheets 1-2 of 2	CPP-666 RH-TRU DISTILLATION SYSTEM COLLECTION TANK ASSEMBLY VES-FC-85A
785276	1 Sheets 1-3 of 3	CPP-666 RH-TRU DISTILLATION SYSTEM COLD TRAP FILTER ASSEMBLY F-FC-221
788579	2	CPP-666 RH-TRU DISTILLATION SYSTEM SPOOL PIECE 6

Drawing Number	Revision Number	Description
790816	3	INTEC CPP-659/666 ARGON REPACKAGING STATION ARS 3 ARS 3 CONFIGURATIONS
792396	2	INTEC CPP-659/666 ARGON REPACKAGING STATION 2.0 SHEQ-FC-920
801880	0	INTEC CPP-659/666 ARGON REPACKAGING STATION LARGE BOX ASSEMBLY SHEQ-NCD-940

VALVES, MANUALLY OPERATED

BY ADDING AN ACTUATOR TO THE BASIC VALVE SYMBOL, VALVE BECOMES A CONTROL VALVE.

	ANGLE GATE
	ANGLE GLOBE
	BALL
	BLOW DOWN
	BUTTERFLY
	CHECK
	CHECK ANGLE
	CHECK ANGLE STOP
	CHECK STOP
	COCK
	DIAPHRAGM
	FOUR WAY
	GATE
	GLOBE
	GLOBE WITH BELLOWS SEAL
	HOSE ANGLE GATE
	HOSE GATE
	HOSE ANGLE GLOBE
	HOSE GLOBE
	MANIPULATOR OPERATED
	NEEDLE
	PINCH
	PLUG
	QUICK RELEASE
	RELIEF
	SLIDE
	THREE WAY
	SAFETY

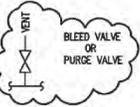

VALVE ACTUATORS

VALVES SHOWN IN PHANTOM ARE FOR REFERENCE ONLY. SUBSTITUTE APPROPRIATE SYMBOLS AS REQUIRED.

	CYLINDER OPERATED
	CYLINDER OPERATED SINGLE ACTING AIR TO OPEN
	CYLINDER OPERATED SINGLE ACTING AIR TO CLOSE
	CYLINDER OPERATED DOUBLE ACTING
	CYLINDER OPERATED RAM
	DIAPHRAGM OPERATED
	FLOAT OPERATED
	EXTENSION
	MOTOR OPERATION
	REGULATOR - PRESSURE REDUCING WITH INTEGRAL RELIEF & OUTPUT PRESSURE INDICATOR
	PRESSURE REGULATOR INTEGRAL RELIEF
	REGULATOR - BACK PRESSURE
	REGULATOR - EXTERNAL PRESSURE TAP
	REGULATOR - PRESSURE REDUCING
	REGULATOR - PRESSURE REDUCING WITH INTERNAL PRESSURE TAPS
	REGULATOR - PRESSURE REDUCING WITH INTERNAL PRESSURE TAPS AND IN AND OUT PRESSURE GAUGES
	SOLENOID OPERATED
	CHAIN OPERATED
	SOLENOID OPERATED WITH RESET
	DIAPHRAGM OPERATED WITH HANDWHEEL
	DIAPHRAGM OPERATED WITH POSITIONER

VALVE STATUS

VALVES SHOWN IN PHANTOM ARE FOR REFERENCE ONLY. SUBSTITUTE APPROPRIATE SYMBOLS AS REQUIRED.

	LOCKED CLOSED
	LOCKED OPEN
	NORMALLY CLOSED
	NORMALLY OPEN
	POST INDICATOR
	FAIL OPEN
	FAIL CLOSED

LINE SYMBOLS

	PRIMARY
	SECONDARY
	PNEUMATIC SIGNAL
	CAPILLARY
	ELECTRICAL
	FLEX HOSE
	RCRA CONTROLLED

JOINT TYPES

VALVES SHOWN IN PHANTOM ARE FOR REFERENCE ONLY. SUBSTITUTE APPROPRIATE SYMBOLS AS REQUIRED.

	SCREWED
	FLANGED
	BUTT WELD
	SOLDERED
	SOCKET WELD
	TUBING FITTING
	TUBING UNION
	TUBING TEE

ABBREVIATIONS

ABBREVIATIONS COMMONLY USED ON CPP DRAWINGS BUT NOT IN G.E. DRAFTING MANUAL

OTA-----OPEN TO ATMOSPHERE

MISCELLANEOUS

	AIRLIFT
	FILTER
	JET
	LINE BLIND FLANGE
	SPECTACLE BLIND (INSTALL DONUT)
	BLIND FLANGE
	QUICK DISCONNECT COUPLING
	STRAINER
	STRAINER (Y-TYPE)
	STRAINER (DUAL)
	PUMP (CENTRIFUGAL)
	PUMP (DIAPHRAGM)
	STEAM TRAP
	REDUCER
	PIPE PLUG
	SOCKET WELD CAPPED LINE OR THREADED CAPPED LINE
	BUTT WELD CAPPED LINE
	HOSE CONNECTION
	SPRAY NOZZLE
	FREEZE PLUG
	VENTURI TUBE
	DIAPHRAGM SEAL
	CONTINUATION ZONE BOX
	FLOOR DRAIN
	CAPPED FLOOR DRAIN
	CAPPED FLOOR DRAIN WITH PENETRATION
	SPARGE

MISCELLANEOUS (CONT.)

	THE POINT
	DISTANCE FROM WALL TO THE POINT
	CONSECUTIVE NUMBERS
	NEW TO EXISTING
	VACUUM BREAKER
	VALVE DRIP PAN
	HEAT EXCHANGER
	EYE WASH
	SAFETY SHOWER
	AIR OPERATED FLOOR DRAIN PLUG VALVE
	LOCKOUT CAN
	SURGE POT

INSTRUMENTATION

FOR INSTRUMENTATION SYMBOLS SEE DRAWING 058500

22	PER DCN #171556-AB8	BUSSA/JAG	6/24/77
21	REVISED PER DCN #155754-AB38	WILSON/CS DBJ	11/21/76
NO.	REVISIONS	DATE	DATE




Westinghouse Idaho Nuclear Company Inc.
IDAHO CHEMICAL PROCESSING PLANT
IDAHO FALLS, IDAHO

FOR U.S. DEPARTMENT OF ENERGY
IDAHO OPERATIONS OFFICE
IDAHO FALLS, IDAHO

CPP PIPING & INSTRUMENT LEGEND, SYMBOLS & ABBREVIATIONS

APPROVALS	SIGNATURE	DATE
ENGR.		
OFFER.		
CHECKER		
REQUESTER		
DESIGNER		
SCALE		
DATE ISSUED		

DCN. NO.	INDEX CODE NUMBER	DRAWING NUMBER	REV.
D 200	9999 24 030	056381	22

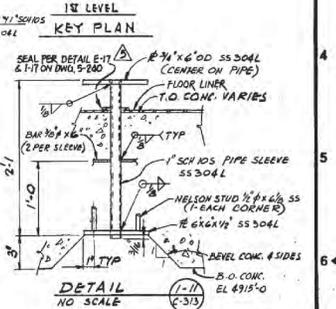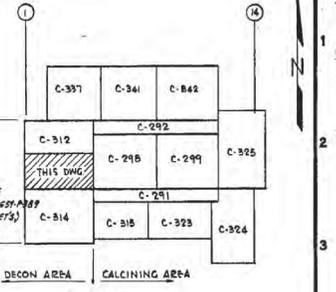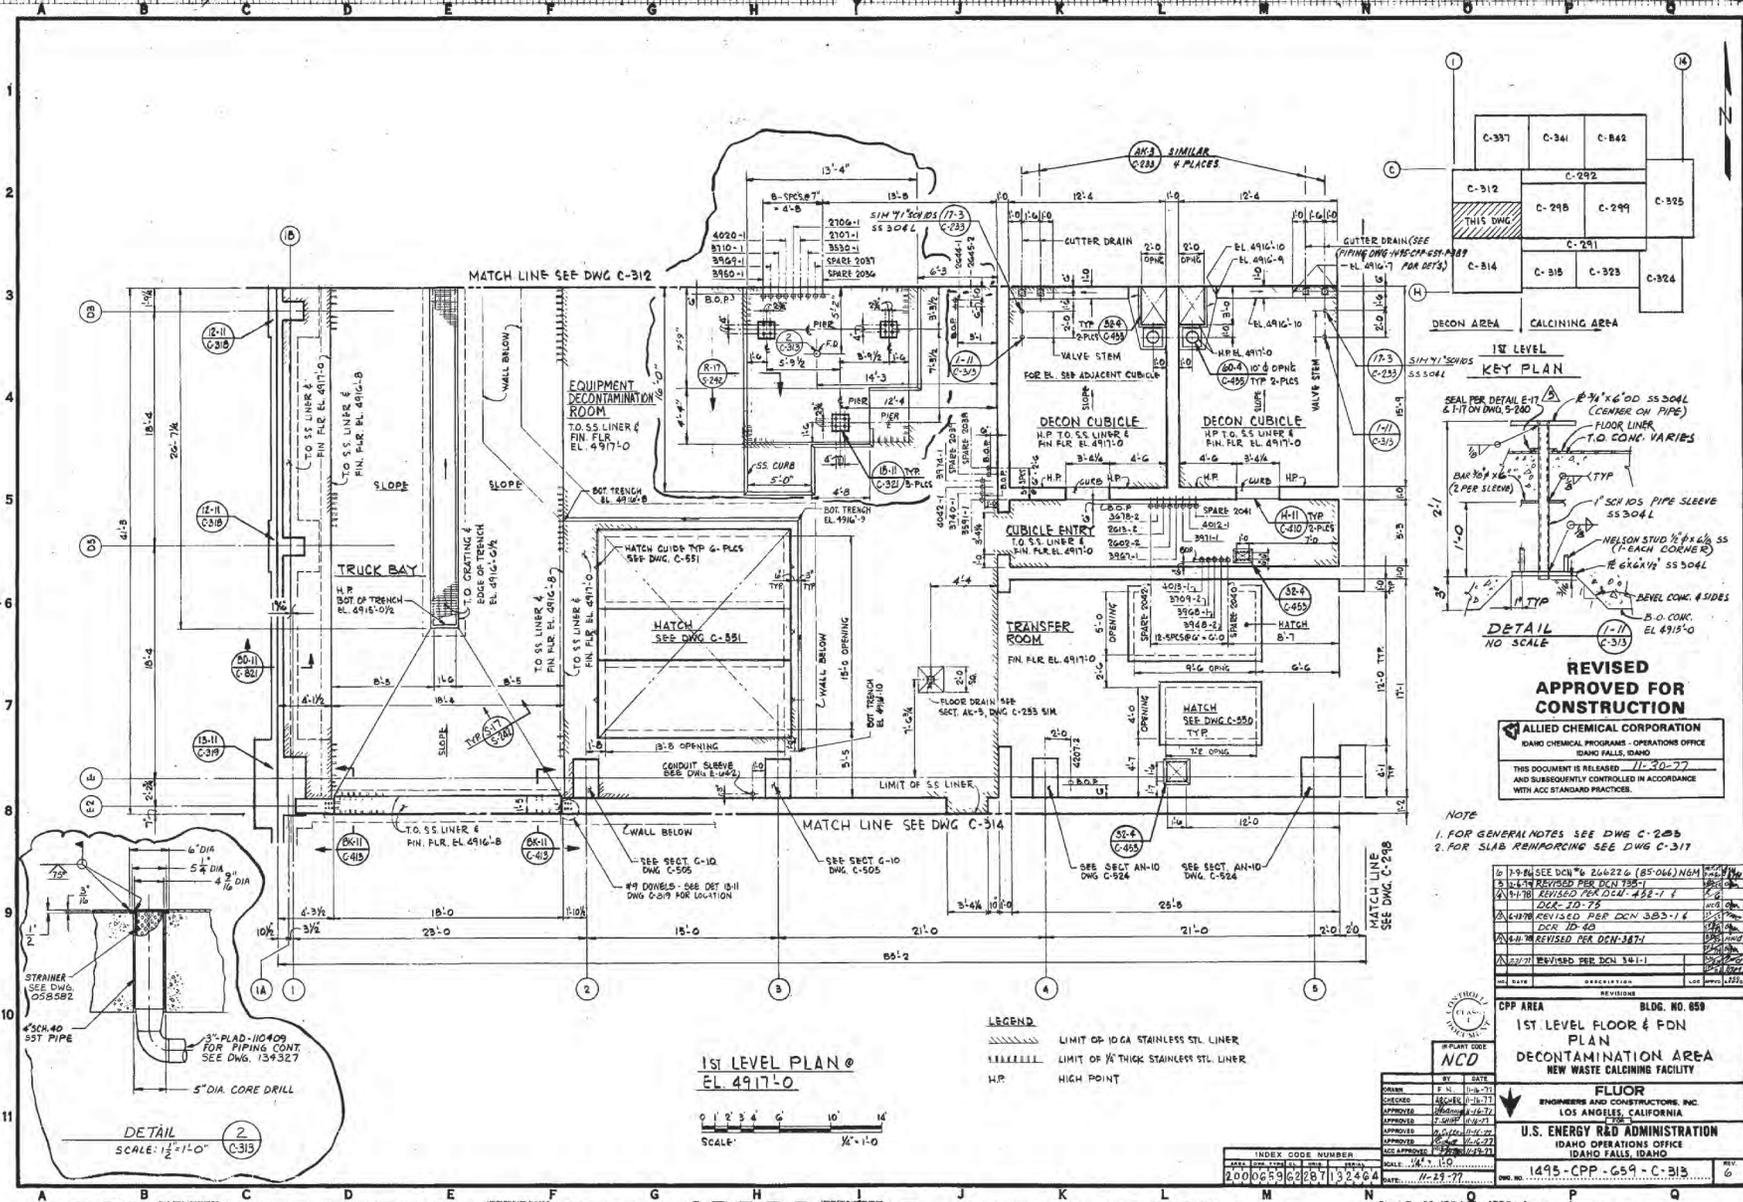

REVISED APPROVED FOR CONSTRUCTION

ALLIED CHEMICAL CORPORATION
 IDAHO CHEMICAL PROGRAMS - OPERATIONS OFFICE
 IDAHO FALLS, IDAHO

THIS DOCUMENT IS RELEASED 11-30-77
 AND SUBSEQUENTLY CONTROLLED IN ACCORDANCE
 WITH ACC STANDARD PRACTICES.

- NOTE**
- FOR GENERAL NOTES SEE DWG C-285
 - FOR SLAB REINFORCING SEE DWG C-317

NO	DATE	DESCRIPTION	BY	CHKD
1	11-29-77	ISSUED FOR CONSTRUCTION
2	11-29-77	REVISED PER DCN 385-16
3	11-29-77	REVISED PER DCN 385-16
4	11-29-77	REVISED PER DCN 385-16
5	11-29-77	REVISED PER DCN 385-16
6	11-29-77	REVISED PER DCN 385-16

CPP AREA BLDG. NO. 859

1st LEVEL FLOOR & FDN PLAN


DECONTAMINATION AREA
 NEW WASTE CALCINING FACILITY

FLUOR ENGINEERS AND CONSTRUCTORS, INC.
 LOS ANGELES, CALIFORNIA

U.S. ENERGY RESEARCH ADMINISTRATION
 IDAHO OPERATIONS OFFICE
 IDAHO FALLS, IDAHO

1495 CPP-659-C-313

137281

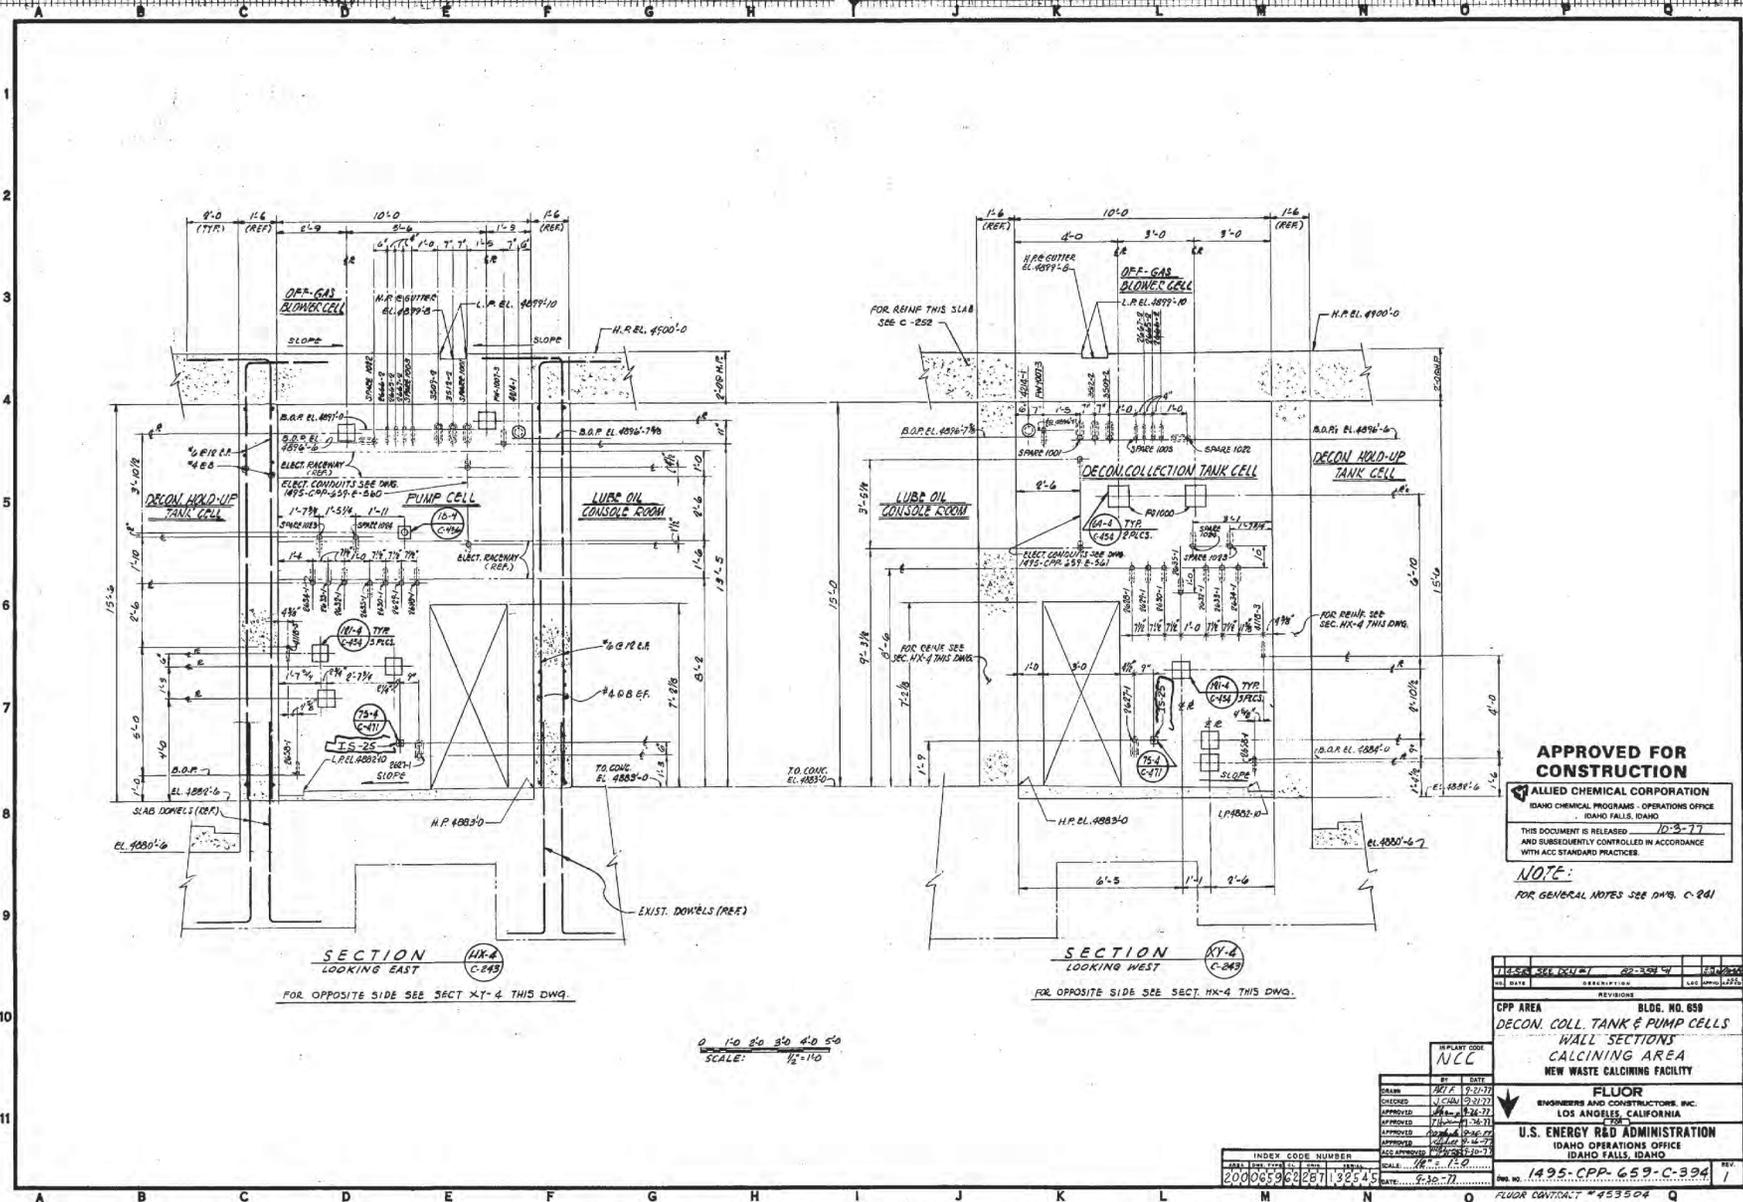



APPROVED FOR CONSTRUCTION
 ALLIED CHEMICAL CORPORATION
 IDAHO CHEMICAL PROGRAMS - OPERATIONS OFFICE
 IDAHO FALLS, IDAHO
 THIS DOCUMENT IS RELEASED 10-23-77
 AND SUBSEQUENTLY CONTROLLED IN ACCORDANCE
 WITH ACC STANDARD PRACTICES

NOTE:
 FOR GENERAL NOTES SEE DWG. C-241

NO.	DATE	DESCRIPTION	BY	CHKD.
1	8-30-77	ISSUED FOR CONSTRUCTION	FLUOR	FLUOR


IN PLANT CODE: **NCC**
 SCALE: 1/8" = 1'-0"
 INDEX CODE NUMBER: 20006596287132545
 DATE: 8-30-77
 DWG. NO.: 1495-CPP-659-C-394
 FLUOR CONTRACT # 453504

187545

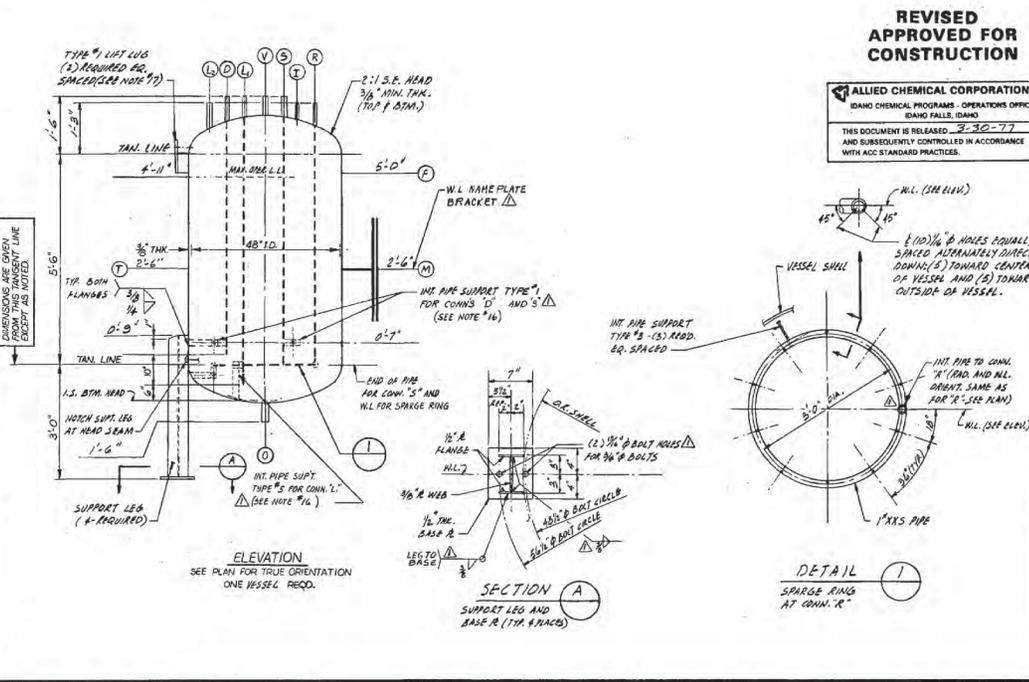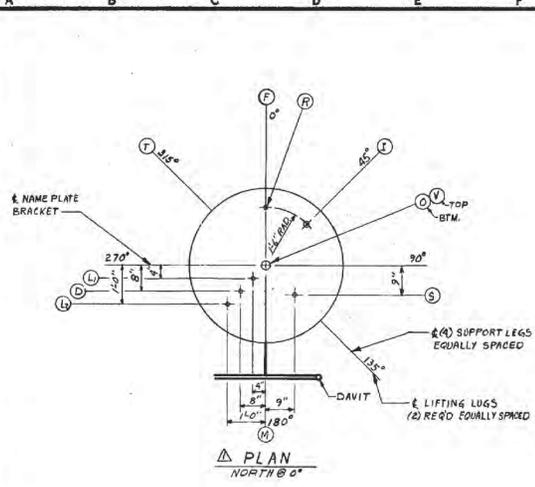

REVISED APPROVED FOR CONSTRUCTION


ALLIED CHEMICAL CORPORATION
 IDAHO CHEMICAL PROGRAMS - OPERATIONS OFFICE
 IDAHO FALLS, IDAHO
 THIS DOCUMENT IS RELEASED 3-20-77
 AND SUBSEQUENTLY CONTROLLED IN ACCORDANCE
 WITH ACS STANDARD PRACTICES.

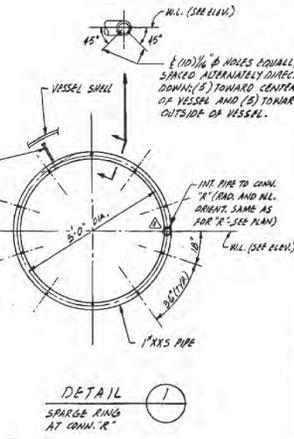

- NOTES**
- VESSEL FABRICATOR SHALL FURNISH AND INSTALL ALL PARTS UNLESS SPECIFIED OTHERWISE.
 - SPECIFIC GRAVITY OF LIQUID = 1.03 @ 150°F
 - VESSEL CAPACITY = 550 GALLONS (70 OVERFLOW)
 - DELTA T = 0
 - GASKETS - METALLIC SPIRAL WOUND (304L WITH BLUE AMERICAN COPOLYMER FILLER) OR PURCHASER APPROVED EQUAL.
 - NOMINAL CORROSION ALLOWANCE = 0.125" SERVICE CORROSION ALLOWANCE PLUS 0.010" CLEANING ALLOWANCE = 0.135" TOTAL
 - ALL STUB END NOZZLE NECKS SHALL BE DESIGNED FOR WELDING TO EXTERNAL PIPE PER API SPEC 5005-CP-1 (250-14-101).
 - EXTERNAL PIPE WELDING TO STUB END CONNECTIONS SHALL BE 1/2" SCH. 80S FOR CONNS "L", "S", "I", "J", "K", "L", "M", "N", "O", "P", "Q", "R", "S", "T", "U", "V", "W", "X", "Y", "Z", AND "D", AND SCH. 80S (NOMINAL SIZE 1/2" CONNECTION SCHEDULE) FOR EACH OF THE REMAINING STUB END CONNECTIONS. STUB END I.D. SHALL BE TOLERED TO MATCH EXTERNAL PIPING I.D. PER SEC. 5F-105008-42-2, PARA. 2.4.1.
 - INTERNAL PIPE SHALL BE SAME NOMINAL SIZE AND SCHEDULE AS NOZZLE NECK TO WHICH ATTACHED, UNLESS NOTED OTHERWISE.
 - ALL INTERNAL SURFACES (INCLUDING BURS AND ANY OTHER IRREGULARITIES).
 - NO PROTRUDING PARTS ALLOWED, HIGHER AT DRUMMING OR AT EXTERNAL ATTACHMENTS.
 - VESSEL SUPPORT LEGS, BASE PLATE AND LIFTING BOWS ARE DESIGNED FOR OPERATING BASE EARTHQUAKE (O. B. E.), BASED ON THE SUPPORT POINT RESPONSE SPECTRA AT 2% DAMPING AND NATURAL FREQUENCY FREQUENCY GREATER THAN 25 HZ, THE PEAK ACCELERATION IS 0.165 G (HORIZONTAL) AND 0.110 G (VERT.).
 - "DELETED"
 - A MINIMUM 10% OF THE CONNECTIONS "S" AND SMALLER SHALL BE LIQUID BARRIER INSPECTED AT EACH LAYER OF THEIR WELDS TO HEAD OR SHALL THIS IS IN LINE OF SPT AND O.D. PANNY.
 - FOR MANUFACTURING TOLERANCES, SEE SPEC. 5F-105008-42-2, PARA. B.4 AND FIG. 2.
 - INTERNAL PIPE SUPPORT DETAILS AND MANHOLE COVER DETAIL SHALL BE PER REFERENCE DRAWINGS NO. 1485-CAP-653-V-141.
 - DETAILS FOR LIFTING LUGS SHALL BE PER REF. DRAWINGS NO. 1485-CAP-653-V-144.

DESIGN DATA					
1. DESIGN BASIS	ASME SECTION VIII DIV. 1 (DESIGN & CONSTRUCTION)				
2. STAMPING REQUIREMENTS	(NONE)				
3. SPEC. NO.	453504-42-2 AND 90-100				
4. DESIGN PRESSURE	30 PSI / 14 EXTERNAL PSIG. TEMP. 194 °F				
5. OPER. PRESSURE	0.3 EX. PSIG. TEMP. 150 °F				
6. POSTWELD HEAT TREATMENT	(NONE)				
7. WELD EXAMINATION	SP-8-RADIOGRAPH (SEE NOTE #14)				
8. JOINT EFFICIENCY	SHELL 85% HEADS 85%				
9. NOM. CORROSION ALLOWANCE	SHELL .135" HEADS .135" NOZZLE NECKS .135" (SEE NOTE #6)				
10. MAX. ALLOWABLE WORKING PRESSURE @ DESIGN TEMP.	30 PSIG				
11. BASIS FOR CALCULATED TEST PRESSURE	1/4 (M.A.P.-H.F.C.)				
12. HYDROSTATIC TEST PRESSURE (SHOP)	174 PSIG FIELD 52 (N.B.C.)				
13. MATERIAL SPECIFICATIONS					
(M) SHELL	SA-240-304L				
(N) HEADS	SA-240-304L				
(O) STUB END CONNECTIONS	(NONE)				
(P) NOZZLE NECKS & PIPE	SA-312-1/2-304L				
(Q) FLANGES (EXTERNAL)	SA-182-F304L				
(R) COUPLERS	(NONE)				
(S) GASKETS	(SEE NOTE #5)				
(T) BOLTING (EXTERNAL)	SA-192-B8C-CL1 NUTS SA-194-8C				
(U) BOLTING (INTERNAL)	JA-193-B8C-CL1 NUTS SA-194-8C				
(V) INTERNALS	SA-240-304L				
(W) SUPPORT LEGS	SA-240-304L				
(X) BASE PLATES	SA-240-304L				
(Y)					
(Z) EXTERNAL APPURTENANCES	SA-240-304L				
14. MAX. MIN. FINN. UNFINNED COVER, STUBS, GASKETS & NUTS					
15. PAINT PER SP-	(NONE)				
16. INSULATION (NONE)					
17. FIREPROOFING BY OTHERS					
18. INSPECTION BY	PURCHASER				
NOZZLE PROJECTIONS ARE FROM END OF VESSEL TO EXTERIOR FACE OF FLANGE OR STUB END EXCEPT AS NOTED.					
ESTIMATED VESSEL WEIGHTS					
(M) FURN. BY					
(N) INSTALLED BY					
(O) FABR. (LESS TRAYS)	3,485 LB.				
(P) EMPTY (LESS OPER. LIQUID)	3,575 LB.				
(Q) OPERATING	8,915 LB.				
(R) FULL OF WATER	8,950 LB.				
CONNECTION SCHEDULE					
MARK	NO.	WELT. SCHED.	OROS. TYPING	DESCRIPTION	
M	1	2"	30	1985	MANHOLE
T	1	1/2"	XKS	150"	THERMOWELL CONN.
V	1	2"	160	316	VENT
S	1	1/2"	XKS	316	SAMPLE SUPPLY WITH PIPE
P	1	1/2"	XKS	316	SOURCE "W" WITH PIPE (SEE DETAIL #1)
D	1	2"	160	316	DRAIN
L	1	1"	XKS	316	LEVEL / PRESSURE
I	1	1/2"	XKS	316	DECON INLET
F	1	1/2"	XKS	316	OVERFLOW
D	1	1"	XKS	316	DENSITY "W" WITH PIPE
VESSEL APPURTENANCES					
-V-144	STANDARD DETS. FOR THE SUPPS., STUB END WELD APP., MANHOLE COVER DETS. AND NAME PLATE BRACKET.				
-V-141	INTERNAL PIPE SUPPORT DETAILS AND MANHOLE COVER DETAIL SHALL BE PER REFERENCE DRAWINGS NO. 1485-CAP-653-V-141.				
-V-144	DETAILS FOR LIFTING LUGS SHALL BE PER REF. DRAWINGS NO. 1485-CAP-653-V-144.				
INDEX CODE NUMBER					
800065953287132099					
SCALE: NONE					
DATE: 3-29-77					
SHEET 1 OF 1					
CPP AREA BLDG. NO. 659					
ITEM NO. VES-MCD-129					
COLLECTION TANK					
DECON AREA					
NEW WASTE CALCINING FACILITY					
FLUOR ENGINEERS AND CONSTRUCTORS, INC.					
LOS ANGELES, CALIFORNIA					
U.S. ENERGY R&D ADMINISTRATION					
IDAHO OPERATIONS OFFICE					
IDAHO FALLS, IDAHO					
NO. 1495 CPP 659-V-129					

66LTC81

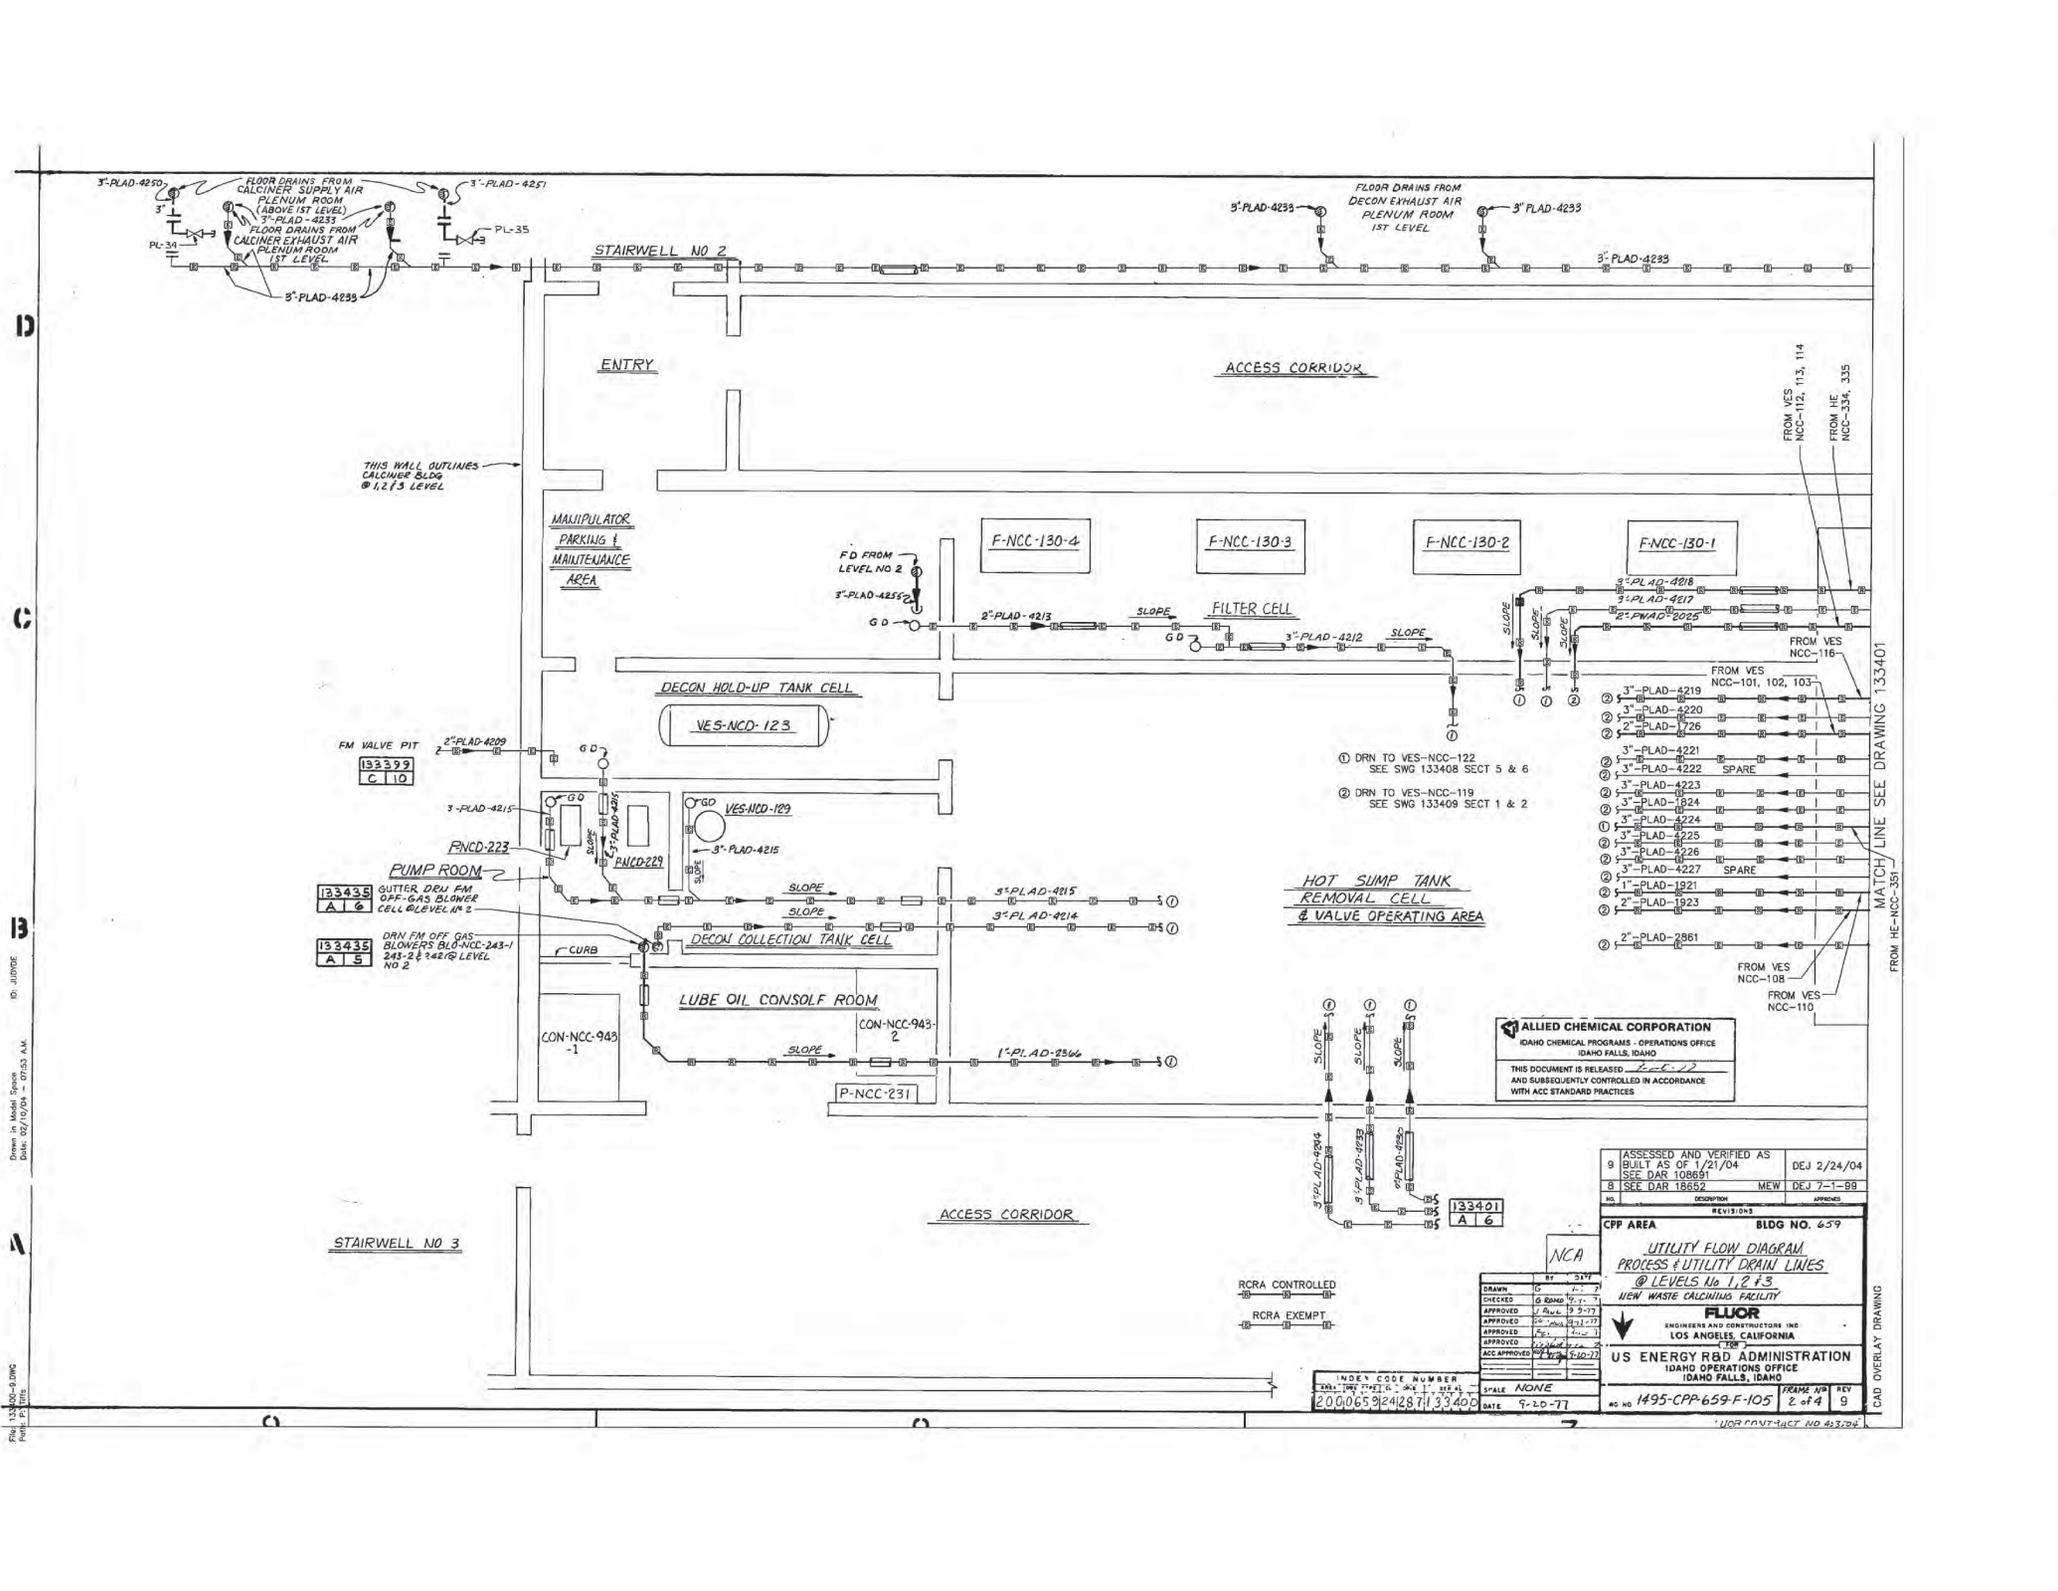

ID
 C
 B
 A
 13
 12
 11
 10
 9
 8
 7
 6
 5
 4
 3
 2
 1

Drawn by: [Name]
 Date: 02/19/04 07:53 AM
 ID: JUMBE

File: [Name]
 Path: [Path]


INDEX CODE NUMBER	SCALE	DATE
20006591242871133401	NONE	9-20-77

RCRA CONTROLLED	RCRA EXEMPT
<input type="checkbox"/>	<input type="checkbox"/>

ALLIED CHEMICAL CORPORATION
 IDAHO CHEMICAL PROGRAMS - OPERATIONS OFFICE
 IDAHO FALLS, IDAHO
 THIS DOCUMENT IS RELEASED IN ACCORDANCE
 AND SUBSEQUENTLY CONTROLLED IN ACCORDANCE
 WITH ACC STANDARD PRACTICES

ASSESSED AND VERIFIED AS	DEJ 2/24/04	
9 BUILT AS OF 1/21/04	SEE DAR 100891	
B SEE DAR 18652	MEW DEJ 7-1-89	
NO	DESCRIPTION	APPROVED
CPP AREA BIDG NO. 659		
UTILITY FLOW DIAGRAM PROCESS & UTILITY DRAIN LINES @ LEVELS No 1, 2 & 3 NEW WASTE CALCIUM FACILITY		
FLUOR ENGINEERS AND CONSTRUCTORS, INC. LOS ANGELES, CALIFORNIA		
US ENERGY R&D ADMINISTRATION IDAHO OPERATIONS OFFICE IDAHO FALLS, IDAHO		
NO. 1495-CPP-659-F-105	FRAME NO. 2 of 4	REV 9

MATCH LINE SEE DRAWING 133401
 FROM HE-NCC-350

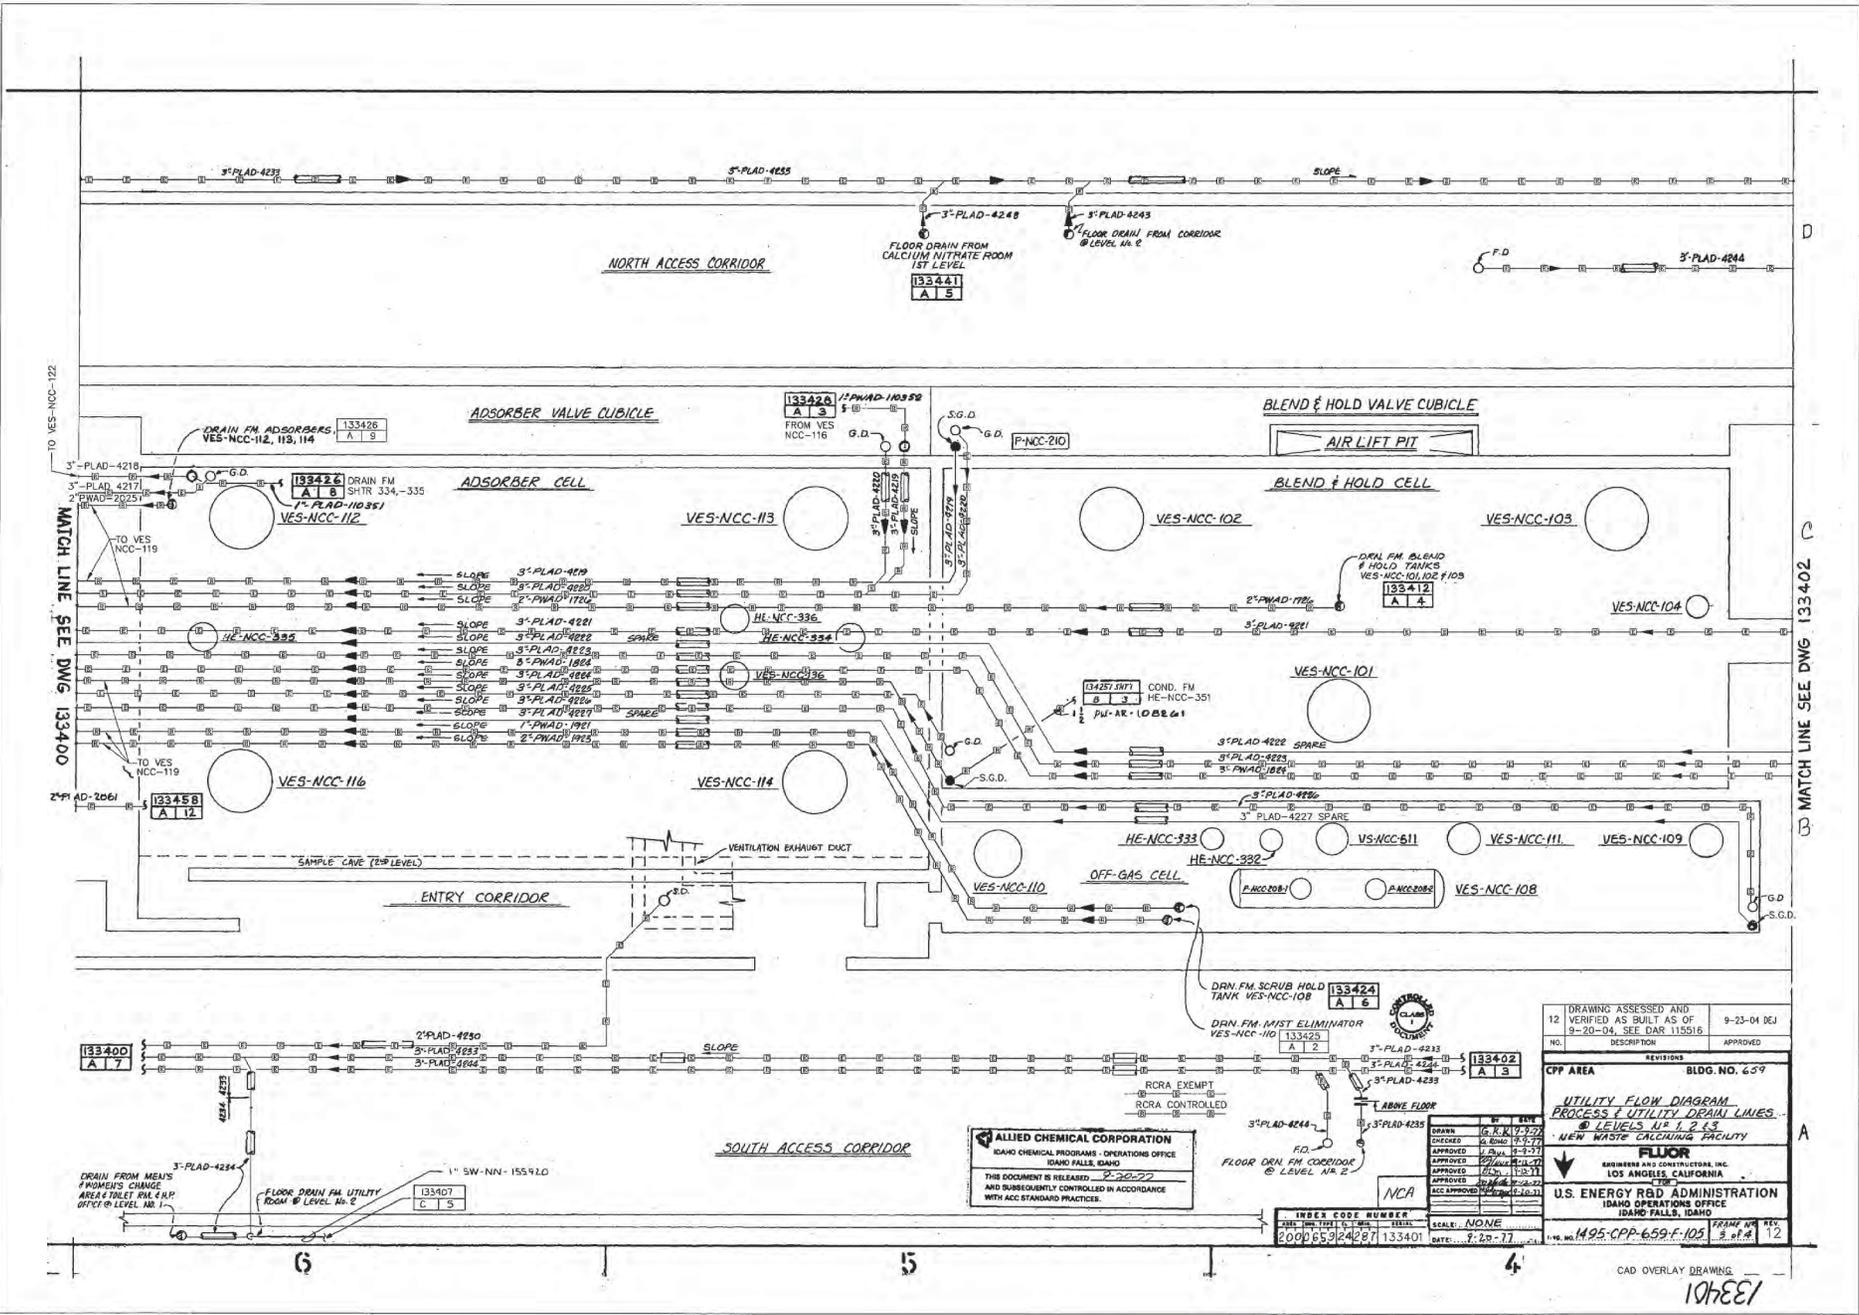

MATCH LINE SEE DWG. 133400

MATCH LINE SEE DWG. 133402

ALLIED CHEMICAL CORPORATION
 IDAHO CHEMICAL PROGRAM OPERATIONS OFFICE
 IDAHO FALLS, IDAHO
 THIS DOCUMENT IS RELEASED: 2-20-77
 AND SUBSEQUENTLY CONTROLLED IN ACCORDANCE
 WITH ACC. STANDARD PRACTICES.

DRAWING ASSESSED AND 12 VERIFIED AS BUILT AS OF 9-20-04, SEE DAR 115516		9-23-04 DEJ
NO.	DESCRIPTION	APPROVED
REVISIONS		
CPP AREA		BLDG. NO. 639
UTILITY FLOW DIAGRAM PROCESS & UTILITY DRAIN LINES LEVELS N° 1, 2 & 3 NEW WASTE CLEANING FACILITY		
FLUOR		
ENGINEERS AND CONSTRUCTORS, INC. LOS ANGELES, CALIFORNIA		
U.S. ENERGY R&D ADMINISTRATION IDAHO OPERATIONS OFFICE IDAHO FALLS, IDAHO		
INDEX CODE NUMBER 200065324287	SCALE: NONE DATE: 9-29-77	FRAME NO. REV. 12

CAD OVERLAY DRAWING
10/28/07

AG-NCD-427
DECON TANK AGITATOR

SCL-NCD-936-1
CHEMICAL SCALE


VES-NCD-127
DECON SOLN MAKE-UP TANK
48" DIA. X 5'-0" T-7
DESIGN: 0.2 PSIG, 0.2 PSI W.C. @ 175°F
INSULATION
VESSEL TRIM LINE NO. 5009

P-NCD-227
DECON SOLN PUMP
CAPACITY: 30 GPM
PRESSURE: 0-100 PSIG
NO INSULATION

VES-NCD-128
DECON SOLN MAKE-UP TANK
48" DIA. X 5'-0" T-7
DESIGN: 0.2 PSIG, 0.2 PSI W.C. @ 175°F
INSULATION
VESSEL TRIM LINE NO. 5009

P-NCD-228
DECON SOLN PUMP
CAPACITY: 30 GPM
PRESSURE: 0-100 PSIG
NO INSULATION

AG-NCD-428
DECON TANK AGITATOR

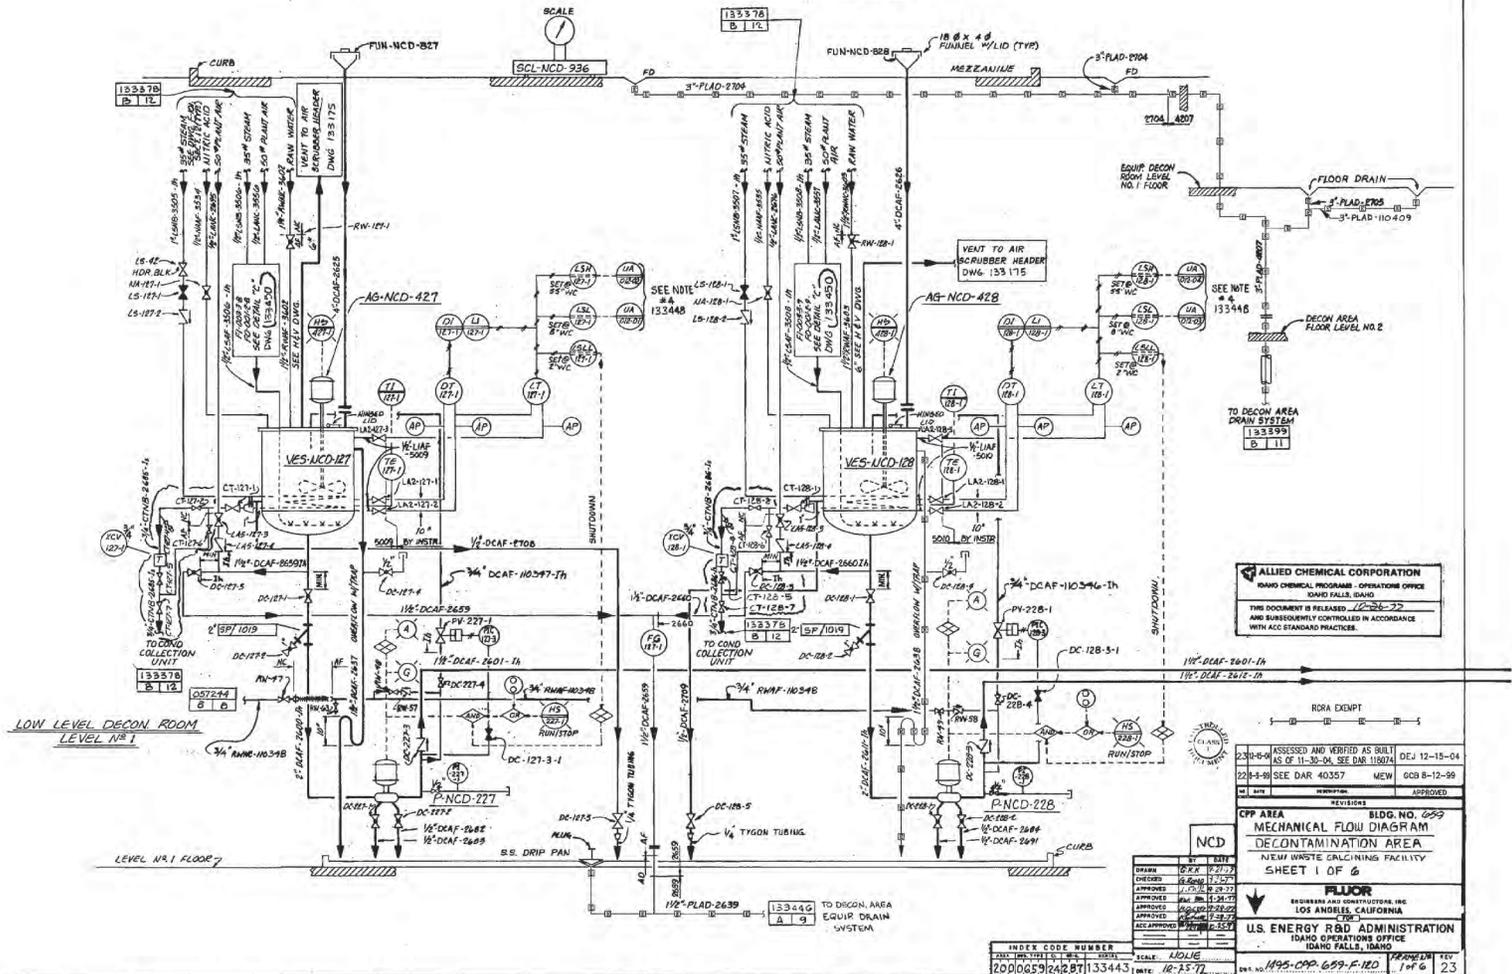

ALLIED CHEMICAL CORPORATION
RADIO CHEMICAL PROGRAM - OPERATIONS OFFICE
IDAHO FALLS, IDAHO
THIS DOCUMENT IS RELEASED UNDER E.O. 12812-22
AND SUBSEQUENTLY CONTROLLED IN ACCORDANCE
WITH ACC STANDARD PRACTICES.

RORA EXCPT


ASSESSED AND VERIFIED AS BUILT AS OF 11-30-04. SEE DAR 118074
22-8-88 SEE DAR 40357 MEW GCB 8-12-99
DATE: 11/30/04 APPROVED:

CPA AREA BLDG. NO. 659
MECHANICAL FLOW DIAGRAM
DECONTAMINATION AREA
NEW WASTE CALCINING FACILITY
SHEET 1 OF 6

FLUOR
ENGINEERS AND ARCHITECTS, INC.
LOS ANGELES, CALIFORNIA

U.S. ENERGY RESEARCH ADMINISTRATION
IDAHO OPERATIONS OFFICE
IDAHO FALLS, IDAHO

INDEX CODE NUMBER
200106592428 BT 133443
SCALE: NONE
DATE: 12-25-77
REV: 1495-CPA-659-F-180
1 of 6 23

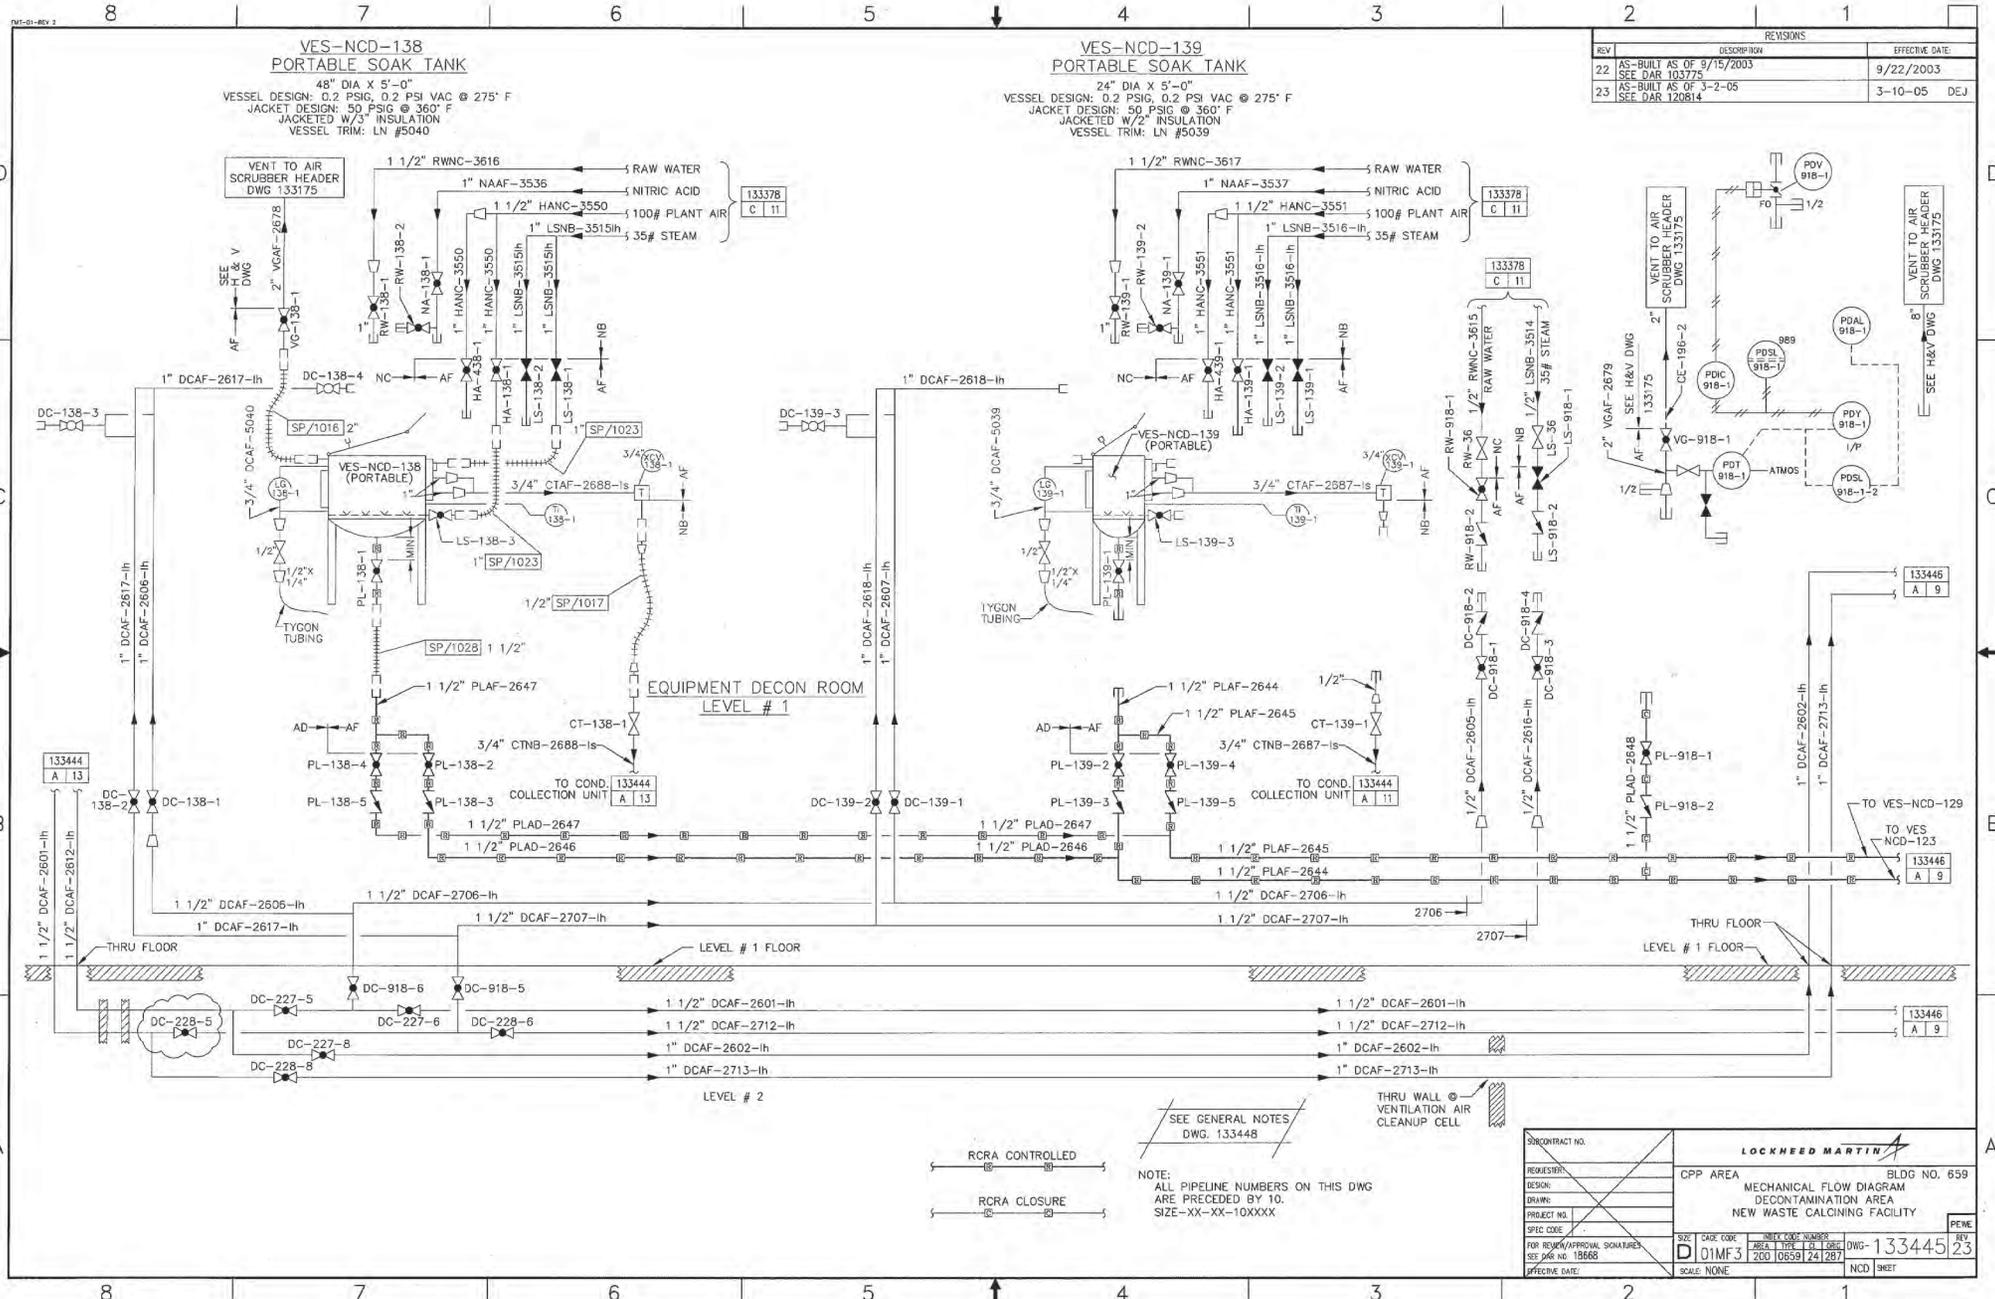

VES-NCD-138
PORTABLE SOAK TANK
 48" DIA X 5'-0"
 VESSEL DESIGN: 0.2 PSIG, 0.2 PSI VAC @ 275° F
 JACKET DESIGN: 50 PSIG @ 360° F
 JACKETED W/3" INSULATION
 VESSEL TRIM: LN #5040

VES-NCD-139
PORTABLE SOAK TANK
 24" DIA X 5'-0"
 VESSEL DESIGN: 0.2 PSIG, 0.2 PSI VAC @ 275° F
 JACKET DESIGN: 50 PSIG @ 360° F
 JACKETED W/2" INSULATION
 VESSEL TRIM: LN #5039


REVISIONS		
REV	DESCRIPTION	EFFECTIVE DATE
22	AS-BUILT AS OF 9/15/2003 SEE DAR 103372	9/22/2003
23	AS-BUILT AS OF 3-2-05 SEE DAR 120814	3-10-05 DEJ

RCRA CONTROLLED
 RCRA CLOSURE

NOTE:
 ALL PIPELINE NUMBERS ON THIS DWG
 ARE PRECEDED BY 10.
 SIZE-XX-XX-10XXXX

CONTRACT NO.		LOCKHEED MARTIN	
REQUISITION	CPP AREA	BLDG NO. 659	
DESIGN	MECHANICAL FLOW DIAGRAM		
DRAWN	DECONTAMINATION AREA		
PROJECT NO.	NEW WASTE CALCINING FACILITY		
SPEC CODE	DATE CODE	UNIT CIRC. NUMBERS	REV
FOR REVIEW/APPROVAL SIGNATURES	D 01MF3	AREA TYPE BY DATE	DWG-133445 23
SEE DAR NO. 18666	SCALE: NONE	200 10639 24 287	NCD SHEET
EFFECTIVE DATE:			

JET-NCD-554
 DECON CELL
 SUMP DRAIN JET

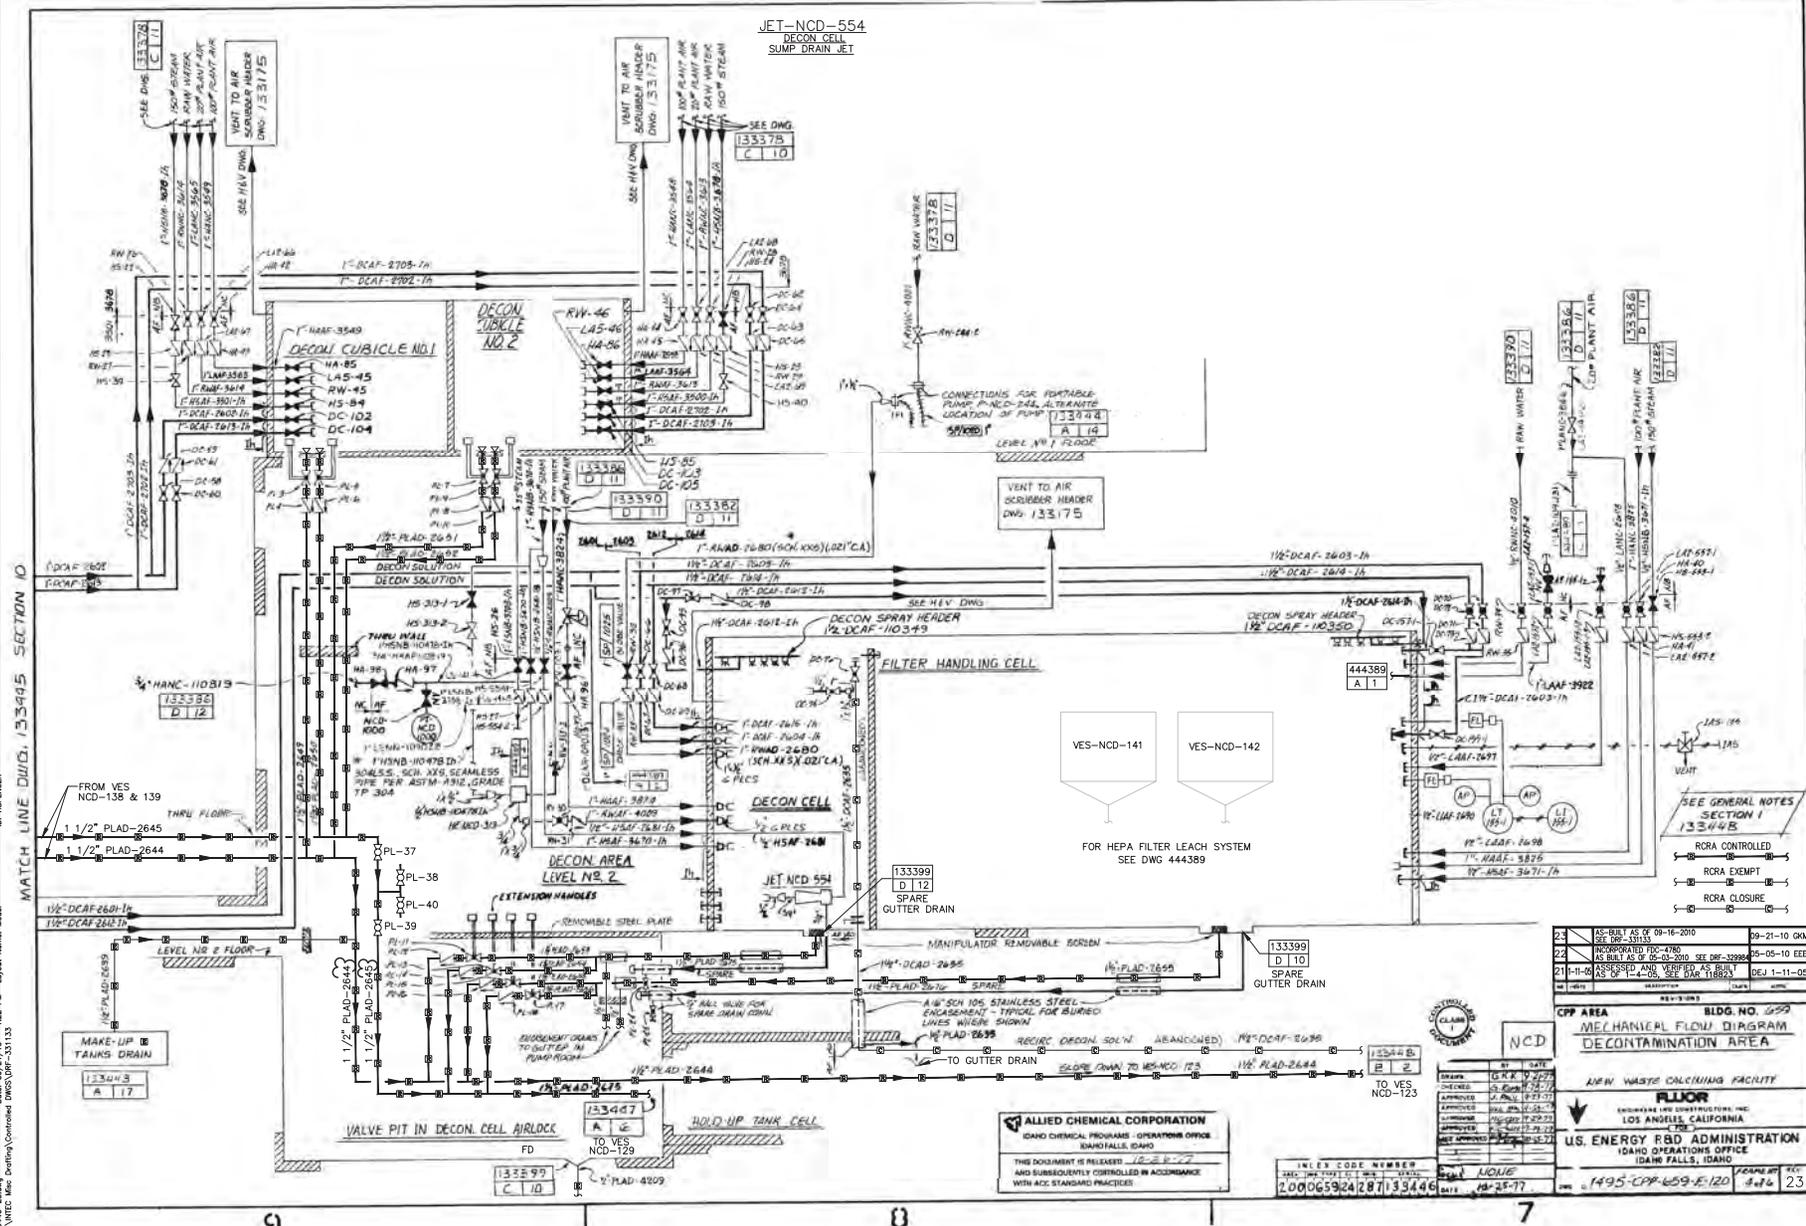

SEE GENERAL NOTES
 SECTION I
 133448

RORA CONTROLLED
 RORA EXEMPT
 RORA CLOSURE

20	AS-BUILT AS OF 09-16-2010	20-21-10 GM
21	AS-BUILT AS OF 05-03-2010	20-05-10 EEE
22	INCORPORATED 08-07-00	20-05-10 EEE
21-11-00	AS-BUILT AS OF 04-06, SEE DWG 118853	DEJ 1-11-05

CPP AREA BLDG. NO. 6599
 MECHANICAL FLOW DIAGRAM
 DECONTAMINATION AREA

NEW WASTE COLLECTING FACILITY

FLUOR
 ENGINEERING AND CONSTRUCTION, INC.
 LOS ANGELES, CALIFORNIA

U.S. ENERGY RESEARCH AND DEVELOPMENT ADMINISTRATION
 IDAHO OPERATIONS OFFICE
 IDAHO FALLS, IDAHO

ALLIED CHEMICAL CORPORATION
 IDAHO CHEMICAL PROGRAMS - OPERATIONS OFFICE
 SAND HILLS, IDAHO


THIS DOCUMENT IS RELEASED UNDER THE ATOMIC ENERGY ACT OF 1954 AND IS HEREBY RELEASED IN ACCORDANCE WITH THE ATOMIC ENERGY ACT OF 1954 AND IS HEREBY RELEASED IN ACCORDANCE WITH THE ATOMIC ENERGY ACT OF 1954

INDEX CODE NUMBER
 200065924287133446

DATE 10-25-77
 1495-CPP-659-E-120 3 of 6 23

MATCH LINE DWG. 133445 SECTION 10

Drawn: K. N. K. 10/25/77, Checked: J. M. J. 10/25/77, Layout: K. N. K. 10/25/77, Plot: K. N. K. 10/25/77, Title: DECONTAMINATION AREA MECHANICAL FLOW DIAGRAM

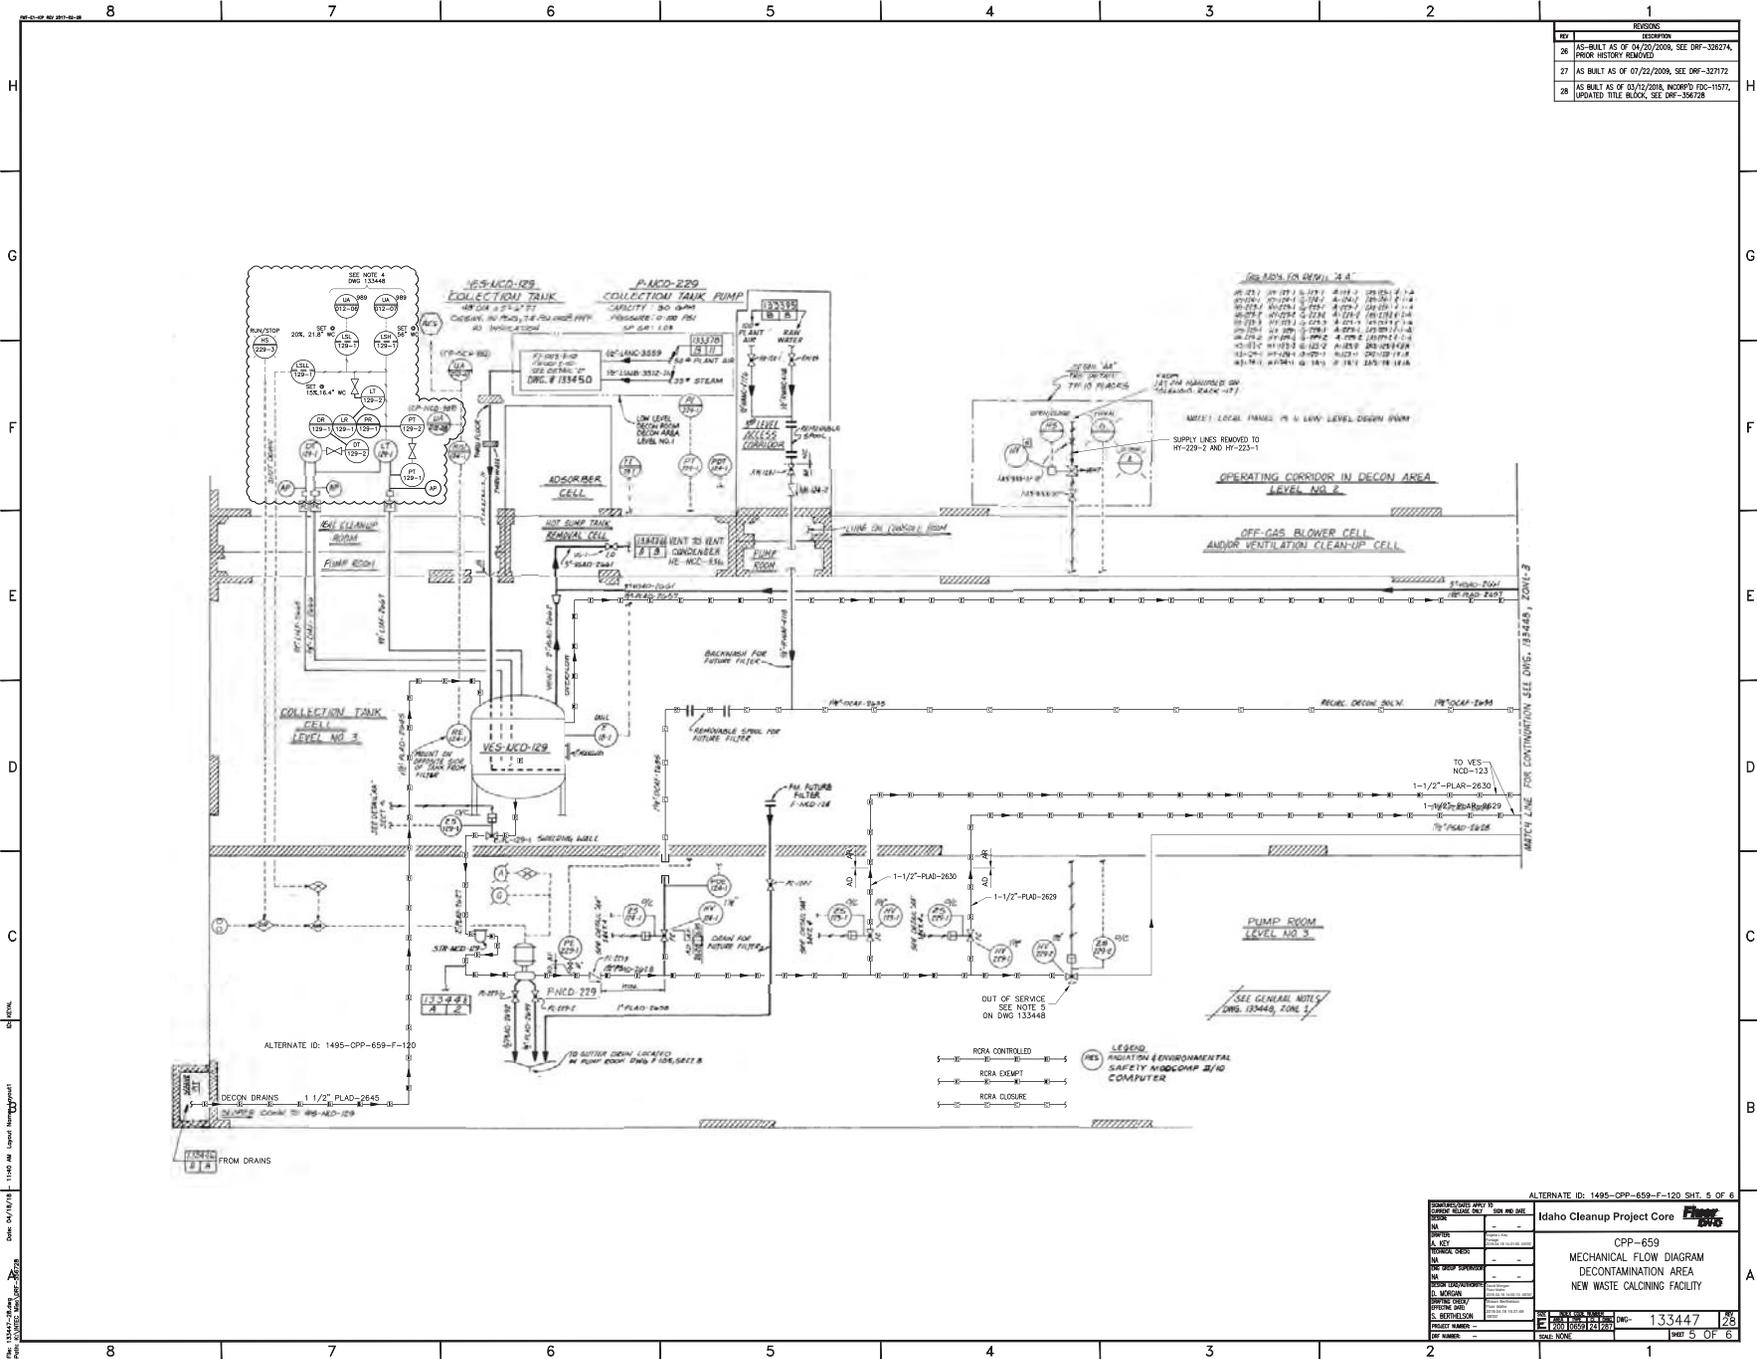


REVISION	
REV	DESCRIPTION
26	AS-BUILT AS OF 04/20/2006, SEE DRW-328274, PROH. HISTORY REMOVED
27	AS BUILT AS OF 07/22/2006, SEE DRW-327172
28	AS BUILT AS OF 03/12/2008, INCORP'D FDC-1157, UPDATED TITLE BLOCK, SEE DRW-356728

Date: 04/19/08 1:10:00 PM User: hmpj/ast
 Plot: 133447.dwg, Sheet: 28 of 28

ALTERNATE ID: 1495-OPP-659-F-120 SHT. 5 OF 6


ILLINOIS INSTITUTE OF TECHNOLOGY 707 North Central Expressway Urbana, IL 61820-7003 Phone: (618) 241-1600 Fax: (618) 241-1601 E-mail: iist@iit.edu		Idaho Cleanup Project Core Flow Diagrams
CPP-659 MECHANICAL FLOW DIAGRAM DECONTAMINATION AREA NEW WASTE CALCINING FACILITY		133447 28 SHEET 5 OF 6

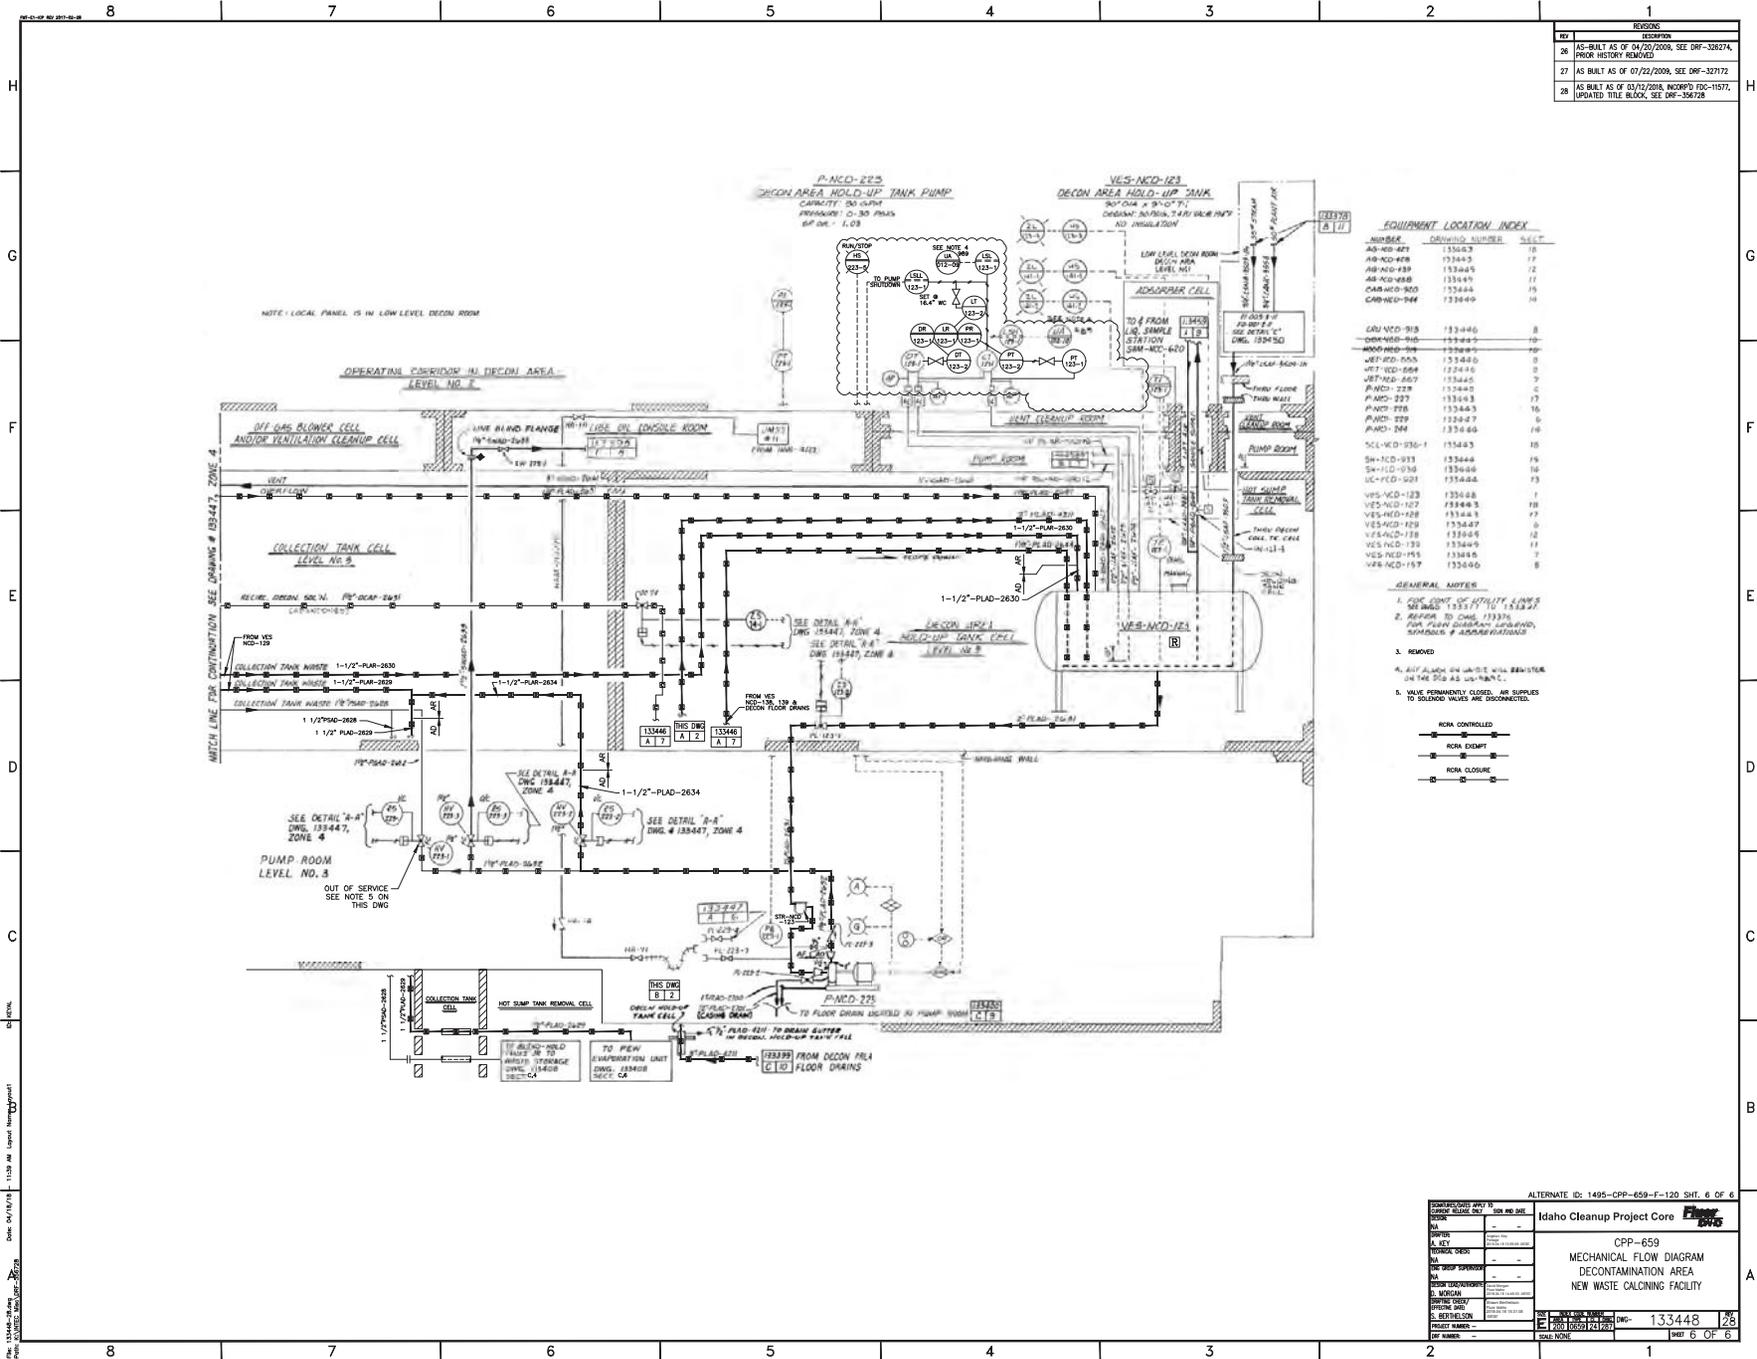

REVISION	
NO.	DESCRIPTION
26	AS-BUILT AS OF 04/20/2009, SEE DRP-328274, PROH. HISTORY REMOVED
27	AS BUILT AS OF 07/22/2009, SEE DRP-327172
28	AS BUILT AS OF 03/12/2010, INCORP'D FDC-11571, UPDATED TITLE BLOCK, SEE DRP-356728

EQUIPMENT LOCATION INDEX		
SYMBOL	DESCRIPTION	SHEET
AS-NCD-001	133443	16
AS-NCD-008	133443	17
AS-NCD-039	133449	12
AS-NCD-068	133449	17
CAS-NCD-000	133444	15
CAS-NCD-044	133449	16
CAU-NCD-018	133446	8
DM-NCD-010	133449	10
DM-NCD-008	133449	10
VEP-NCD-000	133446	9
VEP-NCD-006	133446	9
VEP-NCD-007	133446	9
P-NCD-223	133440	8
P-NCD-227	133443	17
P-NCD-228	133443	16
P-NCD-229	133447	6
P-NCD-244	133446	16
SCL-NCD-036-1	133443	16
SM-NCD-015	133444	16
SM-NCD-036	133446	16
UC-NCD-001	133444	13
VES-NCD-123	133448	1
VES-NCD-127	133448	18
VES-NCD-128	133448	17
VES-NCD-129	133447	6
VES-NCD-130	133449	12
VES-NCD-131	133448	7
VES-NCD-137	133446	11


- GENERAL NOTES:
1. SEE CONT. OF UTILITY LINES SEE DWG. 133447 TO 133457
 2. REFER TO DWG. 133434 FOR PUMP DISCONNECT LABELING, SYMBOLS & ADDRESSING
 3. REMOVED
 4. ALL JUNCTIONS AND UNITS WILL BE INSTALLED IN THE FIELD AND WELDED
 5. VALVE PERMANENTLY CLOSED, AIR SUPPLIES TO SOLVED VALVES ARE DISCONNECTED

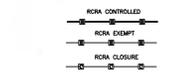


ALTERNATE ID: 1495-CPP-659-I-120 SHT. 6 OF 6

ILLINOIS STATE ENGINEERING & SURVEYING BOARD LICENSE NO. 0299723 R23		Idaho Cleanup Project Core Flow Diagram
PROJECT NO. 133448 SHEET NO. 28 OF 28		CPP-659 MECHANICAL FLOW DIAGRAM DECONTAMINATION AREA NEW WASTE CALCINING FACILITY
PROJECT ENGINEER S. BROWN		DATE: 03/12/2010
PROJECT MANAGER S. BROWN		SHEET 6 OF 6

DATE: 04/16/10 BY: 1128 MR. JAMES HENNING

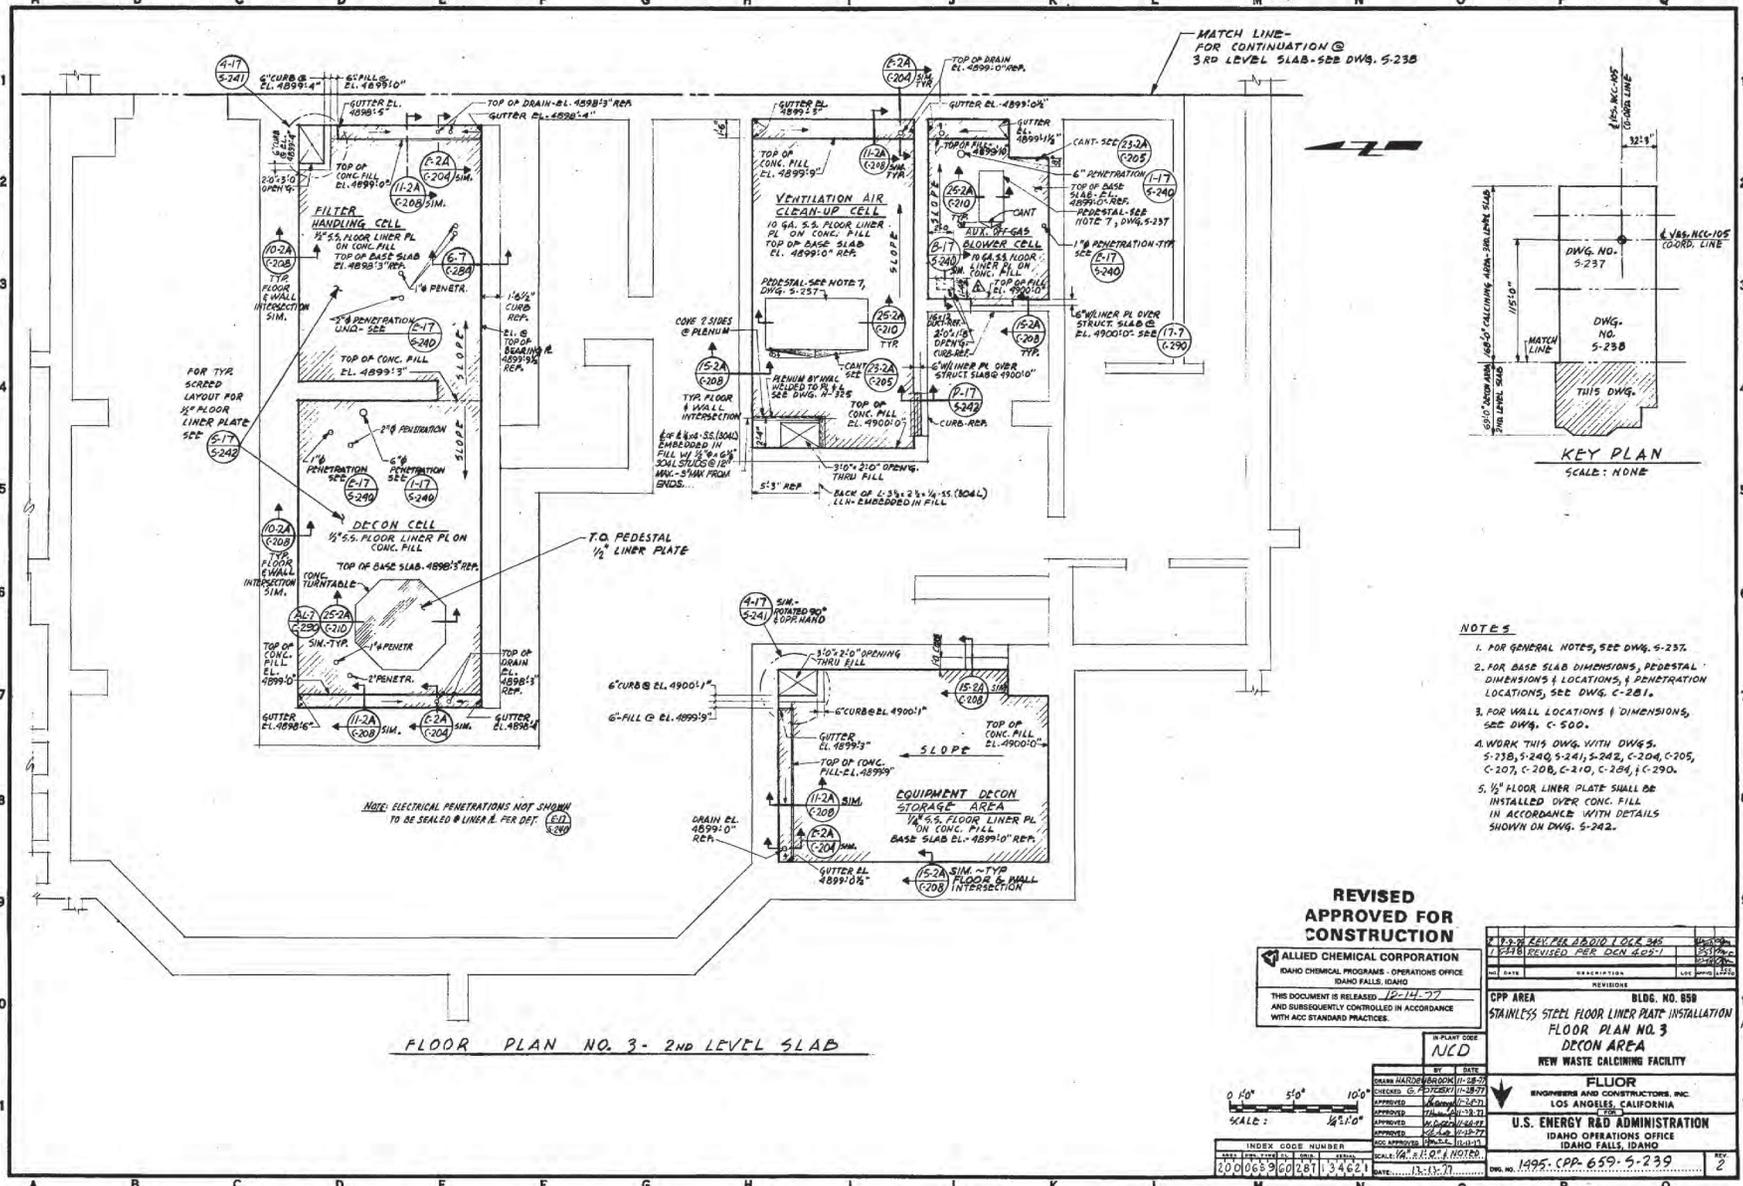

FLOOR PLAN NO. 3- 2ND LEVEL SLAB

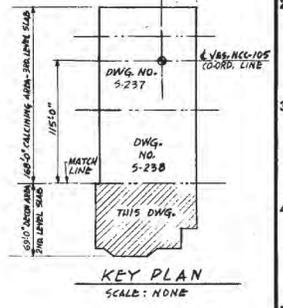

- NOTES**
1. FOR GENERAL NOTES, SEE DWG. 5-237.
 2. FOR BASE SLAB DIMENSIONS, PEDESTAL DIMENSIONS & LOCATIONS, & PENETRATION LOCATIONS, SEE DWG. C-281.
 3. FOR WALL LOCATIONS & DIMENSIONS, SEE DWG. C-500.
 4. WORK THIS DWG. WITH DWGS. 5-238, 5-240, 5-241, 5-242, C-204, C-205, C-207, C-208, C-210, C-206, & C-290.
 5. 1/2" FLOOR LINER PLATE SHALL BE INSTALLED OVER CONC. FILL IN ACCORDANCE WITH DETAILS SHOWN ON DWG. 5-242.

REVISED APPROVED FOR CONSTRUCTION

ALLIED CHEMICAL CORPORATION
 IDAHO CHEMICAL PROGRAMS - OPERATIONS OFFICE
 IDAHO FALLS, IDAHO

THIS DOCUMENT IS RELEASED 12-14-77
 AND SUBSEQUENTLY CONTROLLED IN ACCORDANCE
 WITH ACC STANDARD PRACTICES.

DATE	BY	DATE
12-14-77	DEAN HARRISON	11-28-77
12-14-77	CHUCK G. PETERSON	11-28-77
12-14-77	APPROVED	12-14-77

INDEX CODE NUMBER
 001063306281134621

SCALE: 1/8" = 1'-0" (SEE NOTE)

DATE: 12-13-77


NO. 1495 CPP-659-5-239

CPP AREA BLDG. NO. 859
STAINLESS STEEL FLOOR LINER PLATE INSTALLATION
FLOOR PLAN NO. 3
DECON AREA
NEW WASTE CALCINING FACILITY

FLUOR
 ENGINEERS AND CONSTRUCTORS, INC.
 LOS ANGELES, CALIFORNIA

U.S. ENERGY R&D ADMINISTRATION
 IDAHO OPERATIONS OFFICE
 IDAHO FALLS, IDAHO

129751





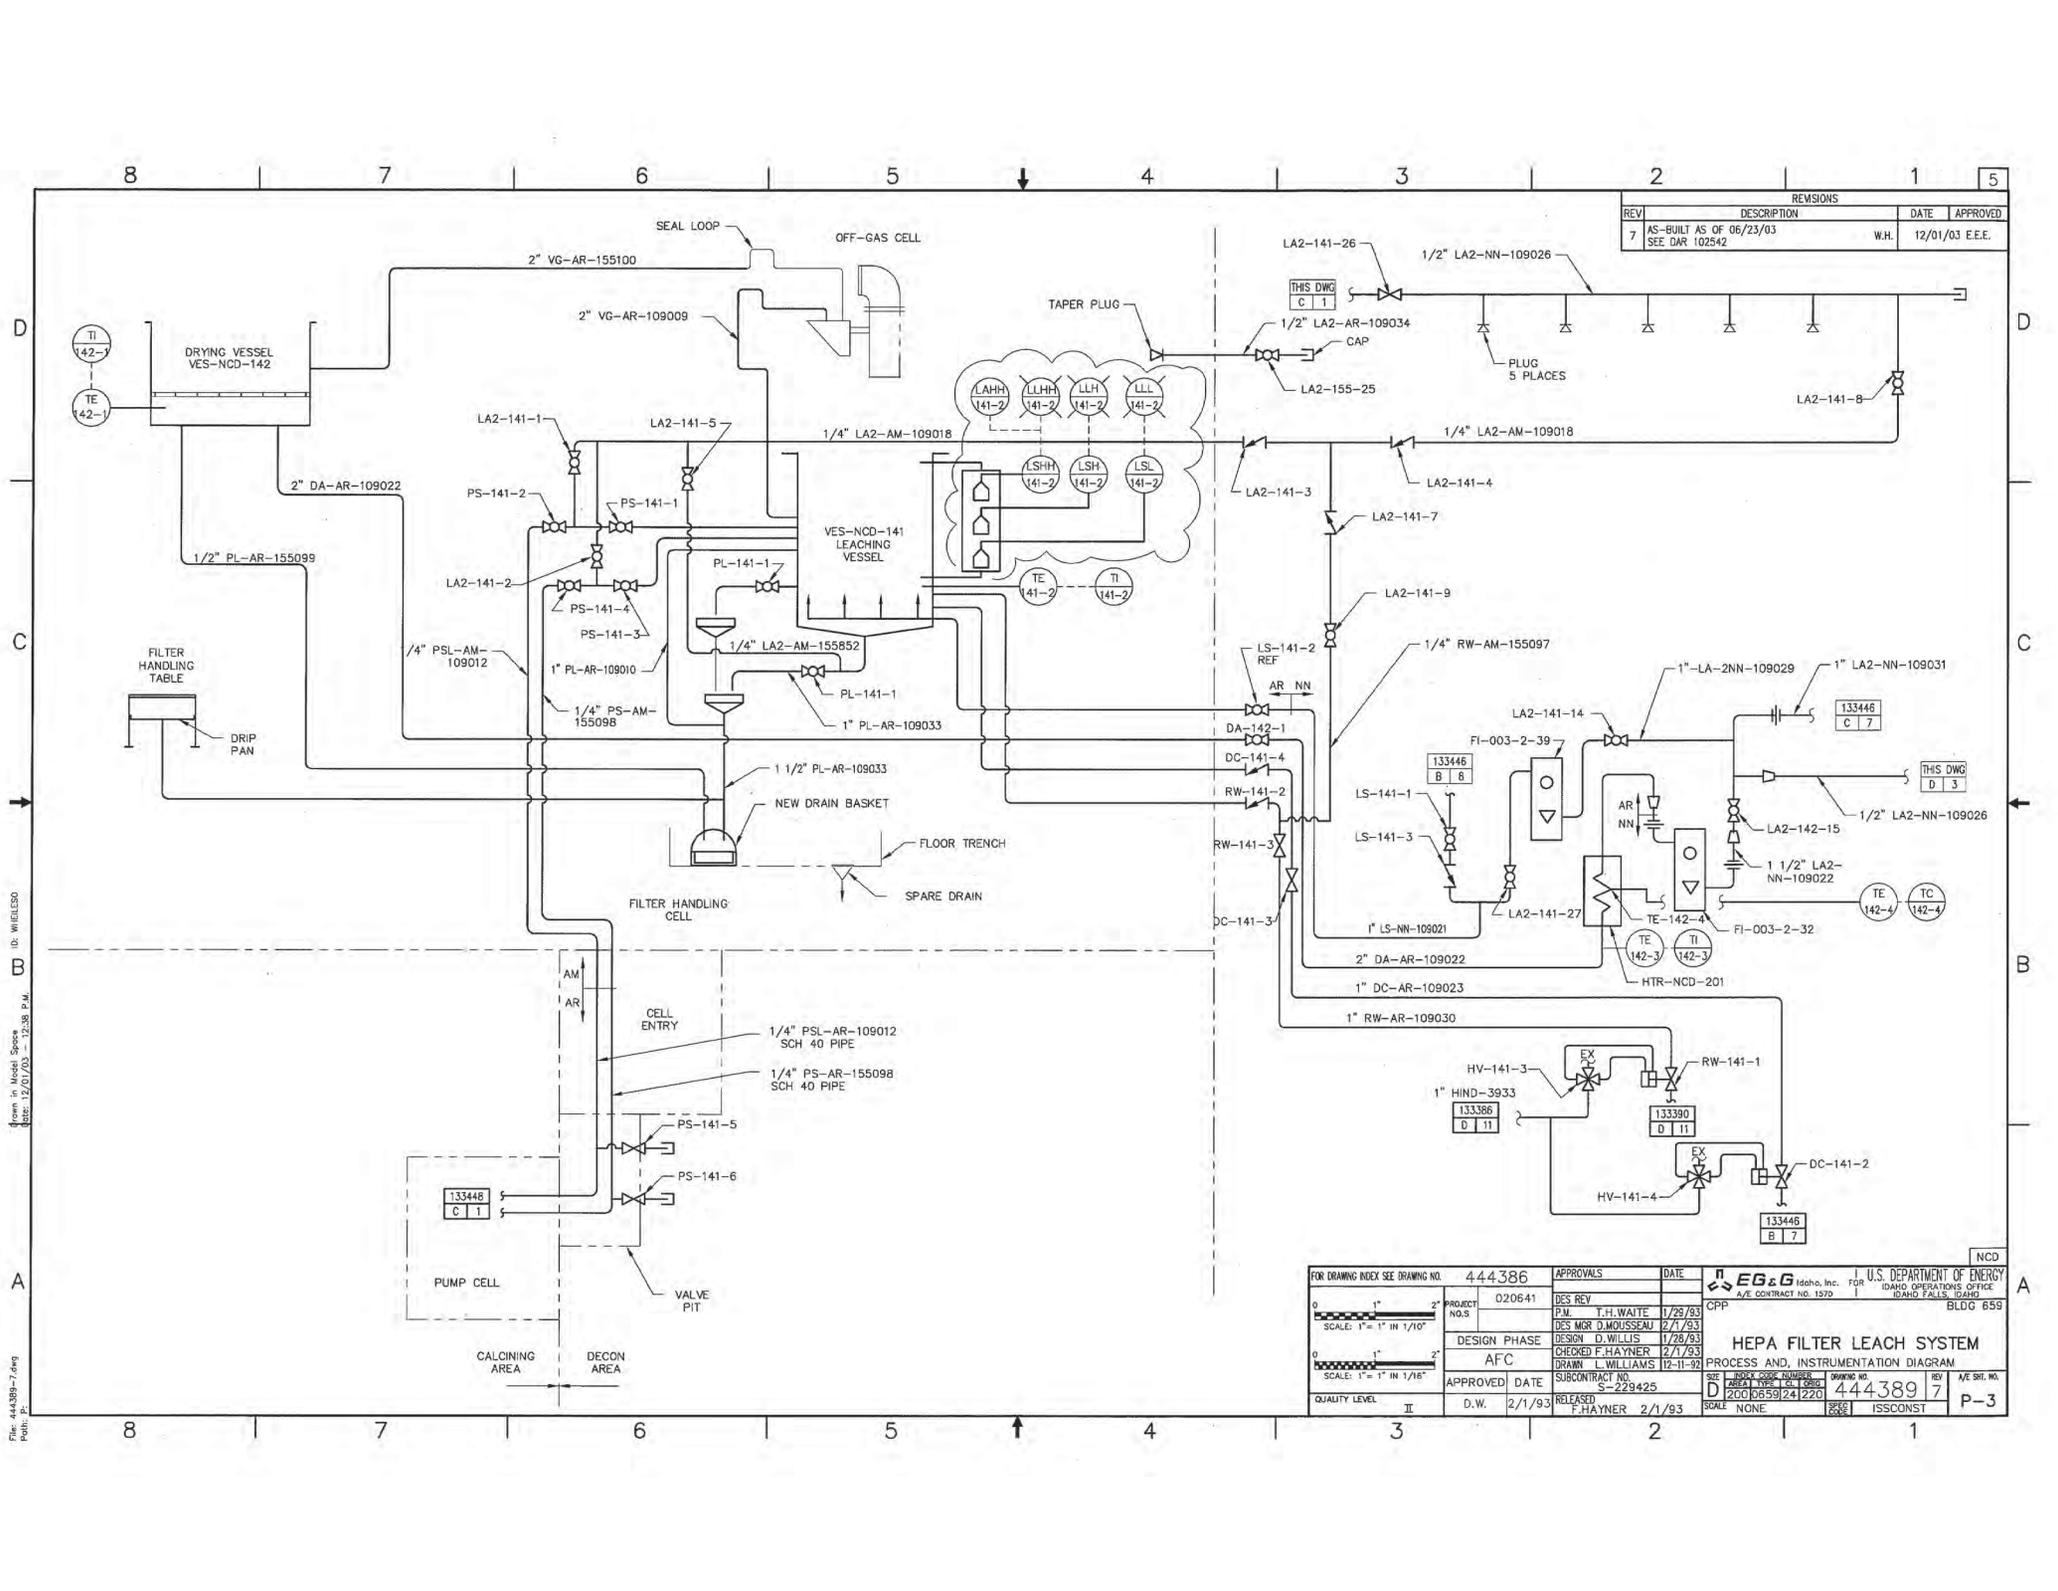


REVISIONS			
REV	DESCRIPTION	DATE	APPROVED
7	AS-BUILT AS OF 06/23/03 SEE DAR 102542	W.H.	12/01/03 E.E.E.

FOR DRAWING INDEX SEE DRAWING NO. 444386		APPROVALS		DATE	Idaho, Inc. U.S. DEPARTMENT OF ENERGY A/E CONTRACT NO. 1570 FOR IDAHO OPERATIONS OFFICE BLDG 659
PROJECT NO. 020641	DES. REV.	T.H. WAITE		1/28/93	
SCALE: 1" = 1" IN 1/10"	DESIGN PHASE	DES. MGR. D. MOUSSEAU		2/1/93	HEPA FILTER LEACH SYSTEM PROCESS AND INSTRUMENTATION DIAGRAM DRAWN L. WILLIAMS 12-11-92 CHECKED F. HAYNER 2/1/93 DESIGN D. WILLIS 1/28/93 SUBCONTRACT NO. S-229425 APPROVED DATE 2/1/93 RELEASED F. HAYNER 2/1/93
SCALE: 1" = 1" IN 1/16"	AFC	DRAWN L. WILLIAMS		12-11-92	
QUALITY LEVEL II	D.W.	S-229425		2/1/93	
		F. HAYNER		2/1/93	
		D. MOUSSEAU		1/28/93	SIZE: 11 1/2" X 17" X 1/8" 2000859 24 220 SCALE: NONE ISSCONST
		D. WILLIS		1/28/93	
		L. WILLIAMS		12-11-92	DRAWING NO. 444389 REV. 7 SHEET NO. P-3

ID: WHELSDO
 From: Michel Spore, 12:58 p.m.
 Date: 12/02/03

REVISIONS			
REV	DESCRIPTION	DATE	APPROVED
3	PER DCN #167361-AB24	LTR 8/26/93	AD

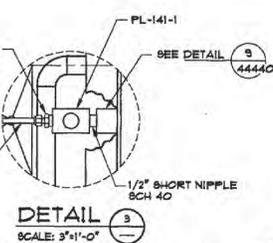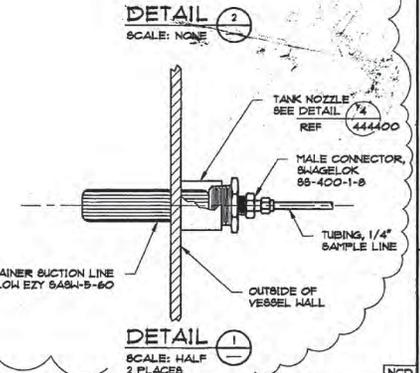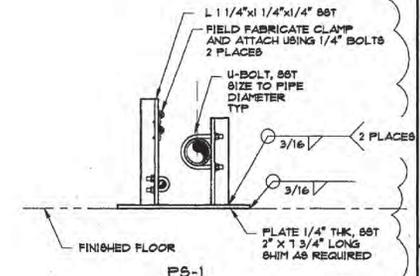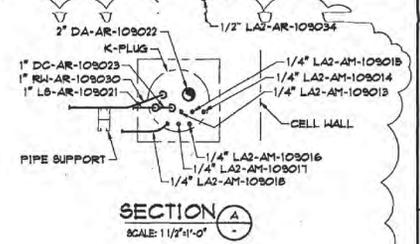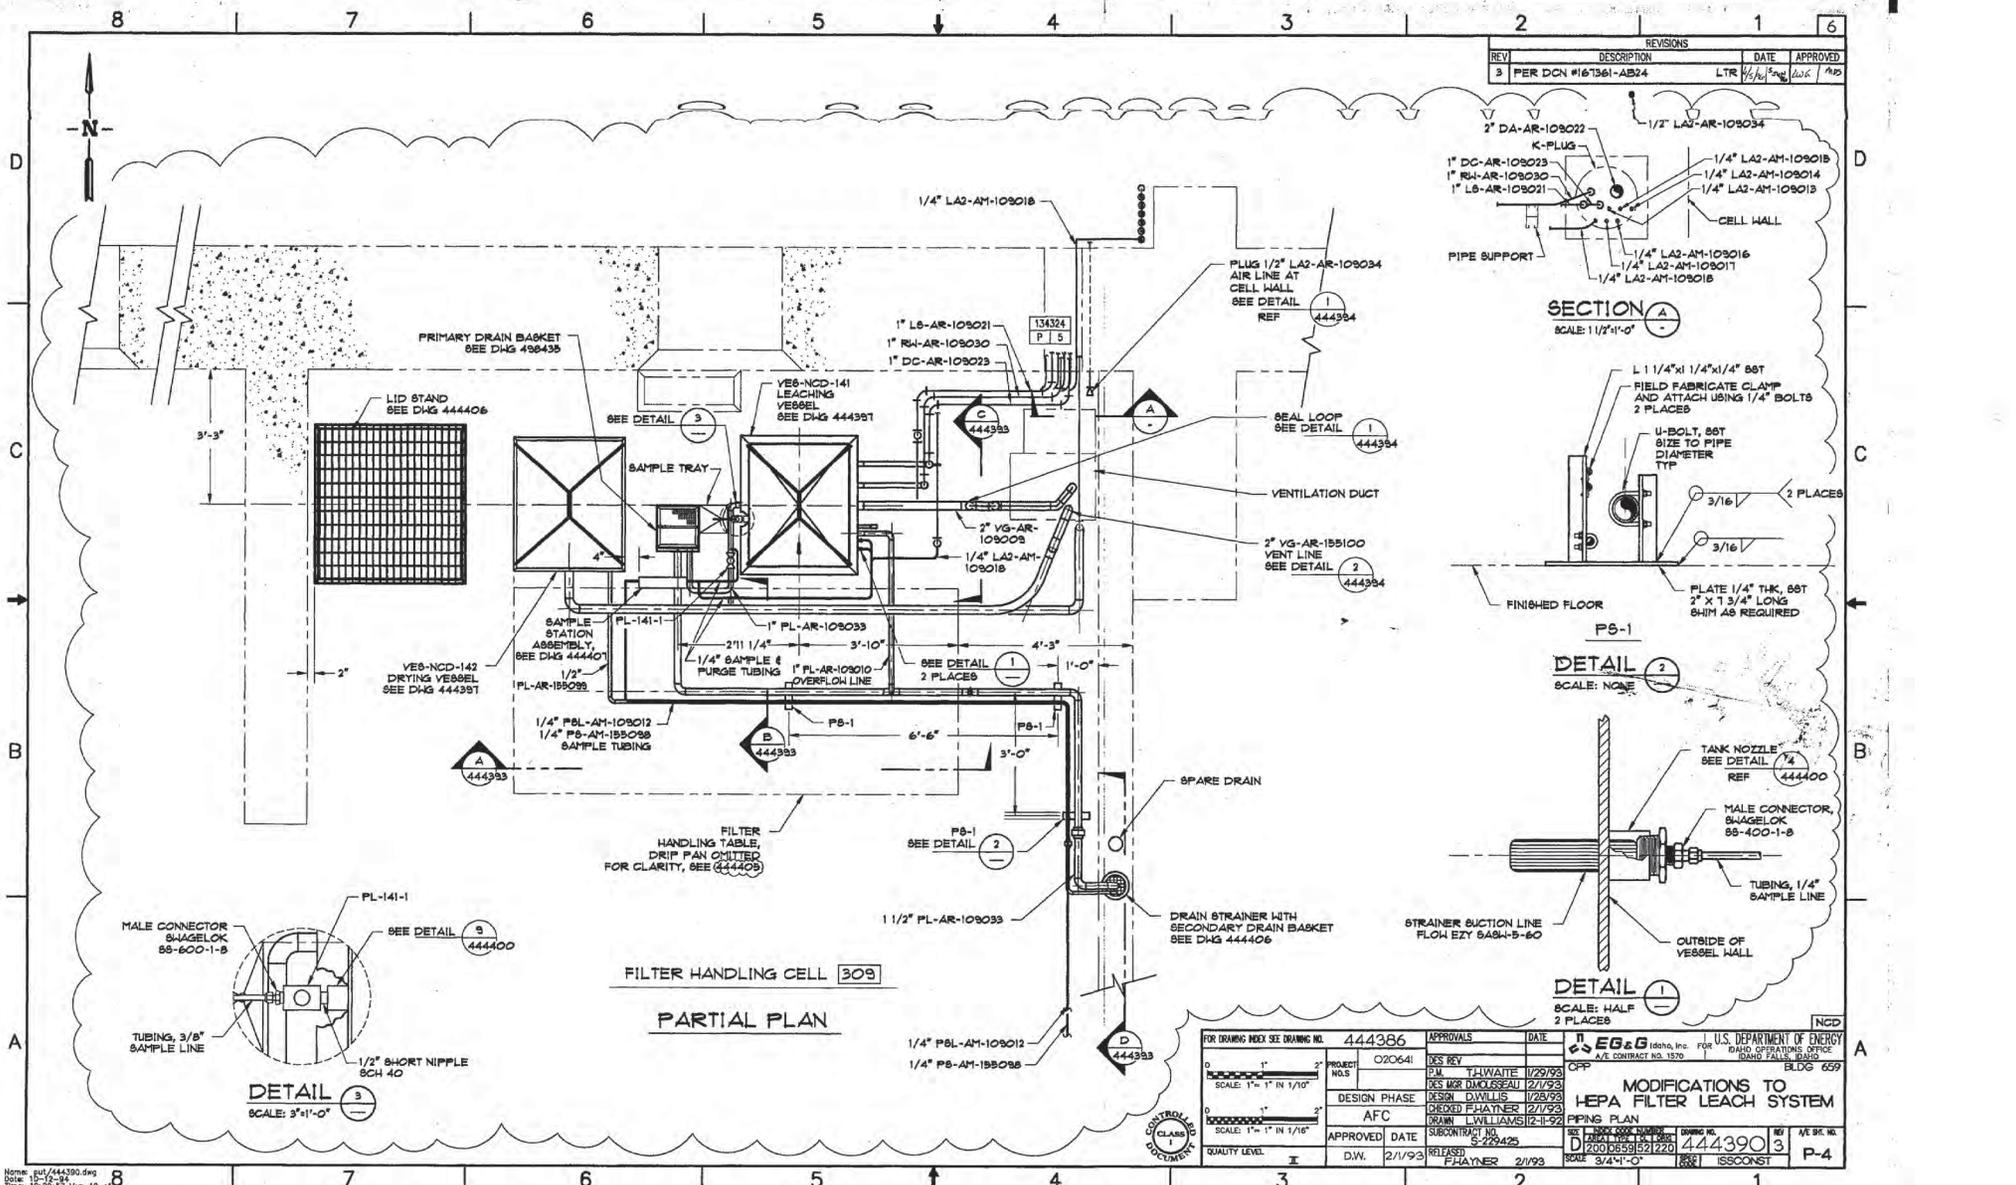


FOR DRAWING INDEX SEE DRAWING NO. 444386	APPROVALS	DATE	EG&G	U.S. DEPARTMENT OF ENERGY
PROJECT NO. 020641	DES REV	1/29/93	16th, Inc.	HEALTH, SAFETY & ENVIRONMENTAL OPERATIONS OFFICE
SCALE: 1" = 1' IN 1/10"	P.M. THWAITE	2/1/93	AVE CONTRACT NO. 1570	DAWG FALLS, MISSOURI
DESIGN PHASE	DESIGN	2/1/93	CFP	BLDG 659
AFC	DESIGNER	2/1/93		
SCALE: 1" = 1' IN 1/16"	DRIVER	2/1/93		
APPROVED	DATE	2/1/93		
QUALITY LEVEL	D.W.	2/1/93		
	RELEASED	2/1/93		
	ISSUED	2/1/93		

REVISIONS		EFFECTIVE DATE:
REV	DESCRIPTION	
3	ASSESSED AND VERIFIED AS BUILT AS OF 11-30-04 SEE DAR 118074	12-15-04 DEJ

3" FIRE WATER

FROM FIRE WATER HEADER
6" FW-107518

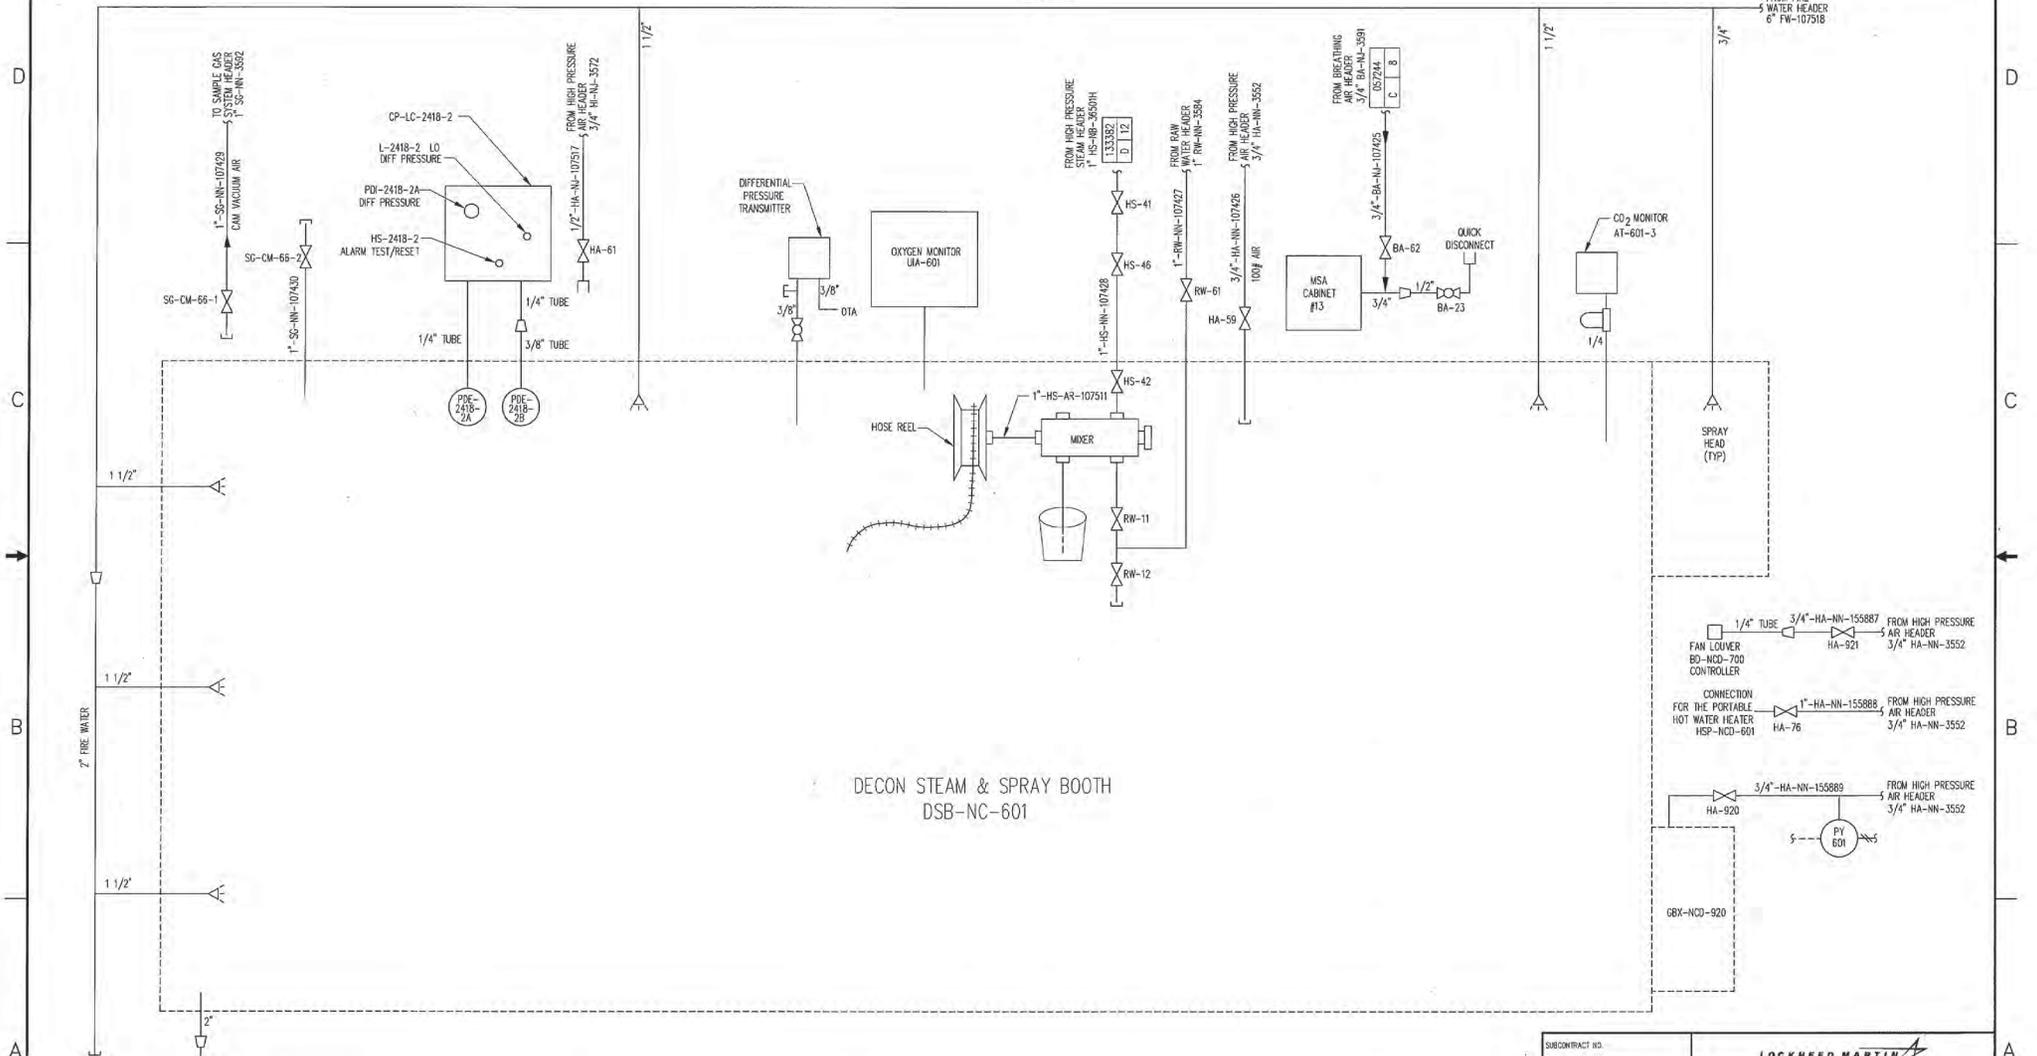

DECON STEAM & SPRAY BOOTH
DSB-NC-601


REF DWG
133378

SUBCONTRACT NO.		LOCKHEED MARTIN	
REQUESTER: M.R. GREEN	DESIGN: V. LOSELLE	CPP-659	
PROJECT NO.	PROJECT NO.	NWCF TRUCK BAY	
PROJECT NO.	PROJECT NO.	DECON SPRAY BOOTH	
PROJECT NO.	PROJECT NO.	DSB-NC-601	
PROJECT NO.	PROJECT NO.	P&ID	
FOR REVIEW/APPROVAL SIGNATURES	DATE	DATE	DATE
SEE DAR NO. 18089	01MF3	200 10559 241530	DWG-097870 3
EFFECTIVE DATE: 4/12/99 MEL	SCALE: NONE	NC	SHEET 1 OF 1


File: 097877-2.DWG
 Plot: 0
 Date: 11/04/03 07:39 A.M.
 User: KRESS
 ID: KRESS

2	1	SHEET	REV STATUS
2	2	REV	OF SHEETS


REVISIONS		
REV	DESCRIPTION	EFFECTIVE DATE
-	REPLACES DWG 094626 REV 1, DWG 094629 REV 1, AND DWG 094630 REV 1 SEE DAR 18246	MEL 4-13-99
1	SEE DAR #41392 W.O. SSB	AJR 10-5-99 MEL 10-21-99
2	SEE DAR 106213	WKJ DEJ 11-5-03

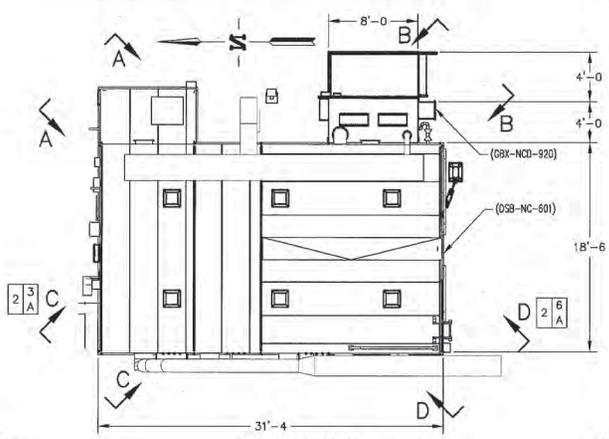

PLAN VIEW
SCALE: 3/16"=1'-0"

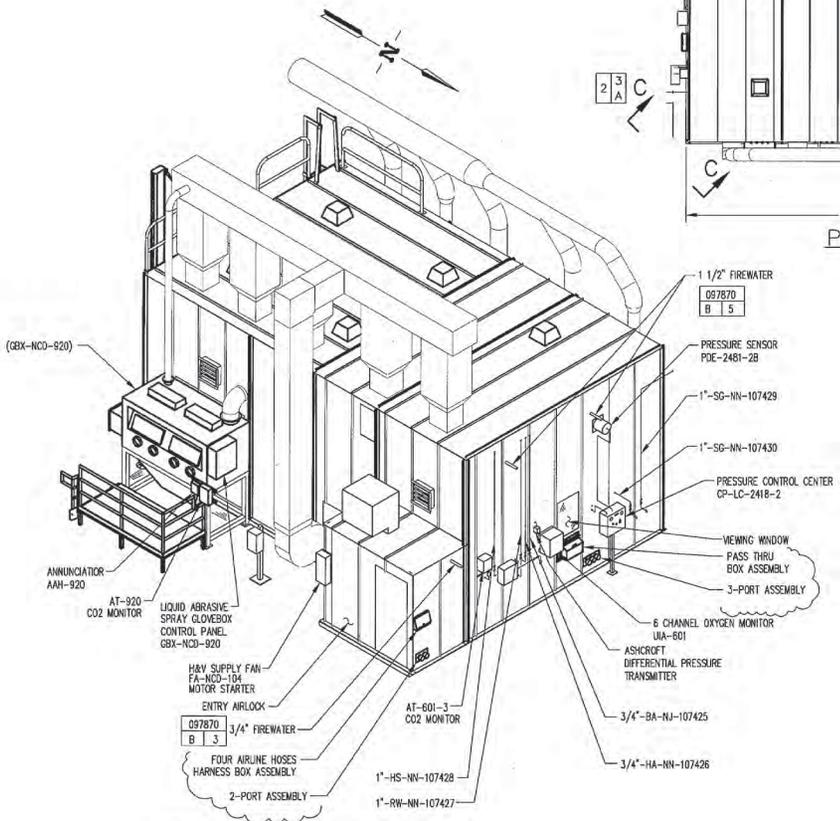

VIEW A-A (NORTHEAST ELEVATION)
SCALE: 1/4"=1'-0"

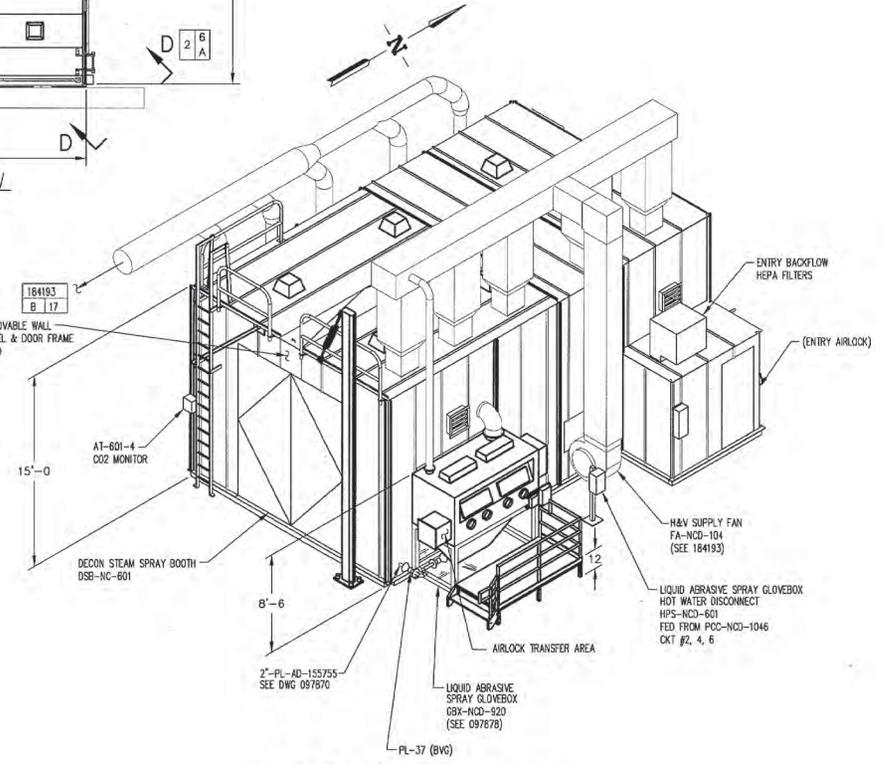

VIEW B-B (SOUTHEAST ELEVATION)
SCALE: 1/4"=1'-0"

SUBCONTRACT NO.				LOCKHEED MARTIN			
REQUESTOR: M.R. GREENE				CPP-659			
DESIGN				NWCFC TRUCK BAY			
DRAWN: V. KRESS				DECON SPRAY BOOTH AND GLOVEBOX			
PROJECT NO.				DSB-NC-601 AND GBX-NCD-920			
SPEC CODE				CONFIGURATION			
DASH NO.	NEXT QTY REQ	FINAL QTY REQ	NEXT ASSY	FOR REVIEW/APPROVAL SIGNATURES SEE DAR NO. 18246	SIZE: D	CAGE CODE: 01MF3	INDEX CASE NUMBER: 200 06591 601530
APPLICATION				EFFECTIVE DATE: 4-13-99	MEL	DWG-097877	
				SCALE: NOTED		REV 2	
						NCD SHEET 1 OF 2	

8 7 6 5 4 3 2 1

D

C

B

A

D


C

B


A

Plot Date: 11/04/03 08:13 A.M.
User: KRESV

Plot Date: 11/04/03 08:13 A.M.
User: KRESV

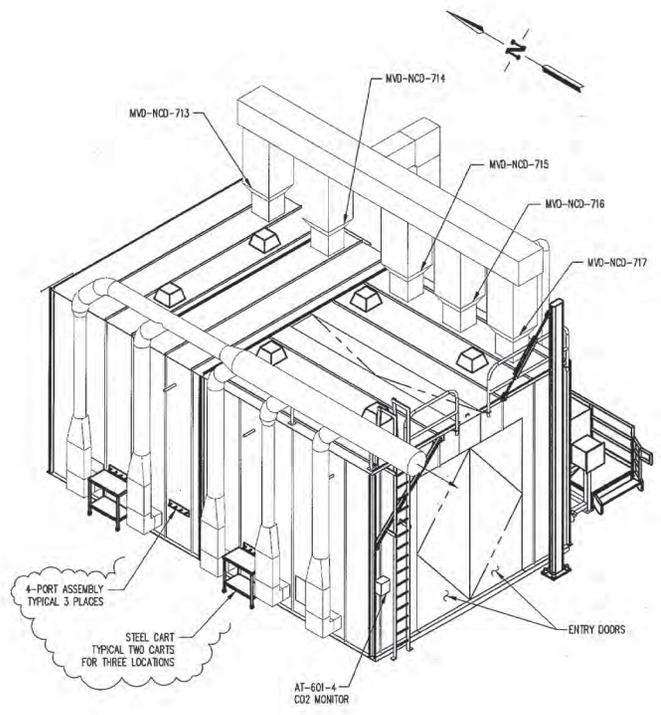

VIEW D-D (SOUTHWEST ELEVATION)
SCALE: 1/4"=1'-0"

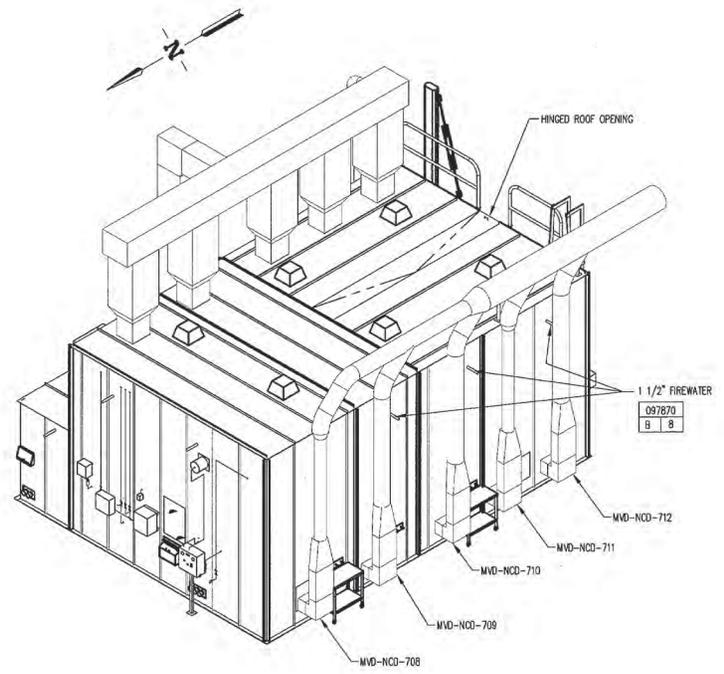






VIEW C-C (NORTHWEST ELEVATION)
SCALE: 1/4"=1'-0"

SIZE	DWG CODE	AREA	DATE	BY	CHK	APP	DATE	BY	CHK	APP
D	01MF3	200	06/29	60	530			DWG-097877		
SCALE: NOTED										
SHEET 2										

8 7 6 5 4 3 2 1

8 7 6 5 4 3 2 1

REVISIONS		
REV	DESCRIPTION	EFFECTIVE DATE
1	SEE DAR #41393 W.O. SSB	ALR 10-5-99 MEL 10-21-99
2	ASSESSED AND VERIFIED AS BUILT AS OF 11-30-04 SEE DAR 118074	12-15-04 DEJ

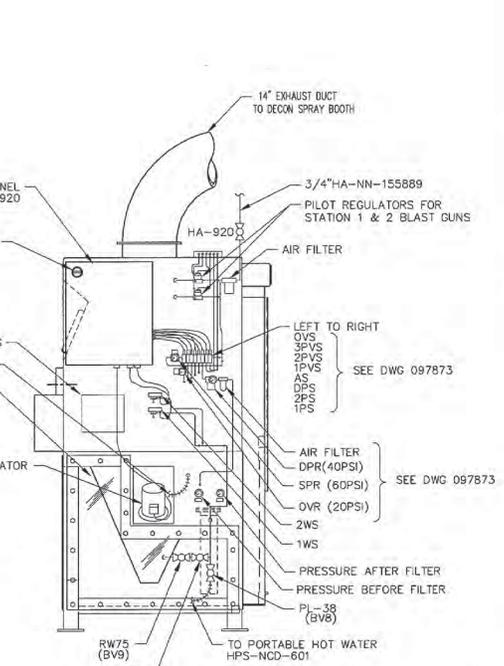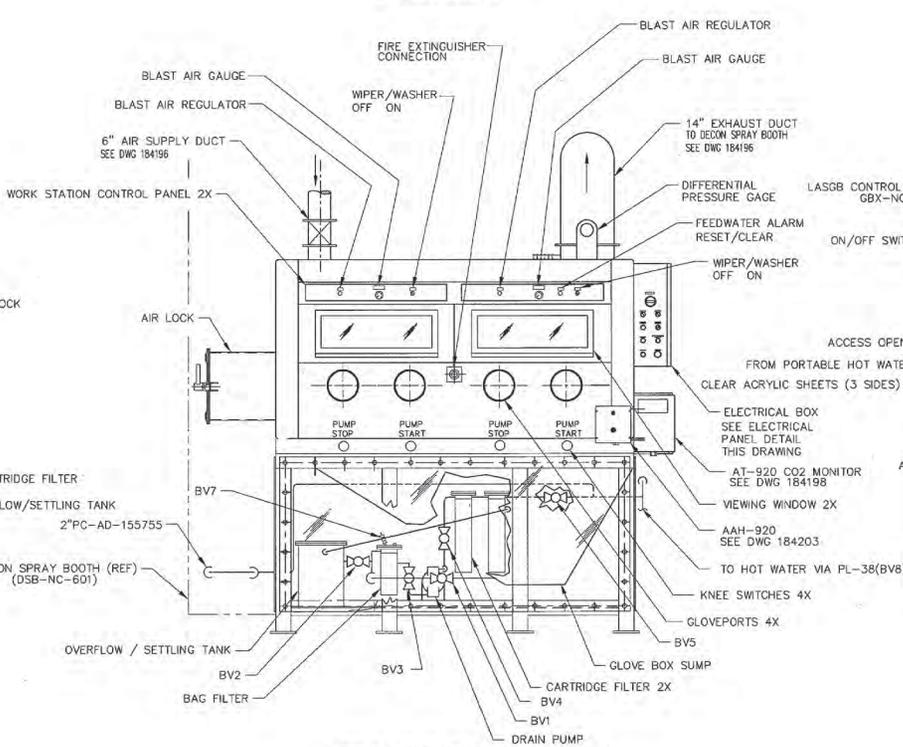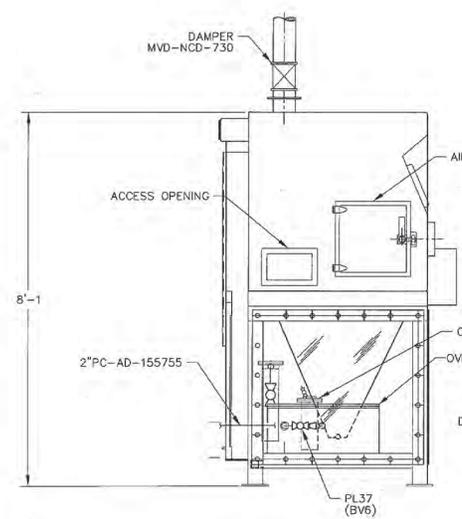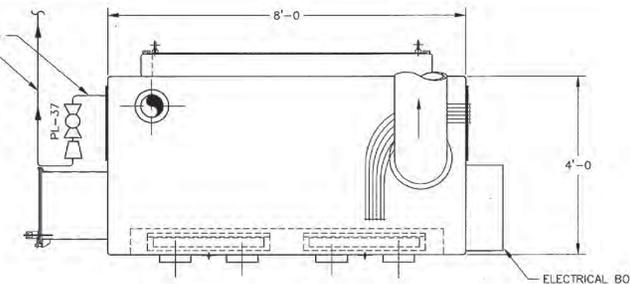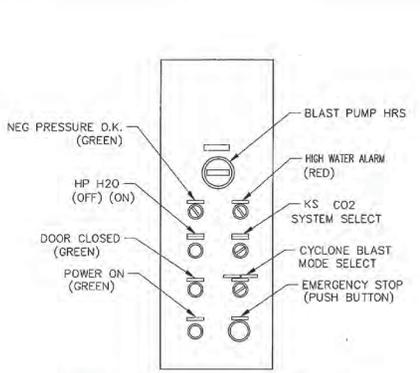


Date: 12/15/04 - 12:36 P.M. Drawn In: Moosh Space
 Plot: P:\M\097878-2.dwg
 Plot: P:\M\097878-2.dwg

SUBCONTRACT NO.		LOCKHEED MARTIN	
REQUESTER:	ICPP BLDG 659		
DESIGN:	NWCF TRUCK BAY		
DRAWN: JUAN M TRACY	LIQUID ABRASIVE SPRAY		
PROJECT NO.:	GLOVE BOX GBX-NCD-920		
SPEC CODE:	COMPONENT ARRANGEMENT		
FOR REVIEW/APPROVAL SIGNATURES		SIZE: 11x17	REV: 2
SEE DAR NO. 11813		DATE: 4/13/99	DWG: 097878
EFFECTIVE DATE: 4/13/99	MEL	SCALE: NONE	NCD SHEET 1 OF 1

8 7 6 5 4 3 2 1

Date: 12/15/04 - 12:14 P.M. Drawn in Model Space
 Plot: P:\VITfile
 File: 184190-5.dwg
 Plot: P:\VITfile

REVISIONS		
REV	DESCRIPTION	EFFECTIVE DATE
4	SEE DAR 41394	MEW MEL 10-21-99
5	ASSESSED AND VERIFIED AS BUILT AS OF 11-30-04 SEE DAR 118074	12-15-04 DEJ

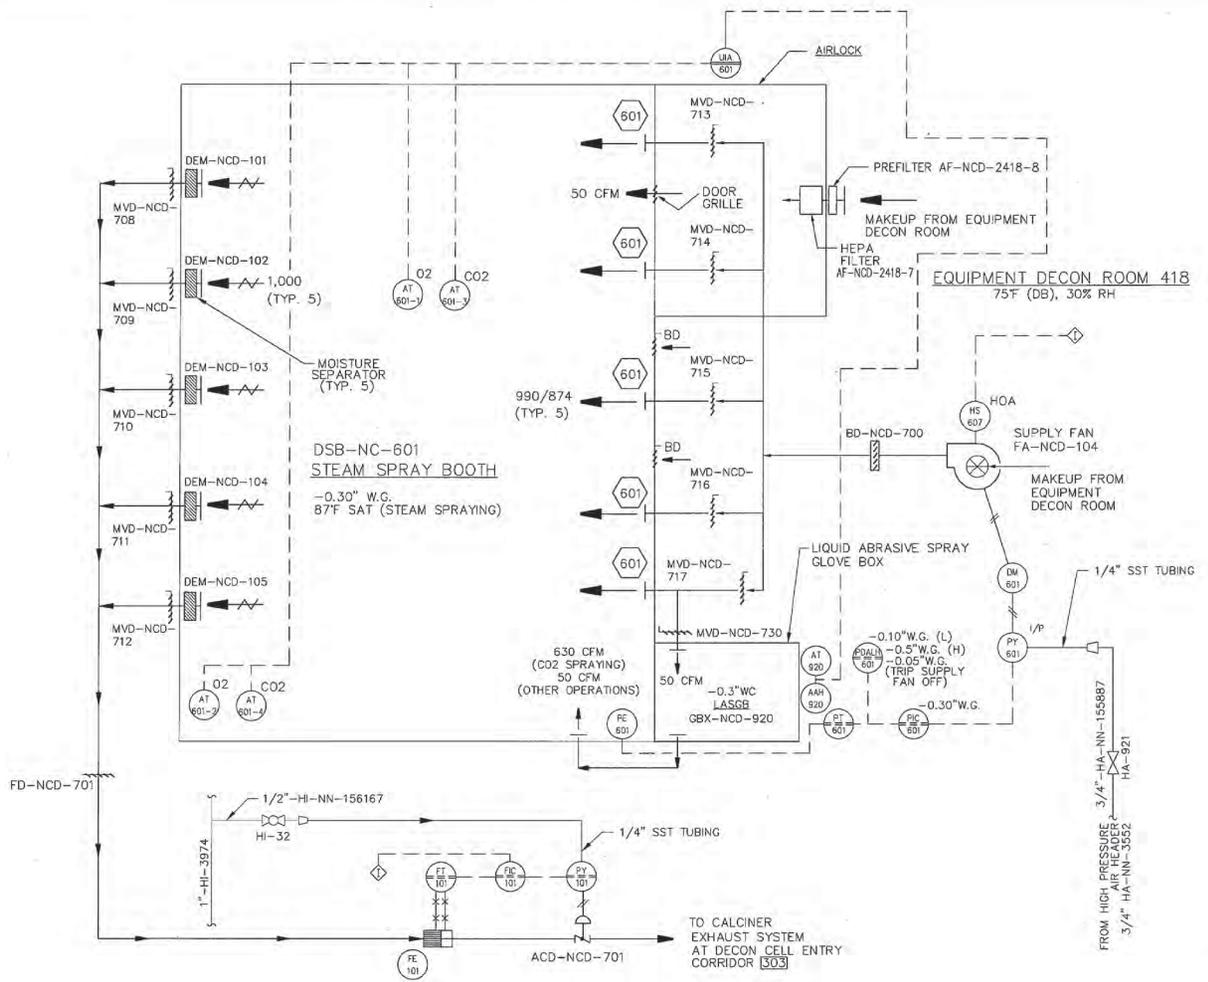

OPERATING LOGIC


- #### 1.0 GENERAL
- THIS DRAWING ADDRESSES THE SUPPLY AND EXHAUST VENTILATION SYSTEMS FOR THE STEAM SPRAY BOOTH AND THE LIQUID ABRASIVE SPRAY GLOVEBOX.
 - THE STEAM SPRAY BOOTH OPERATES IN EITHER A VENTILATION ON OR VENTILATION OFF MODE.
 - WHEN THE STEAM SPRAY BOOTH VENTILATION SUPPLY FAN IS NOT OPERATING THE EXHAUST SYSTEM CONTINUES TO MAINTAIN THE INDICATED NEGATIVE BOOTH PRESSURE BY INDUCING THE AIRFLOW SCHEDULED AS VENTILATION OFF MODE THROUGH EXISTING BACKDRAFT DAMPERS.
 - SEE THE "SCHEDULE OF OPERATING SCHEMES" FOR THE POSSIBLE OPERATING SCHEMES, THEIR AIRFLOW SETPOINTS, AND THE DAMPER CONDITIONS (OPEN, CLOSED, MODULATION (MOD)).
- #### 2.0 SEQUENCE OF OPERATIONS
- THE OPERATOR SELECTS THE OPERATING SCHEME. (ON OR OFF)
 - FOR THE SELECTED OPERATING SCHEME, THE SOFTWARE DOES THE FOLLOWING:
 - SETS THE SCHEDULED DAMPER CONDITIONS,
 - SETS THE SCHEDULED FLOW CONTROLLER SETPOINTS,
 - STARTS SUPPLY FAN FA-NCD-104.
 - FLOW CONTROLLER MODULATES THE INDICATED DAMPER TO MAINTAIN EXHAUST AIRFLOW AT SETPOINT.
 - THE SPACE PRESSURE CONTROLLER, PIC-601, MODULATES THE INLET VANES OF SUPPLY FAN FA-NCD-104 TO MAINTAIN SETPOINT.
 - AT THE END OF OPERATIONS, THE OPERATOR SELECTS THE OFF SCHEME TO MAINTAIN MINIMUM FLOW AND BOOTH PRESSURE DURING NON-OPERATING CONDITIONS.
- #### 3.0 OTHER OPERATIONS
- AIR FROM THE EQUIPMENT DECON ROOM IS DRAWN THROUGH THE AIRLOCK DOOR AND INTO THE SPACE THROUGH EXISTING FILTERS AS INDICATED.
 - NO SMOKE DETECTION OR AUTOMATIC SHUTDOWN OF THE SUPPLY FAN IS PROVIDED FOR FIRE. IN THE EVENT OF FIRE IN THE TRUCK BAY OR THE SPRAY BOOTH, THE CONDITION IS ALARMED AND THE OPERATOR MUST MANUALLY STOP THE FAN.
 - CO2 AND O2 DETECTORS ACTIVATE ALARM UIA-601 UPON DEVIATION FROM SETPOINTS DETERMINED BY THE CONTRACTOR.
- #### 4.0 NOTES
- SCHEDULED SUPPLY FAN AIRFLOWS FOR CO2 INJECTION ARE MINIMUM AIRFLOWS, BASED UPON CONTINUOUS CO2 BLAST GUN FLOWS OF 580 CFM.
 - FOR LEGEND SEE DWG 184176.
 - FOR EQUIPMENT SCHEDULE SEE DWG 184191.

SCHEDULE OF OPERATING SCHEMES						
SCHEMES	STEAM SPRAY BOOTH (SSB)				FLOW CONTROLLER SETPOINTS (CFM)	DAMPER CONDITIONS (TAG NO "ACD-NCD-XXX")
	STEAM INJ	CO2 INJ	S. FAN CFM	EXHAUST CFM		
VENTILATION ON	YES	NO	4,900	5,000	FIC-601	701
VENTILATION ON	NO	YES	4,900	5,000	5,000	MOD
VENTILATION OFF	NO	NO	0	1,500	1,500	MOD


REFERENCE DRAWINGS
133190 PROCESS & INSTRUMENTATION DIAGRAM, EQUIPMENT DECON ROOM

FOR DRAWING INDEX SEE DRAWING NO. 184175	SUBCONTRACT NO. 294005.2					
	REQUESTOR: C.E. JOHNSON DESIGN: M. VAN SICKLE DRAWN: RA. FRESZ					
	PROJECT NO. 294005.2 SPEC CODE: ISSCONST	ICPP BLDG 659 SPRAY BOOTH DSB-NC-601 HVAC AIR FLOW AND CONTROL DIAGRAM				
DESIGN PHASE: AFC QUALITY LEVEL: 3	FOR REVIEW/APPROVAL SIGNATURES SEE DAR NO. 5745 EFFECTIVE DATE: 3/24/97	<table border="1"> <tr> <td>SHEET</td> <td>5</td> </tr> <tr> <td>OF</td> <td>5</td> </tr> </table>	SHEET	5	OF	5
SHEET	5					
OF	5					

REV.	REVISION DESCRIPTION	APPROVED		
		DATE	RE&C	WINGO
7	SEE DAR 40409	MEW	8-16-99	
8	SEE DAR 40838	MEW	8-30-99	

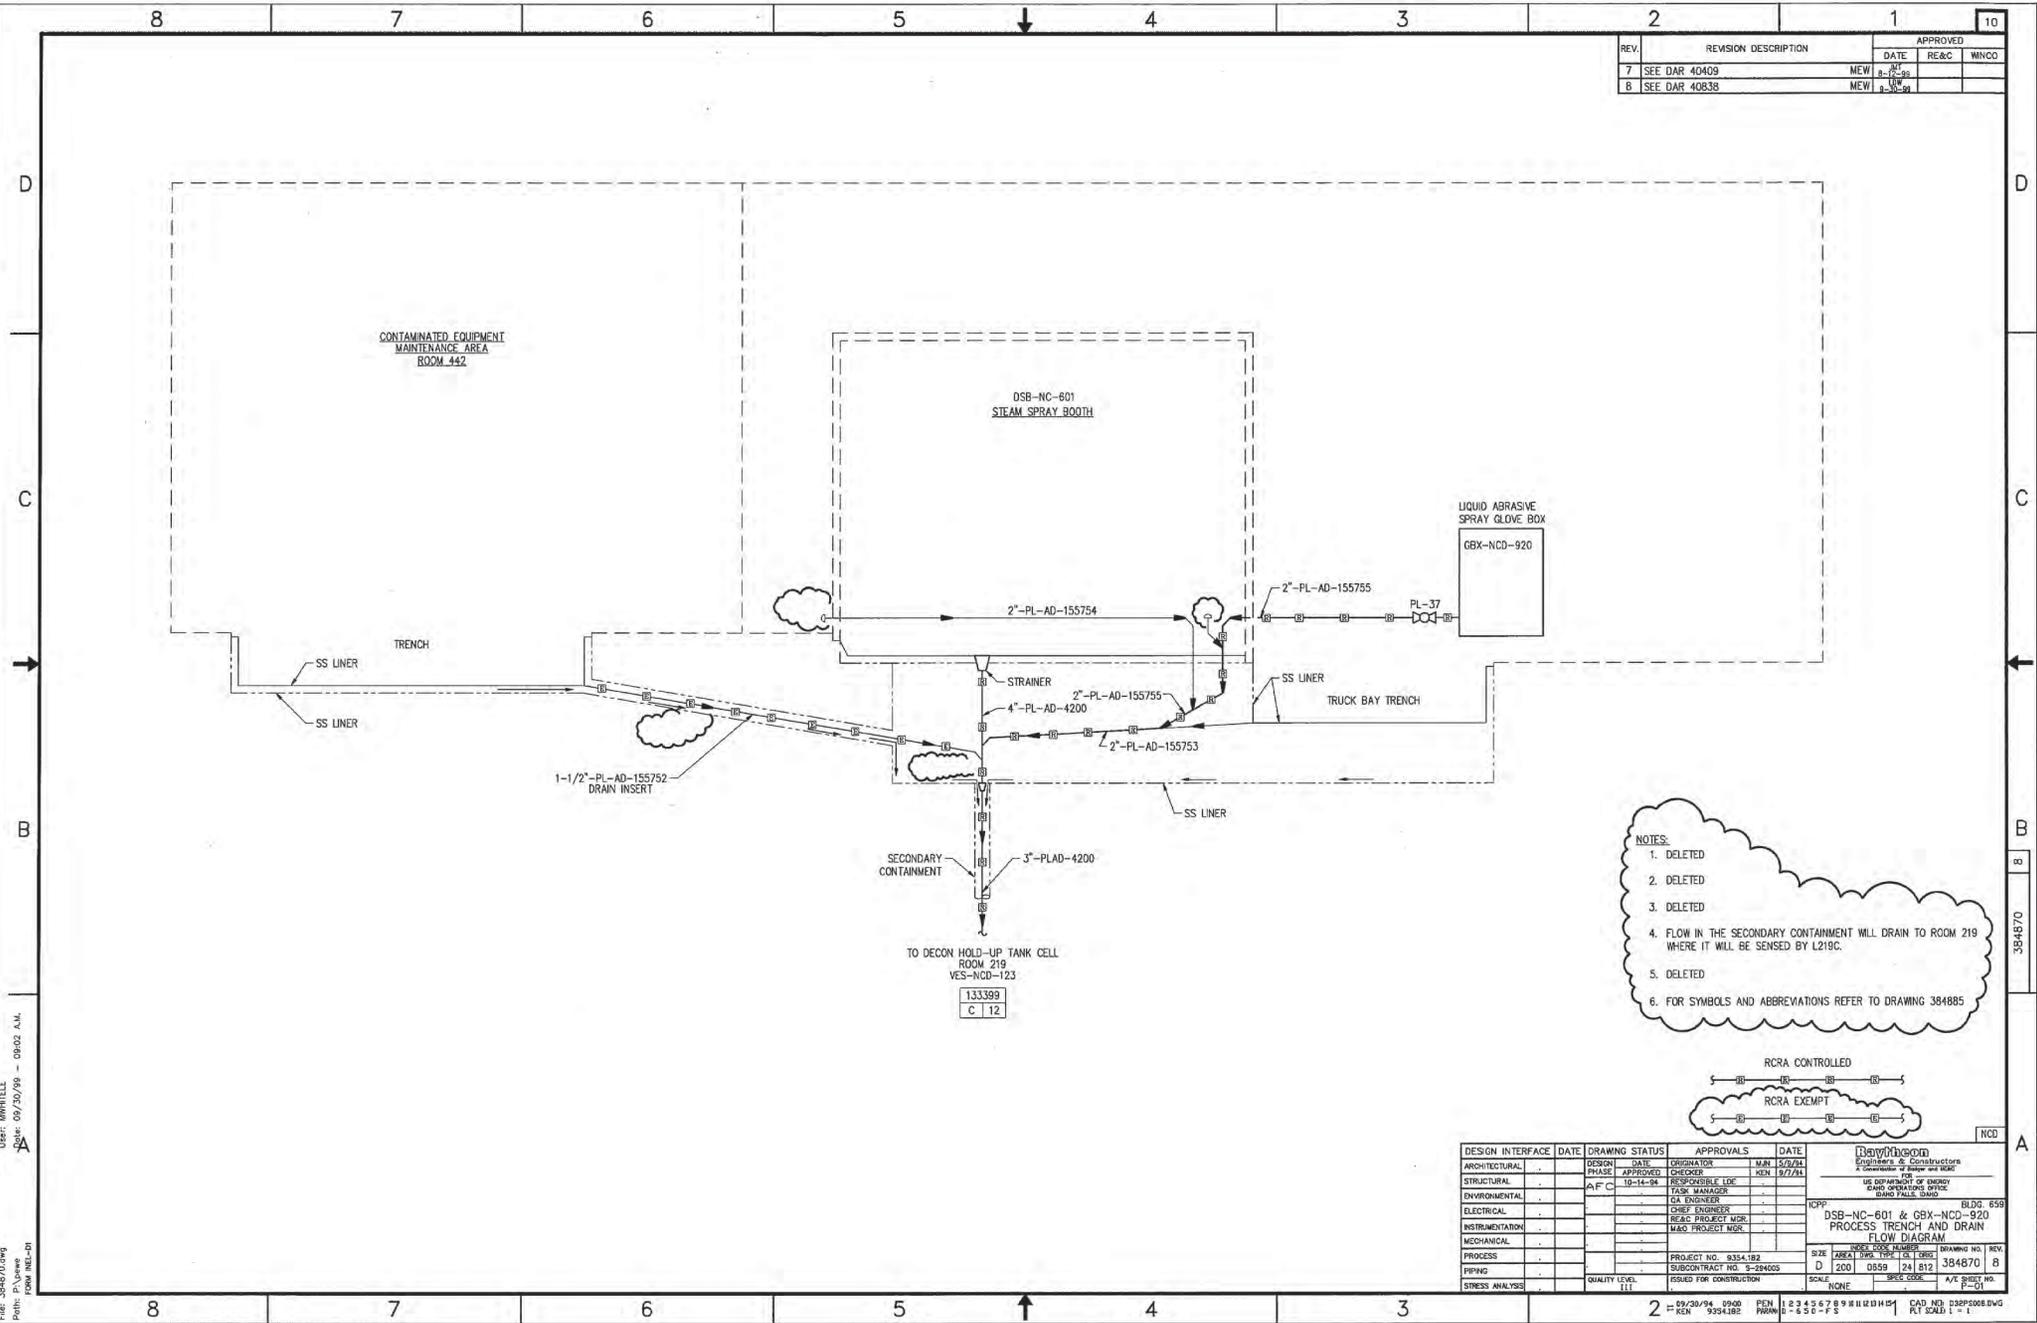

- NOTES:
1. DELETED
 2. DELETED
 3. DELETED
 4. FLOW IN THE SECONDARY CONTAINMENT WILL DRAIN TO ROOM 219 WHERE IT WILL BE SENSED BY L219C.
 5. DELETED
 6. FOR SYMBOLS AND ABBREVIATIONS REFER TO DRAWING 384885


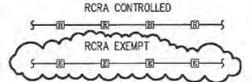


DESIGN INTERFACE	DATE	DRAWING STATUS	APPROVALS	DATE
ARCHITECTURAL	DESIGN DATE	APPROVED	ORIGINATOR	MAR 3/2/91
STRUCTURAL	PHASE	APPROVED	CHECKER	KEN 9/7/91
ENVIRONMENTAL	A/F C	10-14-98	RESPONSIBLE LDR	
ELECTRICAL			TASK MANAGER	
INSTRUMENTATIONAL			IA ENGINEER	
MECHANICAL			CHIEF ENGINEER	
PROCESS			HEAD PROJECT MGR	
PIPING			MAJ PROJECT MGR	
STRESS ANALYSIS				

PROJECT NO.	9354182	SIZE	A8.5	REV	B
SUBCONTRACT NO.	S-284005	SCALE	AS SHOWN	DWG NO.	384870
ISSUED FOR CONSTRUCTION		SCALE	NONE	A/E	MEW
QUALITY LEVEL	111	SCALE	NONE	P/E	MEW


DATE	09/30/94	0900	PEN	1 2 3 4 5 6 7 8 9 10 11 12 13 14 15	CAD NO.	D38P006.DWG
BY	KEN	9354182	PRN	0-550-F3	PLT	2X40 L-1

User: BWATELE
 Date: 07/20/99 - 09:02 A.M.
 Plot: 384870.dwg
 Path: \\p1\dwg\inl-dt

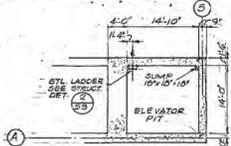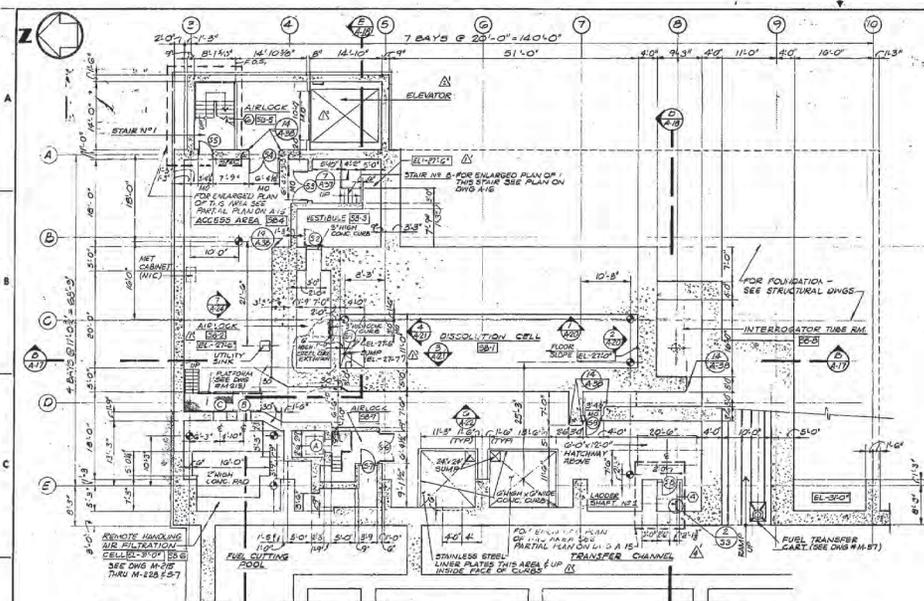

ENLARGED PARTIAL PLAN
FIN. FL. EL. - 27'-9"

NOTES
 1 WINDOW DETAILS: SEE DWGS M-216 FOR WINDOWS
 (A), (B), (C)
 SEE DWGS M-72 FOR WINDOWS
 (D), (E)
 MONUMENT LOCATION - SEE (J), (K), (L), (M), (N), (O), (P), (Q), (R), (S), (T), (U), (V), (W), (X), (Y), (Z)

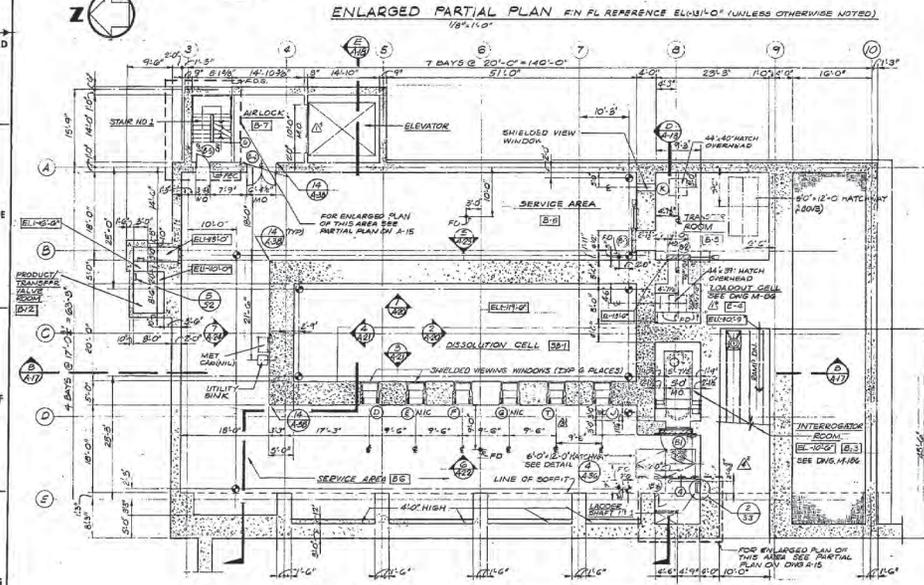

ENLARGED PARTIAL PLAN IN FL REFERENCE EL 0+10' (UNLESS OTHERWISE NOTED)
18'-11 1/2"

APPROVED
FOR
CONSTRUCTION

REFERENCE EL 0+0' = TRUE EL 48.00 FT

NO.	DATE	BY	REVISIONS
1	10/1/70
2
3
4
5
6
7
8
9
10


THE RALPH M. PARSONS COMPANY
 1560 G STREET, N.W.
 WASHINGTON, D.C. 20004
 U.S. ENERGY RESEARCH & DEVELOPMENT ADMINISTRATION
 IDAHO OPERATIONS OFFICE
 IDAHO FALLS, IDAHO

CPP AREA BUILDING NO. CPP-666
 FLUORINEL AND STORAGE FACILITY
 INDUSTRIAL
 ENLARGED PARTIAL PLAN
 EL -13'-0" -27'-0" -31'-0"
 1560-CPP-666-A-6

INDEX CODE NUMBER
 20006600089314706

DATE ISSUED: 1-15-71

PLANT NO. 5588-2006

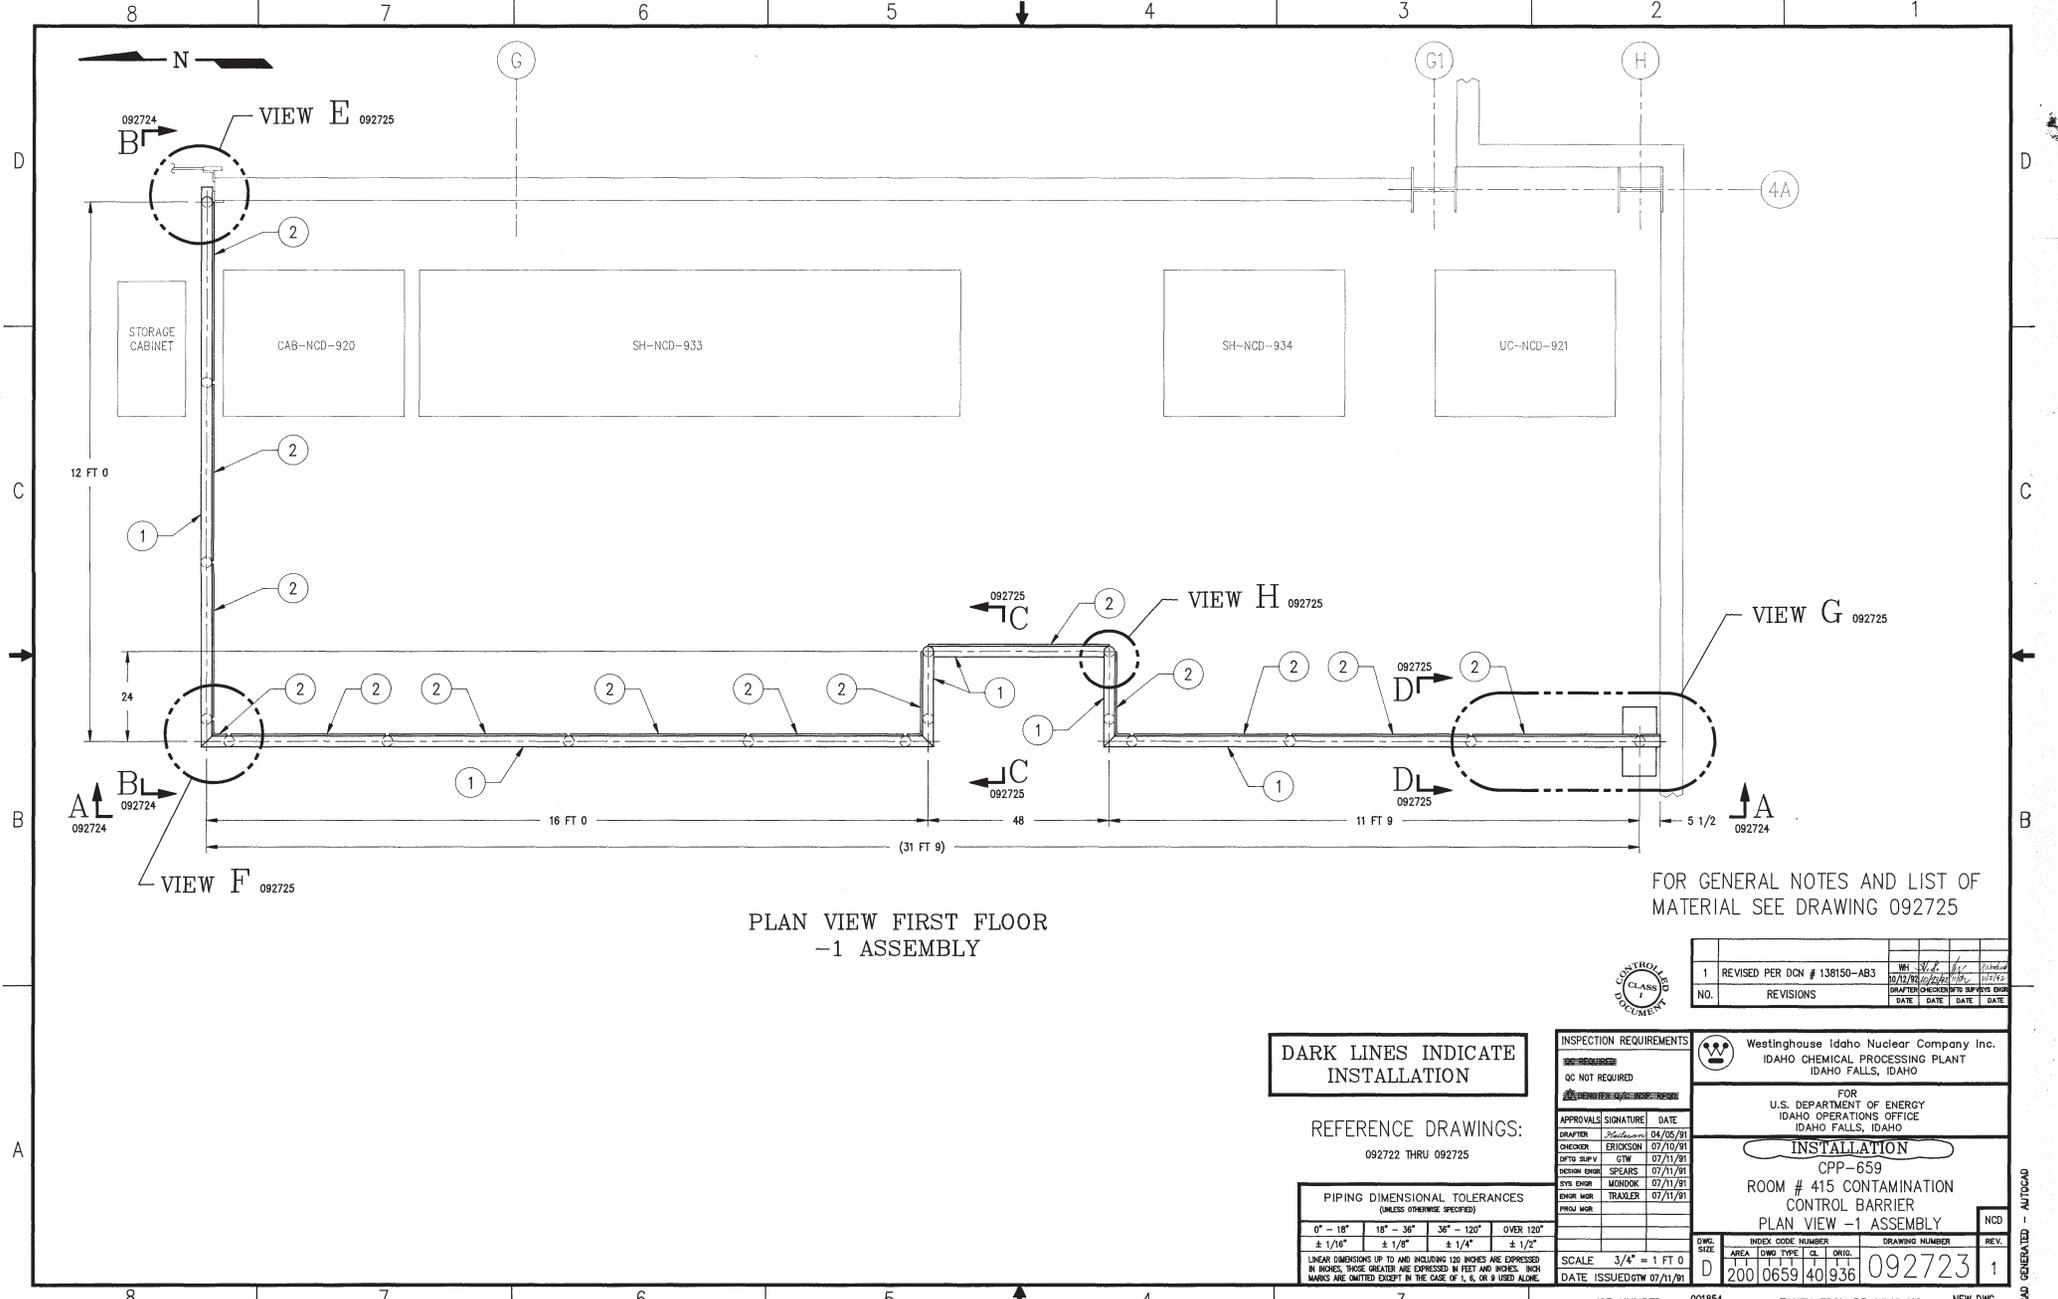

PLAN VIEW FIRST FLOOR
-1 ASSEMBLY

FOR GENERAL NOTES AND LIST OF MATERIAL SEE DRAWING 092725

**DARK LINES INDICATE
INSTALLATION**

REFERENCE DRAWINGS:
092722 THRU 092725

PIPING DIMENSIONAL TOLERANCES (UNLESS OTHERWISE SPECIFIED)			
0" - 18"	18" - 36"	36" - 120"	OVER 120"
± 1/16"	± 1/8"	± 1/4"	± 1/2"

LINEAR DIMENSIONS UP TO AND INCLUDING 100 INCHES ARE EXPRESSED IN INCHES. THOSE GREATER ARE EXPRESSED IN FEET AND INCHES. ZERO MARKS ARE OMITTED EXCEPT IN THE CASE OF 1, 6, OR 8 USED ALONE.







INSPECTION REQUIREMENTS	
QC NOT REQUIRED	
APPROVALS SIGNATURE	DATE
DRAWN BY	04/05/91
CHECKED BY	07/10/91
QFTO SUPV	07/11/91
DESIGN ENGR	07/11/91
SYN ENGR	07/11/91
ENGR. WORK	07/11/91
FIELD WORK	

NO.	REVISIONS	WH	DATE	BY	DATE
1	REVISED PER DCN # 138150-AB3		10/12/92		10/12/92

Westinghouse Idaho Nuclear Company Inc. IDAHO CHEMICAL PROCESSING PLANT IDAHO FALLS, IDAHO	
FOR U.S. DEPARTMENT OF ENERGY IDAHO OPERATIONS OFFICE IDAHO FALLS, IDAHO	
INSTALLATION	
CPP-659 ROOM # 415 CONTAMINATION CONTROL BARRIER PLAN VIEW -1 ASSEMBLY	
DWG. NO.	NCD
200 0659 40 936	092723 1

JOB NUMBER 001854 TAKEN FROM DRAWING NO. NEW DWG

CAD GENERATED BY AUTOCAD

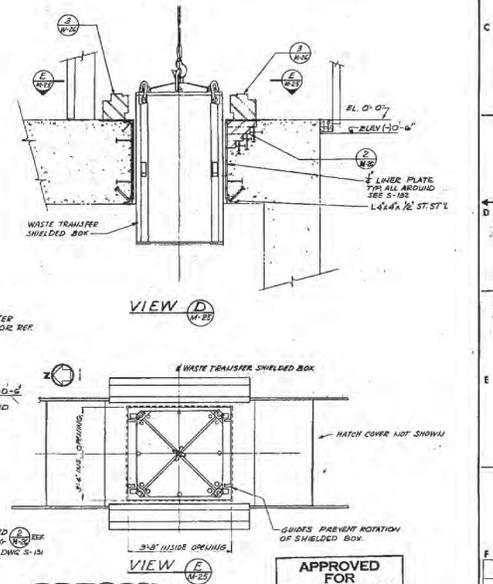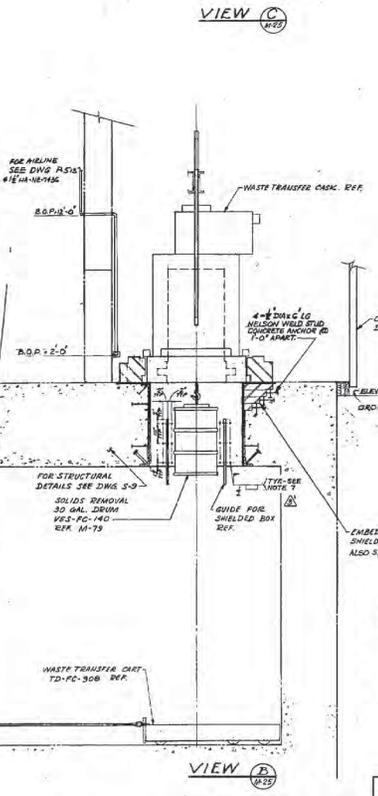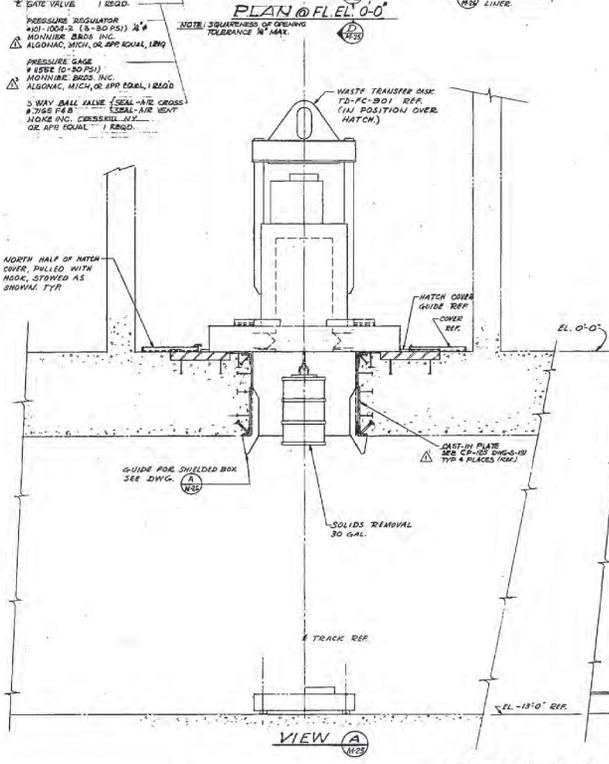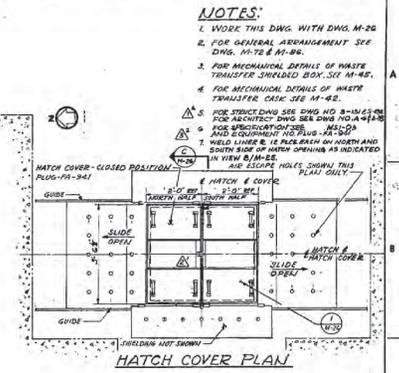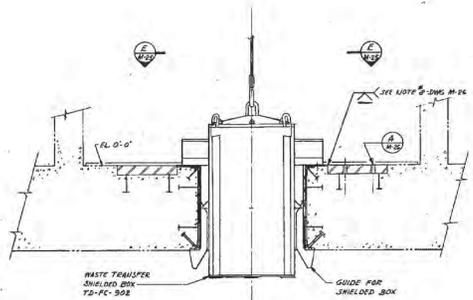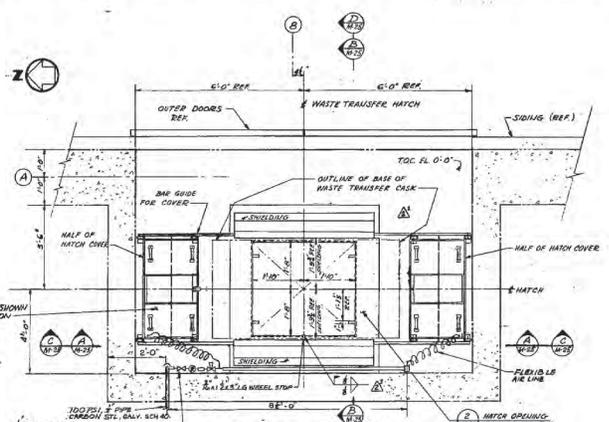

- NOTES:**
1. WELD THIS DWG. WITH DWG. M-26
 2. FOR GENERAL ARRANGEMENT SEE DWG. M-72 & M-26.
 3. FOR MECHANICAL DETAILS OF WASTE TRANSFER SHIELDED BOX, SEE M-142.
 4. FOR MECHANICAL DETAILS OF WASTE TRANSFER CASE SEE M-42.
 5. FOR STRUCTURAL SEE DWG. NO. 3-142-20 FOR ARCHITECT. DWG. SEE DWG. NO. 4-142-20
 6. FOR SPECIFICATION FOR WELDING AND EQUIPMENT FOR PLUG, SEE M-142.
 7. WELD LINER & LE PLACEMENT ON NORTH AND SOUTH SIDE OF OPENING AS INDICATED IN VIEW B/D-WG. M-26. SEE SECTION HOLES SHOWN THIS PLAN ONLY.

APPROVED FOR CONSTRUCTION

CONTRACT NO. 2020-34 EQUIPMENT NO. FLUOR-FA-941 (18)

REVISIONS

NO.	DATE	DESCRIPTION
1		
2		



THE RALPH M. PARSONS COMPANY
 1825 CALIFORNIA STREET
 PASADENA, CALIFORNIA

U.S. ENERGY RESEARCH & DEVELOPMENT ADMINISTRATION
 ISLAND OPERATIONS DIVISION
 ISLAND FIELD, ISLAND




CPD AREA NO. 1 BUILDING NO. CPP-866
 FLUORINEL AND STORAGE FACILITY
 MECHANICAL
 HATCH COVER
 WASTE TRANSFER ROOM

1560-CPP-666-M-25



PROJECT NO. 5586-5003

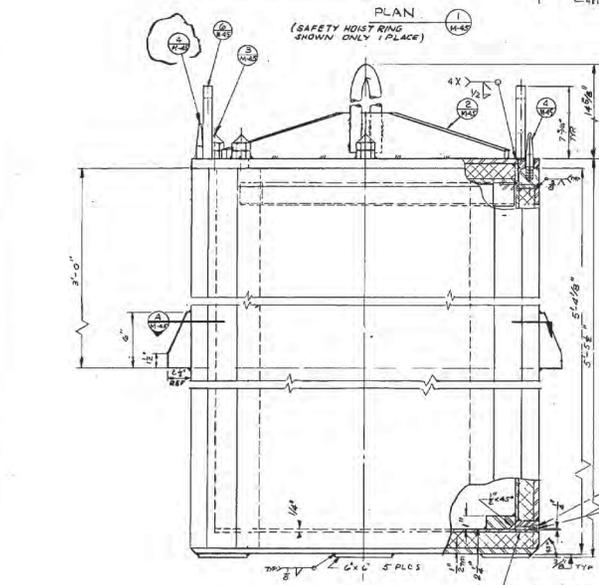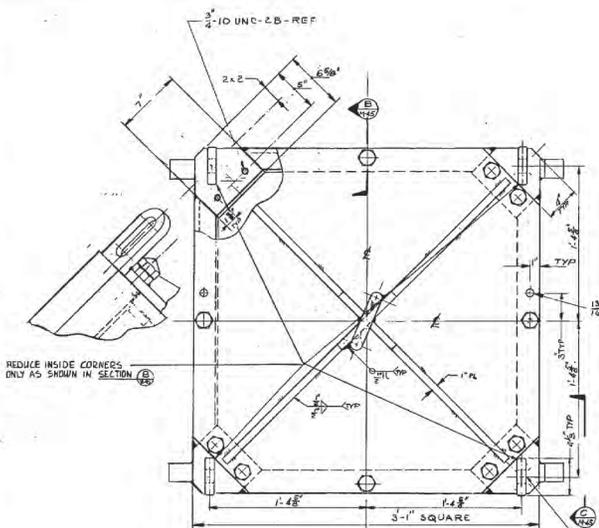

WASTE TRANSFER SHIELDED BOX
 REF TO FC-302
 M-56

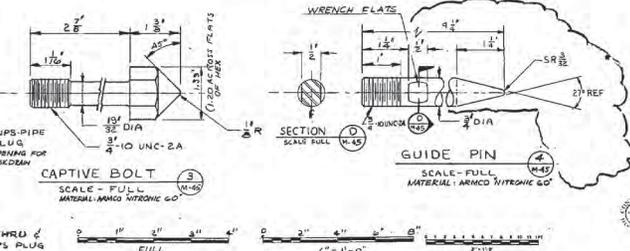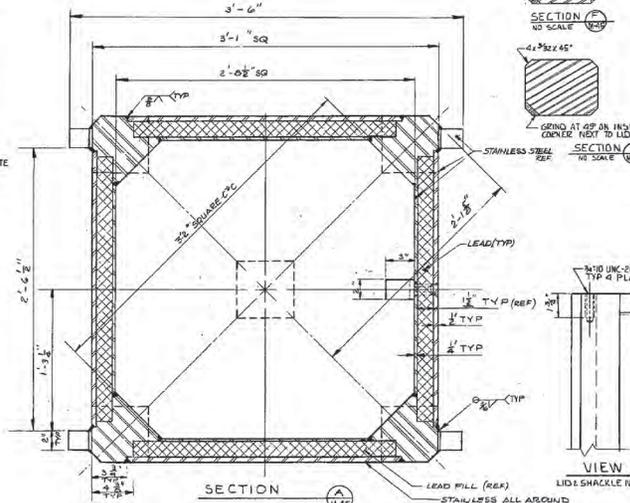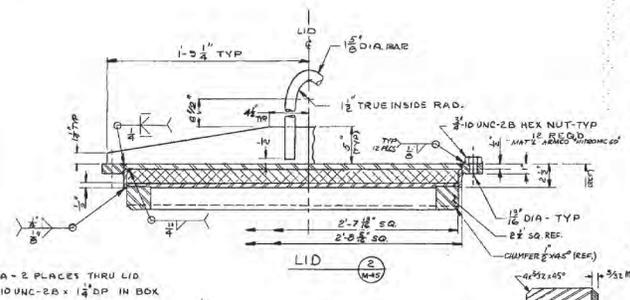

- NOTES:
- 1- ALL STEEL MATERIAL SHALL BE 300 SERIES STAINLESS STEEL, FOR SHEETS & PLATES ASTM-A-283, TUBING ASTM-A-302. BRASS SHALL BE NOTED.
 - 2- LEAD CONSIGT SHALL BE 1/4\"/>

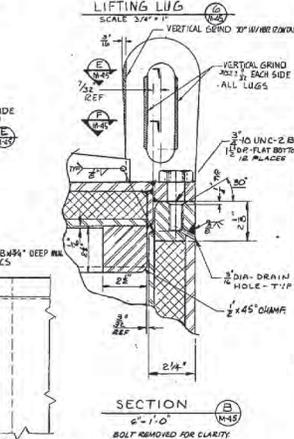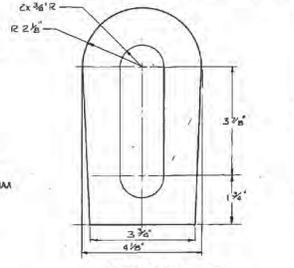

LIFTING LUG
 SCALE 3/4\"/>

CONTRACT NO. 179-562
 EQUIPMENT NO. (VISOR DATA NO.) TD-FC-302 (77)

THE RALPH M. PARSONS COMPANY
 PROJECTS ENGINEERS
 HEADQUARTERS OFFICE
 BEVERLY HILLS, CALIFORNIA

U.S. ENERGY RESEARCH & DEVELOPMENT ADMINISTRATION
 HEAD OPERATIONS OFFICE
 SAND HILLS, IOWA







CFR AREA BUILDING NO. CPP-666
 FLUORINEL AND STORAGE FACILITY
 MECHANICAL
 WASTE TRANSFER SHIELDED BOX

SCALE - FULL
 MATERIAL - ANNEAL 316 STAINLESS S.S.

SCALE - FULL
 MATERIAL - ANNEAL 316 STAINLESS S.S.

15680-CPP-666-M-45 REV 3

PROJECT NO. 5585-7103

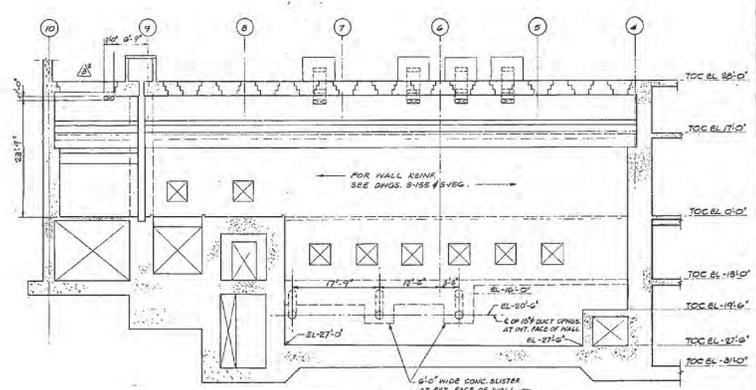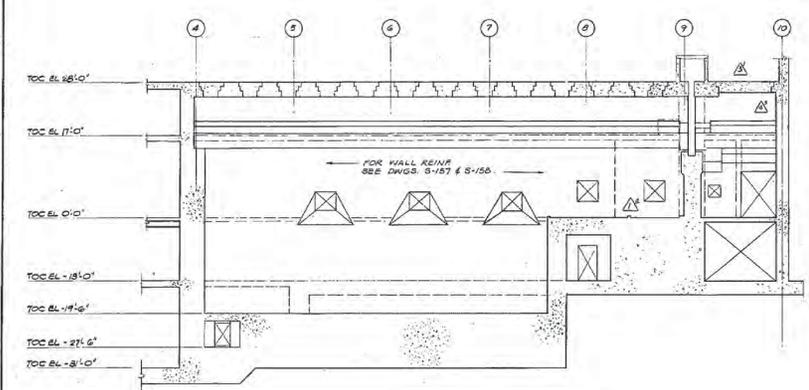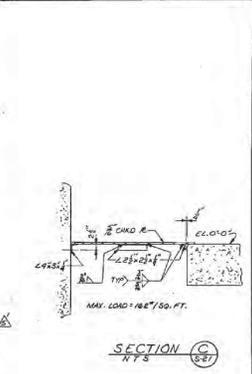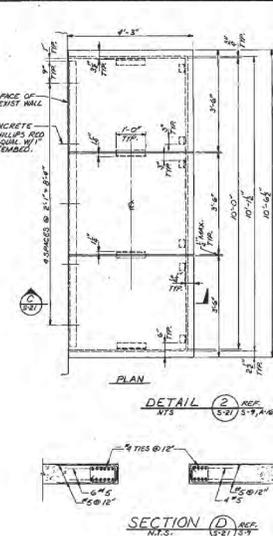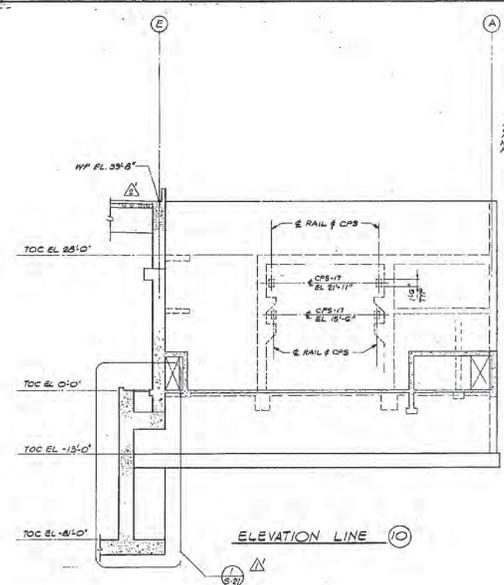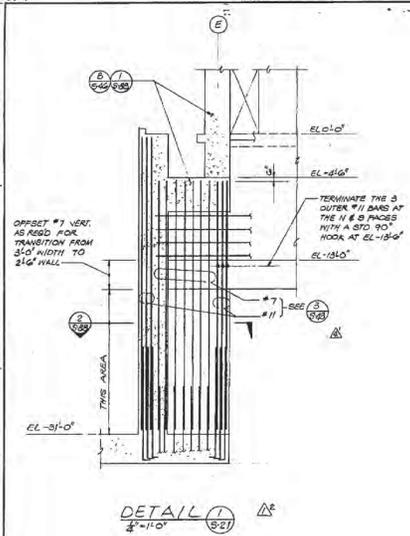

APPROVED FOR CONSTRUCTION



7	INACTIVATE PER UCN # 156, S-7-PASS 58	12/10/70	1/10
6	INACTIVATE PER UCN # 10716-301 D.C.	12/10/70	1/10
5	INACTIVATE PER UCN # 10716-301 D.C.	12/10/70	1/10
4	INACTIVATE PER UCN # 10716-301 D.C.	12/10/70	1/10
3	INACTIVATE PER UCN # 10716-301 D.C.	12/10/70	1/10
2	INACTIVATE PER UCN # 10716-301 D.C.	12/10/70	1/10
1	INACTIVATE PER UCN # 10716-301 D.C.	12/10/70	1/10


THE RALPH M. PARSONS COMPANY
ARCHITECTS-ENGINEERS
BERKELEY, CALIFORNIA

U.S. ENERGY RESEARCH & DEVELOPMENT ADMINISTRATION
IDAHO OPERATIONS OFFICE
IDAHO FALLS, IDAHO

CPP AREA BUILDING NO. CPP-666
FLUORINEL AND STORAGE FACILITY
STRUCTURAL
DISSOLUTION CELL
WALL ELEVATIONS & SECTIONS SH1 I

1560-CPP-666-S-21 7

PROJECT NO. 5586-8007

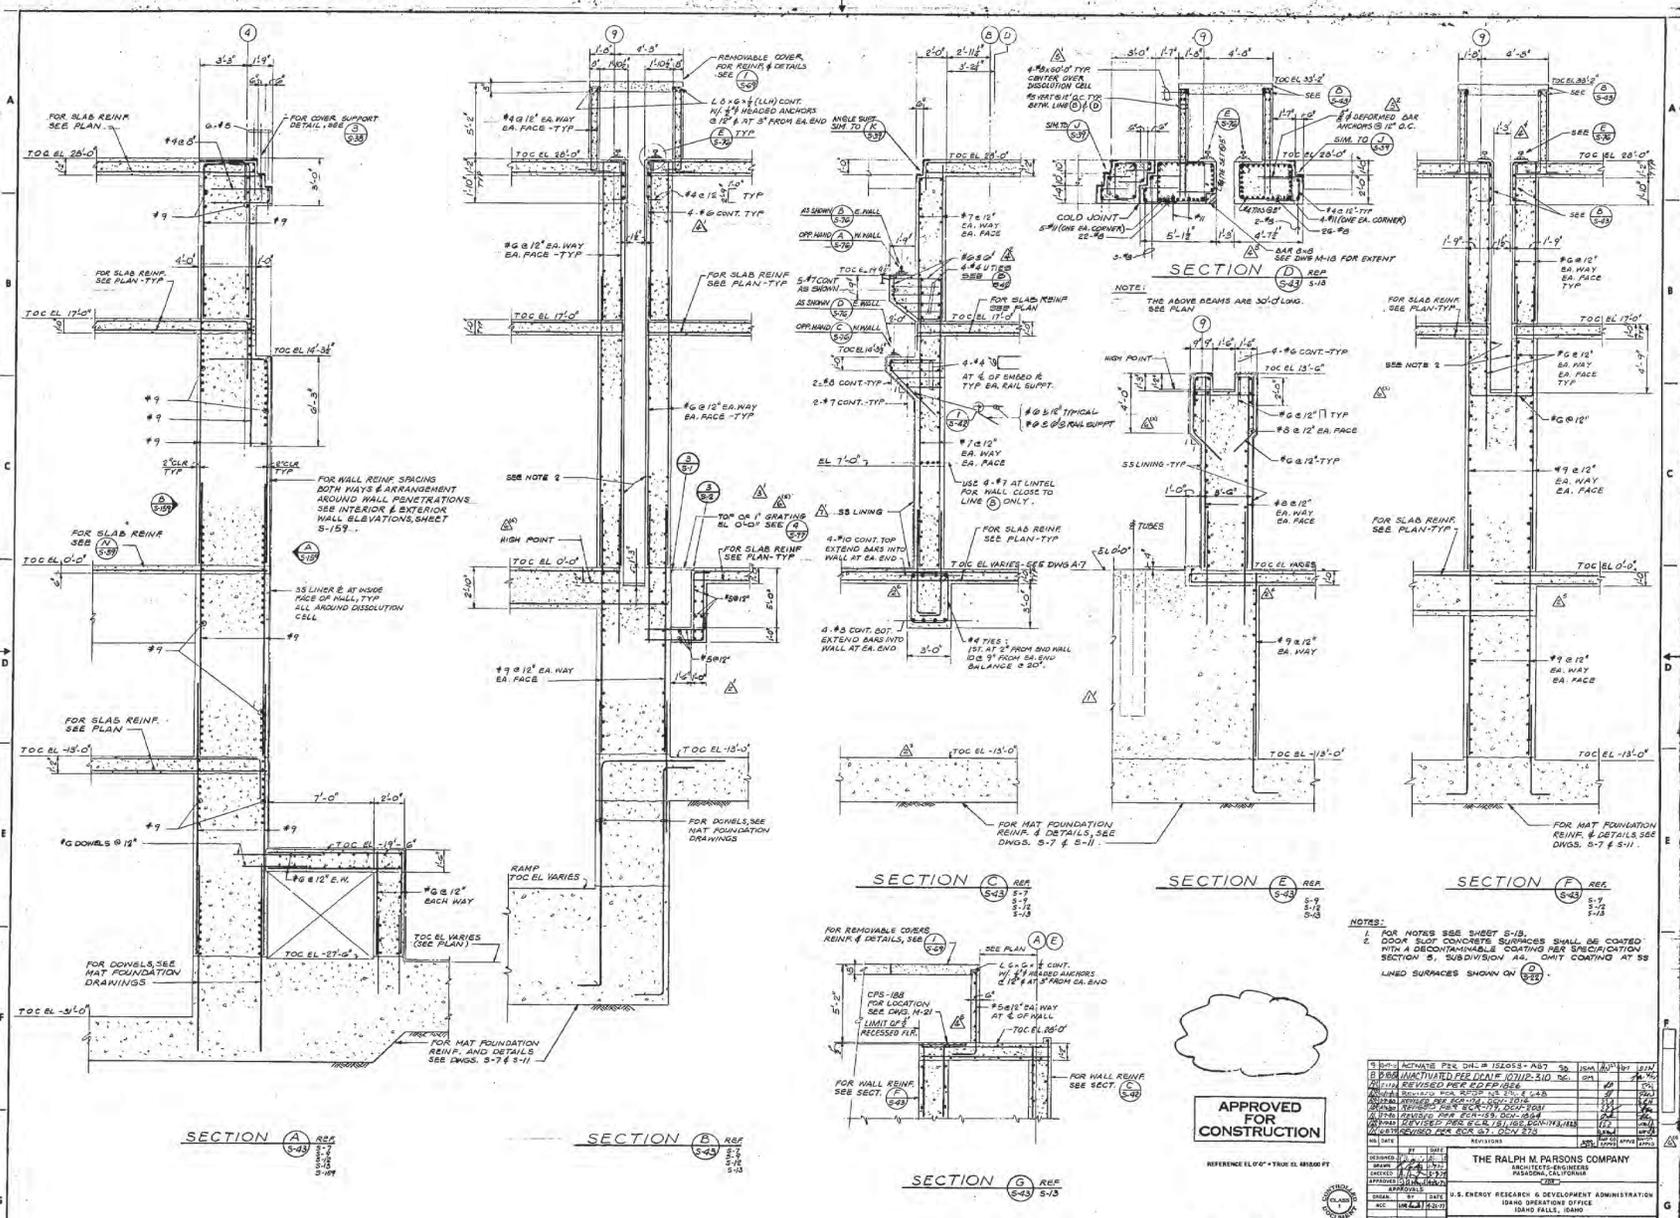

APPROVED FOR CONSTRUCTION

REFERENCE ELEVATION TO FINISH FLOOR

NOTES:
 1. FOR NOTES SEE SHEET S-18.
 2. DOOR SLOTT CONCRETE SURFACES SHALL BE COATED WITH A DISCONTINUABLE COATING PER SPECIFICATION SECTION 5, SUBDIVISION A, OMIT COATING AT SS LINED SURFACES SHOWN ON (C).

NO.	DATE	DESCRIPTION	BY	CHKD.
1	11/15/57	ISSUED FOR PERMITS
2	11/15/57	ISSUED FOR PERMITS
3	11/15/57	ISSUED FOR PERMITS
4	11/15/57	ISSUED FOR PERMITS
5	11/15/57	ISSUED FOR PERMITS
6	11/15/57	ISSUED FOR PERMITS
7	11/15/57	ISSUED FOR PERMITS
8	11/15/57	ISSUED FOR PERMITS
9	11/15/57	ISSUED FOR PERMITS
10	11/15/57	ISSUED FOR PERMITS

THE RALPH N. PARSONS COMPANY
 ARCHITECTS-ENGINEERS
 PASADENA, CALIFORNIA


U.S. ENERGY RESEARCH & DEVELOPMENT ADMINISTRATION
 ISLAND OPERATIONS OFFICE
 ISLAND FALLS, ISLAND

COP AREA BUILDING NO. CPP-668
 FLUORINEL AND STORAGE FACILITY
 STRUCTURAL
 DISSOLUTION CELL
 SECTIONS SHT 2


1560-CPP-668-9-43

INDEX CODE NUMBER	SCALE	DATE
20000-668-9-43	1/4" = 1'-0"	11/15/57


PROJECT NO. 5588-3007

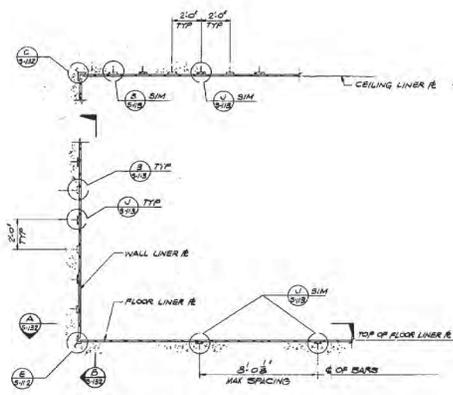

TYPICAL SECTION
3/4" = 1'-0"

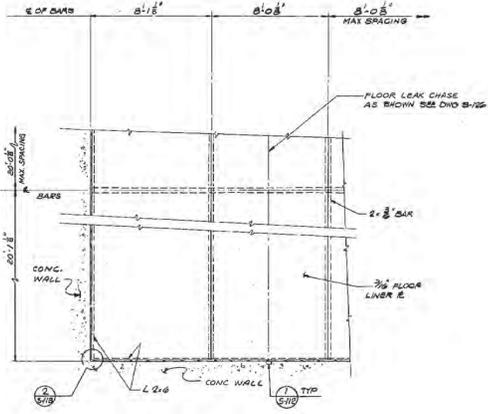


FLOOR PLAN
3/4" = 1'-0"

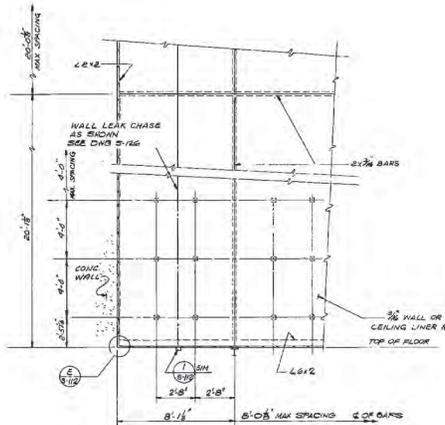


WALL ELEVATION
3/4" = 1'-0"


CEILING PLAN SIMILAR

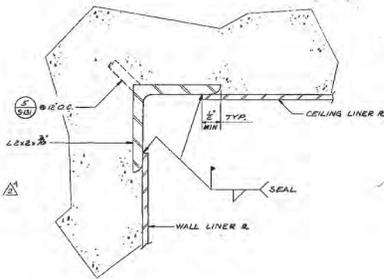


DETAIL
FULL SCALE

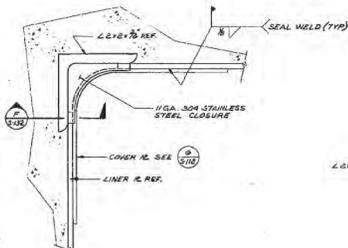

VIEW
FULL SCALE

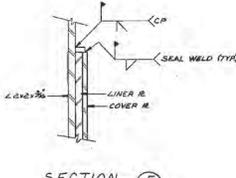


SECTION
FULL SCALE

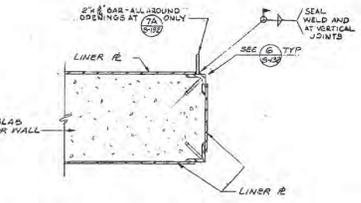


TYP RECT. OR SQUARE OPENING DETAIL UON
3/4" = 1'-0"

- NOTES:
1. FOR NOTES SEE DRAWING S-111
 2. FOR LOCATION OF LINER PLATES AND TOP OF WAINSCOT SEE ARCHITECTURAL DWG A-18

APPROVED FOR CONSTRUCTION

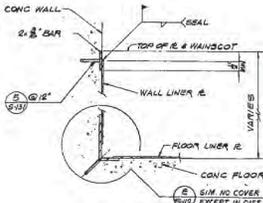

TYP WAINSCOT DETAIL UON
3/4" = 1'-0"

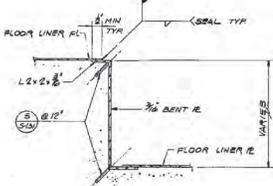

TYP CURB DETAIL UON
3/4" = 1'-0"

DESIGNED BY	DATE	SCALE	NO.
CHECKED BY	DATE	SCALE	NO.
APPROVED BY	DATE	SCALE	NO.
DATE	REVISIONS	DATE	BY

THE RALPH M. PARSONS COMPANY
ARCHITECTS-ENGINEERS
PASADENA, CALIFORNIA


U.S. ENERGY RESEARCH & DEVELOPMENT ADMINISTRATION
ISARD OPERATIONS OFFICE
DANDY HALL, WASH.

CPP AREA BUILDING NO. CPP-666
FLUORINEL AND STORAGE FACILITY
STRUCTURAL
TYPICAL LINER PLATE
PLAN, ELEVATION, SECTION & DETAILS

1560-CPP-666-S-132

INDEX CODE NUMBER
DATE AS SHOWN
DATE DRAWN 2-27-68

PROJECT NO. 5586-8007

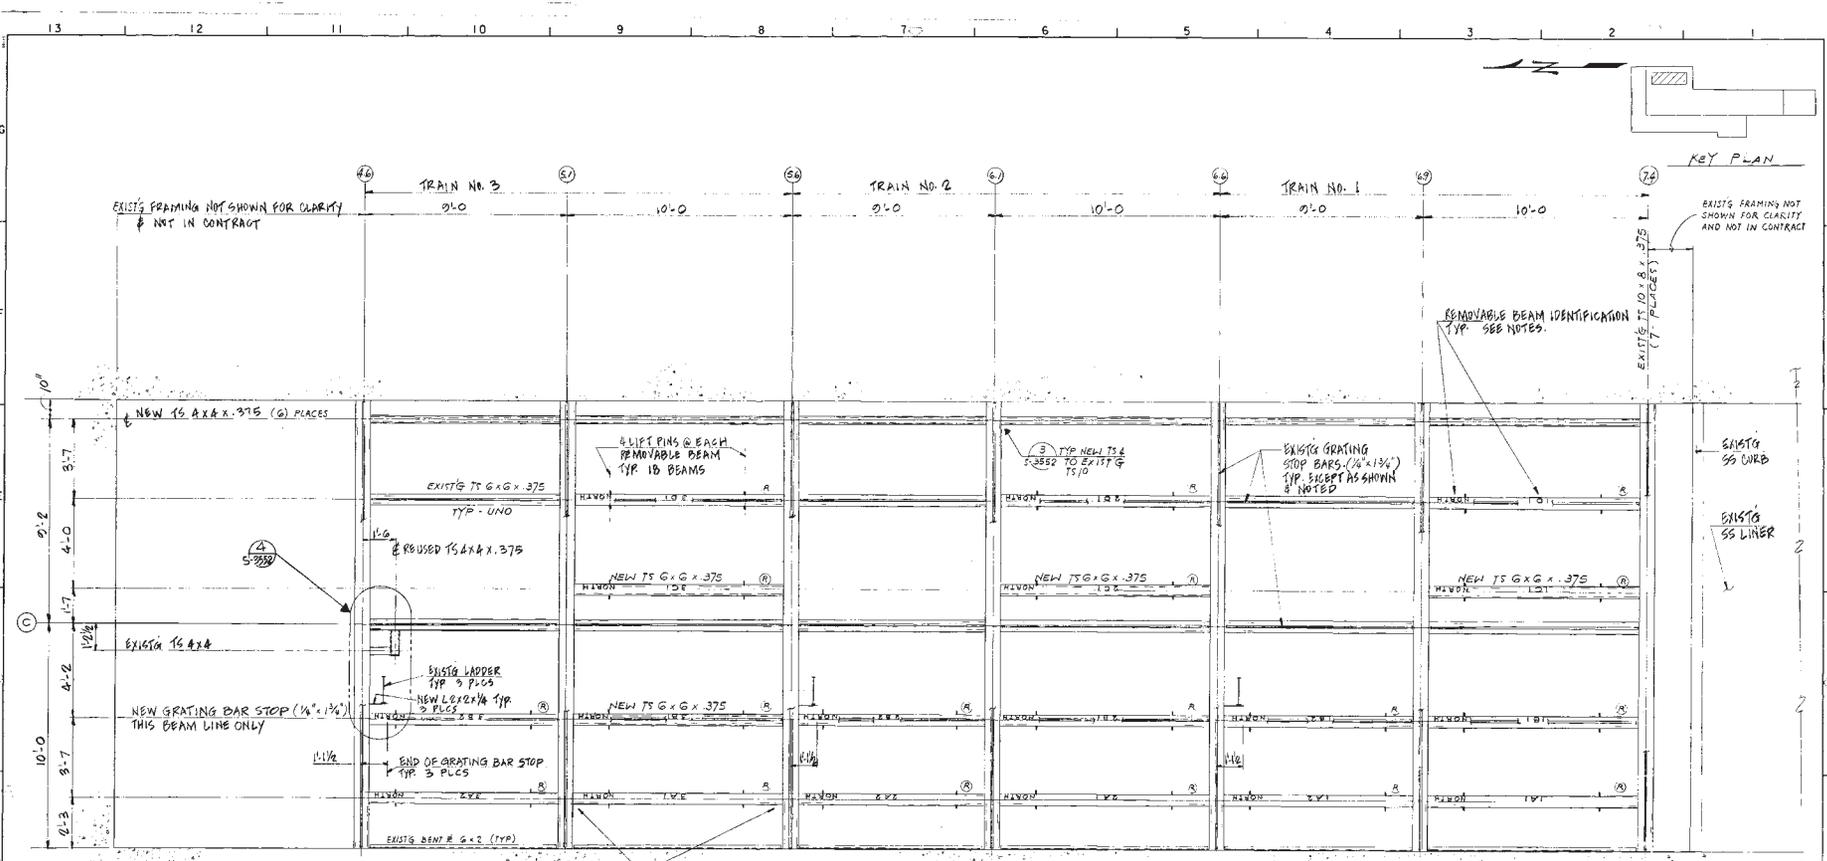

LEGEND
 (C) BEAMS SHALL BE MODIFIED TO A REMOVABLE TYPE

FOR BEAM CONNECTIONS AND LIFT PINS, SEE 'BEAM MODIFICATION' DETAILS DWG S-3552. TYPE 'B' MARKED REMOVABLE BEAMS ONLY.

PLAN - T.O.S. EL. +10'-0"±
 MODIFIED FRAMING PLAN (MAJOR FRAMING SHOWN ONLY)


- NOTES:**
- EXISTING DIMENSIONS AND ELEVATIONS ARE FOR REFERENCE ONLY AND MUST BE FIELD VERIFIED BY DISCREPANCY FROM TO MODIFICATION OR FABRICATION.
 - DISCREPANCY SHALL TAKE CARE NOT TO DAMAGE EXISTING EQUIPMENT OR STRUCTURE. CHANGES THERE SHALL BE REDUCED TO THEIR ORIGINAL CONDITION BY THE DISCREPANCY.
 - ALL STEEL SHALL BE STAINLESS PER SPECIFICATION 10000-071, STRUCTURAL STEEL. WELDING SHALL BE PER SPECIFICATION 30000-041, STRUCTURAL WELDING. ALL WELDS SHALL BE VISUALLY INSPECTED. ALL WELDS TO BE SEALED TO PREVENT ANY CORROSIONING TRAILS.
 - FABRICATION AND ERECTION TOLERANCE SHALL BE ± 1/16 INCH, UNLESS NOTED OTHERWISE.
 - THE CENTER OF GRAVITY OF THE REMOVABLE BEAM SHALL BE DETERMINED AFTER BEAM MODIFICATIONS ARE COMPLETE EXCEPT DISTORTION OF LIFT PINS. LIFT PINS SHALL THEN BE REVALUED CHECKED AGAINST THE ACTUAL BEAM CENTER OF GRAVITY AS SHOWN.
 - FOR BEAM REMOVAL TOOL SEE DRAWING 30437-CPP-666-4-3510.
 - ALL GRATING BETWEEN COLUMN LINE 6+4 AND 7+4 SHALL BE REMOVABLE. THIS INCLUDING ALL GRATING TO MAKE 1/4 INCH DIAMETER CIRCLES AS CALLED OUT IN SPECIFICATION 30000-071 TO FIT THE REMOVAL TOOL. REMOVAL GRATING SHALL BE CALLED OUT IN SPECIFICATION 30000-071-040, TO KEEP COMPATIBILITY WITH GRATING REMOVAL TOOL.
 - GRATING TO BE REMOVED SHALL BE FLAT WITHIN 1/8 INCH IN 2 FEET OR 1/4 INCH IN 5 FEET IN ANY DIRECTION. GRATING BASE AND CROSS BARS SHALL BE WELDED AND 10000-071.
 - NEW GRATING PANELS SHALL HAVE 1/4 INCH CLEARANCE AT GRATING STOP BARS AND CELL WALLS AND 1/2 INCH TO 1/2 INCH CLEARANCE BETWEEN PANELS. GRATING PANELS WHICH ARE NOT DIMENSIONED SHALL HAVE A MINIMUM BETWEEN 24 INCHES AND 28 INCHES. GRATING IS TO BE WELDED AND LIFT WELDED IN PLACE.
 - REMOVABLE BEAMS SHALL BE MARKED WITH THE IDENTIFICATION NUMBER SHOWN AT THE CENTER OF THE BEAM AND THE CORNER CONNECTION AT THE NORTH END OF THE BEAM. THE IDENTIFICATION IS TO BE 3/16 INCH FROM THE CENTER IN THE EAST SIDE OF THE BEAM ONLY. THE LETTERS ARE TO BE 1-1/2 INCHES HIGH AND MARKED WITH PUNCH CHARACTERS AT 1/4 INCH. THE WORD NUMBER PUNCH 1/4 INCH TO 1/4 INCH DIAMETER.
 - GRATING PANELS SHALL BE MARKED WITH THE IDENTIFICATION NUMBER AS SHOWN ON DRAWING 30437-CPP-666-5-3510. THE IDENTIFICATION IS TO BE READABLE FROM THE WINDOWS ON THE EAST SIDE OF THE PLATFORM. THE LETTERS ARE TO BE 1-1/2 INCH HIGH, MARKED WITH A WELD BEAM ON A 1/4 INCH TYPED BY 3 INCH BY 5 PANEL IN THE POSITION SHOWN.
 - SEE SCHEDULE "C" FOR GOVERNMENT FURNISHED EQUIPMENT AND MATERIALS (GPE).
 - WORK SHALL BE APPROVED BY TITLE III INSPECTOR PRIOR TO OPERATING. ALL WORK SHALL BE APPROVED BY TITLE III INSPECTOR PRIOR TO OPERATING. ALL WORK SHALL BE APPROVED BY TITLE III INSPECTOR PRIOR TO OPERATING. ALL WORK SHALL BE APPROVED BY TITLE III INSPECTOR PRIOR TO OPERATING.
 - PLATFORM AT EL. 0'-0" DESIGNED TO 1'-0" SLOPE OF 800 POUND ORBIT, 1'-0" SLOPE OF 1500 POUND ORBIT OR 500 POUNDS PER SQUARE FOOT UNIFORM LOAD.

QUALITY LEVEL II TITLE II
 FOR DRAWING UNDER SEE DRAWING NO. 30437-CPP-666-1-3547

U.S. DEPARTMENT OF ENERGY
 NUCLEAR REGULATORY COMMISSION
 CONTRACT NO. BLDG CPP-666
 BLDG CPP-666
 FOP CELL GRATING MODIFICATIONS
 STEEL FRAMING PLAN @ EL. +10'-0"±

NO.	DATE	REVISION/DESCRIPTION	BY	CHECKED	APP. AUTH.
1	05/10	REVISED PER DCA # 10112-275
2	05/31

30437-CPP-666-5-3519 R.O.

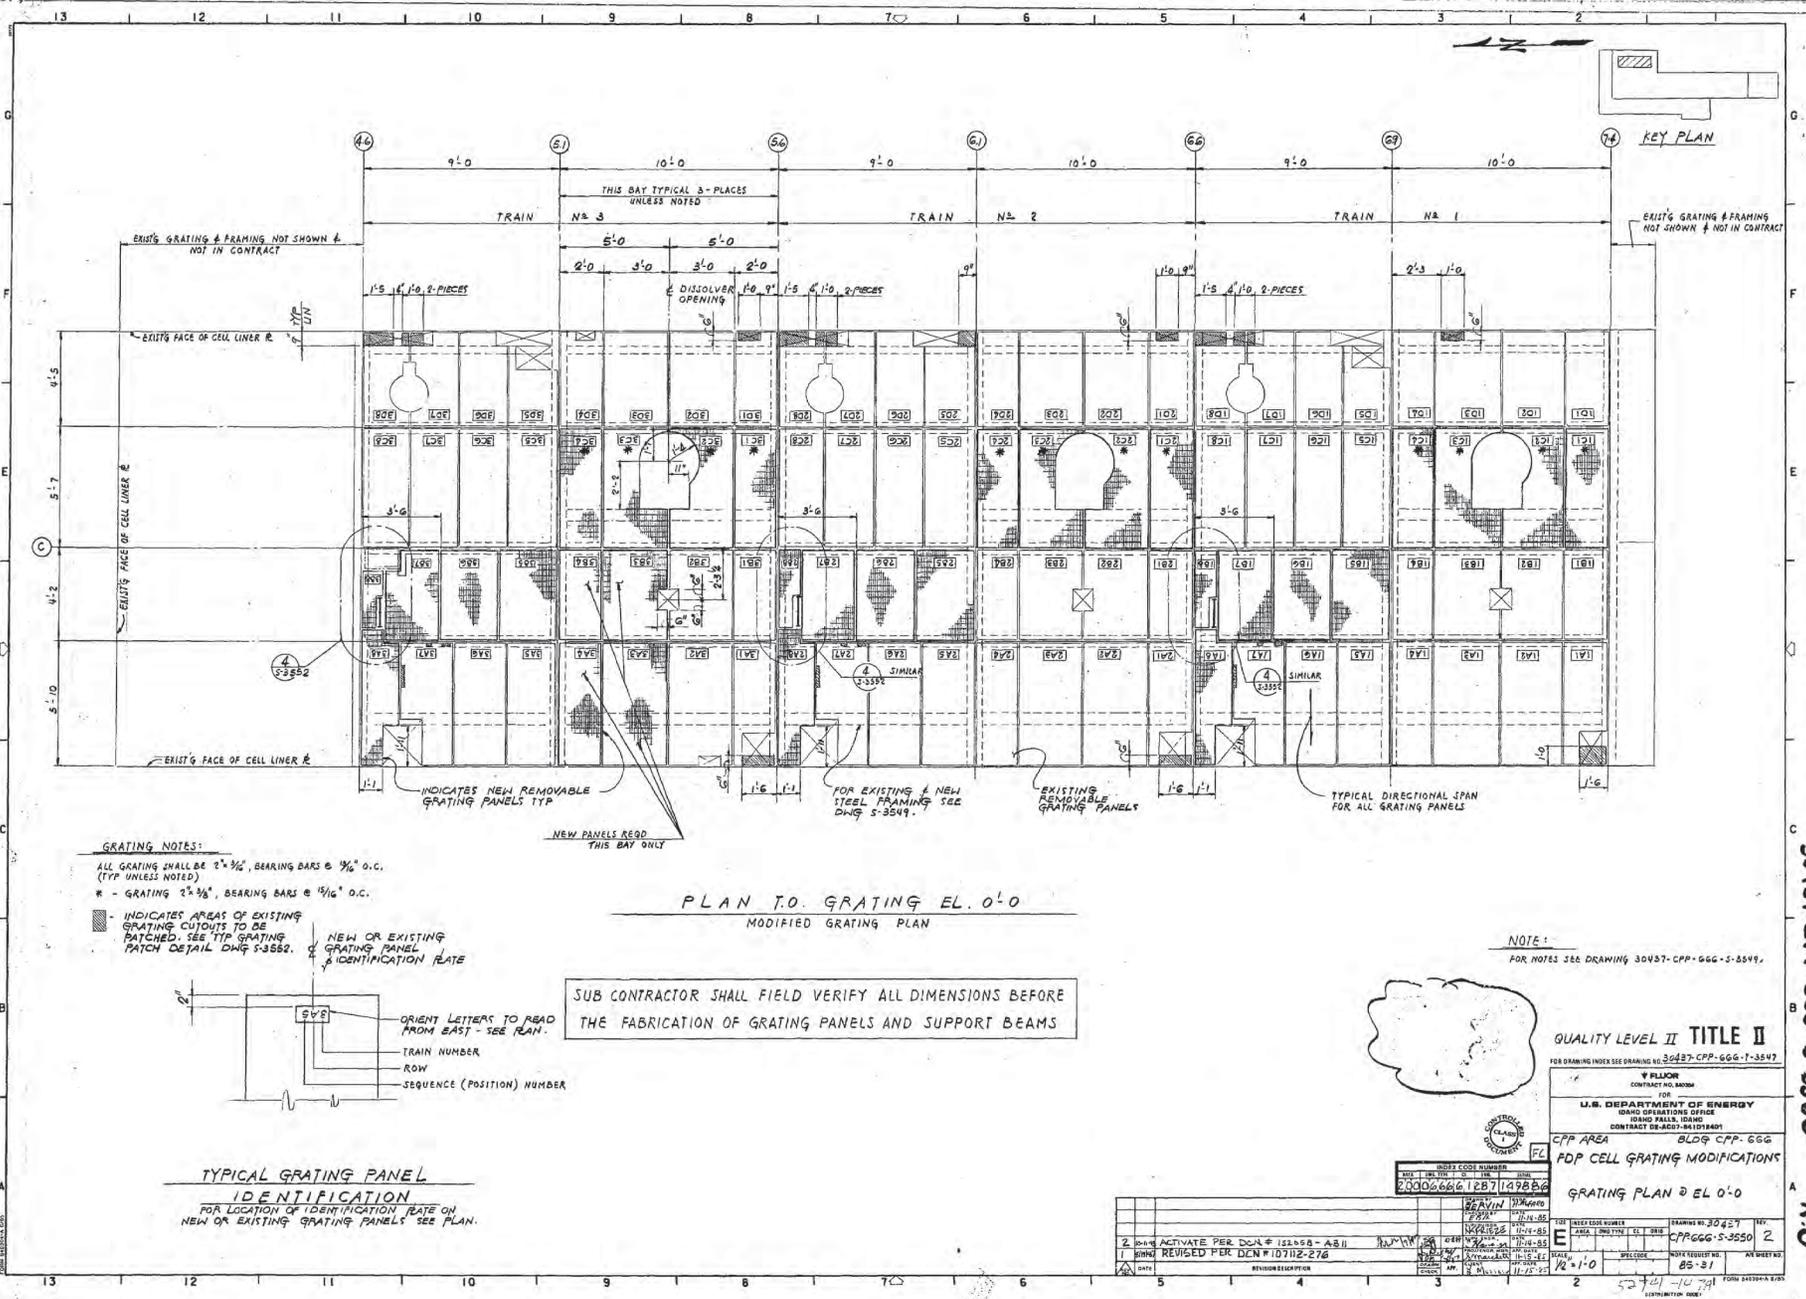

KEY PLAN

EXIST'G GRATING & FRAMING NOT SHOWN & NOT IN CONTRACT

EXIST'G GRATING & FRAMING NOT SHOWN & NOT IN CONTRACT

4 2352

4 2354 SIMILAR

4 2355 SIMILAR

INDICATES NEW REMOVABLE GRATING PANELS TYP

FOR EXISTING & NEW STEEL FRAMING SEE DWG 5-3549.

EXISTING REMOVABLE GRATING PANELS

TYPICAL DIRECTIONAL SPAN FOR ALL GRATING PANELS

NEW PANELS READ THIS BAY ONLY

GRATING NOTES:

ALL GRATING SHALL BE 2" x 3/8", BEARING BARS @ 3/8" O.C. (TYP UNLESS NOTED)


* - GRATING 2" x 3/8", BEARING BARS @ 1/2" O.C.

█ - INDICATES AREAS OF EXISTING GRATING CUTOUTS TO BE PATCHED. SEE TYP GRATING PATCH DETAIL DWG 5-3552.

NEW OR EXISTING GRATING PANEL IDENTIFICATION PLATE

PLAN T.O. GRATING EL. 0'-0"
MODIFIED GRATING PLAN

SUB CONTRACTOR SHALL FIELD VERIFY ALL DIMENSIONS BEFORE THE FABRICATION OF GRATING PANELS AND SUPPORT BEAMS

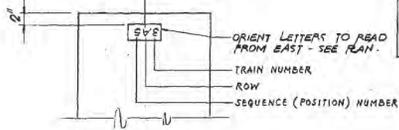

TYPICAL GRATING PANEL IDENTIFICATION
FOR LOCATION OF IDENTIFICATION PLATE ON NEW OR EXISTING GRATING PANELS SEE PLAN.

NOTE:

FOR NOTES SEE DRAWING 30427-CPP-666-5-3549.

QUALITY LEVEL II TITLE II

FOR DRAWING INDEX SEE DRAWING NO. 30427-CPP-666-1-3547

V PLLCON CONTRACT NO. 30427

FOR U.S. DEPARTMENT OF ENERGY

ORAND OPERATIONS OFFICE

ORAND FUEL, ISAND

CONTRACT DE-AC2Y-84D184D1

CPP AREA BLDG CPP-666


PDP CELL GRATING MODIFICATIONS

GRATING PLAN @ EL. 0'-0"



NO.	DATE	REVISION/DESCRIPTION	BY	CHECKED	DATE	SCALE	PROJECT	WORK REQUIRED NO.	NO. SHEETS
2	11/15/85	ACTIVATE PER DC&F 152558-AB11	W.P.W.		11/15/85	1/4" = 1'-0"	CPP666-5-3550	2	
1	11/15/85	REVISED PER DCN #10712-276			11/15/85				

30427-CPP-666-5-3550 R.O.

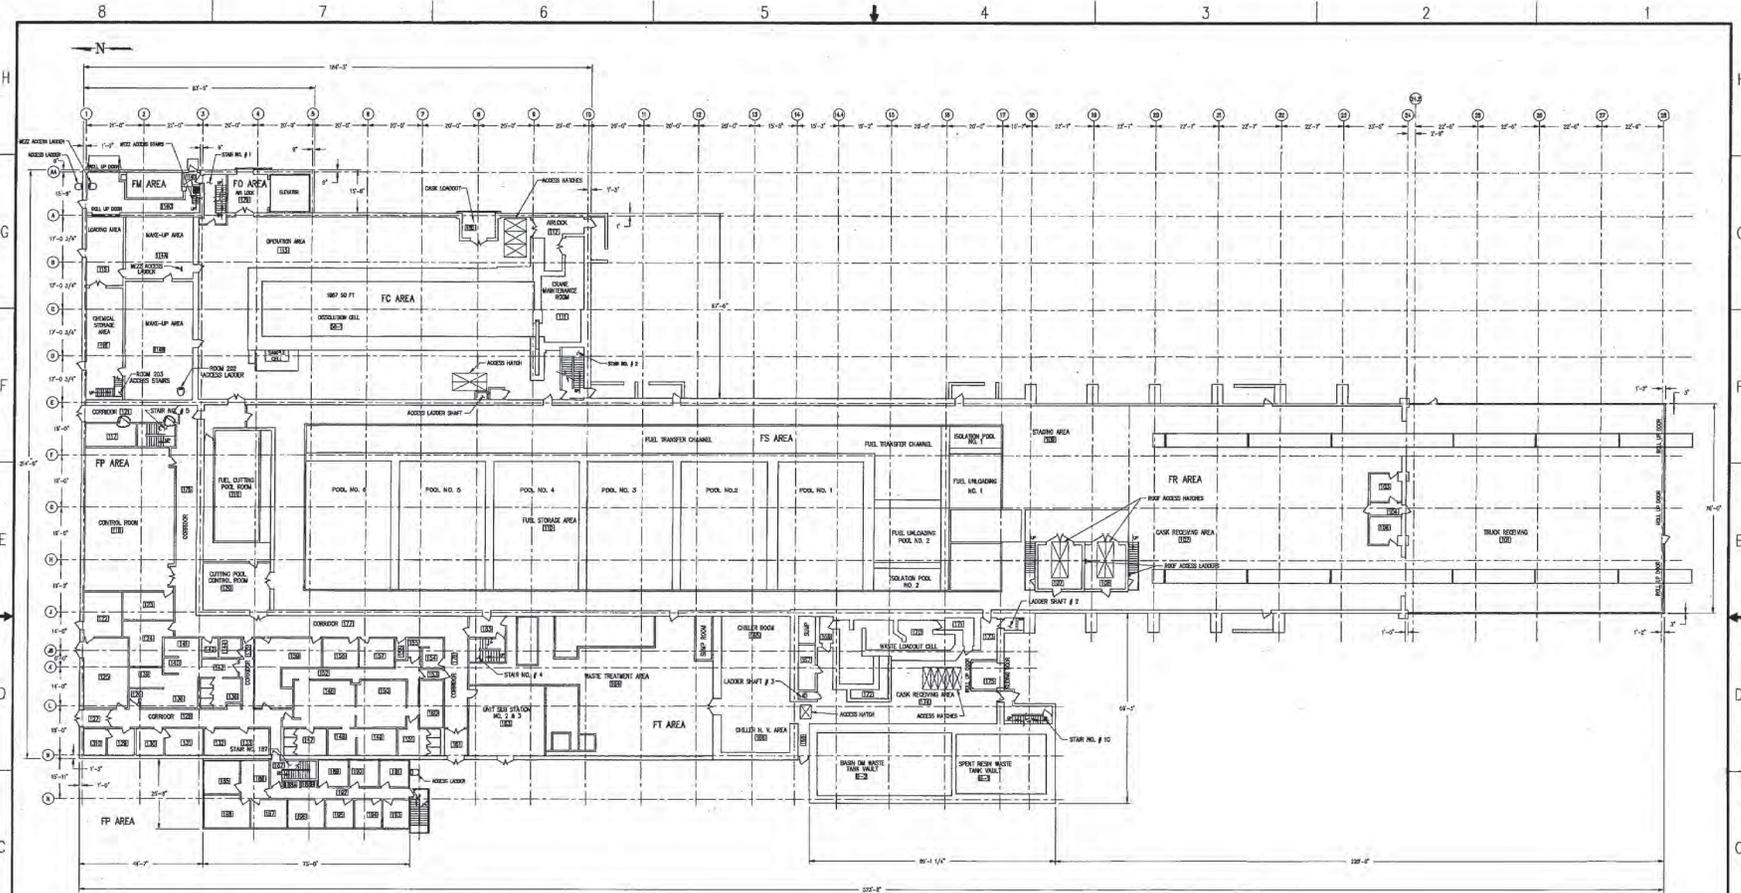

FIRST FLOOR PLAN ELEV. 0'-0"

ROOM NO.	TITLE	SQUARE FOOT	ROOM NO.	TITLE	SQUARE FOOT	ROOM NO.	TITLE	SQUARE FOOT
101	TRUCK REPAIR AREA	2,050	124	OFFICE ROOM	48			
102	COPY ROOM	83	125	CONTROL ROOM	21			
103	OFFICE ROOM	113	126	ARM LOCK ROOM	85			
104	CORRIDOR	56	127	ARM LOCK ROOM	85			
105	OFFICE ROOM	136	128	WOMEN'S LOCKER ROOM	280			
106	OFFICE ROOM	111	129	WOMEN'S LOCKER ROOM	280			
107	WOMEN'S LOCKER ROOM	286	130	WOMEN'S SHOWER AREA	45			
108	WOMEN'S LOCKER ROOM	286	131	WOMEN'S SHOWER AREA	45			
109	STORAGE AREA	1,228	132	WOMEN'S RESTROOM	42			
110	FUEL STORAGE AREA	1,428	133	WOMEN'S TOILET	177			
111	WOMEN'S VESTIBULE AREA	45	134	WOMEN'S VESTIBULE	45			
112	OPERATION AREA	4,771	135	ARM LOCK ROOM	220			
113	MAKE-UP AREA	1,008	136	OFFICE ROOM	151			
114	MAKE-UP AREA	1,008	137	MEN'S CHANGING ROOM	406			
115	MAKE-UP AREA	1,008	138	MEN'S CHANGING ROOM	406			
116	MAKE-UP AREA	1,008	139	MEN'S CHANGING ROOM	406			
200	MAKE-UP AREA	1,008	223	MEN'S CHANGING ROOM	406			

GENERAL NOTES:
 1. TOTAL FLOOR AREA: 77,008 SQ. FT. FOOTAGE CALCULATED FROM INSIDE OF THE EXTERIOR WALLS.

4	REVISED PER DOW #157058-AB20	10/25/90
3	REVISED PER DOW 155447-AB2	10/25/90
NO.	REVISIONS	

Westinghouse Idaho Nuclear Company Inc.
 IDAHO CHEMICAL PROCESSING PLANT
 IDAHO FALLS, IDAHO

FOR
 U.S. DEPARTMENT OF ENERGY
 IDAHO OPERATIONS OFFICE
 IDAHO FALLS, IDAHO

CPP-666
 SPACE OCCUPANCY
 FIRST FLOOR PLAN


SCALE 1/8" = 1'-0"
 DATE ISSUED 8/15/90

JOB NUMBER 122820 TAKEN FROM DRAWING NO. NEW DWG



FC	FR
FM	FS
FD	FT
FP	FY




200 0666 031936 092443 4

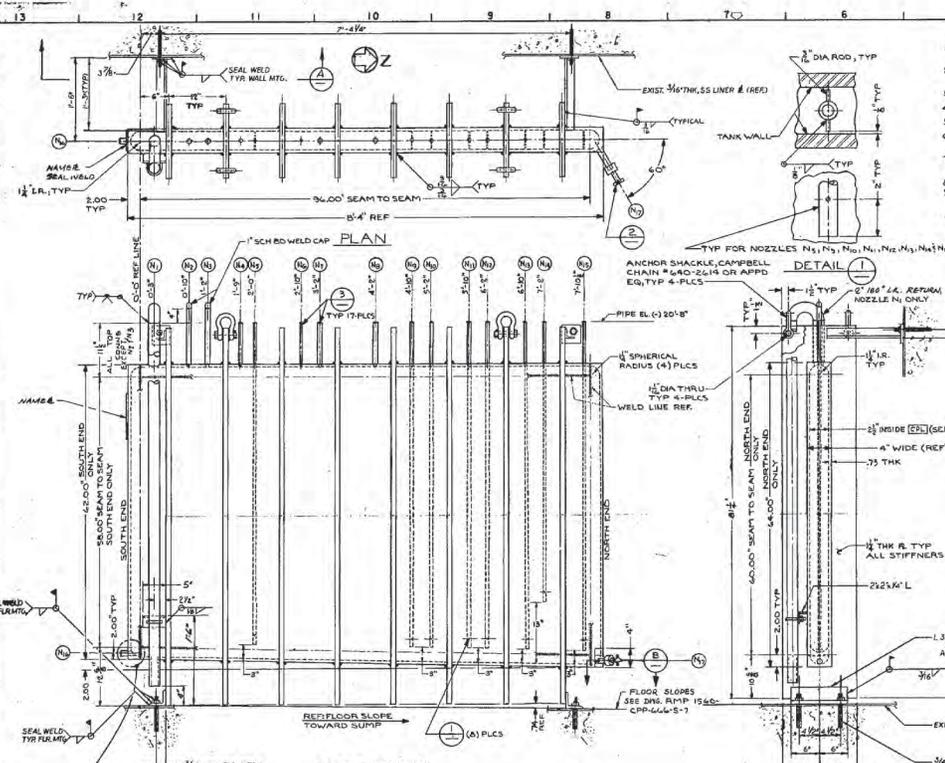

- NOTES:** (UNLESS OTHERWISE SPECIFIED)
- DESIGN BASIS: ASME CODE, SECTION VIII, DIVISION II, 1988 EDITION WITH WINTER 1984 ADDENDA, APPENDIX II
 - ALL WELDS SHALL BE VISUAL AND DYE PENETRANT INSPECTED 100% (SEE SPECIFICATION 3000-G-11)
 - SUBCONTRACTOR SHALL FINISH ALL PARTS.
 - REMOVE ALL BURRS AND SHARP EDGES
 - ALL STUB ENDS SHALL BE BEVELED PER ANSI B16.25
 - MAXIMUM ALLOWABLE STRESS @ DESIGN TEMPERATURE = 15,600 PSI
 - SPECIFIC GRAVITY OF OPERATING LIQUID 1.17 DESIGN LIQUID LEVEL 1 FULL
 - ALL DIMENSIONS FROM REFERENCE LINE
 - ALL SET ON NOZZLES SHALL BE INSPECTED BY SUB CONTRACTOR AFTER BEFORE WELDING TO ENSURE ALIGNMENT OF I.D. OF NOZZLE AND THRU LINE
 - CRITICALITY PREVENTION LIMIT (CPL) DIMENSIONS, PARTS OR MATERIALS DESIGNATED BY THE (CPL) PREVENTION LIMIT SYMBOL SHALL BE AS SHOWN ON THE CONTRACT DRAWINGS AND SHALL NOT BE CHANGED OR SUBSTITUTED. THE INSPECTOR SHALL VERIFY AND RECORD IN THE INSPECTION RECORDS THAT THE WORK COMPLIES WITH THE CONTRACT DRAWINGS. THE TOLERANCE DUE TO THE CRITICALITY PREVENTION LIMIT (CPL) FOR THE SLAB TANK IS 1/32" EXPANSION JOINTS FOR CONCRETE SHALL BE FIELD LOCATED TO AVOID EXISTING REINFORCING STEEL.

DESIGN DATA

1. DESIGN BASIS	SEE NOTE 1
2. DESIGN REQUIREMENTS	YES PER ASME CODE
3. WELD 3000-G-11, WS, SCALE 1/2"=1'-0"	104 FT
4. CORNERS	100% POSITION
5. LOW PRESSURE	PROTECT
6. INSULATION	NONE
7. WELD EXAMINATION	RT-1, VISUAL & DYE PENETRANT
8. DYE PENETRANT	SEE NOTE 2
9. DYE PENETRANT	100% INSIDE
10. NON-CORROSION ALLOWANCE	SHLL .015" MINOR .025" MAJOR
11. MAX. ALLOWABLE WORKING PRESSURE DESIGN TEMP PER ASME CODE	15.6
12. MAX. ALLOWABLE WORKING PRESSURE DESIGN TEMP PER ASME CODE	15.6
13. SPECIFIC GRAVITY OF OPERATING LIQUID	1.17
14. DESIGN LIQUID LEVEL	1 FULL
15. MATERIAL SPECIFICATION	SEE NOTE 3
16. ENDOS	S.A.304 T-304L
17. STIFFENERS	S.A.304 T-304L
18. FITTINGS	C.A.45 T-304L
19. PIPE	C.A.45 T-304L
20. INTERNAL PIPES	ASTM A 312 (HASTELLOY C 4) B3P1
21. INTERNAL PIPES	ASTM A 312 (HASTELLOY C 4) B3P1

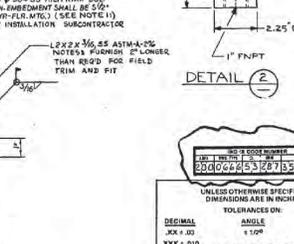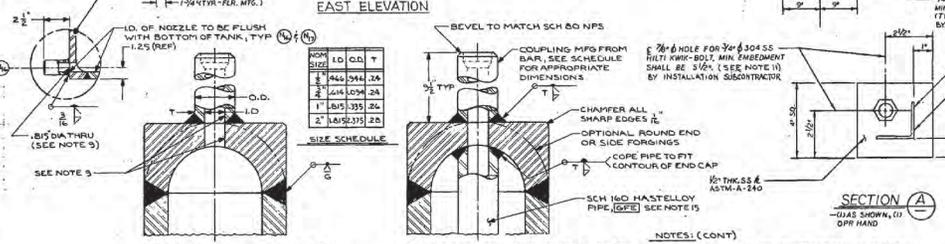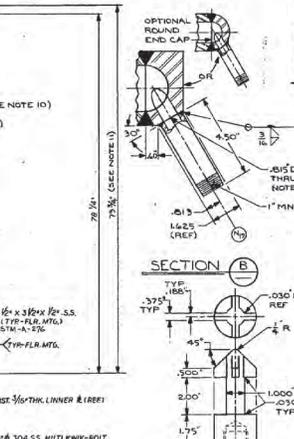

- NOTES (CONT)**
- VESSEL SHALL BE HYDROTESTED IN VERTICAL POSITION.
 - FOR LOCATION OF SLAB TANK SEE SEE DWG 30442-CPP-666-P-3445
 - SEISMIC DESIGN DATA: IBC 1988, ZONE 3
 - (CPL) SYMBOL INDICATES GOVERNMENT FURNISHED EQUIPMENT

CONNECTION SCHEDULE

NO.	DESCRIPTION	FOR	SMALLER	FOR	LARGER
10.	SEE ELEVATION				

ESTIMATED VESSEL WEIGHTS

NO.	DESCRIPTION	WEIGHT (LB)
1.	TANK SHELL	5665
2.	NOZZLE CONNECTION	2410
3.	PIPE	7515
4.	PIPE	7500
5.	CAPACITY	255,000

APPROVED FOR CONSTRUCTION

TITLE II

QUALITY LEVEL I

U.S. DEPARTMENT OF ENERGY

SLAB OPERATIONS OFFICE

CONTRACT 01-80-2413-1401

CPD AREA BUILDING 666

SLAB TANK

VEE-10-10A

MODIFY: SUMP SYSTEM

DATE: 11-1-85


BY: J. J. JONES

NO. 11-3653

REVISION: 85-32

REVISIONS

NO.	DATE	DESCRIPTION
1	11-1-85	ISSUED FOR CONSTRUCTION
2	11-1-85	ISSUED FOR CONSTRUCTION
3	11-1-85	ISSUED FOR CONSTRUCTION
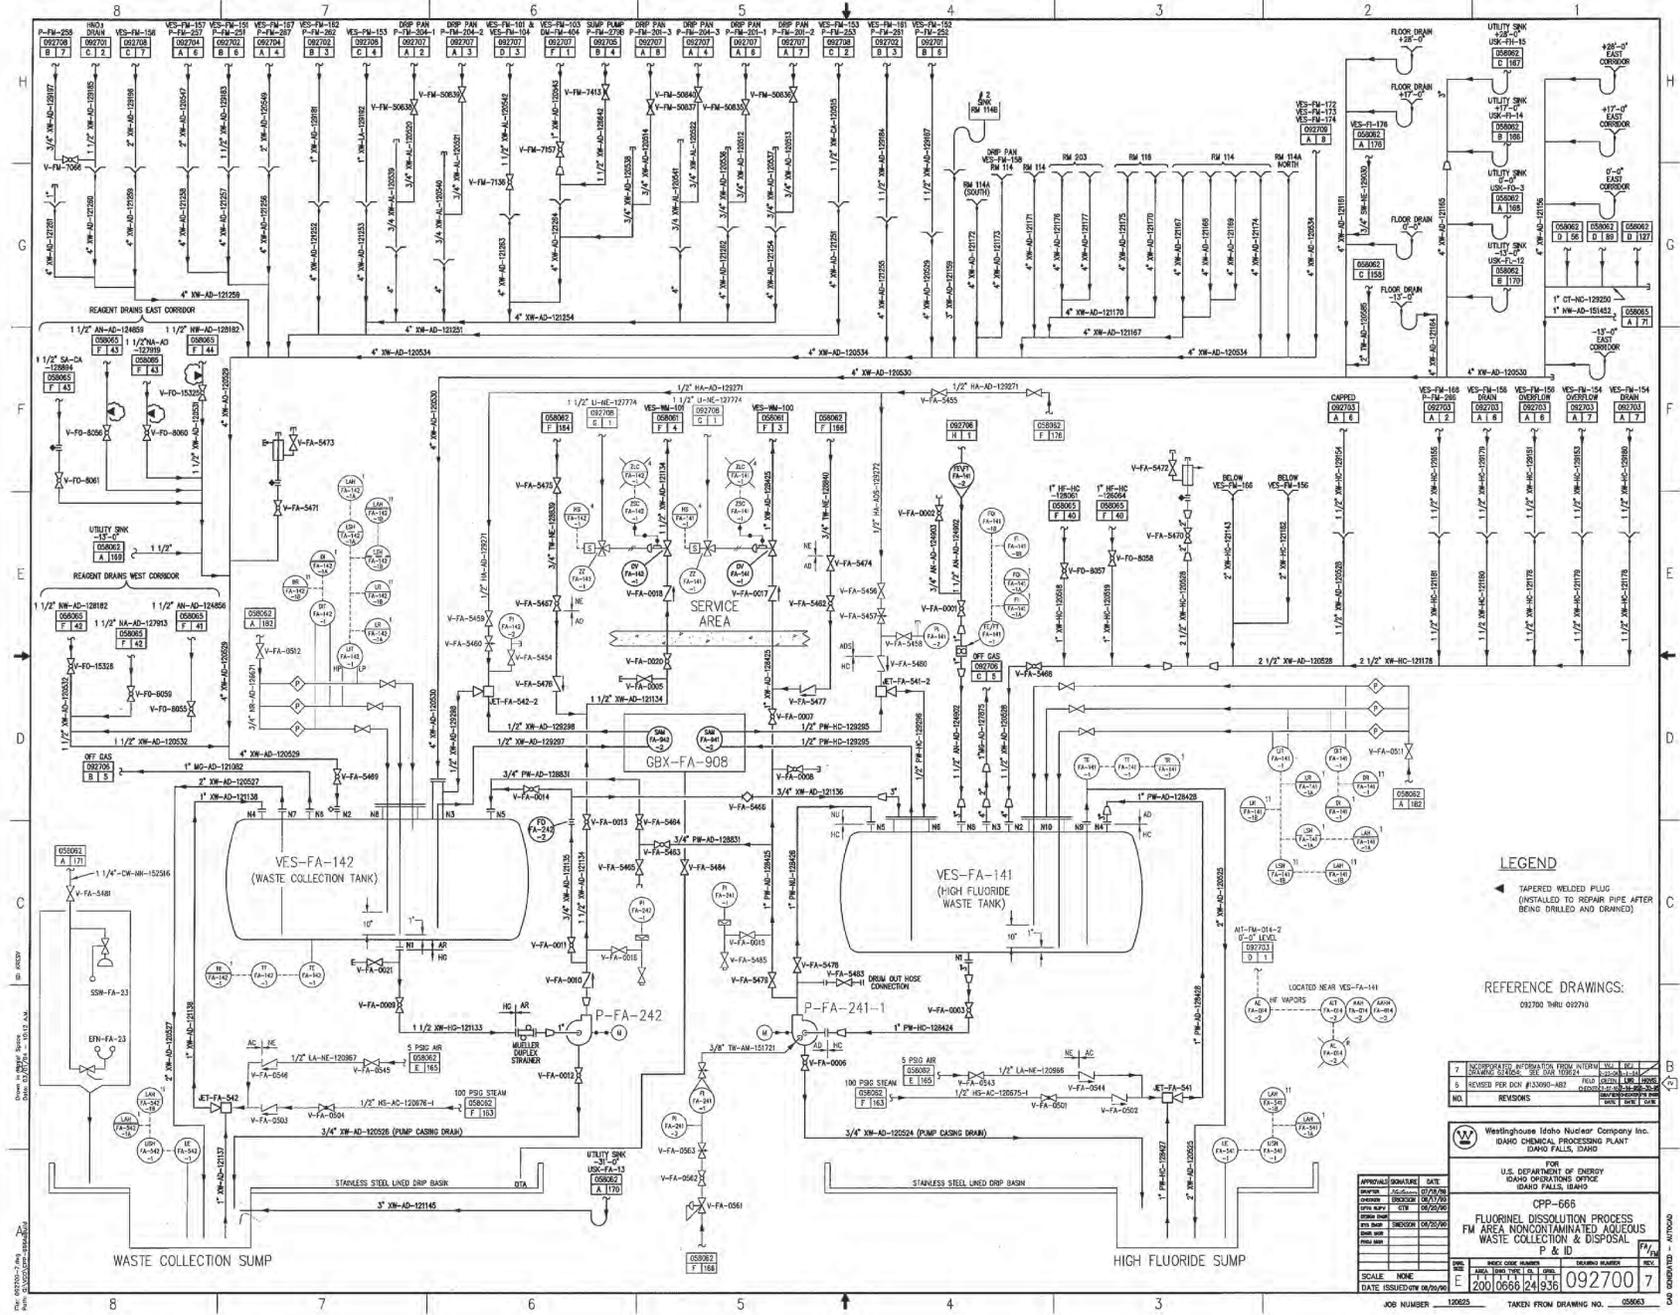

LEGEND
 ▲ TAPERED WELDED PLUG
 (INSTALLED TO REPAIR PIPE AFTER
 BEING DRILLED AND SPACED)

REFERENCE DRAWINGS:
 092700 THRU 092710

NO	REVISIONS
1	INCORPORATED INFORMATION FROM REVISED SHEET 092700
2	REVISED PER DCH #13360-487 FROD DESIGN LMR 09262902
3	REVISED PER DCH #13360-487 FROD DESIGN LMR 09262902


Westinghouse Idaho Nuclear Company Inc.
 IDAHO CHEMICAL PROCESSING PLANT
 IDAHO FALLS, IDAHO

FOR
 U.S. DEPARTMENT OF ENERGY
 IDAHO OPERATIONS OFFICE
 IDAHO FALLS, IDAHO

CPP-666
 FLUORINE DISSOLUTION PROCESS
 FM AREA NONCONTAMINATED AQUEOUS
 WASTE COLLECTION & DISPOSAL
 P & I D

APPROVED DRAWING DATE	09/27/70
DESIGNER	09/27/70
CHECKED	09/27/70
SCALE	NONE
DATE ISSUED	09/29/70

NO	REVISED PER	DATE
1	092700	09/27/70
2	092700	09/27/70
3	092700	09/27/70

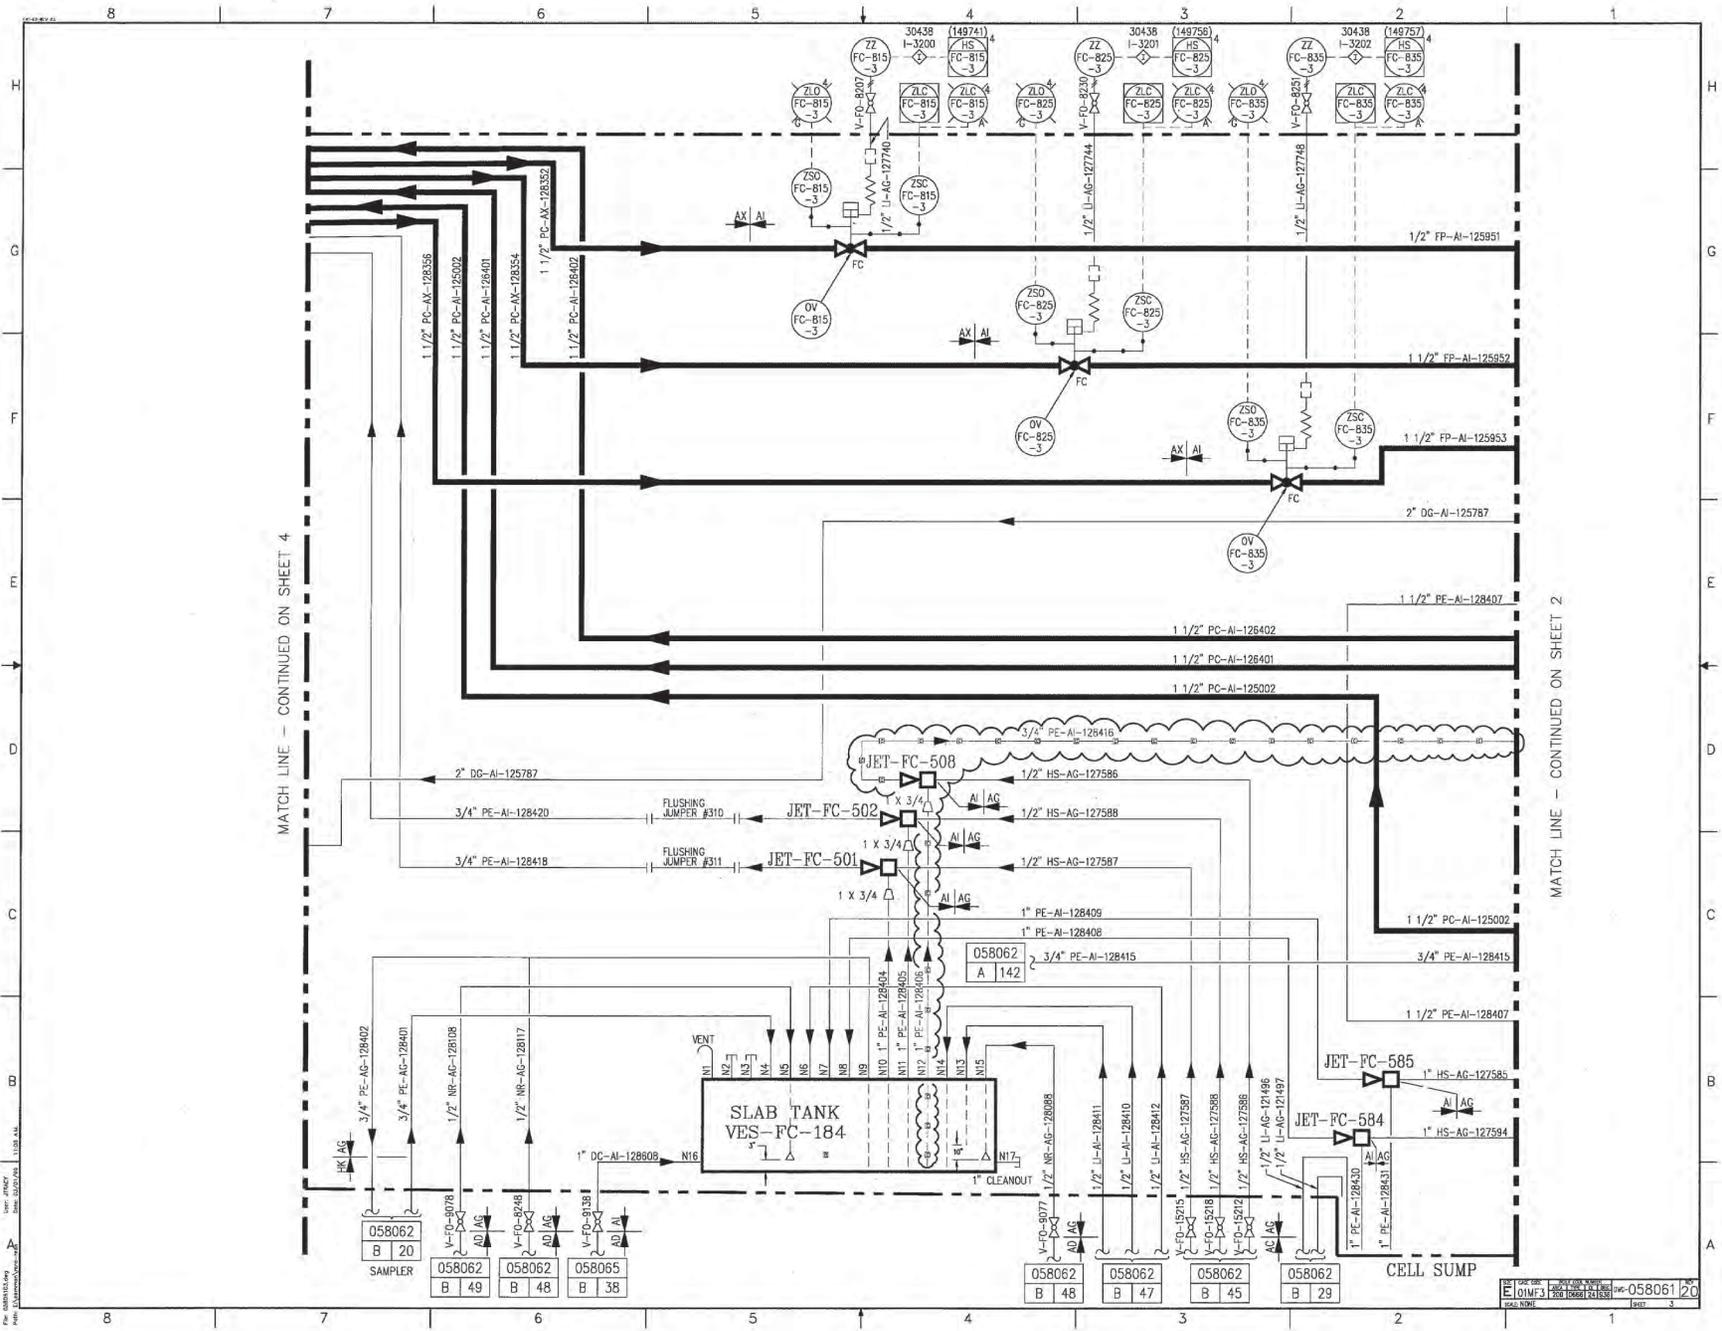

MATCH LINE - CONTINUED ON SHEET 4

MATCH LINE - CONTINUED ON SHEET 2


8 7 6 5 4 3 2 1

H
G
F
E
D
C
B
A


8 7 6 5 4 3 2 1

PIPING SYMBOLS
 058062 B 20
 058062 B 49
 058062 B 48
 058065 B 38
 058062 B 48
 058062 B 47
 058062 B 45
 058062 B 29


DATE	REV.	BY	CHKD.	APP.	NO.
01/11/20	3	0101M/F3	0101M/F3	0101M/F3	0101M/F3
SCALE	NO. OF SHEETS	TOTAL NO. OF SHEETS	SHEET NO.		
	3	3	058061 20		

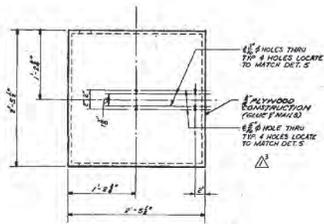


COVER (2)
1/4" = 1'-0" (M-21)

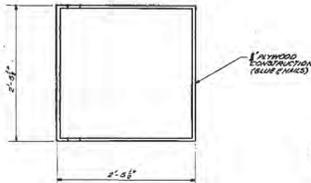


BASE (3)
1/4" = 1'-0" (M-21)

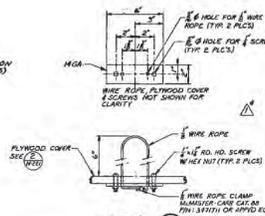


BAIL (5)
3/4" = 1'-0" (M-21)

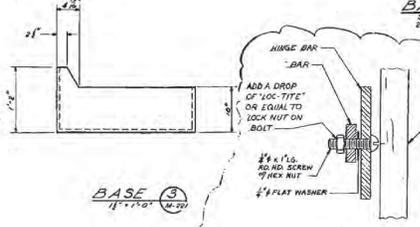


HINGE (4)
1/2" = 1'-0" (M-21)

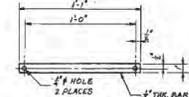


BAR (9)
3/4" = 1'-0" (M-21)

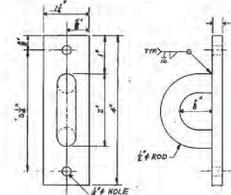


HASP RING (8)
FULL SCALE (M-21)

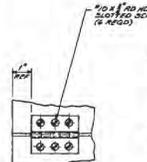


VIEW (A)
1/2" = 1'-0" (M-21)

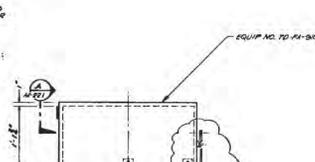


PLYWOOD BOX (1)
1/4" = 1'-0" (M-21)

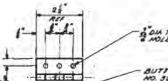


HINGE (4)
1/2" = 1'-0" (M-21)

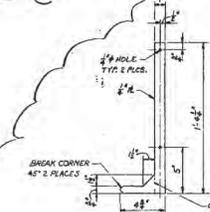


HINGE BAR (10)
3/4" = 1'-0" (M-21)

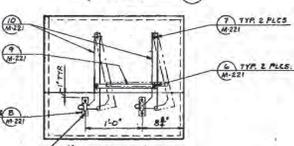

LATCH ASSY (6)
1/2" = 1'-0" (M-21)

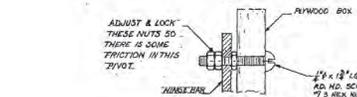

DETAIL (7)
FULL SCALE (M-21)

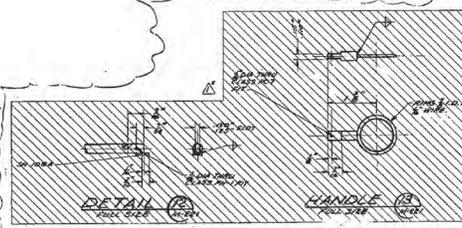

HANDLE (11)
1/2" = 1'-0" (M-21)

- NOTES:**
- BREAK ALL SHARP EDGES AND REMOVE ALL BURRS.
 - DIMENSIONS GIVEN ARE TO THEORETICAL SHARP CORNERS.
 - ALL PARTS SHALL BE THOROUGHLY CLEANED TO REMOVE ALL FOREIGN MATTER BEFORE FINAL ASSEMBLY.
 - FOR GENERAL APPROPRIATE DRAWING SEE CORRESPONDING NUMBER IN THIS SET.
 - ALL MATERIAL SHALL BE CARBON STEEL UNLESS OTHERWISE SPECIFIED.
 - ALL FITS SHALL CONFORM TO ANSI B-1.

APPROVED FOR CONSTRUCTION

CONTRACT NO. EQUIPMENT NO. (VENDOR DATA IN)

DATE	BY	REVISION	DATE	BY	REVISION

THE RALPH M. PARSONS COMPANY
 1400 R STREET, N.W.
 WASHINGTON, D.C. 20004

U.S. ENERGY RESEARCH & DEVELOPMENT ADMINISTRATION
 PLANT OPERATIONS OFFICE
 DAVID FALLS, IDAHO

CPP AREA BUILDING NO. CPP-666
 FLUORINEL AND STORAGE FACILITY
 MECHANICAL
 REMOTE HANDLING AIR FILTRATION CELL
 PLYWOOD BOX

1580-CPP-666-M-221



UNLESS OTHERWISE SPECIFIED
 DIMENSIONS ARE IN INCHES AND
 DECIMALS THEREOF
 DIMENSIONS IN PARENTHESES ARE
 IN MILLIMETERS

SCALE: AS SHOWN
 1" = 1'-0"

PROJECT NO. 5586-7303

NOTES:

1. REMOVE ALL BURRS AND SHARP EDGES.
2. ALL MACHINED FILLET RADI $R_{0.03}$ MAXIMUM UNLESS OTHERWISE NOTED.
3. WELD PER INEEL WELD PROCEDURE SPECIFICATION S2.0 USING WELD FILLER METAL, ITEM 13.
4. VISUALLY INSPECT FINAL PASS OF ALL WELDS. ACCEPTANCE CRITERIA SHALL BE:
 - NO CRACKS.
 - COMPLETE FUSION SHALL EXIST BETWEEN WELD METAL AND BASE METAL.
 - UNDERCUT SHALL NOT EXCEED .01" FOR MATERIAL LESS THAN 3/16". FOR MATERIAL 3/16" AND THICKER, UNDERCUT NOT TO EXCEED 1/32".
 - FOR ALL WELDS THE SUM OF VISIBLE POROSITY 1/32" OR GREATER IN DIAMETER SHALL NOT EXCEED 3/8" IN ANY LINEAR INCH OF WELD AND SHALL NOT EXCEED 3/4" IN ANY 12" LENGTH OF WELD.
 - ALL CRATERS SHALL BE FILLED TO THE FULL CROSS-SECTION OF THE WELD EXCEPT FOR ENDS OF FILLET WELDS OUTSIDE THEIR EFFECTIVE LENGTH.
 - FILLET WELDS SHALL BE AT LEAST THE SIZE SPECIFIED IN THE WELD SYMBOL.
5. FINAL ASSEMBLY SHALL MEET CLEANLINESS REQUIREMENTS OF STD-7022, LEVEL D.
6. MECHANICALLY ETCH WITH INFORMATION SHOWN WITH 1/4" HIGH CHARACTERS SUBSTITUTING FOR "XX" THE SERIAL NUMBERS PROVIDED BY REQUESTER.
7. PROVIDE A CLEARANCE OF 1/8" MAXIMUM BETWEEN ITEM 8, BACK CLAMP, AND THE RECTANGULAR WASTE CONTAINER, WHEN THE CLAMP IS INSTALLED UNDER THE CONTAINER'S LIP.
8. VERIFY MARKING OF EQUIPMENT NUMBER HAS BEEN APPLIED ACCURATELY.
9. SEE EDF-5675 FOR CAPACITY CALCULATIONS AND PROOF TEST RESULTS.
10. MECHANICALLY ETCH WITH INFORMATION SHOWN WITH 1/4" HIGH CHARACTERS.

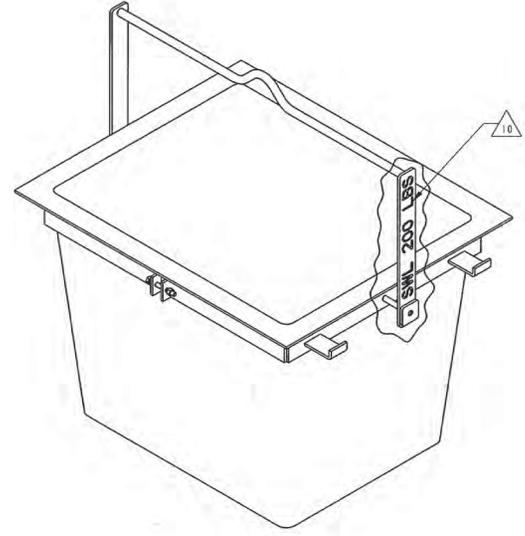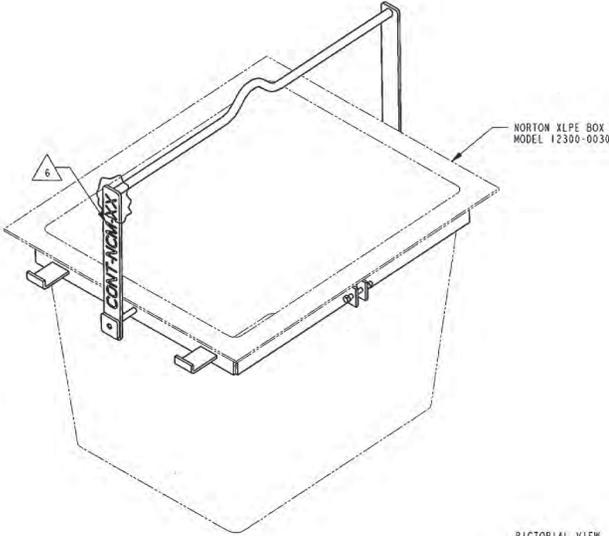


PICTORIAL VIEW FOR CLARITY ONLY

SHEET			REV STATUS		REVISIONS	
NO.	REV	OF SHEETS	REV	OF SHEETS	DESCRIPTION	EFFECTIVE DATE
1	1	1	1	1	REVISED PER DRF 316500	4/9/2007 E.E.E.

AR	CG		WELD FILLER METAL	ER308 OR 308L	AWS A5.9	13
						12
1	CG		NUT, HEX 3/8-16 UNC-2B	SST		11
1	CG		BOLT, HEX HEAD 3/8-16 UNC-2A X 3 LG	SST		10
2	CG	-9	FRONT CLAMP	BAR, 1/4 X 2 304 OR 304L SST	ASTM A276	9
1	CG	-8	BACK CLAMP	BAR, 1/4 X 2 304 OR 304L SST	ASTM A276	8
2	CG	-7	BAIL HANDLE	BAR, 1/4 X 2 304 OR 304L SST	ASTM A276	7
4	CG	-6	BAIL STOP	BAR, 1/4 X 2 304 OR 304L SST	ASTM A276	6
2	CG	-5	BAIL KEEPER	BAR, 1/4 X 2 304 OR 304L SST	ASTM A276	5
2	CG	-4	BAIL PIN	BAR, ϕ 1/2 304 OR 304L SST	ASTM A276	4
1	CG	-3	BAIL	BAR, ϕ 3/4 304 OR 304L SST	ASTM A276	3
						2
						1
-1	SAFETY		PART OR IDENTIFYING NO.	NOMENCLATURE OR DESCRIPTION	MATERIAL/SPECIFICATION OR VENDOR NAME	ITEM NO.


INSPECTION REQUIREMENTS QC REQUIRED 01MF3 DENOTES Q/C INSP. REQ.		-1 FINAL DASH NO. NEXT ASSY APPLICATION	DIMENSIONING AND SYMBOLS ARE AMERICAN NATIONAL STANDARD UNLESS OTHERWISE SPECIFIED SURFACE FINISHNESS #25 DIMENSIONS AND TOLERANCES ARE IN INCHES TOLERANCES: $\pm .01$ DECIMALS: $\pm .03$ FRACTIONS: $\pm .005$ ANGULAR: $\pm 2^\circ$ DO NOT SCALE DRAWING	SUBCONTRACT NO. REQUESTER: J. LAW DESIGN: W. SHURTLEIFF DRAWN: V.K. JACKSON PROJECT NO. SPEC CODE FOR REVIEW/APPROVAL SIGNATURES SEE BAR NO. 120924 EFFECTIVE DATE: 03/08/05 D.E.J.	INEEL CPP-659 REMOTE WASTE BOX BAIL ASSEMBLY CONT-NCM-16 SIZE CASE CODE D 01MF3 INEEL CODE NUMBER 200 0659 41 0930 DWG-630299 NCM SHEET 1 OF 3
--	--	---	---	---	---

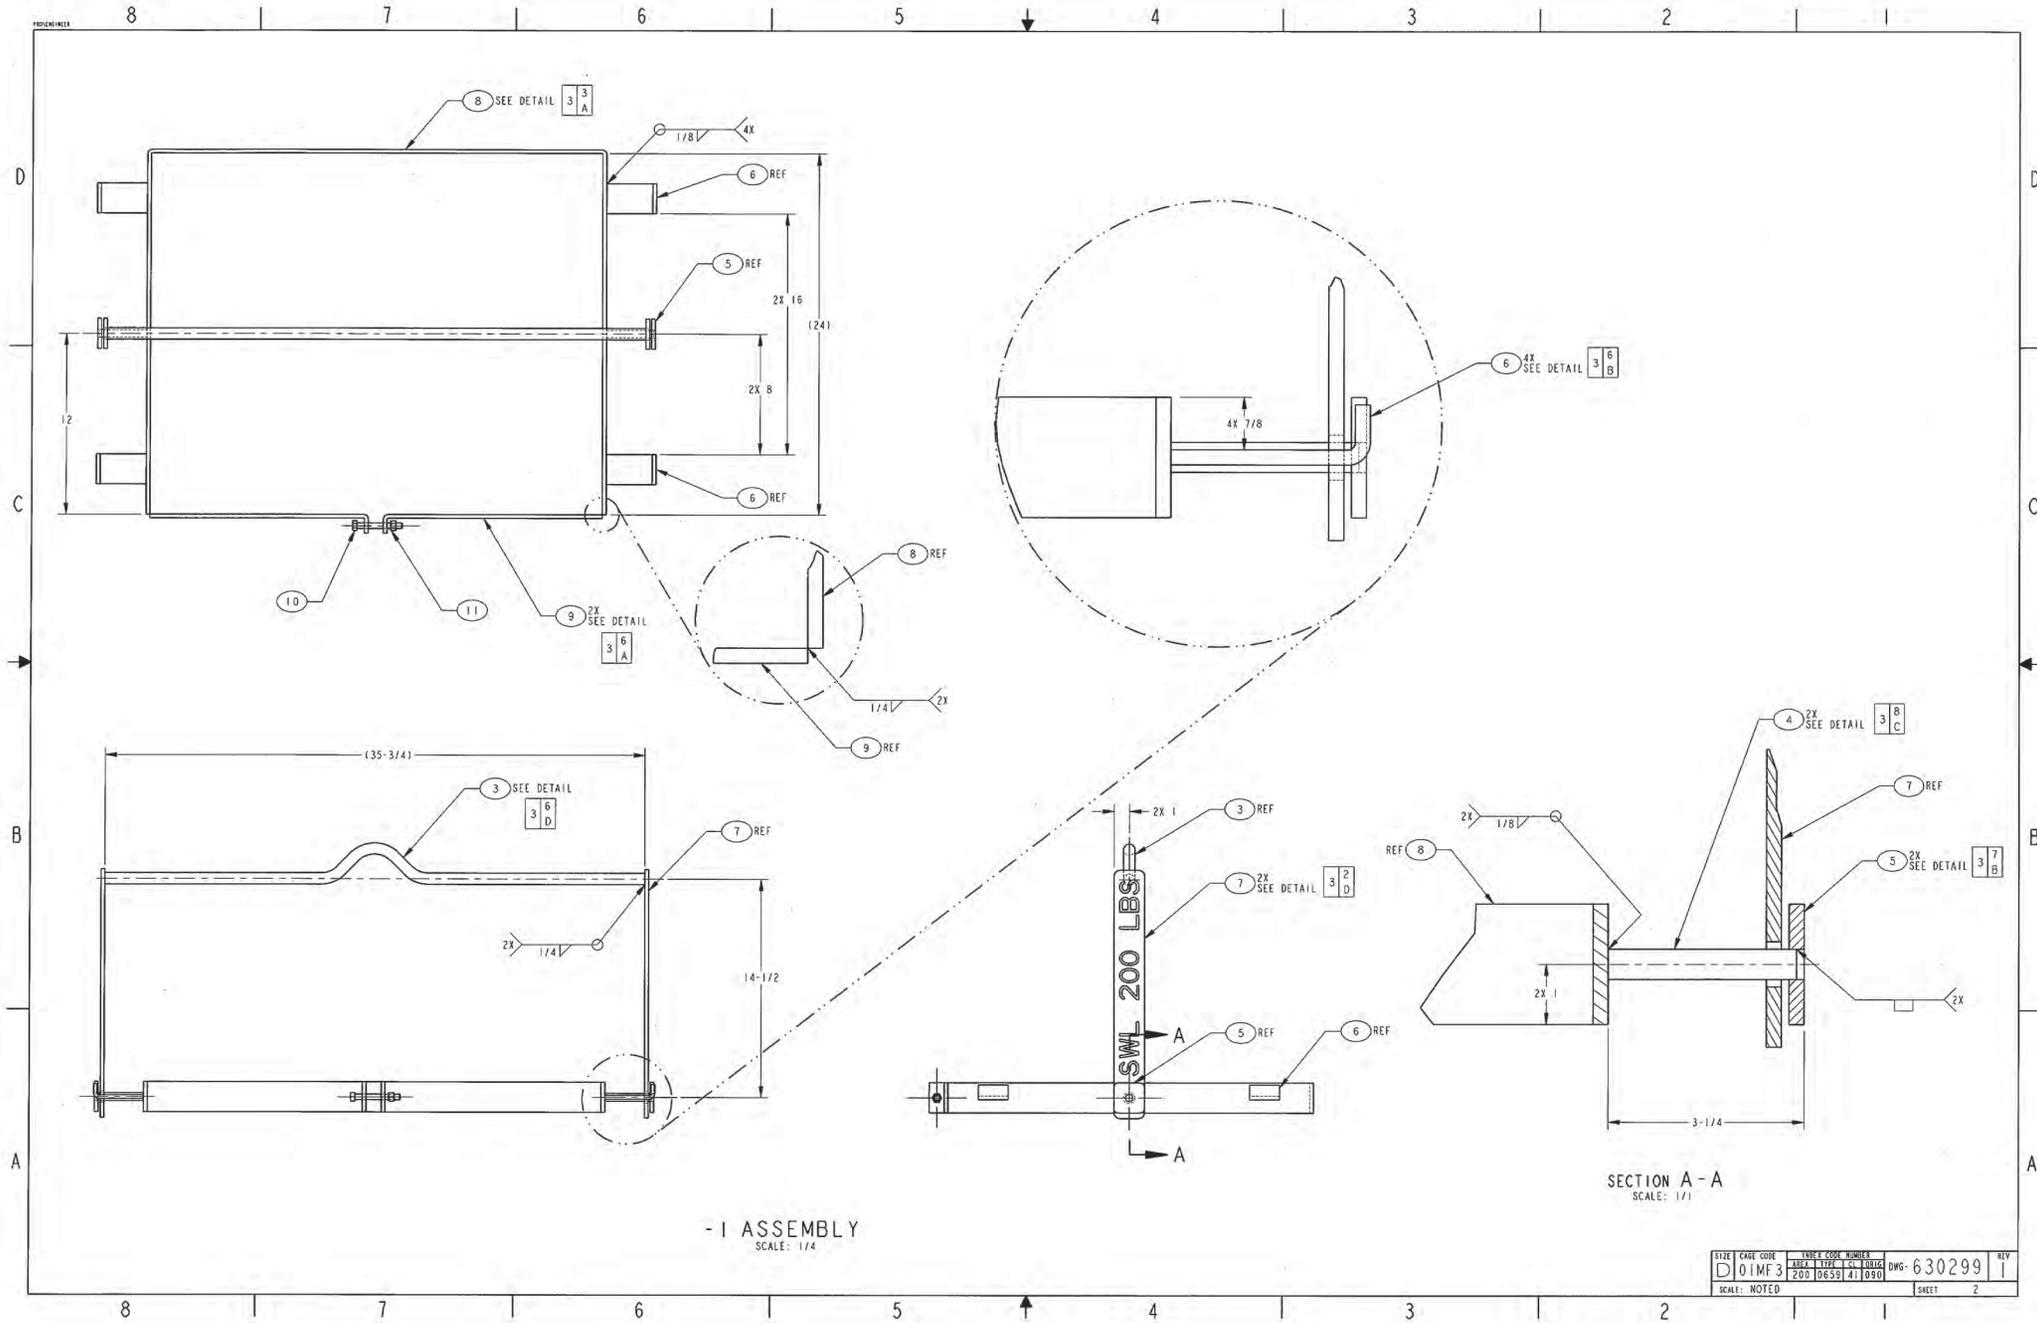

- I ASSEMBLY
SCALE: 1/4

SECTION A-A
SCALE: 1/1

SIZE	CAGE CODE	TEMP CODE NUMBER	REV
D	01MF 3	200 196301 41 1090	1
SCALE: NOTED			SHEET 2

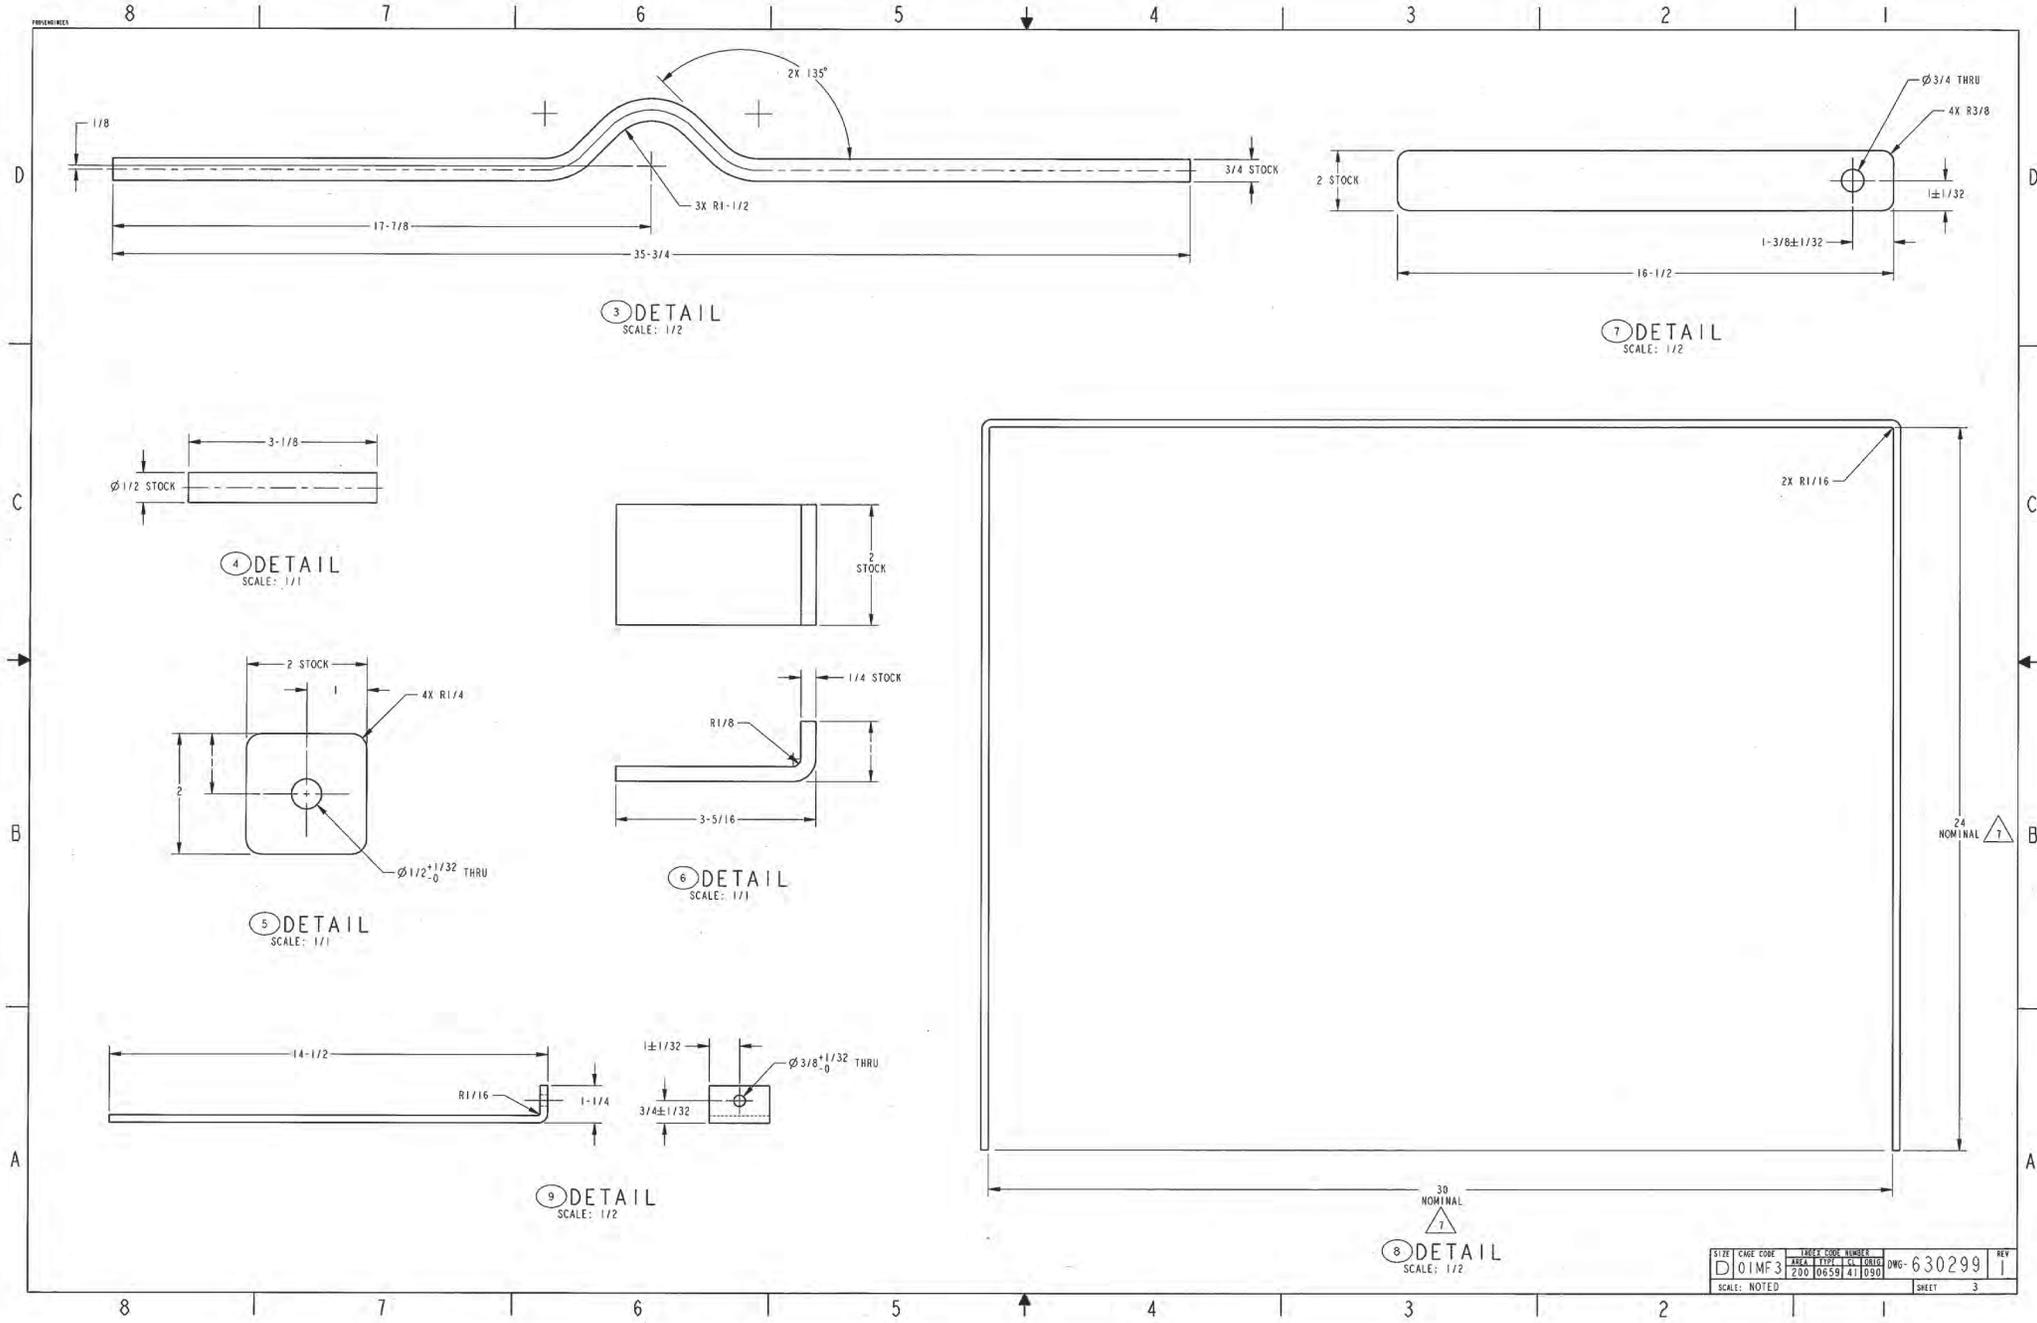

3 DETAIL
SCALE: 1/2

7 DETAIL
SCALE: 1/2

4 DETAIL
SCALE: 1/1

6 DETAIL
SCALE: 1/1





5 DETAIL
SCALE: 1/1

9 DETAIL
SCALE: 1/2

8 DETAIL
SCALE: 1/2

SIZE	DATE CODE	TRUCK CODE	TRUCK	REV
D	01MF3	200	0659	41 098
SCALE: NOTED				DWG- 630299
SHEET				3

8 7 6 5 4 3 2 1

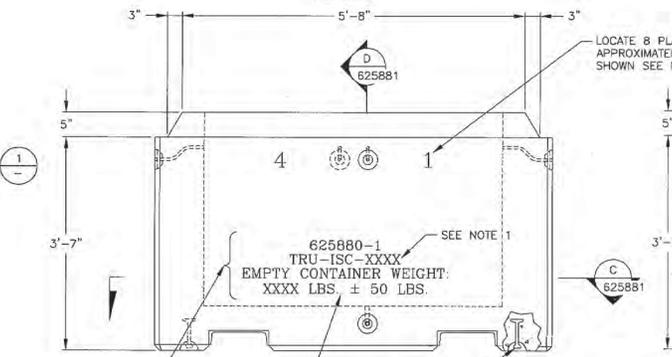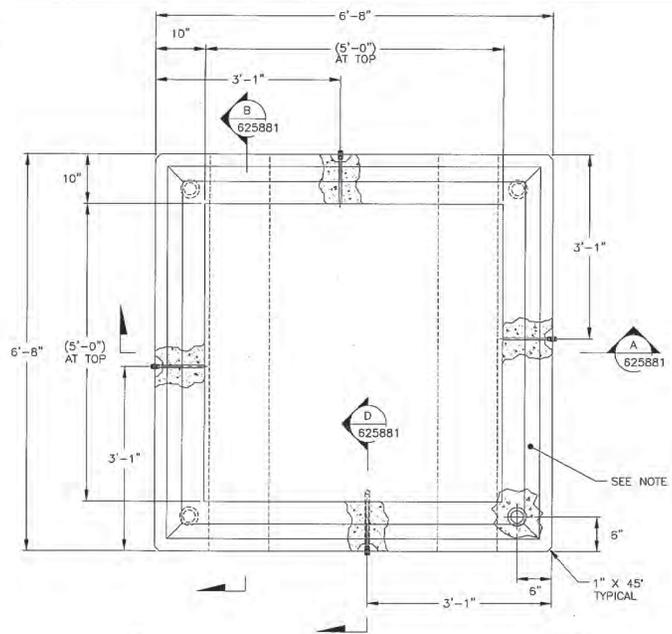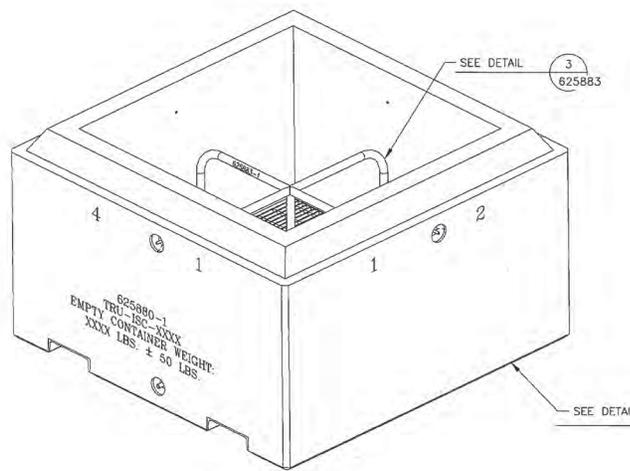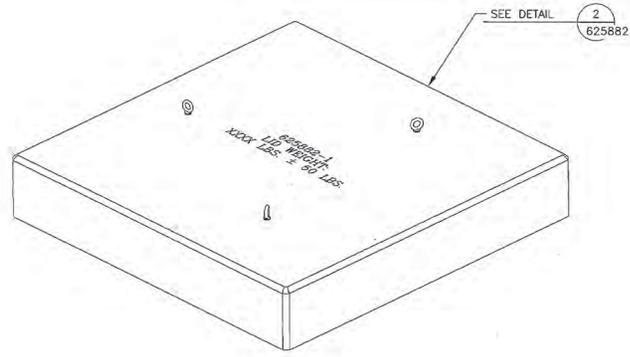

REVISIONS		
REV	DESCRIPTION	EFFECTIVE DATE
1	SEE DAR 110317	4/9/2004
2	AS-BUILT AS OF 7-27-2004 SEE DAR 113928	8/30/2004
3	AS-BUILT AS OF 10/13/05 SEE DAR-125855	11/7/05





- NOTES:
1. SEQUENTIALLY NUMBER EACH CONTAINER IN ORDER OF FABRICATION WITH TRU-ISC-0001 THRU TRU-ISC-0160.
 2. PAINT, LETTERING AND NUMBERING IN 2" HIGH CHARACTERS USING BLACK ENAMEL PAINT AS SPECIFIED IN SPC-511.
 3. CONCRETE SHALL HAVE A MINIMUM 28-DAY COMPRESSIVE STRENGTH OF 4,000 PSI. USE OF AN INTEGRAL REPELLENT ADMIXTURE (SUCH AS GRACE CONSTRUCTION PRODUCTS' DARAPEL).
 4. REINFORCING STEEL SHALL CONFORM TO ASTM A615 GRADE 60.
 5. PAINT ALL EXPOSED METAL SURFACES PER SPC-511.
 6. APPLY WATER PROOFING ON ALL CONCRETE SURFACES PER SPC-511.
 7. MATERIAL SPECIFICATIONS, TESTING AND DIMENSIONAL TOLERANCES FOR FINAL ASSEMBLY TO BE PER SPC-511.
 8. WEIGH EMPTY CONTAINER AND LID AND PAINT EMPTY WEIGHT ON CONTAINER ± 50 LBS.
 9. LIFT FROM EYEBOLTS SHALL BE WITHIN 5 DEGREES OF VERTICAL PER ASME B30.26-2004.

DETAIL 1
SCALE: 1" = 1'-0"


FOR DRAWING INDEX SEE DRAWING NO.	SUBCONTRACT NO.	INEEL	
REQUESTER: DOUG PARKER	DESIGN: STEVE MOODY	RWMC REMOTE HANDLING FOR TRU WASTE INTERIM STORAGE SYSTEM ASSEMBLY AND DETAILS	
DRAWN: G. MORGAN	PROJECT NO. 23048	SHEET NO. 3	
SPEC CODE	FOR REVIEW/APPROVAL SIGNATURES SEE DAR NO. 109473	DATE: 2/19/2004	
DESIGN PHASE:	SAFETY CATEGORY: CG	EFFECTIVE DATE: 2/19/2004	

8 7 6 5 4 3 2 1



REVISIONS		
REV	DESCRIPTION	EFFECTIVE DATE
1	SEE DAR 110317	4/9/2004
2	AS-BUILT AS OF 7-27-2004 SEE DAR 113828	8/30/2004

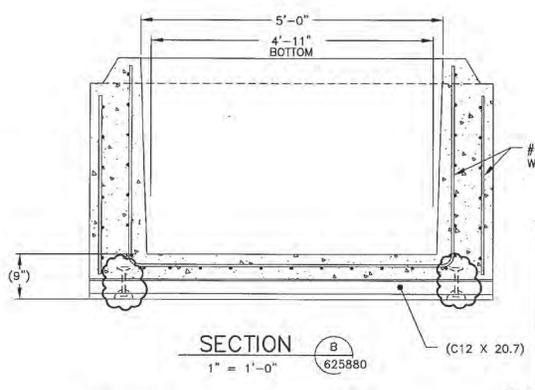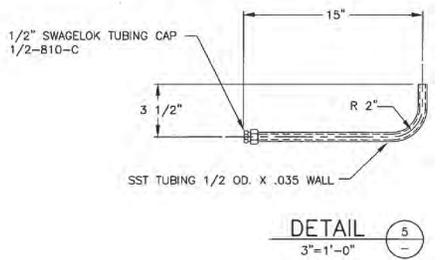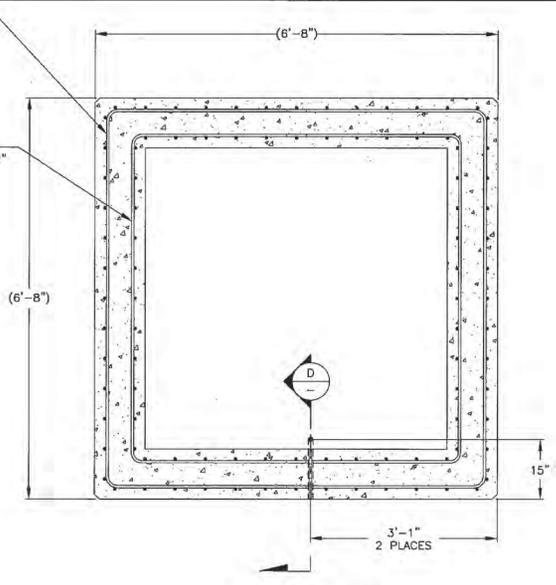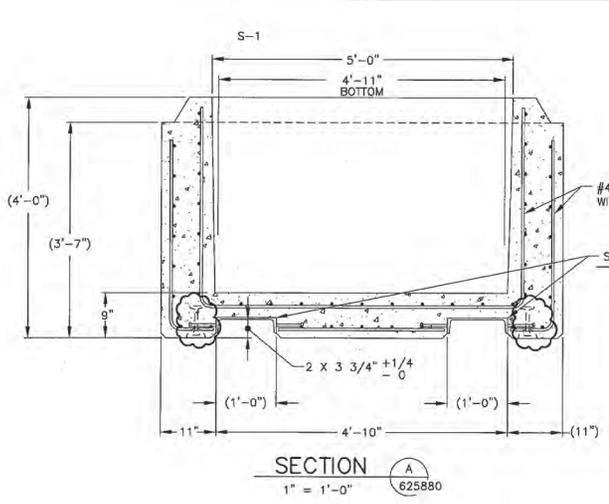


NELSON WELDING STUDS 14 PLACES
HAL 1/2 X 5 5/16 WILD STEEL
PART NUMBER 101053005 INSTALL
PER MANUFACTURES INSTRUCTIONS

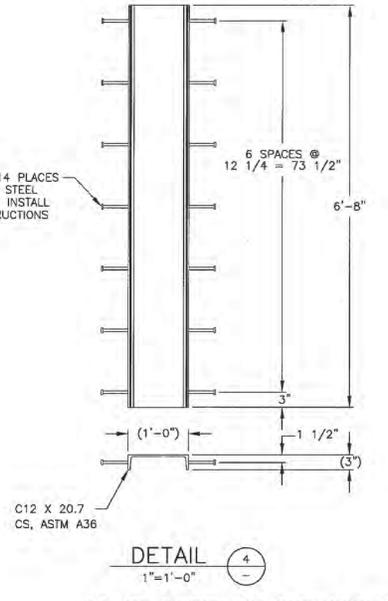

NOTE: USE THIS DRAWING IN CONJUNCTION WITH DRAWING 625880

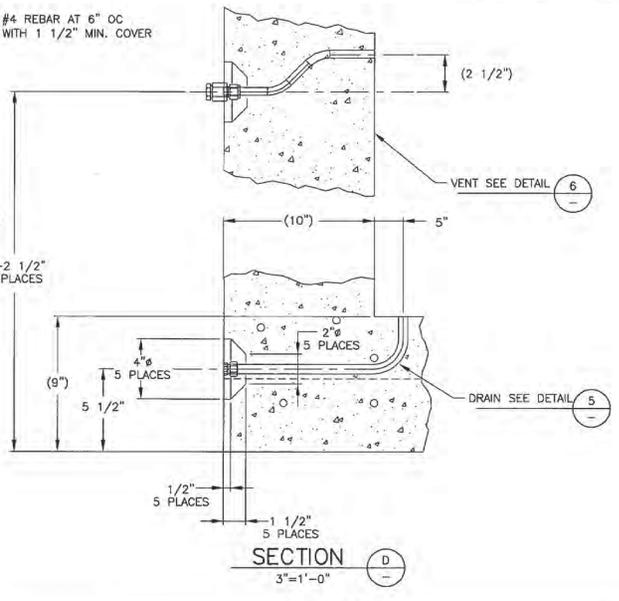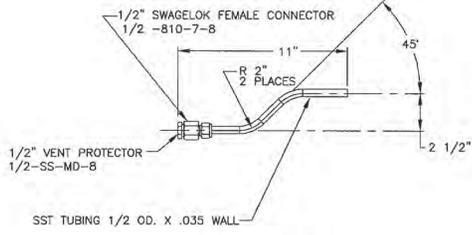


FOR DRAWING INDEX SEE DRAWING NO.	SUBCONTRACT NO.	INEEL INTERNATIONAL NEUTRON ENGINEERING & CONSULTANTS, INC. WWW.INEEL.COM
DESIGNER: DOUG PARKER	DESIGNER: STEVE WOODY	
SCALE: 3/4" = 1'-0"	DRAWING: D. MORGAN	RWMC REMOTE HANDLING FOR TRU WASTE INTERIM STORAGE SYSTEM INTERIM STORAGE CONTAINER SECTIONS AND DETAILS
SCALE: 3/4" = 1'-0"	PROJECT NO.: 23048	
DESIGN PHASE:	FOR REVIEW/APPROVAL SIGNATURES SEE DAR NO. 109473	SIZE: D
SAFETY CATEGORY: CG	EFFECTIVE DATE: 2/19/2004	CASE CODE: 01MF3
		INDEX CODE NUMBER: 098 99991 471 090
		DWG: 625881
		SCALE: NOTED
		SHEET 1 OF 1

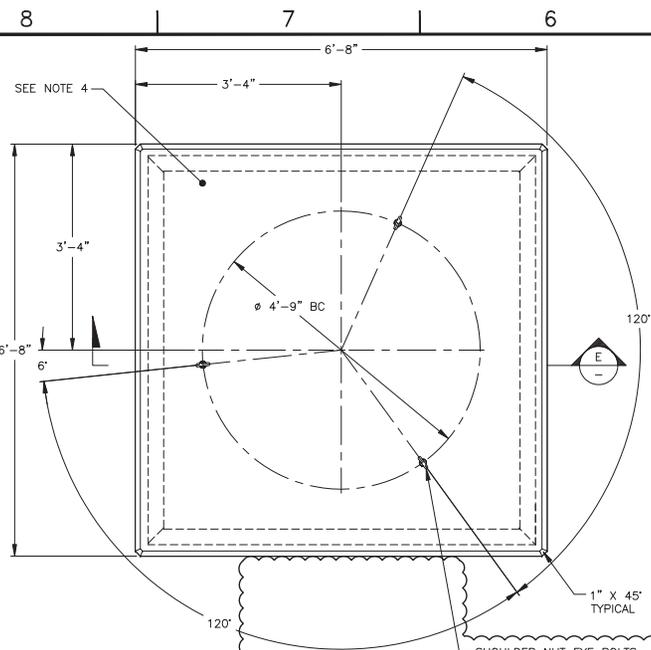


DETAIL
SCALE: 1" = 1'-0" (2)


SHOULDER NUT EYE BOLTS
Ø 3/4" X 6" CROSBY GROUP
G-277 PART #1045238
OR Ø 3/4" X 6" CHICAGO EYE
BOLT PART #085113, 3 PLACES

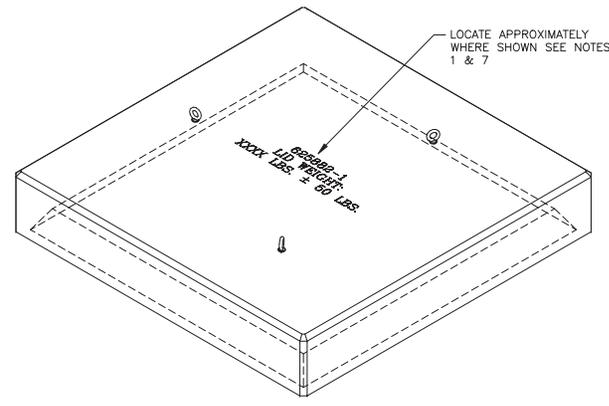

ISOMETRIC VIEW

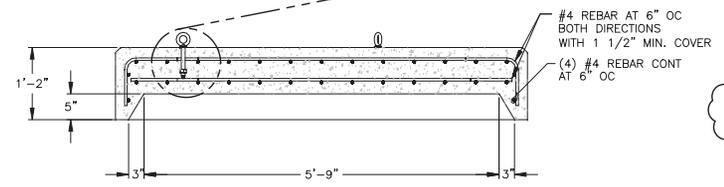


SECTION E-E
1 1/2" = 1'-0"

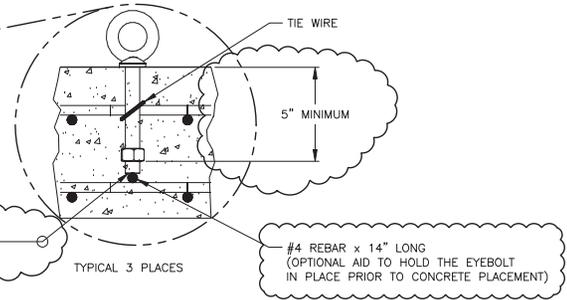

REVISIONS		
REV	DESCRIPTION	EFFECTIVE DATE
1	AS-BUILT AS OF 7-27-2004 SEE DAR 113928	8/30/2004
2	AS-BUILT AS OF 10/12/05 SEE DAR-125856	11/7/05
3	AS-BUILT AS OF 7/23/09 SEE DRF 327186	8/12/09

- NOTES:
1. PAINT, LETTERING AND NUMBERING IN 2" HIGH CHARACTERS USING BLACK ENAMEL PAINT AS SPECIFIED IN SPC-511.
 2. CONCRETE SHALL HAVE A MINIMUM 28-DAY COMPRESSIVE STRENGTH OF 4,000 PSI. USE OF AN INTEGRAL WATER REPELLENT ADMIXTURE (SUCH AS GRACE CONSTRUCTION PRODUCTS' DARAPEL).
 3. REINFORCING STEEL SHALL CONFORM TO ASTM A615 GRADE 60.
 4. WATER PROOFING ON ALL EXPOSED SURFACES PER SPC-511.
 5. SEE SPC-511 FOR DIMENSIONAL TOLERANCES.
 6. MATERIAL SPECIFICATIONS AND TESTING FOR FINAL ASSEMBLY TO BE PER SPC-511.
 7. WEIGH LID AND PAINT WEIGHT ON LID ± 50 LBS.


FOR DRAWING INDEX SEE DRAWING NO.	SUBCONTRACT NO.	INEEL <small>INTERNATIONAL NUCLEAR ENERGY LABORATORY</small>	
REQUESTOR: DOUG PARKER	DESIGNER: STEVE MOODY	RWMC REMOTE HANDLING FOR TRU WASTE INTERIM STORAGE SYSTEM INTERIM STORAGE CONTAINER LID ASSEMBLY AND DETAILS	
DRAWN: O. MORGAN	PROJECT NO. 23048	SIZE: D	CARE CODE: 01MF3
SCALE: 1" = 1'-0"	SPEC CODE:	ISSUE CODE NUMBER:	DWG: 625882
FOR REVIEW/APPROVAL SIGNATURES SEE DAR NO. 109473	EFFECTIVE DATE: 2/19/2004	DATE: 08/11/05	REV: 3
SAFETY CATEGORY: CG		SCALE: NOTED	SHEET 1 OF 1

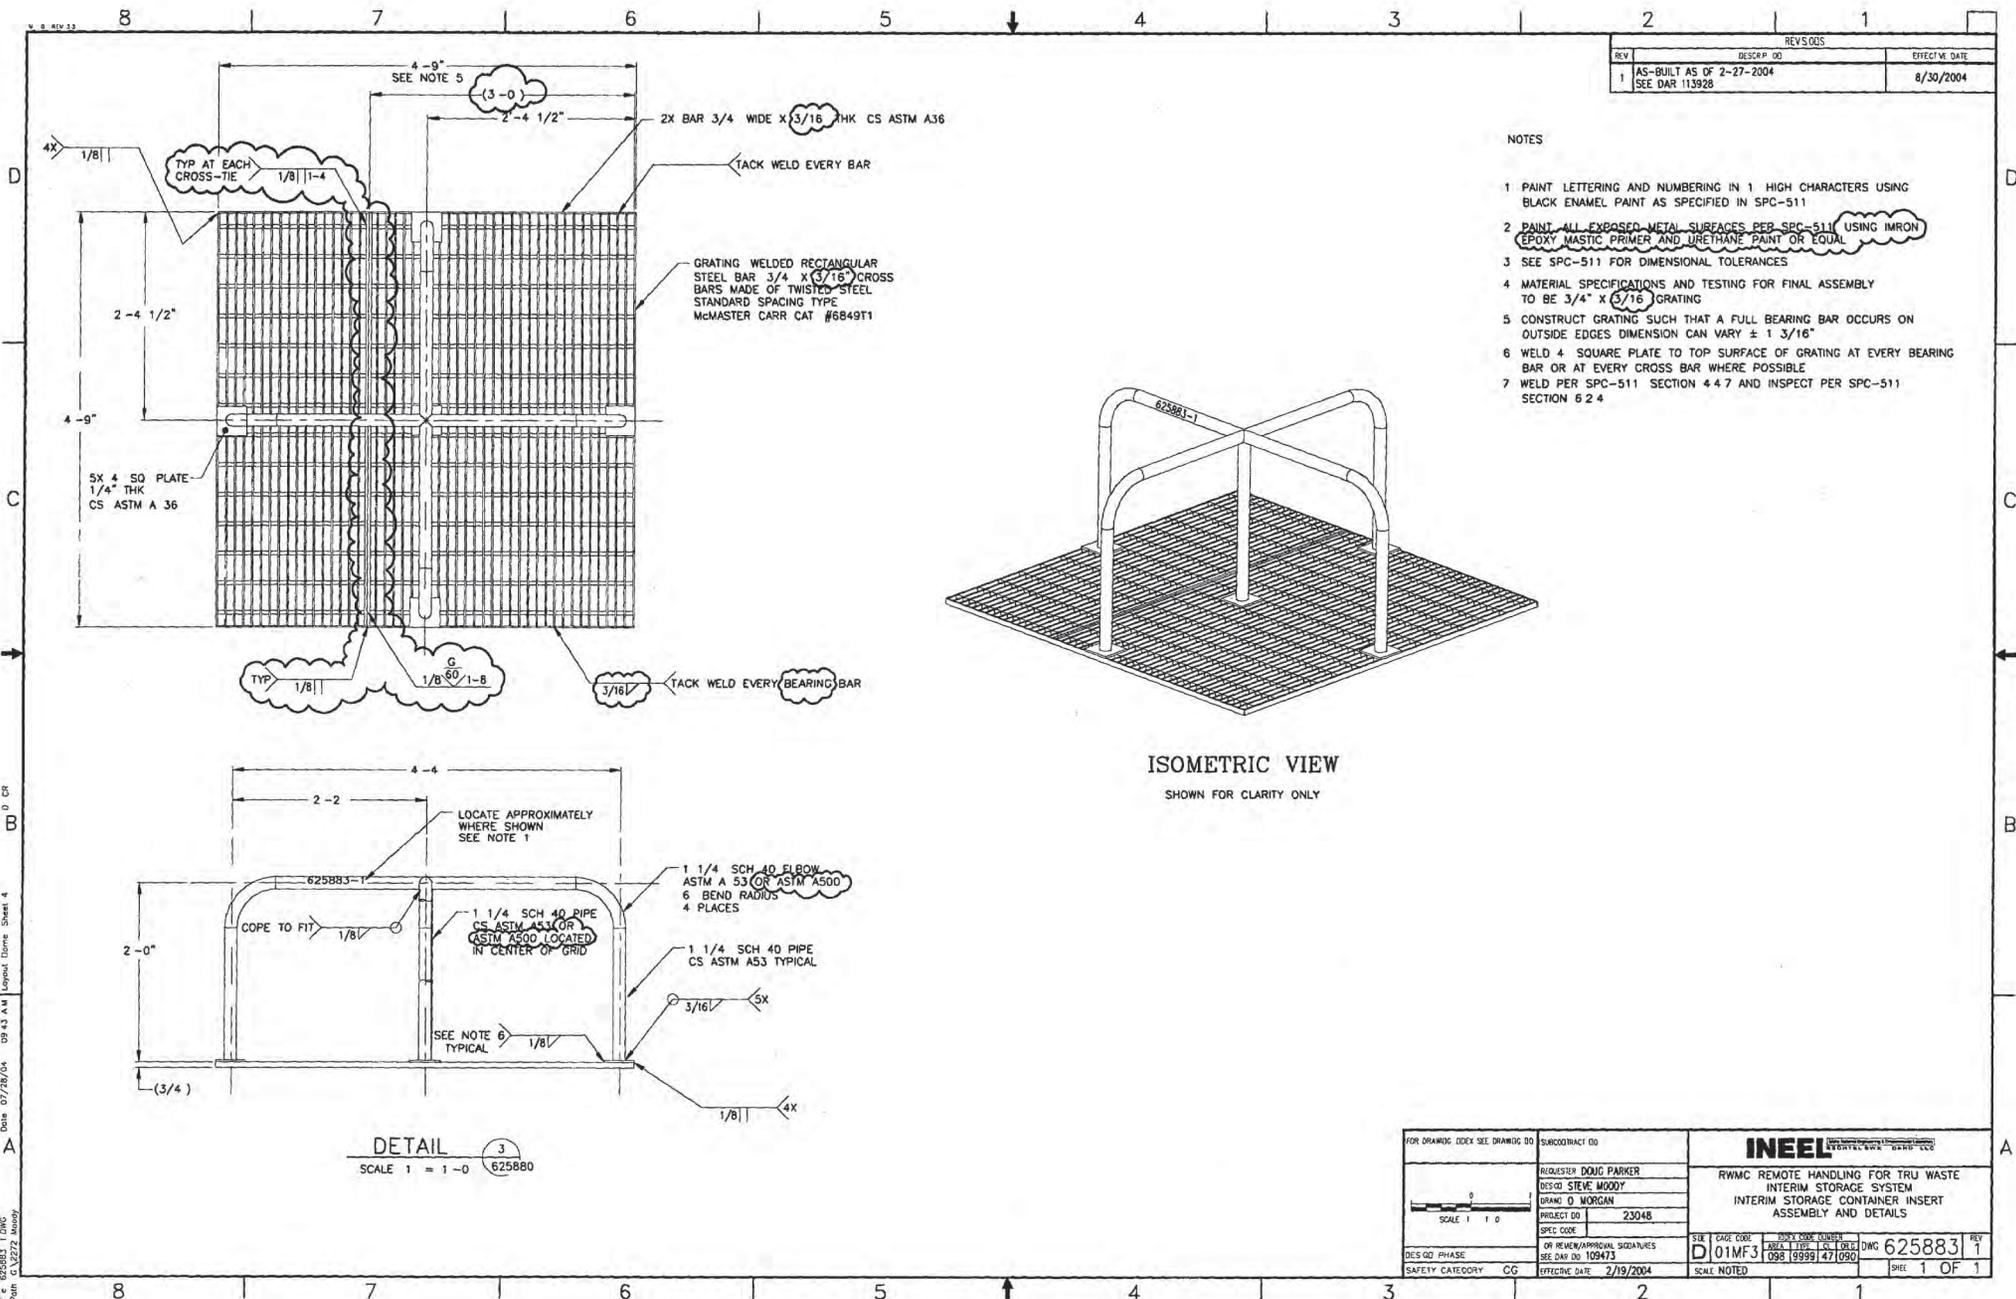

REVISIONS		
REV	DESCRIP. NO.	EFFECTIVE DATE
1	AS-BUILT AS OF 2-27-2004 SEE DAR 113928	8/30/2004

NOTES

- 1 PAINT LETTERING AND NUMBERING IN 1 HIGH CHARACTERS USING BLACK ENAMEL PAINT AS SPECIFIED IN SPC-511
- 2 PAINT ALL EXPOSED METAL SURFACES PER SPC-511 USING IMRON EPOXY MASTIC PRIMER AND URETHANE PAINT OR EQUAL
- 3 SEE SPC-511 FOR DIMENSIONAL TOLERANCES
- 4 MATERIAL SPECIFICATIONS AND TESTING FOR FINAL ASSEMBLY TO BE 3/4" X 3/16" GRATING
- 5 CONSTRUCT GRATING SUCH THAT A FULL BEARING BAR OCCURS ON OUTSIDE EDGES DIMENSION CAN VARY ± 1/32"
- 6 WELD 4 SQUARE PLATE TO TOP SURFACE OF GRATING AT EVERY BEARING BAR OR AT EVERY CROSS BAR WHERE POSSIBLE
- 7 WELD PER SPC-511 SECTION 4.4.7 AND INSPECT PER SPC-511 SECTION 6.2.4

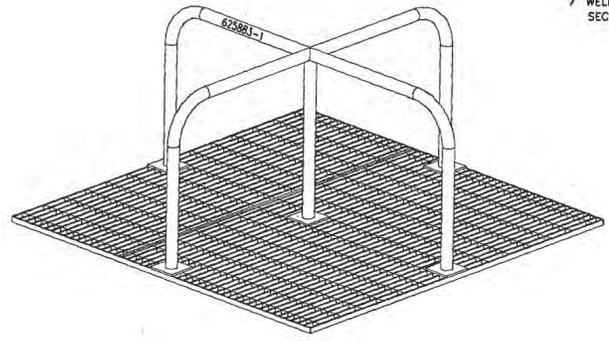


ISOMETRIC VIEW
SHOWN FOR CLARITY ONLY

DETAIL 3
SCALE 1 = 1'-0" 625880

FOR DRAWING INDEX SEE DRAWING 00	SUBCONTRACT 00	INEEL	
REQUESTOR: DOMC PARKER	DESIGN: STEVE MOODY	RWMC REMOTE HANDLING FOR TRU WASTE INTERIM STORAGE SYSTEM INTERIM STORAGE CONTAINER INSERT ASSEMBLY AND DETAILS	
PROJECT NO: 23048	SPEC CODE:	SIX CASE CODE: D01MF3	DWG: 625883
DESIGN PHASE:	OR REVIEW/APPROVAL SIGNATURES SEE DAY 00 108473	DATE: 1/18/04	REV: 1
SAFETY CATEGORY: CG	EFFECTIVE DATE: 2/19/2004	SCALE: NOTED	SHEET: 1 OF 1

Date: 07/26/04 09:43 AM Layout: Thom, Sheet: 4
 P: 625883 DWG
 Plot: G:\2727 Mooney

- NOTES:
1. MAXIMUM SURFACE ROUGHNESS TO BE 250 UNLESS OTHERWISE NOTED.
 2. REMOVE ALL BURRS, SCALE, OIL, AND SHARP EDGES. REDUCE EDGES TO .060 ±.020 R OR .06 X 45° CHAMFER. UNLESS OTHERWISE NOTED
 3. REMOVED
 4. THE FINAL OVERPACK ASSEMBLY SHALL BE SOAP BUBBLE LEAK TESTED PER ASME B&PV CODE, SECTION V, ARTICLE 10 APPENDIX I USING A TEST PRESSURE OF 10 PSIG. +5, -0, AND WITH THE TOP AND BOTTOM FLANGES TORQUED TO 350 +25 -0 FT LBS.
 5. THE AIR LEAK TEST SHALL BE WITNESSED BY AN INSPECTOR QUALIFIED PER ASNT SNT-TC-1A LEVEL II OR III.
 6. ALL SURFACES EXCEPT O-RING GROOVE SURFACES, THEIR MATING SURFACES, AND THREADED HOLES ARE TO BE SAND BLASTED CLEAN PER SSPC-SP5.
 7. REMOVED
 8. REMOVED
 9. REMOVED
 10. APPLY ITEM 18 TO ITEMS 16 AND 17 AND ALL UNPAINTED SURFACES PER MANUFACTURER'S RECOMMENDATIONS.
 11. LUBRICATE ALL THREADED FASTENERS WITH COLLOIDAL GRAPHITE AND ALCOHOL, ITEM 20, PRIOR TO ASSEMBLY.
 12. ALL SURFACES EXCEPT O-RING GROOVE SURFACES, THEIR MATING SURFACES, AND THREADED HOLES ARE TO BE PAINTED WITH TWO COATS OF ITEM 21, PER MANUFACTURER'S INSTRUCTIONS EXCEPT AS NOTED.
 13. SEE DRAWING 513174 FOR MARKINGS AND TORQUE VALUES

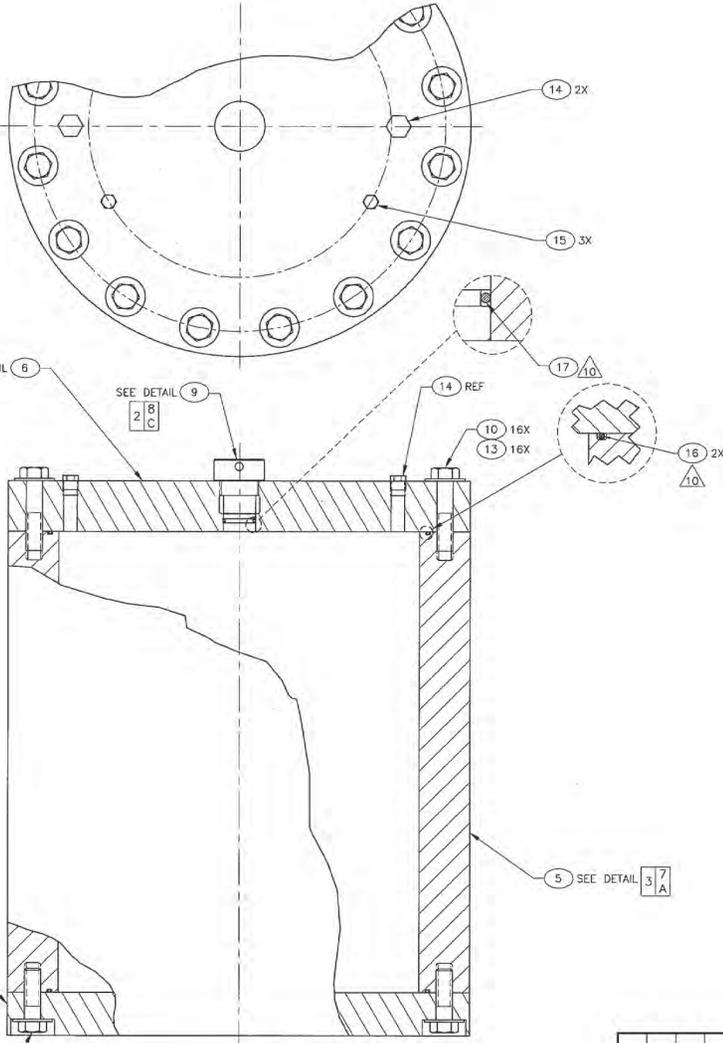

-1 ASSEMBLY (30 GAL.)
SCALE: 1/4

REV		REV STATUS	DESCRIPTION	EFFECTIVE DATE:
1	4	REV	SEE DAR 98769	02/11/03
2	4	REV	SEE DAR-98991	13 March 2003
3	4	REV	REVISED TITLE BLOCK AND INDEX CODE	07/01/03
4	4	REV	SEE DAR 109500	02/25/04

AR	CG	DESCRIPTION	MATERIAL	QTY
		PAINT, AMERLOCK 400, WHITE	AMERON INTERNATIONAL	21
		NED LUBE		20
				19
		SUPER-O-LUBE LUBRICANT	PARKER	18
1	LSC	2-330 COMPOUND N674-70	O-RING	PARKER SEAL GROUP
2	LSC	2-475 COMPOUND N674-70	O-RING	PARKER SEAL GROUP
3	CG	CAP SCREW, HEX HEAD 5/8-11 UNC-2A X 0.75	CARBON STEEL	15
2	SS	PIPE PLUG, 3/4-14 NPT	CARBON STEEL ASTM A105	14
32	CG	WASHER, FLAT, 2.75 OD X 1.25 ID X 0.16 THICK	CARBON STEEL	13
				12
16	SS	BOLT, HEAVY HEX HEAD, 1 1/8-8 UN-2A X 3 1/2 LG	CARBON STEEL, ASTM A193 GRADE B7	11
16	SS	BOLT, (HEAVY HEX HEAD,) 1 1/8-8 UN-2A X 5 LG	CARBON STEEL, ASTM A193 GRADE B7	10
1	SS	-9	ROUND BAR, CS, ASTM A108 GR 12L14 CD	9
1	SS	-8	BOTTOM FLANGE	8
		-7	REMOVED	7
1	SS	-6	TOP FLANGE	6
1	SS	-5	SHELL	5
				4
				3
				2
				1
-1	SS	-1	30 GAL OVERPACK ASSEMBLY	1


SUBCONTRACT NO.		INEEL	
REQUESTER: Craig Tyler		30 GALLON STORAGE AND CHARACTERIZATION OVERPACK FOR RH-TRU WASTE	
DESIGN: Kevin Skinner		DRAWN: L.D. TULLIS	
PROJECT NO. 15638		SPEC CODE	
FOR REVIEW/APPROVAL SIGNATURES		SEE DAR NO. 42167	
EFFECTIVE DATE: 3/20/2000		SCALE: NOTED	

1	1	1	513174-3
1	1	1	513174-3
NOTES:

1. MAXIMUM SURFACE ROUGHNESS TO BE 250 UNLESS OTHERWISE NOTED.
2. REMOVE ALL BURRS, SCALE, OIL, AND BREAK ALL OD CORNERS OF SHELL AND FLANGE TO 1/8 ± 1/32 RADIUS OR CHAMFER.
3. MATERIAL SUBSTITUTIONS ALLOWED WITH WRITTEN APPROVAL FROM IDAHO NATIONAL ENGINEERING AND ENVIRONMENTAL LABORATORY.
4. REMOVED
5. REMOVED
6. REMOVED
7. REMOVED
8. REMOVED
9. REMOVED
10. REMOVED
11. REMOVED
12. REMOVED

13. IT IS PERMISSIBLE TO FABRICATE THE FLANGE FROM A CARBON STEEL BLIND PIPE FLANGE, 20-INCH, CLASS 600 LB, ASTM A105; HOWEVER, THE HOLES AND HOLE PATTERN SHALL BE PER THIS DRAWING.
14. THE FINAL OVERPACK ASSEMBLY SHALL BE SOAP BUBBLE LEAK TESTED USING A TEST PRESSURE OF 10 ± 5 PSI. HOLD THE TEST PRESSURE FOR A MINIMUM OF 15 MINUTES PRIOR TO THE TEST. THE OVERPACK MUST PASS THE TEST.
15. REMOVED
16. THE AIR LEAK TEST SHALL BE WHITENESS BY AN INSPECTOR QUALIFIED PER ASNT SNT-TC-1A LEVEL II OR III.
17. ALL SURFACES EXCEPT O-RING GROOVE SURFACES, THEIR MATING SURFACES, AND THREADED HOLES ARE TO BE SAND BLASTED CLEAN PER SSPC-SP5. ALL SURFACES EXCEPT O-RING GROOVE SURFACES, THEIR MATING SURFACES, AND THREADED HOLES ARE TO BE PAINTED WITH TWO COATS OF ITEM 19, PER MANUFACTURER'S INSTRUCTIONS EXCEPT AS NOTED.
18. REMOVED
19. REMOVED
20. REMOVED
21. REMOVED
22. MARK "EMPTY WEIGHT XXXX LBS" ON THE SIDE OF THE OVERPACK, WITH 3/4 INCH HIGH CHARACTERS USING BLACK ENAMEL PAINT, WHERE XXXX REPRESENTS THE OVERPACK WEIGHT ROUNDED TO THE NEAREST ±10 POUNDS.
23. MARKING SHALL BE 1/4" HIGH AND PRODUCED INDIVIDUALLY OR IN GROUPS BY IMPACT FORCE APPLIED BY HAMMER OR OTHER DEVICE TO DRIVE STAMP INTO THE MATERIAL. "X" INDICATES OVERPACK ASSEMBLY NUMBER.
24. APPLY ITEM 22 TO ITEMS 15 AND 16 AND ALL UNPAINTED SURFACES PER MANUFACTURER'S RECOMMENDATIONS.

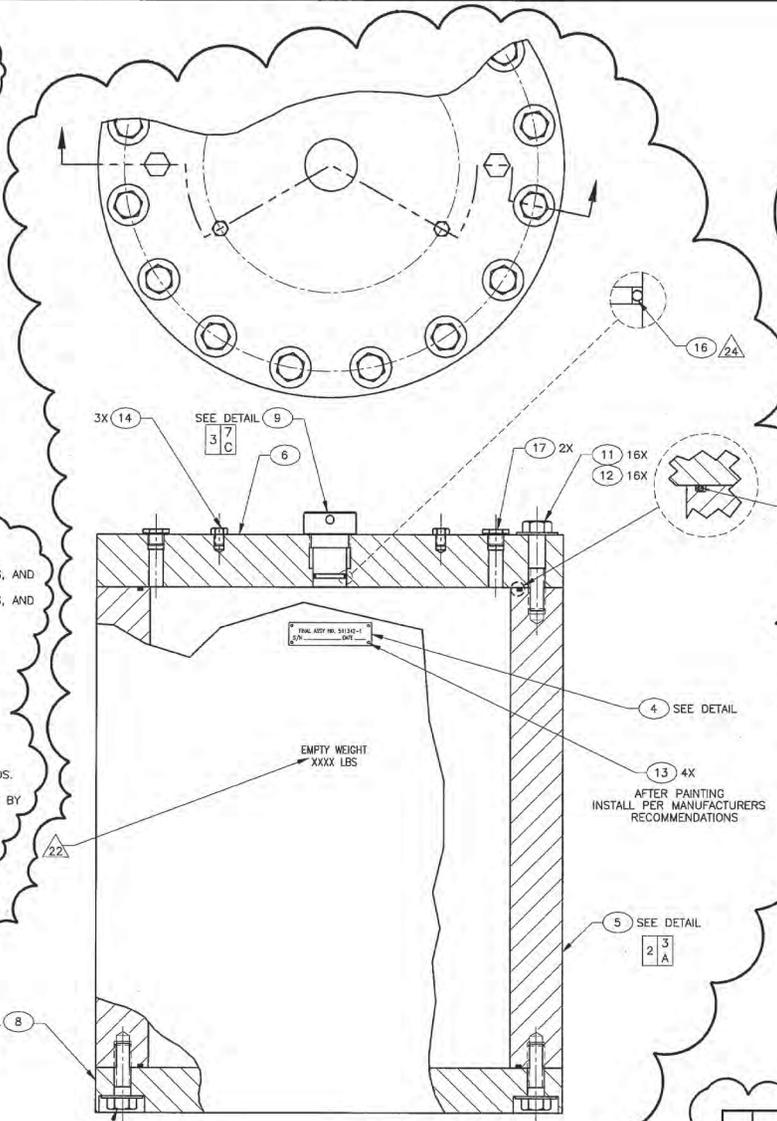

REV	DESCRIPTION	EFFECTIVE DATE
1	SEE DAR NUMBER 15791.	09/16/98
2	SEE DAR NO. 17831	2-24-99
3	SEE DAR NO. 43989	3/20/2000

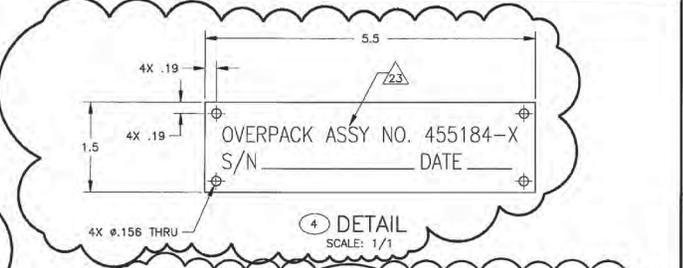




AR	AR	2	SUPER-O-LUBE	LUBRICANT	PARKER	22
16	2			BOLT, HEX HEAD, 1 1/8-8 UNC-2A X 5.00 LG	CARBON STEEL, ASTM A193 GRADE B7	21
16	2			BOLT, HEX HEAD, 1 1/8-8 UNC-2A X 3.50 LG	CARBON STEEL, ASTM A193 GRADE B7	20
	3			PAINT, AMERLOCK 400, WHITE	AMERON INTERNATIONAL	19
		-18		REMOVE		18
2	2	3		PIPE PLUG, 3/4-14 NPT	PVC	17
1	1	3	2-330	O-RING	PARKER SEAL GROUP	16
2	2	3	2-475	O-RING	PARKER SEAL GROUP	15
3	3	3		CAP SCREW, HEX HEAD 5/8-11 UNC-2A X 0.75	CARBON STEEL	14
4	4	3		RIVET, DOMED HEAD #1/8 x .196-.275 GRIP	SST	13
32	32	3		WASHER, FLAT, 2.75 OD X 1.25 ID X 0.16 THICK	CARBON STEEL	12
16	2			BOLT, HEX HEAD, 1 1/8-7 UNC-2A X 5.00 LG	CARBON STEEL, ASTM A193 GRADE B7	11
16	2			BOLT, HEX HEAD, 1 1/8-7 UNC-2A X 3.50 LG	CARBON STEEL, ASTM A193 GRADE B7	10
1	1	3	-9	PLUG	ROUND BAR, CS, ASTM A108 GR 12L14 CD	9
1	1	3		BASE	PLATE, CARBON STEEL, ASTM A36	8
		3		SHELL, TYPE 2	HSS 32 X 3.50 CARBON STEEL, ASTM A106	7
1	1	3		TOP FLANGE	PLATE, CARBON STEEL, ASTM A36	6
1	1	3		SHELL, TYPE 1	HSS 32 X 3.50 CARBON STEEL, ASTM A106	5
1	1	3	-4	ID PLATE	SHEET, 22 GA (.0293 THK) 304 SST ASTM A240	4
		-3		REMOVE		3
	2	-2		30 GAL OVERPACK ASSEMBLY, TYPE 2		2
	2	-1		30 GAL OVERPACK ASSEMBLY, TYPE 1		1
2	-1	QUAL	PART OR IDENTIFYING NO.	MANUFACTURE OR DESCRIPTION	MATERIAL SPECIFICATION	ITEM NO.

Drawn In Model Space
 Date: 03/29/00 - 08:01 A.M.
 Path: P:\1779 - Work Cdr
 File: 45518401-3.dwg ID: 685

DESIGNING AND CHECKING ARE AMERICAN NATIONAL STANDARDS UNLESS OTHERWISE SPECIFIED SURFACE ROUGHNESS 125 DIMENSIONS AND TOLERANCES ARE IN INCHES TOLERANCES: X ± .1; .001 ± .001; .002 ± .002; .005 ± .005; .010 ± .010; .020 ± .020; .050 ± .050; .100 ± .100; .200 ± .200; .500 ± .500; 1.000 ± 1.000 FRACTIONS: 1/16 ± .001; 1/8 ± .001; 1/4 ± .001; 3/8 ± .001; 1/2 ± .001; 3/4 ± .001; 1 ± .001; 1 1/2 ± .001; 2 ± .001; 3 ± .001; 4 ± .001; 5 ± .001; 6 ± .001; 8 ± .001; 10 ± .001; 12 ± .001; 15 ± .001; 20 ± .001; 25 ± .001; 30 ± .001; 40 ± .001; 50 ± .001; 60 ± .001; 70 ± .001; 80 ± .001; 90 ± .001; 100 ± .001 ANGULAR: ± 2' DO NOT SCALE DRAWING		SUBCONTRACT NO. REQUESTOR: Craig Tyler DESIGN: Kevin Skelmer DRAWN: EE THOMAS PROJECT NO: 15638 SPEC CODE: FOR REVIEW/APPROVAL SIGNATURES SEE DAR NO. 14307 EFFECTIVE DATE: 05/19/98	LOCKHEED MARTIN STORAGE AND CHARACTERIZATION OVERPACK FOR RH-TRU WASTE (BOLTED BASE CONSTRUCTION) SIZE: 401MF3 INDEX CODE NUMBER: 400 99991 48 530 DWG-455184 SHEET 1 OF 4
--	--	--	---

DWG. NO. 01MF3-3 Rev. B. GDS
 DATE: 03/14/2010 1:51 P.M.
 PLOT: P11729 - 100%


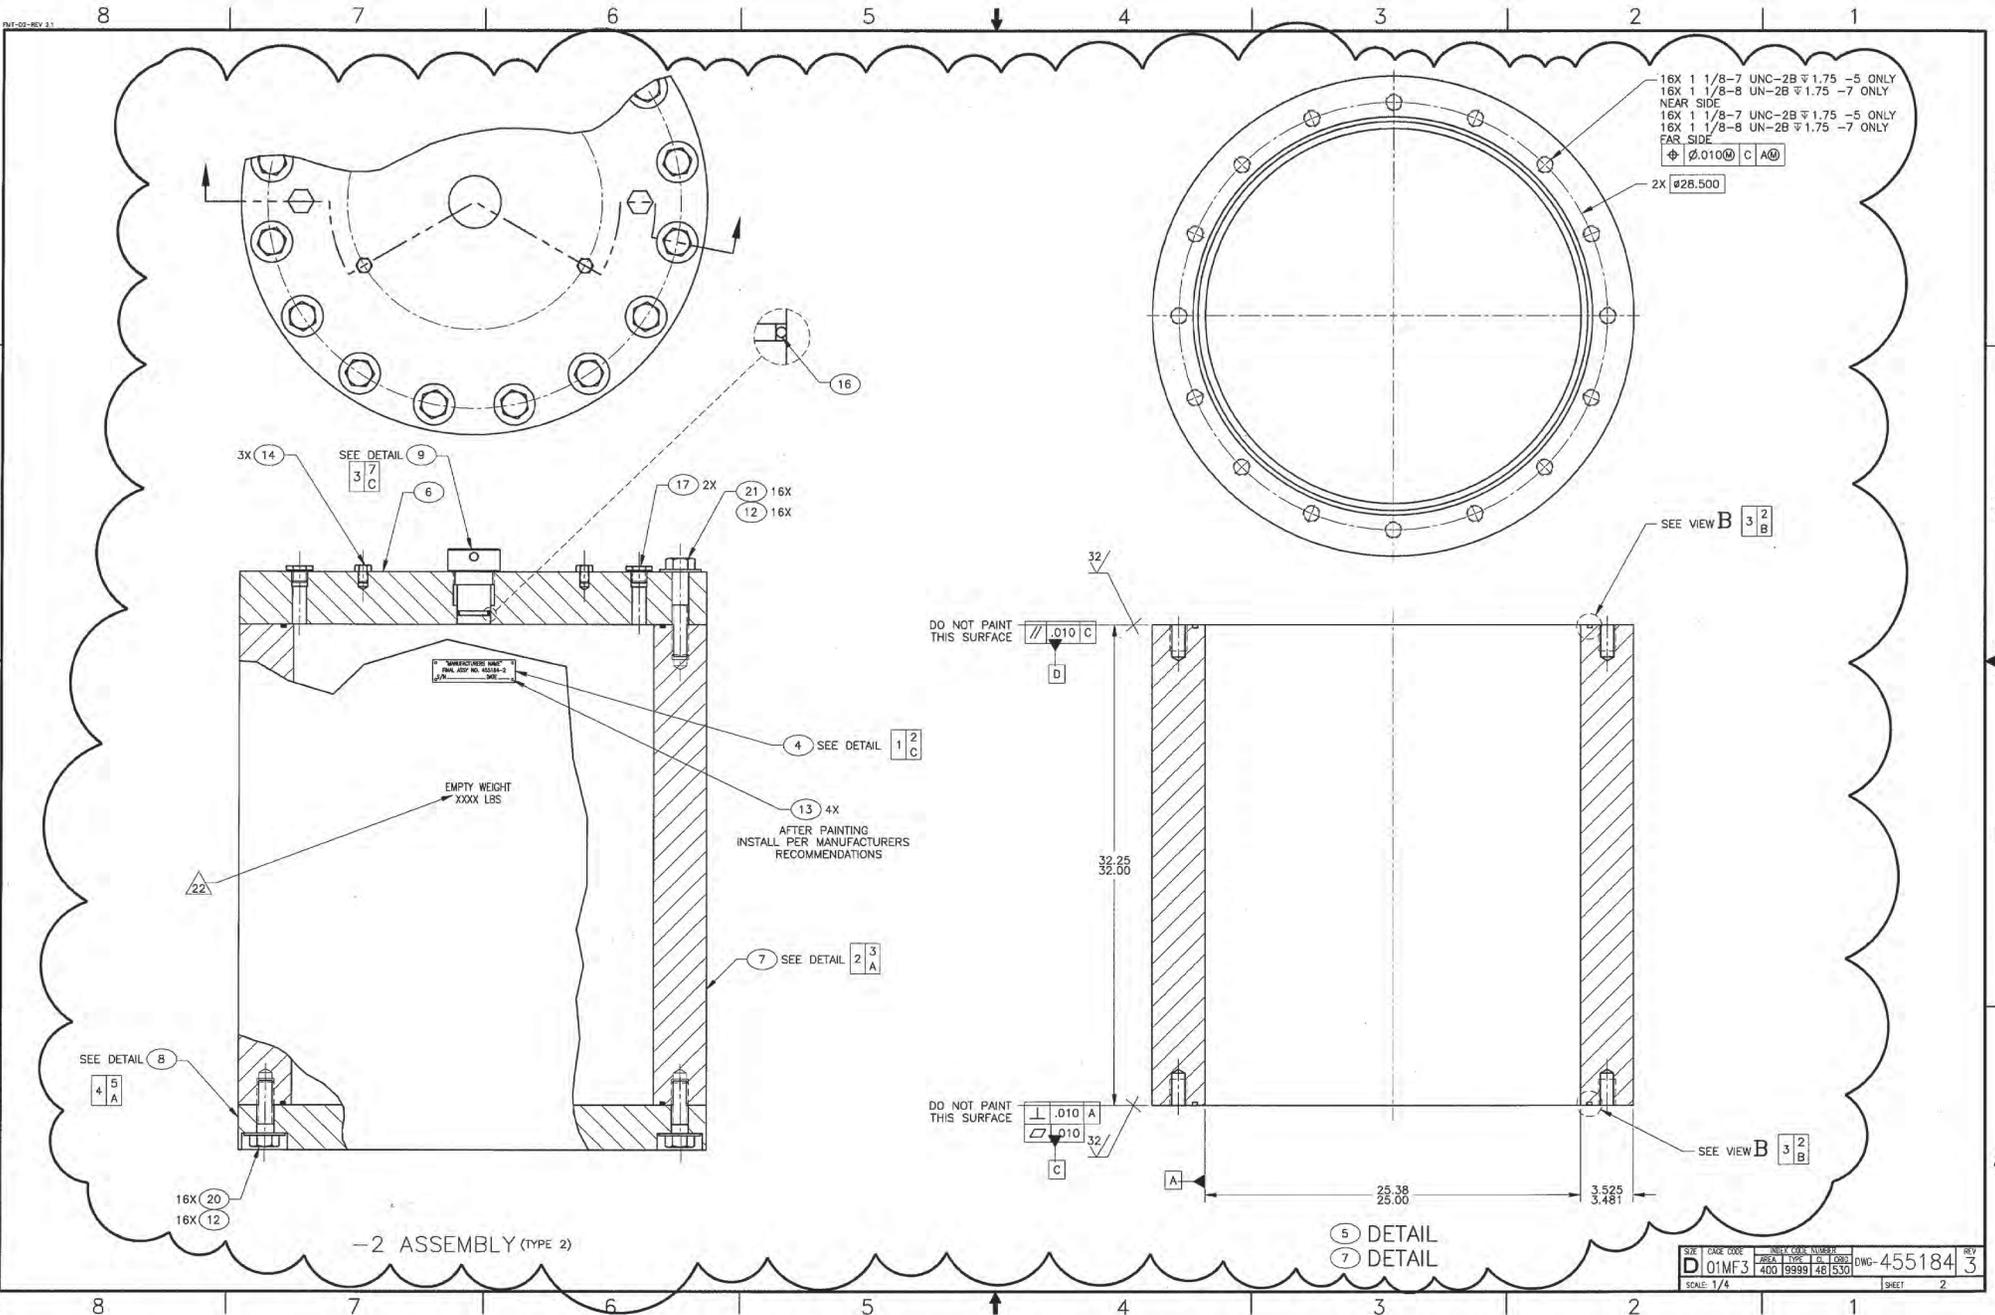


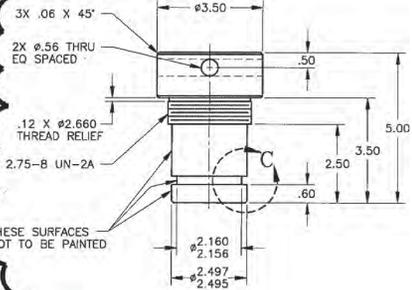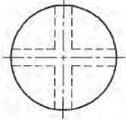

9 DETAIL SCALE: 1/2


2X Ø.921 THRU 3/4-14NPSM
±1.00 EQ SPACED WITHIN .010

3X Ø5/8-11UNC-2B
±1.00 EQ SPACED WITHIN
.010 ON 21.00 DIA. B.C.

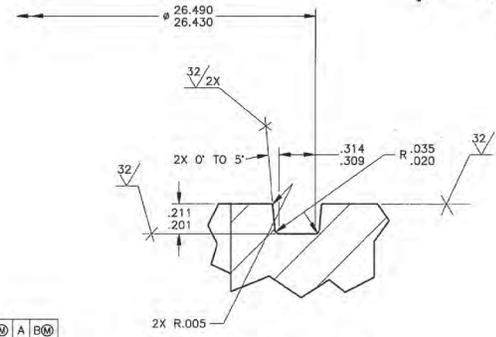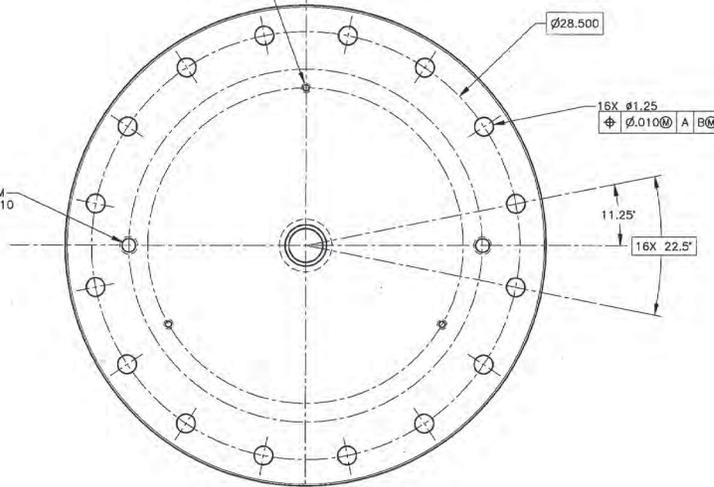


VIEW B


SCALE: 2/1
1X AS SHOWN
1X ROTATED 180°

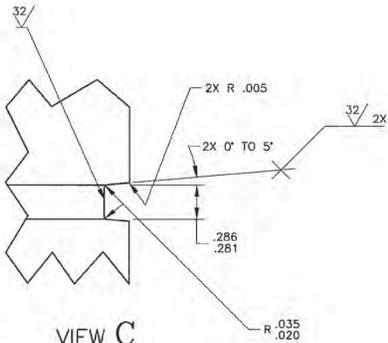

VIEW C
SCALE: 2/1

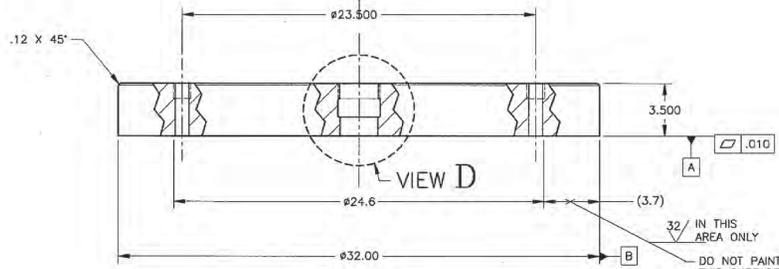


6 DETAIL SCALE: 1/4

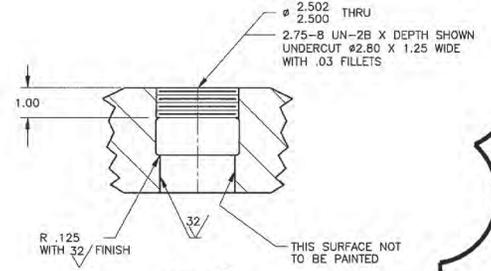

VIEW D
SCALE: 1/2

SIZE	CASE CODE	REV CODE NUMBER	DWG-455184	REV 3
D	01MF3	AREA 1 TIME 1.5-1.530	400 9999 48 530	
SCALE: NOTED				SHEET 3

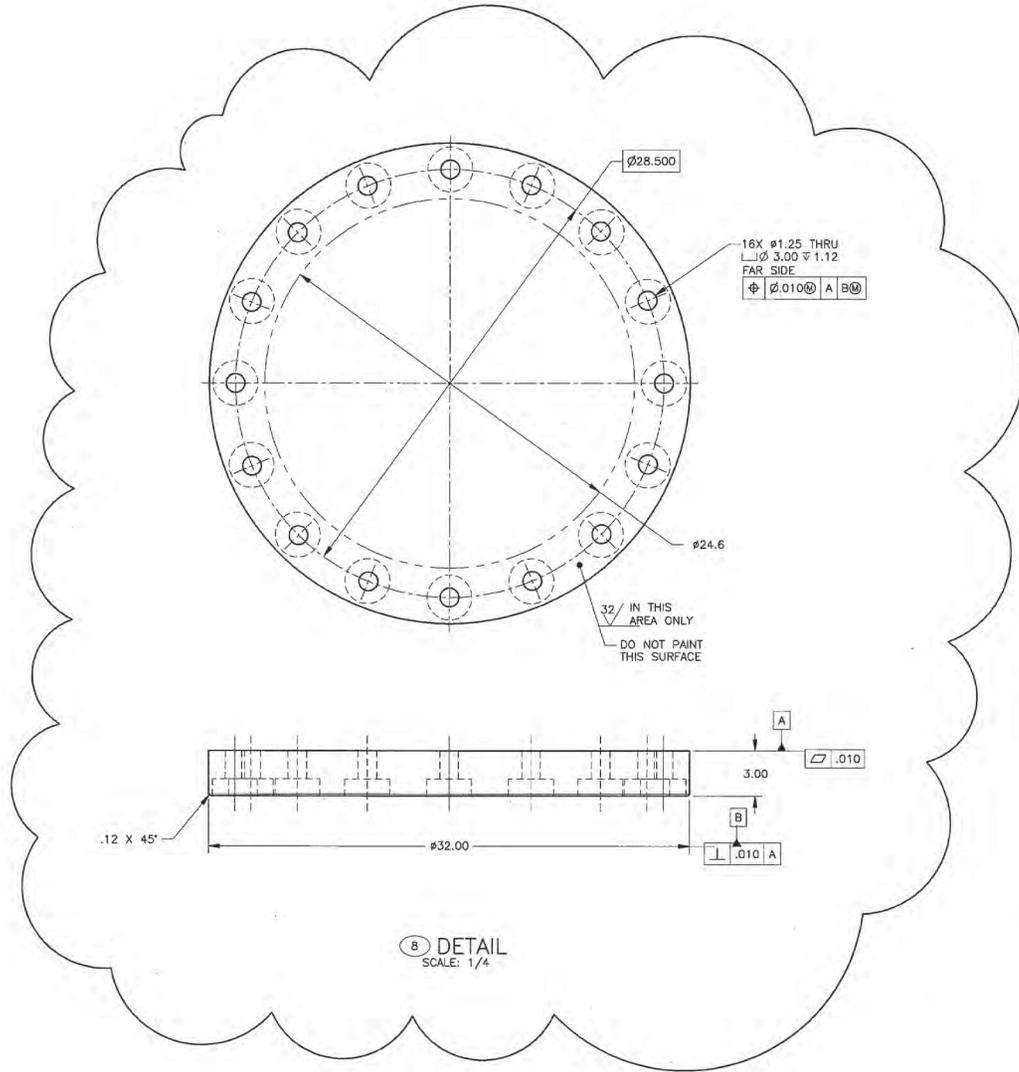

B DETAIL
SCALE: 1/4

16X #1.25 THRU
 ⌀ 3.00 ± 1.12
 FAR SIDE
 ⌀ ⌀.010 @ A B

⌀28.500

⌀24.6

32 IN THIS
 AREA ONLY
 DO NOT PAINT
 THIS SURFACE

⌀.010

3.00


⌀.010 A

.12 X 45°

⌀32.00



SIZE	CASE CODE	UNLESS OTHERWISE SPECIFIED	DWG-455184	REV
D	01MF3	AREA 1 TIME 1.00 1.00	400 9999 48 530	3
SCALE NOTED			SHEET	4

MATCH LINE SEE DRAWING 133412

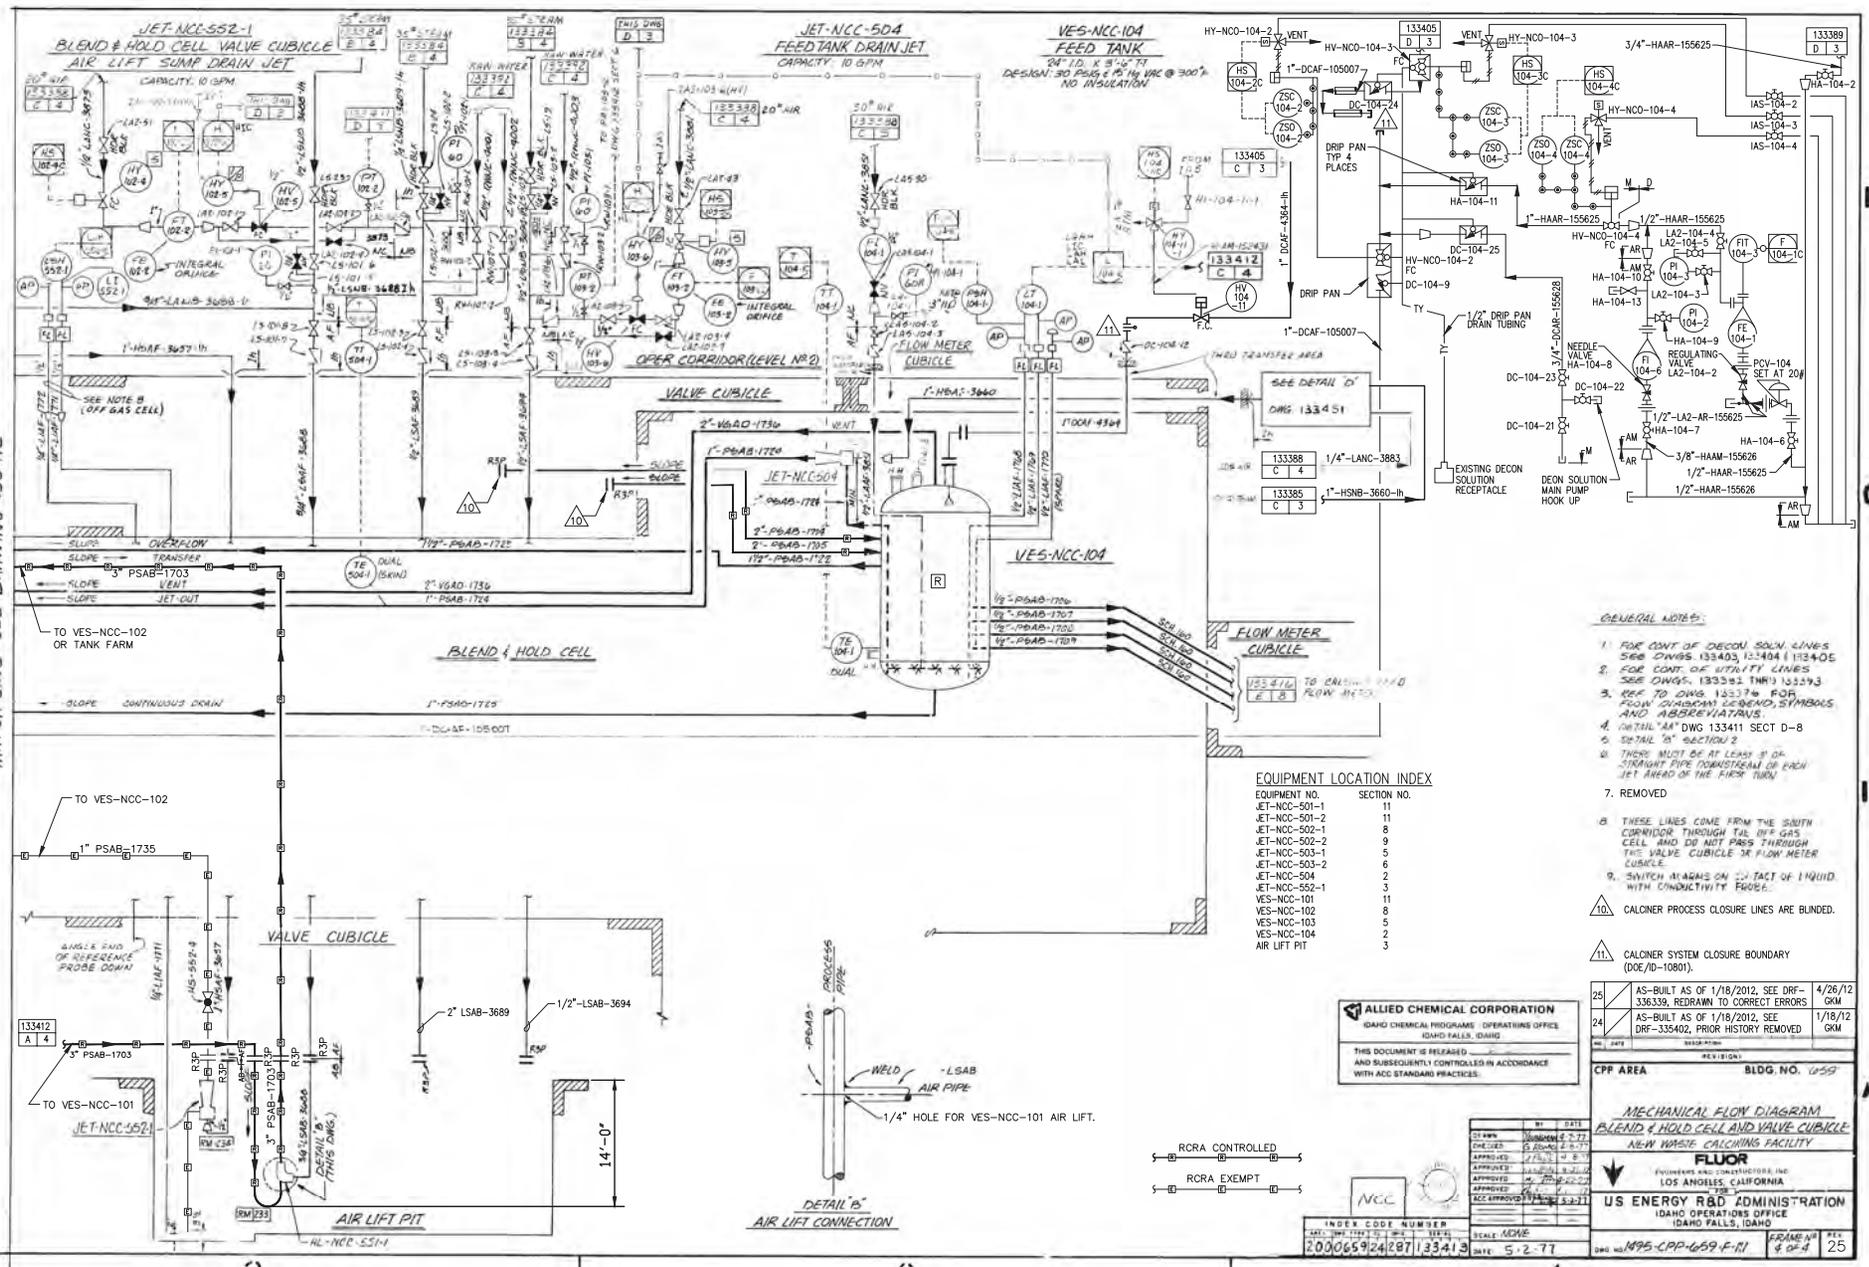

EQUIPMENT LOCATION INDEX

EQUIPMENT NO.	SECTION NO.
JET-NCC-501-1	11
JET-NCC-501-2	11
JET-NCC-502-1	8
JET-NCC-502-2	9
JET-NCC-503-1	5
JET-NCC-503-2	6
JET-NCC-504	2
JET-NCC-552-1	3
VES-NCC-101	11
VES-NCC-102	8
VES-NCC-103	5
VES-NCC-104	2
AIR LIFT PIT	3

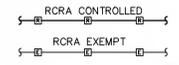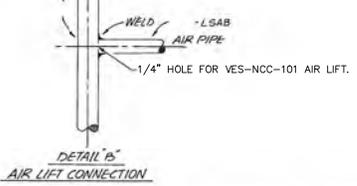

- GENERAL NOTES:**
- FOR CONT. OF DECON. SOLN. LINES SEE DWGS. 133403, 133404 & 133405
 - FOR CONT. OF VITALITY LINES SEE DWGS. 133382 THRU 133293
 - REF TO DWG 133376 FOR PUMP JOUBURNING SYMBOLS AND ABBREVIATIONS.
 - INITIAL "AM" DWG 133411 SECT D-8
 - DETAIL "B" SECTION 2
 - THESE MUST BE AT LEAST 8\"/>

ALLIED CHEMICAL CORPORATION
 IDAHO CHEMICAL PROGRAM OPERATIONS OFFICE
 IDAHO FALLS, IDAHO

THIS DOCUMENT IS RELEASED AND SUBSEQUENTLY CONTROLLED IN ACCORDANCE WITH ACC STANDARD PRACTICES.

NCC

INDEX CODE NUMBER
 200069524287133413

AS-BUILT AS OF 1/18/2012, SEE DR-336339, REDRAWN TO CORRECT ERRORS 4/26/12 GKM

AS-BUILT AS OF 1/18/2012, SEE DR-335402, PRIOR HISTORY REMOVED 1/18/12 GKM


CPP AREA BLDG. NO. 1059

MECHANICAL FLOW DIAGRAM
 BLEND & HOLD CELL AND VALVE CUBICLE
 NEW WASTE CALCINATION FACILITY

FLUOR
 ENGINEERS AND CONSTRUCTORS, INC.
 LOS ANGELES, CALIFORNIA

US ENERGY R&D ADMINISTRATION
 IDAHO OPERATIONS OFFICE
 IDAHO FALLS, IDAHO

SCALE: NONE DATE: 5.2.11 FRAME # 1 OF 25

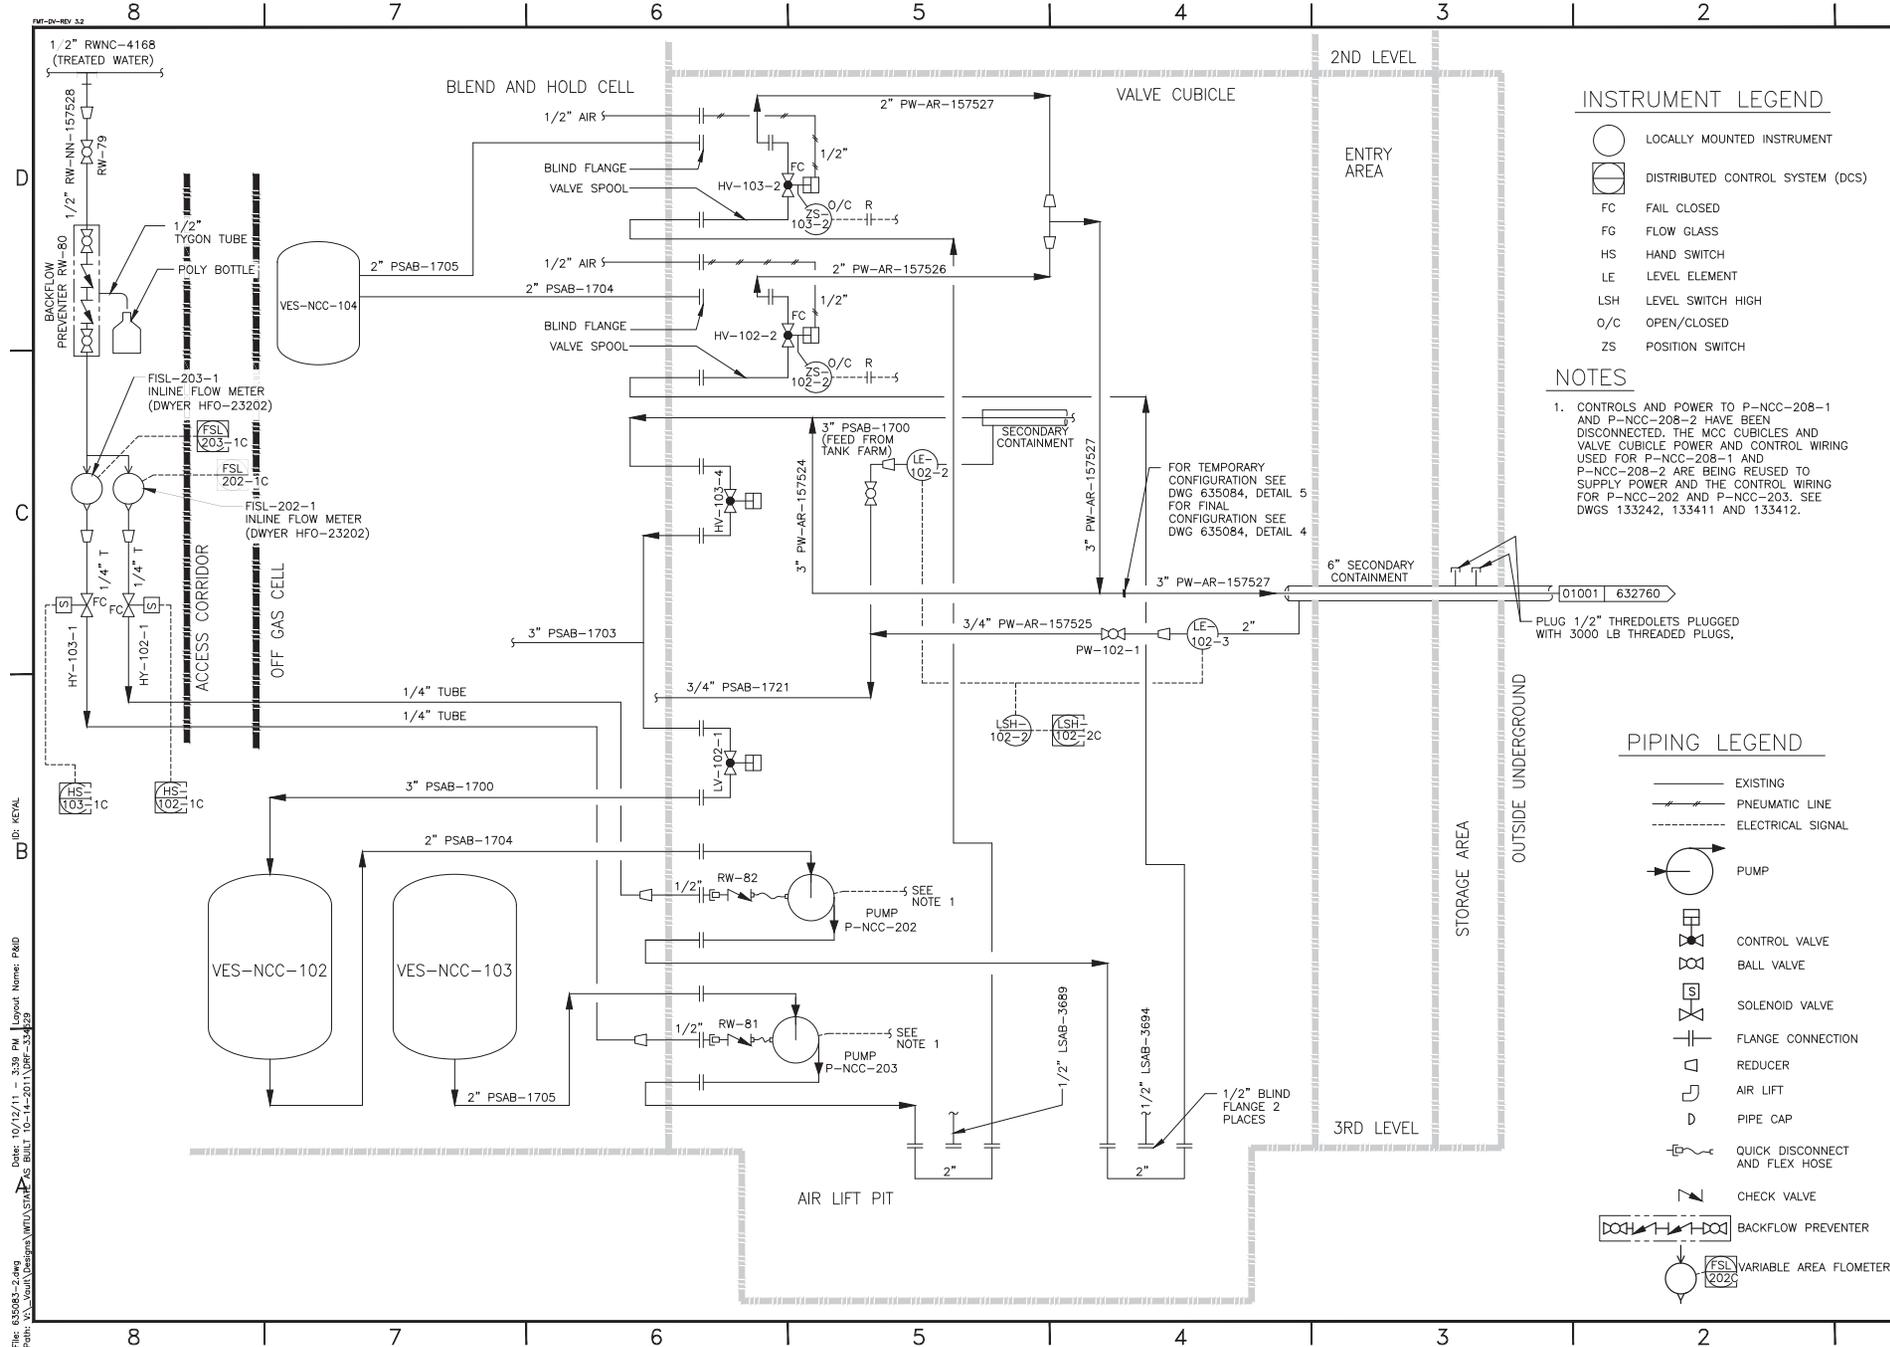

INSTRUMENT LEGEND

- LOCALLY MOUNTED INSTRUMENT
- ◻ DISTRIBUTED CONTROL SYSTEM (DCS)
- FC FAIL CLOSED
- FG FLOW GLASS
- HS HAND SWITCH
- LE LEVEL ELEMENT
- LSH LEVEL SWITCH HIGH
- O/C OPEN/CLOSED
- ZS POSITION SWITCH

NOTES

1. CONTROLS AND POWER TO P-NCC-208-1 AND P-NCC-208-2 HAVE BEEN DISCONNECTED. THE MCC CUBICLES AND VALVE CUBICLE POWER AND CONTROL WIRING USED FOR P-NCC-208-1 AND P-NCC-208-2 ARE BEING REUSED TO SUPPLY POWER AND THE CONTROL WIRING FOR P-NCC-202 AND P-NCC-203. SEE DWGS 133242, 133411 AND 133412.

PIPING LEGEND

- EXISTING
- PNEUMATIC LINE
- - - ELECTRICAL SIGNAL
- PUMP
- ◻ CONTROL VALVE
- ◻ BALL VALVE
- ◻ SOLENOID VALVE
- FLANGE CONNECTION
- ◻ REDUCER
- ◻ AIR LIFT
- ◻ PIPE CAP
- QUICK DISCONNECT AND FLEX HOSE
- ◻ CHECK VALVE
- ◻ BACKFLOW PREVENTER
- ◻ VARIABLE AREA FLOMETER

2	AS BUILT AS OF 10/5/11, INCORP'D
	FC 4572, 7144, 7639, 7683,
	SEE DRW-334559
1	SEE DRW-316691
REV	DESCRIPTION
REVISION HISTORY	
NO SCALE	
DESIGN PHASE: _____	
QUALITY LEVEL: 3	
HORIZONTAL SCALE	NONE
VERTICAL SCALE	NA
FOR DRAWING INDEX SEE DRAWING NO. 635080	
SIGNATURES/DATES APPLY TO CURRENT RELEASE ONLY SIGN AND DATE	
DESIGNER:	NA
DRAWN BY:	NA
TECHNICAL CHECKER:	NA
ENG GROUP SUPERVISOR:	NA
DESIGN LEAD:	NA
DRAWING CHECK/EFFECTIVE DATE:	NA
DATE:	NA
INTEC IWTU MODIFICATIONS TO NWCF VALVE CUBICLE	
P. & ID	
PROJECT NUMBER: 25051	INDEX CODE NUMBER
	200 106591 24 1136
SIZE: D	DWG: 635083
DRW NO. 126630	SHEET P-3


Date: 10/12/11 3:39 PM Layout Name: P&ID
 Path: V:_Work\Design\W\U\STAR\AS BUILT_10-11-2011\DRW-334559

INSTRUMENTATION IDENTIFICATION SYMBOLS

FIRST-LETTER			SUCCEEDING-LETTERS		
	MEASURED OR INITIATING VARIABLE	MODIFIER	READOUT OR PASSIVE FUNCTION	OUTPUT FUNCTION	MODIFIER
A	ANALYSIS		ALARM FUNCTION		
B	BURNER, COMBUSTION		USER'S CHOICE	USER'S CHOICE	USER'S CHOICE
C	CONDUCTIVITY			CONTROL	CLOSE
D	DENSITY OR SPG	DIFFERENTIAL			
E	VOLTAGE		SENSOR (PRIMARY ELEMENT)		
F	FLOW RATE	RATIO (FRACTION)			
G	USER'S CHOICE		GLASS, VIEWING DEVICE		
H	HAND				HIGH
I	CURRENT (ELECTRICAL)		INDICATE		
J	POWER	SCAN			
K	TIME, TIME SCHEDULE	TIME RATE OF CHANGE			
L	LEVEL		LIGHT		LOW
M	MOTOR	MOMENTARY			MIDDLE, INTER-MEDIATE
N	USER'S CHOICE		USER'S CHOICE	USER'S CHOICE	USER'S CHOICE
O	USER'S CHOICE		ORIFICE, RESTRICTION		OPEN
P	PRESSURE, VACUUM		POINT (TEST) CONNECTION		
Q	QUANTITY	INTEGRATE TOTALIZE			
R	RADIATION		RECORD		
S	SPEED, FREQUENCY	SAFETY		SWITCH	
T	TEMPERATURE			TRANSMIT	
U	MULTIVARIABLE		MULTIFUNCTION	MULTIFUNCTION	MULTIFUNCTION
V	VISCOSITY			VALVE, DAMPER, LOUVER	
W	WEIGHT, FORCE		WELL		
X	VIBRATION	X AXIS	UNCLASSIFIED	UNCLASSIFIED	UNCLASSIFIED
Y	EVENT, STATE OR PRESENCE	Y AXIS		RELAY, COMPUTE, CONVERT	
Z	POSITION/DIMENSION	Z AXIS		DRIVER, ACTUATOR, UNCLASSIFIED FINAL CONTROL ELEMENT	

GENERAL NOTES:

- INTEC INSTRUMENTATION SYMBOLOGY SHALL BE BASED ON ISA STANDARD 5.1
- A COMPLETE INSTRUMENT IDENTIFICATION NUMBER FOR INTEC IS CONSTRUCTED AS FOLLOWS:

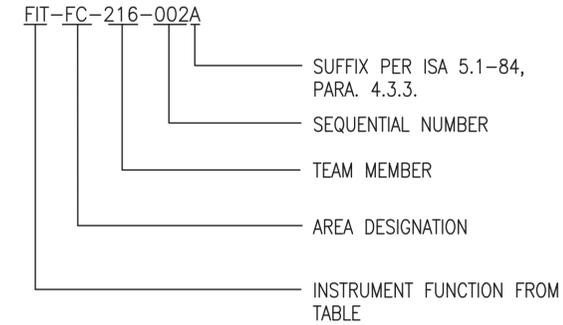

PILOT LIGHT DESIGNATIONS

R	RED	UNSAFE	EMERGENCY, DANGER, HIGH PRIORITY ALARM, CLOSED/OFF/STOPPED (INACTIVE) CLOSED/ON/FLOWING (ELECTRICAL POWER DISTRIBUTION) *
Y	YELLOW	CAUTION	HAZARD SECOND PRIORITY ALARM ABNORMAL STATE
G	GREEN	SAFE	SAFE, SATISFACTORY, OPEN/ON/FLOWING (ACTIVE) OPEN/OFF/STOPPED (ELECTRICAL POWER DISTRIBUTION) *
LB	LIGHT BLUE (CYAN)	STATIC AND SIGNIFICANT	EQUIPMENT IN SERVICE MAJOR LABELS
DB	DARK BLUE	NON ESSENTIAL	EQUIPMENT IN STANDBY
M	MAGENTA	RADIATION	RADIATION ALARM/CAUTION
W	WHITE	DYNAMIC DATA	MEASUREMENT AND STATE INFORMATION SYSTEM MESSAGES TREND ACTIVE SEQUENCE STEP

* - THE ASSOCIATED COLOR MEANINGS ARE FOR ELECTRICAL POWER DISTRIBUTION SYSTEM DISPLAYS ONLY.

REVISION HISTORY

REV	DESCRIPTION
1	AS-BUILT AS OF 3/18/2014, SUBMITAL TO STATE FOR RCRA PERMIT, SEE DRG-341590

Idaho Cleanup Project
 CPP-666
 RH-TRU DISTILLATION SYSTEM
 INSTRUMENTATION LEGEND SHEET 1

SIGNATURES/DATES APPLY TO CURRENT RELEASE ONLY

DESIGN:	SIGN AND DATE
NA	- -
DRAFTER:	Jim Moncur CWI 2014.03.19 13:05:32 -0600'
J. MONCUR	
TECHNICAL CHECK:	NA
ENG GROUP SUPERVISOR:	NA
DESIGN LEAD/AUTHORITY:	David Morgan CWI 2014.03.20 08:38:36 -0600'
D. MORGAN	
DRAFTING CHECK/EFFECTIVE DATE:	K. KELLER CWI 2014.03.20 09:52:10 -0600'
K. KELLER	



I CERTIFY THAT THIS DRAWING REFLECTS THE CURRENT CONSTRUCTED CONDITION AS OF 3/18/2014

NO SCALE

DESIGN PHASE:			
QUALITY LEVEL:	3		
HORIZONTAL SCALE:	NONE		
VERTICAL SCALE:	NA		
FOR DRAWING INDEX SEE DRAWING NO.	571426		
PROJECT NUMBER:	31720		
INDEX CODE NUMBER			
AREA	TYPE	CL	ORIG
200	0666	24	136
SIZE	DWG-	REV	
D	571621	1	
DRF NO.	SHEET		
338620	P-1		

ID: MXJ
 Date: 03/19/14 11:09 AM Layout Name: Layout1
 File: 571621-1.dwg
 Path: K:\RH-TRU Distillation\Drawings\DRG-341590

PROCESS LINES

- PRIMARY PROCESS
- PRIMARY PROCESS (UNDERGROUND)
- SECONDARY PROCESS
- SECONDARY PROCESS (UNDERGROUND)
- BURIED OR EMBEDDED PIPE
- HEAT TRACING
- E-ELECTRICALLY TRACED (SHOWN)
- S-STEAM TRACED
- INL-VENDOR INTERFACE
- SEISMIC REQUIREMENTS APPLY BETWEEN FLAGS (FOR EXACT PHYSICAL DESCRIPTION OF SEISMIC BOUNDARIES REFER TO APPROPRIATE ISOMETRIC)

VALVE STATUS

- N.O. - NORMALLY OPEN (SHOWN)
- N.C. - NORMALLY CLOSED (SHOWN)
- L.O. - LOCKED OPEN
- L.C. - LOCKED CLOSED
- F.O. - FAIL OPEN
- F.C. - FAIL CLOSED
- F.L. - FAIL LOCKED IN LAST POSITION
- F.I. - FAIL INDETERMINATE

VALVES

- GENERAL OR GATE
- GLOBE
- CHECK
- THREE-WAY
- FOUR-WAY
- DIAPHRAGM OR PINCH
- BALL
- BALL-3 WAY
- BUTTERFLY
- RESTRICTION ORIFICE DRILLED IN VALVE
- PLUG
- COCK
- NEEDLE
- STOP CHECK
- ANGLE
- SLIDE
- DAMPER OR LOUVER
- BACKDRAFT DAMPER

PUMPS AND COMPRESSORS

- COMPRESSOR
- BLOWER OR FAN (CENTRIFUGAL)
- CENTRIFUGAL PUMP
- VACUUM PUMP
- AIR FAN

INSTRUMENT LINES

- INSTRUMENT AIR
- UNDEFINED SIGNALS
- PNEUMATIC SIGNALS
- ELECTRICAL SIGNALS
- HYDRAULIC SIGNALS
- CAPILLARY TUBING
- PLC COMMUNICATIONS LINK
- MECHANICAL LINK

SYSTEM ABBREVIATION

AA	ATMOSPHERE AIR	P	PUMP
ATM	ATMOSPHERE	POGV	PROCESS OFF-GAS VALVE
COM	CARBON MONOXIDE MONITORING	PSD	PUMP SUCTION DIFFUSER
CW	POTABLE WATER	SE	SPECIALIZED EQUIPMENT
CWR	CHILLED WATER RETURN	SEP	SEPARATOR
CWS	CHILLED WATER SUPPLY	STR	STRAINER
DRN	DRAIN	SV	SLIDE VALVE
DWR	DOMESTIC WATER RETURN	TK	TANK
DWS	DOMESTIC WATER SUPPLY	TR	TRAP
EX	EXHAUST	V	VALVE
FASS	FIXED AIR SAMPLING SYSTEM	VAC	VACUUM
FP	FIRE PROTECTION	VB	VACUUM BREAKER
H	HYDROGEN GAS	VES	VESSEL
HA	HIGH PRESSURE AIR	VIB	VIBRATION EQUIPMENT
He	HELIUM, ULTRA HIGH PURITY		
HI	INSTRUMENT AIR 100#		
HWR	HOT WATER RETURN		
HWS	HOT WATER SUPPLY		
HY	HYDRAULIC FLUID (THERMAL FLUID)		
IA	INSTRUMENT AIR		
LI5	INSTRUMENT AIR 50#		
NR	INERT GAS		
O2M	OXYGEN MONITORING		
POG	PROCESS OFF-GAS		
SO	SODIUM		
STP	STANDBY POWER		
SW	SANITARY WASTE		
V5	STACK EXHAUST		
VA	VACUUM		
WG	WELDING GAS		

EQUIPMENT IDENTIFIERS

AAV	ATMOSPHERIC AIR VALVE	P	PUMP
AC	GLOVEBOX ATMOSPHERE CONTROLLER	POGV	PROCESS OFF-GAS VALVE
ADV	AUTOMATIC DRAIN VALVE	PSD	PUMP SUCTION DIFFUSER
AE	ANALYSIS ELEMENT	SE	SPECIALIZED EQUIPMENT
AHU	AIR HANDLING UNIT	SEP	SEPARATOR
BFP	BACK FLOW PREVENTER	STR	STRAINER
BLW	BLOWER	SV	SLIDE VALVE
BU	BUBBLER	TK	TANK
BV	BALANCING VALVE	TR	TRAP
CAB	CABINET	V	VALVE
CCU	COOLING COIL UNIT	VAC	VACUUM
CHR	CHILLER	VB	VACUUM BREAKER
CK	CHECK VALVE	VES	VESSEL
CMP	COMPRESSOR	VIB	VIBRATION EQUIPMENT
COND	CONDENSER		
CRU	CONDENSATE RETURN UNIT		
CT	CURRENT TRANSFORMER		
CY	CONTROL RELAY		
DSW	DISCONNECT SWITCH		
DM	DEMISTER		
DMP	DAMPER		
DPE	DRIP PAN ELBOW		
DRY	DRYER		
DT	DRY-TRAIN		
EF	EXHAUST FAN		
EN	ENCLOSURE		
ET	EXPANSION TANK		
FA	FIRE ALARM		
FA	FAN		
FCO	FLOOR CLEAN OUT		
FCU	FAN COIL UNIT		
FD	FLOOR DRAIN		
F	FILTER		
FIT	FLOW INDICATING TRANSMITTER		
FURN	FURNACE		
GBX	GLOVEBOX		
HIV	INSTRUMENT AIR 100# VALVE		
HTR	HEATER		
HE	HEAT EXCHANGER		
JB	JUNCTION BOX		
LUB	LUBRICATOR		
MOT	MOTOR		
MS	MOTOR STARTER		
NC	NORMALLY CLOSED		
NO	NORMALLY OPEN		
NRV	INERT GAS VALVE		

PIPING SYMBOLS

- INTERLOCK
- SPRAY NOZZLE
- REDUCER/INCREASER
- FLOW SIGHT GLASS
- VESSEL PORTS
- DRAIN
- STRAINER
- EXPANSION JOINT
- HOSE
- FLEXIBLE CONNECTION
- QUICK DISCONNECT W/O CHECKS (SHOWN OPEN)
- QUICK DISCONNECT WITH CHECKS (SHOWN CLOSED)
- PLUG
- CAP
- BLIND FLANGE
- LOOP SEAL
- RESTRICTION ORIFICE PLATE
- TRAP
- LUBRICATOR
- WATER HAMMER ARRESTOR
- VAPOR TRAP
- HOSE BIBB
- ST-STEAM TRAP (SHOWN)
- DT-RAIN TRAP
- AT-AIR TRAP
- CT-CONDENSATE TRAP
- MOISTURE SEPARATOR WITH AUTOMATIC DRAIN
- MOISTURE SEPARATOR WITH MANUAL DRAIN
- HEPA FILTER (SHOWN)
- COALESCING FILTER
- SCREEN FILTER
- PAPER ELEMENT FILTER
- METAL FILTER
- PREFILTER

SELF-ACTUATING REGULATORS

- TEMPERATURE REGULATOR
- DIFFERENTIAL-PRESSURE-REDUCING REGULATOR WITH INTERNAL AND EXTERNAL PRESSURE TAPS
- BACKPRESSURE REGULATOR, SELF-CONTAINED
- PRESSURE-REDUCING REGULATOR, SELF-CONTAINED, WITH HANDWHEEL ADJUSTABLE SET POINT
- PRESSURE-REDUCING REGULATOR, WITH EXTERNAL PRESSURE TAP
- BACKPRESSURE REGULATOR WITH EXTERNAL PRESSURE TAP
- PRESSURE-REDUCING REGULATOR, WITH INTEGRAL OUTLET PRESSURE RELIEF VALVE, OPTIONAL PRESSURE INDICATOR
- RUPTURE DISK PRESSURE
- RUPTURE DISK VACUUM
- VACUUM RELIEF
- PRESSURE RELIEF
- PRESSURE AND VACUUM RELIEF
- MANOMETER

ACTUATORS

- HAND
- DIAPHRAGM
- DIAPHRAGM PRESSURE-BALANCED
- SOLENOID
- MOTOR
- CYLINDER WITH PILOT MOUNTING
- CYLINDER, SINGLE-ACTING
- CYLINDER, DOUBLE-ACTING
- FLOAT
- DIAPHRAGM WITH POSITIONER
- SPRING OR WEIGHT
- LATCH-TYPE ACTUATOR WITH MANUAL RESET
- CONTROL VALVE WITH ATTACHED ELECTRO-PNEUMATIC SIGNAL CONVERTER (I/P)
- CONTROL VALVE WITH SEPARATELY MOUNTED ELECTRO-PNEUMATIC SIGNAL CONVERTER (I/P)

HEAT TRANSFER

- WATER COOLED EXCHANGER
- WATER COOLED CONDENSER
- SHELL AND TUBE EXCHANGER
- HEAT EXCHANGER
- HEATER
- SUPERHEATER OR REHEATER
- ELECTRICAL HEATER

INSTRUMENT SYMBOLS

- HARDWIRED LOGIC
- DIGITAL LOGIC CONTROLS INTEGRAL TO ICS
- LIGHT
- INDICATING FLOWMETER (ROTAMETER)
- INDICATING FLOWMETER WITH INTEGRAL THROTTLING VALVE
- PRESSURE INDICATOR WITH INTEGRAL ISOLATION VALVE
- H/O/A - HAND/OFF/AUTO (SHOWN)
- S/S - START/STOP
- O/O - ON/OFF
- O/A/C - OPEN/AUTO/CLOSE
- O/C - OPEN/CLOSE
- S/S/J - START/STOP/JOG
- TEMPERATURE ELEMENT WITH THERMOWELL
- ΔT THERMAL MASS FLOWMETER
- C CAMERA

PIPE MATERIAL ABBREVIATION

- AM STAINLESS STEEL TUBE
- AR STAINLESS STEEL PIPE
- NH POLYETHYLENE TUBE
- NN CARBON STEEL PIPE

PIPE LINE NUMBERING SYSTEM

SIZE 3" - HW - SH - 160001 - H INSULATION LINE SEQUENCE NUMBER

GENERAL INSTRUMENT OR FUNCTION DISCRETE INSTRUMENTS

- FIELD MOUNTED DEVICES
- PRIMARY LOCATION (PLC OR INTERFACE CABINET)
- AUXILIARY LOCATION (NORMALLY INACCESSIBLE)
- NORMALLY INACCESSIBLE OR BEHIND-THE-PANEL

OPERATOR CONTROL STATION

- OCS SHARED DISPLAY INACCESSIBLE TO OPERATOR
- CONTROL LOGIC IN OCS ACCESSIBLE TO OPERATOR

PROGRAMMABLE LOGIC CONTROL

- CONTROL LOGIC IN PLC INACCESSIBLE TO OPERATOR
- CONTROL LOGIC IN PLC ACCESSIBLE TO OPERATOR
- COMPUTER FUNCTION FIELD MOUNT
- COMPUTER FUNCTION NORMALLY ACCESSIBLE TO OPERATOR

DRYERS

- GENERAL
- DESSICANT

DRYERS

- GENERAL
- DESSICANT

DRYERS

- GENERAL
- DESSICANT

DRIVERS

- MOTOR
- SPEED REDUCER (GEAR DRIVEN)
- SPEED REDUCER (BELT DRIVEN)

INSTRUMENT & EQUIPMENT IDENTIFICATION

SA FORMAT PROCESS VARIABLE IDENTIFIER

PLANT AREA

PIT-SPF 100-0318

TEAM MEMBER

SEQUENCE NUMBER

HV-SPF-XXXX

UNIQUE NUMBER

PLANT AREA

EQUIPMENT IDENTIFIER

NOTES:

- GRAPHICAL SYMBOLS AND IDENTIFIERS ARE BASED ON ANSI/ISA.
- INSTRUMENTATION SYMBOLS AND IDENTIFICATION FROM ISA

REVISION HISTORY

REV	DESCRIPTION	DATE
1	INCORPORATED FDC-9007, -9135, -9347, SEE DRG-341129	
2	AS-BUILT AS OF 3/18/2014, SUBMITAL TO STATE FOR RCBA	
3	PERMIT, SEE DRG-341590	
	AS-BUILT AS OF 3/18/2014, SUBMITAL TO STATE FOR RCBA	
	PERMIT, SEE DRG-341662	

Idaho Cleanup Project

CPP-666

RH-TRU DISTILLATION SYSTEM

INSTRUMENTATION LEGEND SHEET 2

SIGNATURES/DATES APPLY TO CURRENT RELEASE ONLY

DESIGN:	SIGN AND DATE
NA	- -
DRAFTER:	Jason Williams Hukari 2014.03.28 10:36:48 -0600'
TECHNICAL CHECK:	
NA	- -
ENG GROUP SUPERVISOR:	
NA	- -
DESIGN LEAD/AUTHORITY:	David Morgan CWI 2014.03.28 10:55:12 -0600'
DRAFTING CHECK/EFFECTIVE DATE:	Kris Keller CWI 2014.03.28 11:03:09 -0600'

NO SCALE

DESIGN PHASE:

QUALITY LEVEL: 3

HORIZONTAL SCALE: NONE

VERTICAL SCALE: NA

FOR DRAWING INDEX SEE DRAWING NO. 571426

PROJECT NUMBER: 31720

INDEX CODE NUMBER			
AREA	TYPE	CL	ORIG
200	0666	24	136

I CERTIFY THAT THIS DRAWING REFLECTS THE CURRENT CONSTRUCTED CONDITION AS OF 3/18/2014

Randy Eastman
CWI
2014.03.28 11:06:00
PROFESSIONAL ENGINEER
4307
STATE OF IDAHO
RANDY EASTMAN


SIZE	DWG-	REV
D	571622	3

DRF NO. SHEET P-2

338620

NOTES:

- REMOVE ALL BURRS AND SHARP EDGES.
- ALL MACHINED FILLET RADII .03 MAXIMUM UNLESS OTHERWISE NOTED.
- WELDING SHALL BE PERFORMED IN ACCORDANCE WITH ASME B31.3 USING ITEM 18.
- VISUALLY INSPECT ALL WELDS IN ACCORDANCE WITH ASME B31.3, PARA. 341.4.1 (a) FOR NORMAL FLUID SERVICE. ACCEPTANCE CRITERIA SHALL BE PER ASME B31.3, PARA. 341.3.2.
- PERFORM IN-PROCESS INSPECTION OF WELDS WHERE SPECIFIED PER ASME B31.3 PARA. 344.7 USING LIQUID PENETRANT EXAMINATION OF THE ROOT AND FINAL PASS.
- LIQUID PENETRANT EXAMINATION SHALL BE PERFORMED IN ACCORDANCE WITH THE BPV CODE SECTION V, ARTICLE 6. ACCEPTANCE CRITERIA SHALL BE:
 - ALL SURFACES TO BE EXAMINED SHALL BE FREE OF:
 - RELEVANT LINEAR INDICATIONS
 - RELEVANT ROUNDED INDICATIONS GREATER THAN 5MM (3/16")
 - FOUR OR MORE RELEVANT ROUNDED INDICATIONS IN A LINE SEPARATED BY 1.5MM (1/16") OR LESS, EDGE-TO-EDGE.
 - CRACK LIKE INDICATIONS DETECTED, IRRESPECTIVE OF SURFACE CONDITIONS, ARE UNACCEPTABLE.
- FINAL ASSEMBLY SHALL BE FREE OF DIRT, CHIPS, WELDING FLUX, SLAG, SCALE, OIL, GREASE, ETC. PERFORM A VISUAL INSPECTION OF THE FINAL ASSEMBLY PER ASTM A380, PARA 7.2.1.
- MARK PER CWI STD-7006-2A OR STD-7006-2D IN 1/2" HIGH CHARACTERS WITH INFORMATION AS SHOWN WHERE "ZZ" IS A UNIQUE NUMBER ASSIGNED FOR EACH ASSEMBLY BUILT AND "YY" IS THE MEASURED WEIGHT OF THE -1 ASSEMBLY. LOCATE APPROXIMATELY WHERE SHOWN. FILL CHARACTERS WITH SANFORD T.E.C. MARKER #13401 OR #13501, ITW DYMON FORMULA Q404 INK OR OTHER HIGH-PURITY LOW-CHLORIDE BLACK INK THAT COMPLIES WITH ASTM C1217-00 OR RDT F7-3T. DO NOT APPLY VARNISH OVER MARKING.
- VERIFY MARKINGS HAVE BEEN ACCURATELY APPLIED AND RECORD THE UNIQUE NUMBER AND MEASURED WEIGHT.
- COMPLETED ASSEMBLY SHALL UNDERGO A PNEUMATIC LEAK TEST IN ACCORDANCE WITH ASME B31.3 AT A PRESSURE OF 16.5 TO 18.5 PSIG. "SNOOP" ALL CONNECTIONS FOR LEAKS. PRESSURE DROP SHALL NOT EXCEED 0.1 PSIG OVER A 10 MINUTE PERIOD.
- TOLERANCES ON DECIMALS
.XX = ± .06
.XXX = ± .005
- REMOVED
- DESIGN PRESSURE: FULL VACUUM TO 15 PSIG.
- DESIGN TEMPERATURE: DISTILLATION VESSEL - 1250° F, VAPOR PIPING - 1200° F
- REMOVED
- REMOVED
- A 1/4 NPT TELLTALE HOLE SHALL BE PROVIDED IN ITEM 24 FOR TESTING THE ATTACHING WELDS ACCORDING TO ASME BPV CODE SECTION VIII, DIV. 1, UG-37(g). 5 PSIG AIR SHALL BE USED FOR THE TEST. LEAVE HOLE UNFILLED.
- WELD AS SHOWN ON EITHER SIDE OF THE SADDLE, WHICHEVER SIDE IS EASIEST TO ACCESS. BOTH SIDES NOT REQUIRED.
- WELD PER INL WELD PROCEDURE SPECIFICATION S2.0 USING ITEM 18.
- VISUALLY INSPECT ALL WELDS IN ACCORDANCE WITH TPR-4981 "VISUAL EXAMINATION" APPENDIX K "VISUAL ACCEPTANCE CRITERIA FOR AWS D1.6, FOR STATICALLY LOADED MEMBERS.

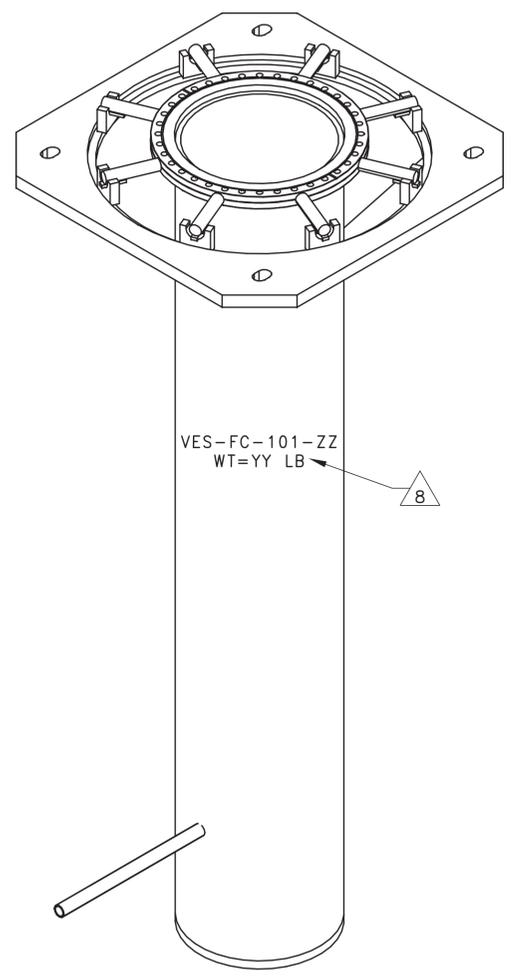

3D VIEW
(SHOWN FOR CLARITY)
SCALE: NONE

REVISIONS	
REV	DESCRIPTION
1	INCORPORATED FDCs 8784, 8889, 8961, 9121, 9300, AND 9370 SEE DRF-340057
2	INCORPORATED FDCs 9442, 9468, 9526, AND 9548 AS-BUILT AS OF 3/18/2014, SUBMITTAL TO STATE FOR RCRA PERMIT, SEE DRF-341137

QTY REQD	QUAL LEVEL	PART OR IDENTIFYING NO.	NOMENCLATURE OR DESCRIPTION	MATERIAL/SPECIFICATION OR VENDOR NAME	ITEM NO.
2		3	-24	REPAD HALF	PLATE 304H SST ASTM A240 24
		1	3	-23	COLLAR PIPE, SEAMLESS 304H SST ASTM A312 23
					22
					21
					20
					19
AR	AR	AR	AR	3	WELD FILLER METAL ER 308H AWS A 5.9 18
					17
					16
	8		3	-15	SHIM PLATE 304 OR 304L SST ASTM A240 15
8			3	-14	ROD BAR 304 OR 304H SST ASTM A479 14
1			3	-13	CF FLANGE MAKE FROM #F1650X000N KURT J LESKER, CO. 13
	8		3	-12	SADDLE PLATE 304H SST ASTM A240 12
	1		3	-11	PLATE 304H SST ASTM A240 11
	1		3	-10	CONDENSOR LINE PIPE, SEAMLESS 304H SST ASTM A312 10
	1		3	-9	NITROGEN LINE PIPE, SEAMLESS 304H SST ASTM A312 9
	1		3	-8	BOTTOM PLATE PLATE 304H SST ASTM A240 8
	1		3	-7	DISTILLATION BODY PIPE, SEAMLESS 304H SST ASTM A312 7
				-6	REMOVED 6
		1	3	-5	INDEX ASSEMBLY 5
		1	3	-4	VESSEL ASSEMBLY 4
		1	3	-3	SADDLE ASSEMBLY 3
				-2	REMOVED 2
				-1	ASSEMBLY 1



I CERTIFY THAT THIS DRAWING REFLECTS THE CURRENT CONSTRUCTED CONDITION AS OF 3/18/2014

INSPECTION REQUIREMENTS	-1	571692
QC REQUIRED	DASH NO.	NEXT ASSY
Q	DENOTES Q/C INSP. REQD.	

DIMENSIONING AND SYMBOLY PER ASME Y14.5-2009 AND STD-11 UNLESS OTHERWISE SPECIFIED SURFACE ROUGHNESS 125/ DIMENSIONS AND TOLERANCES ARE IN INCHES TOLERANCES: X = ± .1 DECIMALS: .XX = ± .06 .XXX = ± .005 FRACTIONS: ± 1/8 ANGULAR: ± 2° DO NOT SCALE DRAWING
--

SIGNATURES/DATES APPLY TO CURRENT RELEASE ONLY	SIGN AND DATE
DESIGN: R. CAMPBELL	Rodney C. Campbell 2014.03.20 11:38:38 -0600
DRAFTER: C. WRIDE	Cad Wride 2014.03.20 11:24:55 -0600
TECHNICAL CHECK: N. SEAWER	Randy Eastman 2014.03.20 16:10:04 -0600
ENG GROUP SUPERVISOR: R. EASTMAN, P.E.	Randy Eastman 2014.03.20 12:52:53 -0600
DESIGN LEAD/AUTHORITY: D. MORGAN	David Morgan 2014.03.20 11:50:35 -0600
DRAFTING CHECK/EFFECTIVE DATE: S. BERTHELSON	Shawn Berthelson 2014.03.20 16:24:35 -0600
PROJECT NUMBER: 31720	
DRF NUMBER: 337562	

Idaho Cleanup Project


CPP-666

RH-TRU DISTILLATION PROJECT
DISTILLATION VESSEL ASSEMBLY
VES-FC-101


SIZE	INDEX CODE	NUMBER	DWG-	571700	REV	2
D	AREA	TYPE	CL	ORIG		
200	0666	53	136			

SCALE: NONE SHEET 1 OF 6


Date: 03/20/14 - 11:20 AM
 Layout Name: Sheet 1
 ID: WRIDCC
 Path: K:\0-Signoff\Checker Review\Shawn\DRF-341137

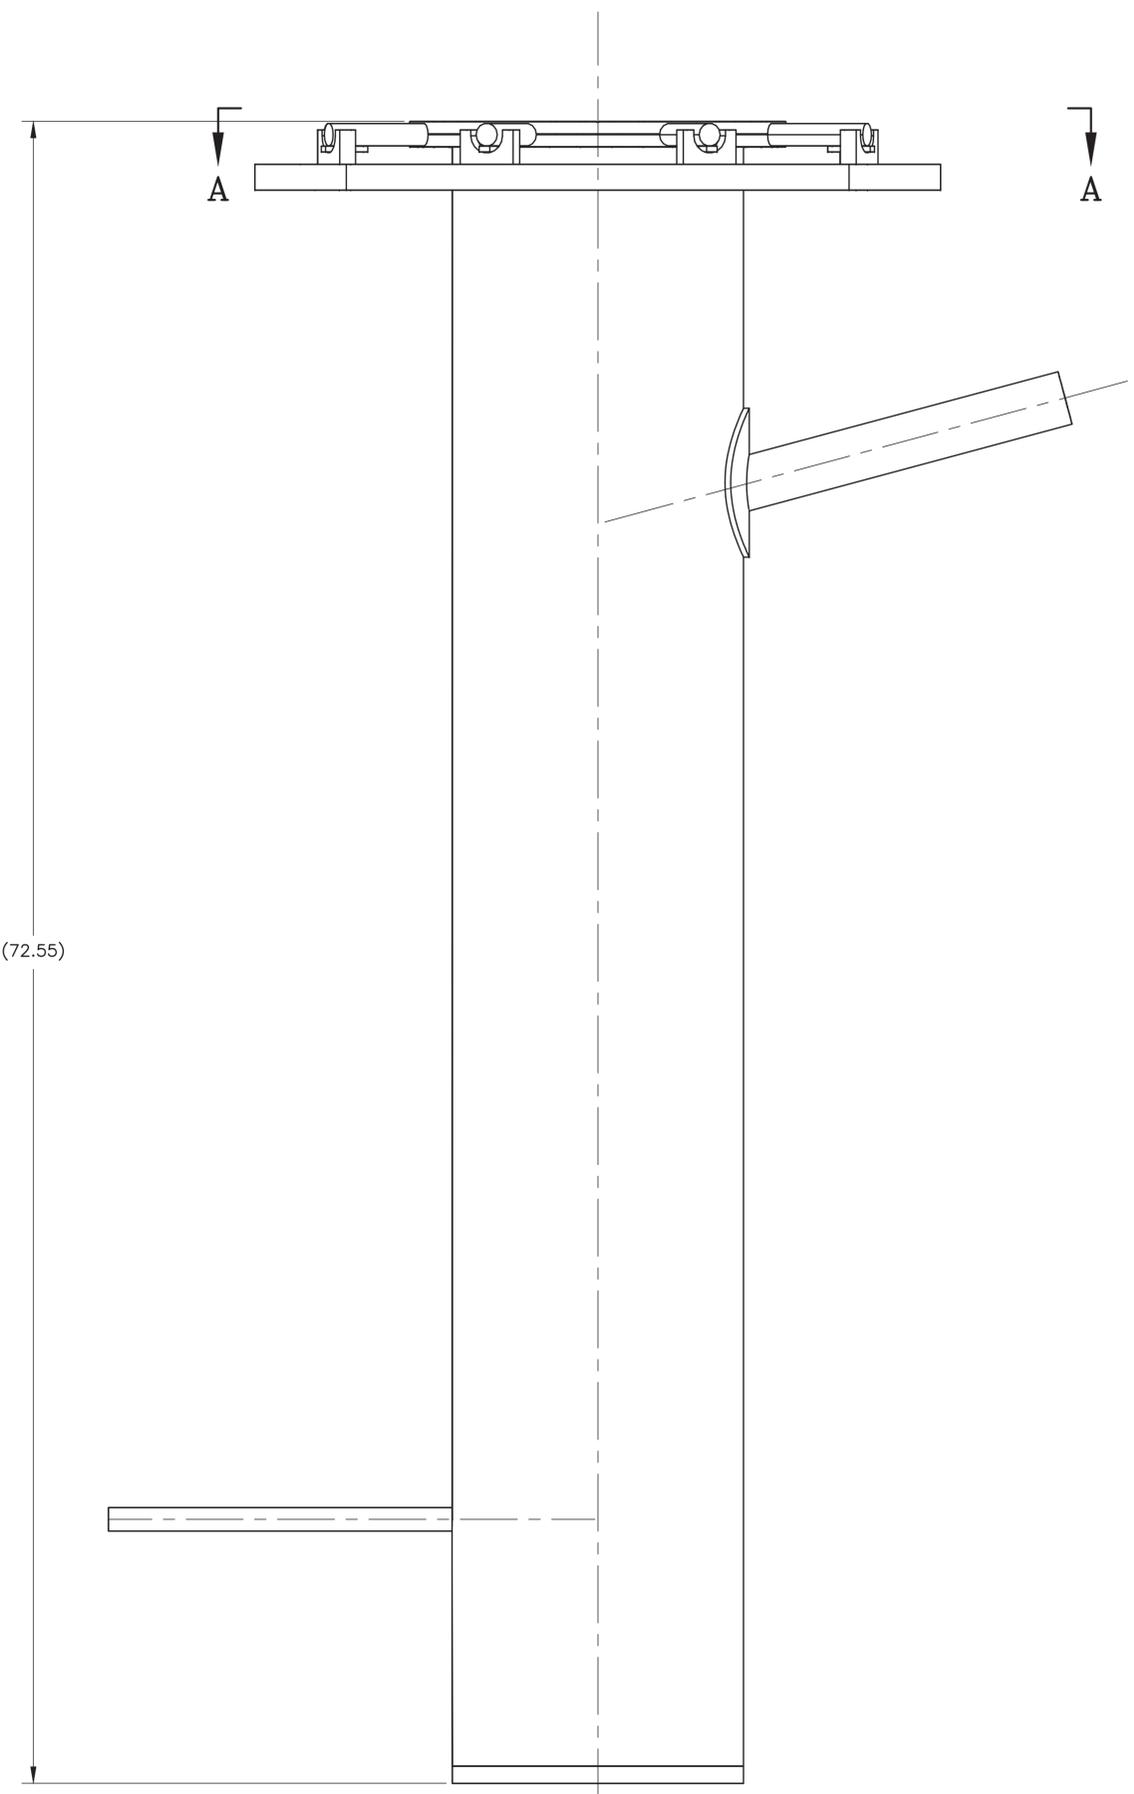

-1 ASSEMBLY
SCALE: 1/4

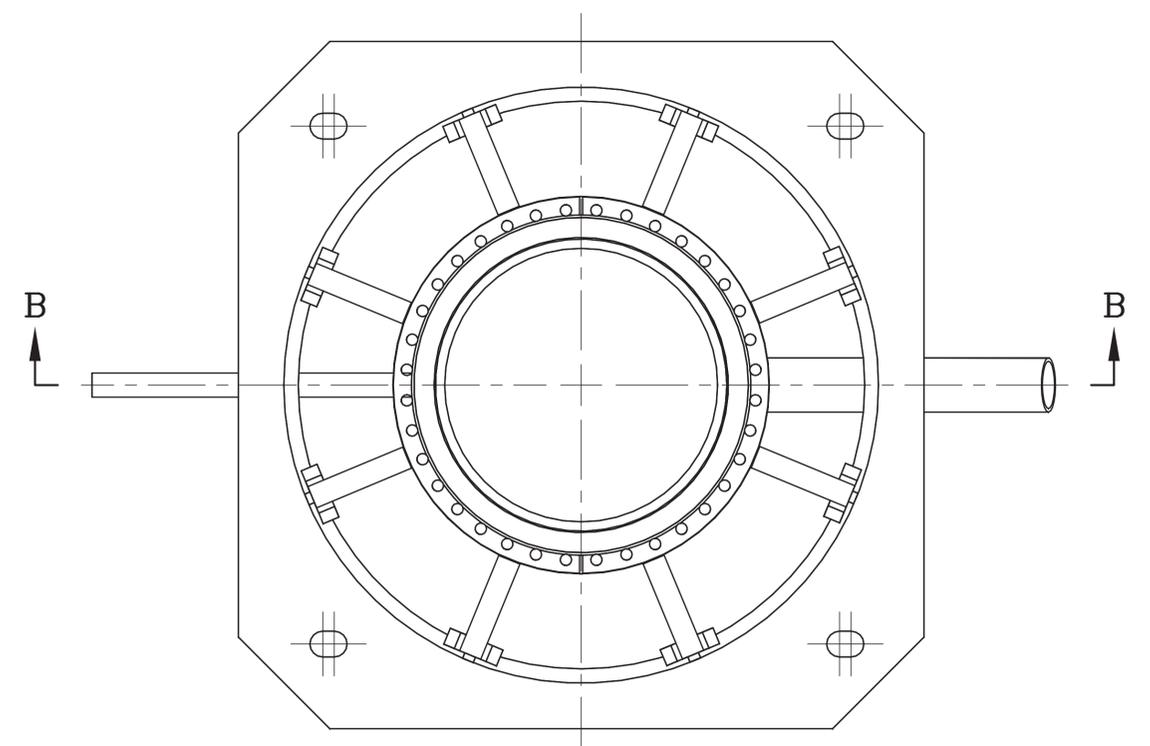


VIEW A-A
SCALE: 1/4

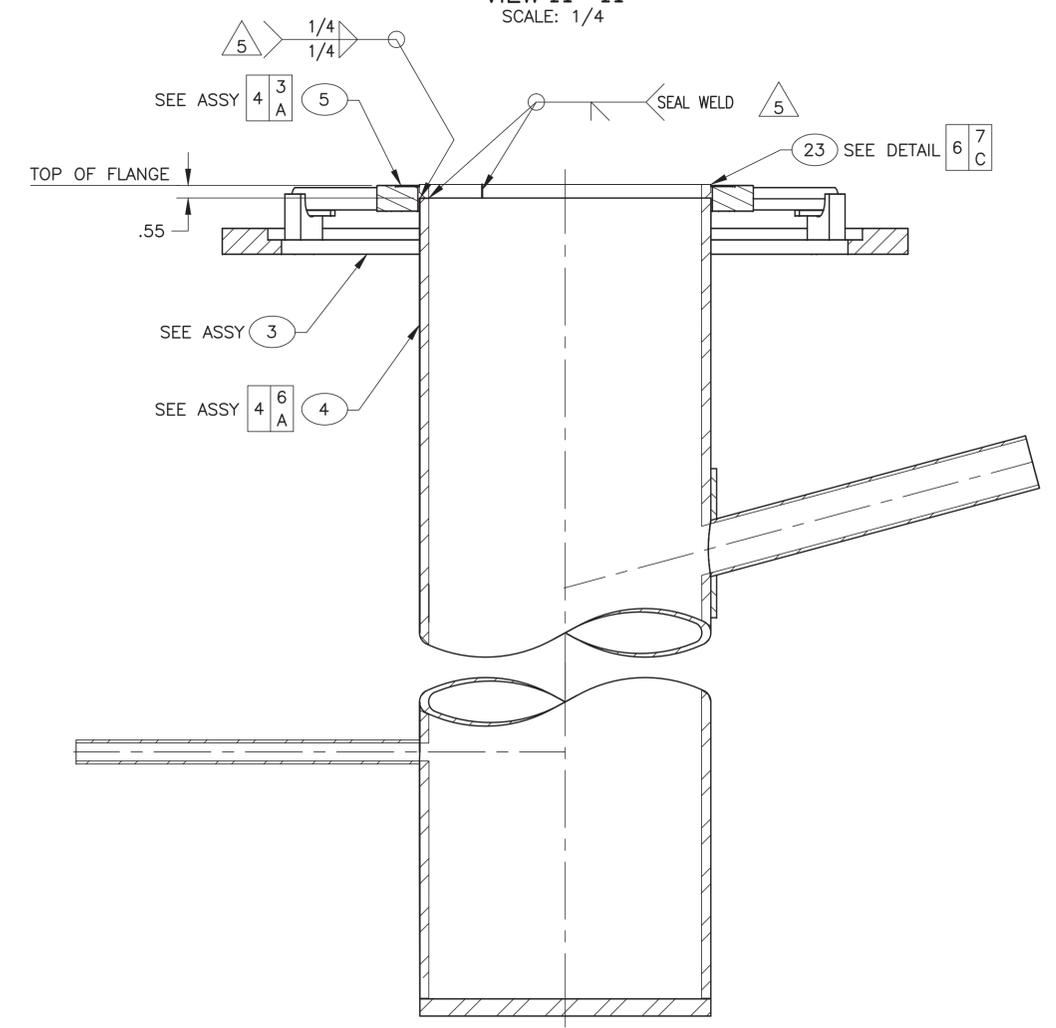



SECTION B-B
SCALE: 1/4

SIZE	INDEX CODE	NUMBER	REV
D	AREA	TYPE	DL
200	0666	53	136
SCALE: NOTED			DWG- 571700
SHEET 2			REV 2


File: 571700-2.dwg
Date: 03/20/14 - 11:20 AM
Layout Name: Sheet 2
Pat: K:\0-Signoff\Checker Review\Berthelson_Shawn\DRF-341137

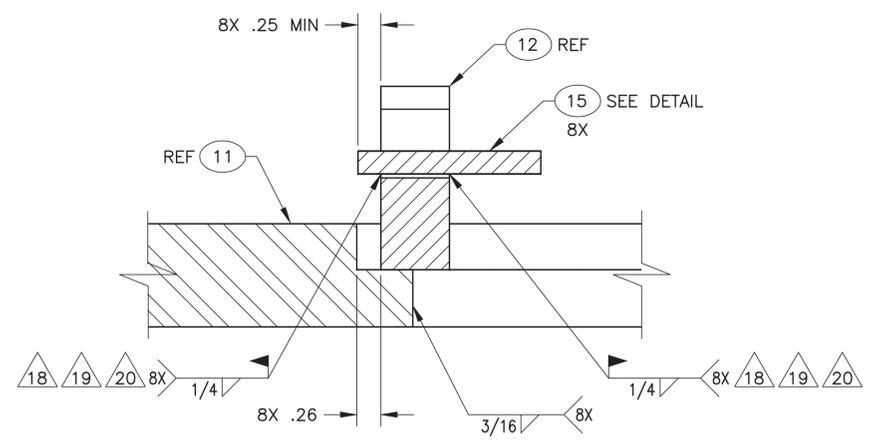

VIEW C-C
SCALE: 1/1

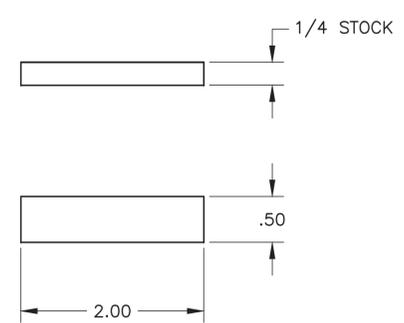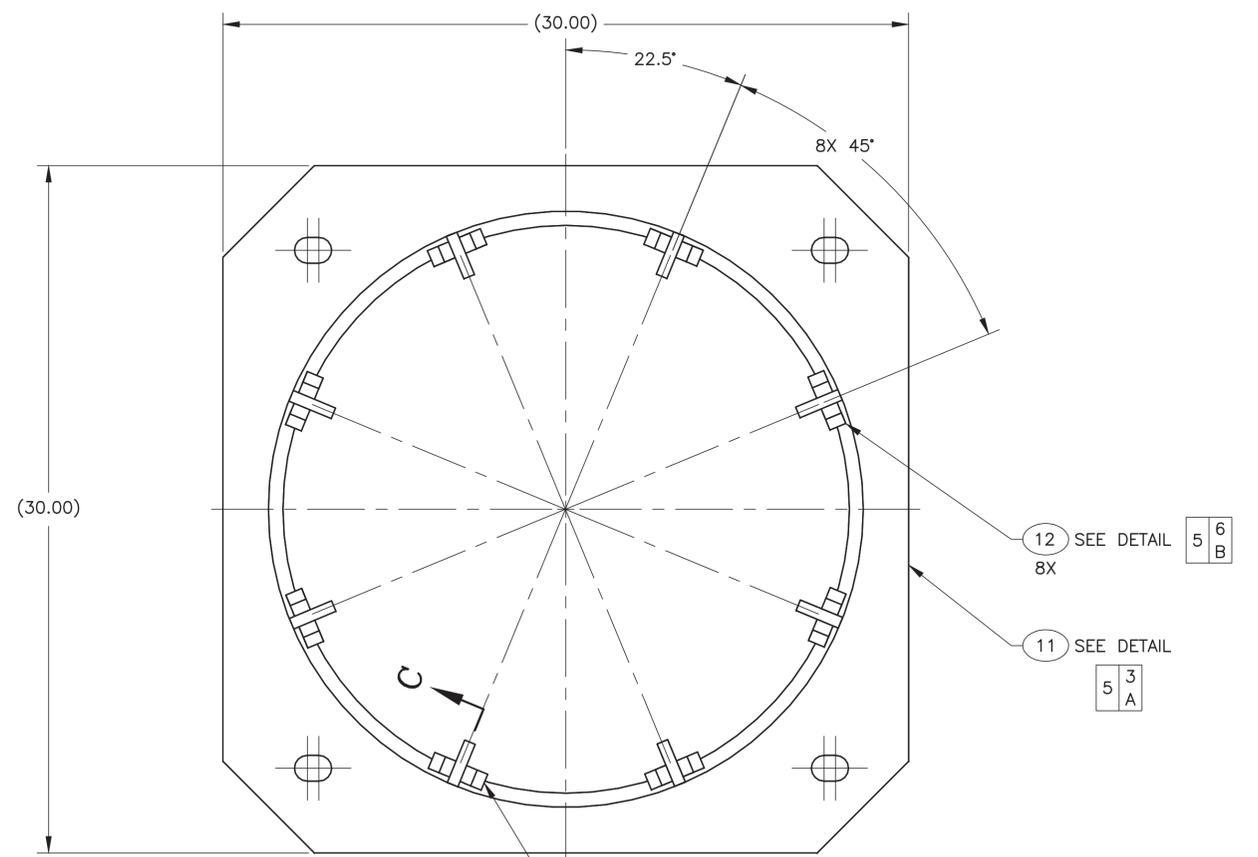



15 DETAIL
SCALE: 1/1

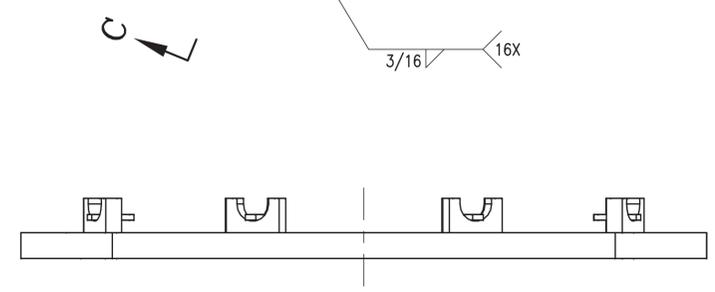


-3 ASSEMBLY
SCALE: 1/4

SIZE	INDEX CODE	NUMBER	REV
D	AREA	TYPE	DL
200	0666	53	136
SCALE: NOTED			DWG- 571700
SHEET 3			2

File: 571700-2.dwg
Date: 03/20/14 - 11:20 AM
Layout Name: Sheet 3
Pat: K:\D-Signoff\Checker Review\Berthelson_Shawn\DRF-341137

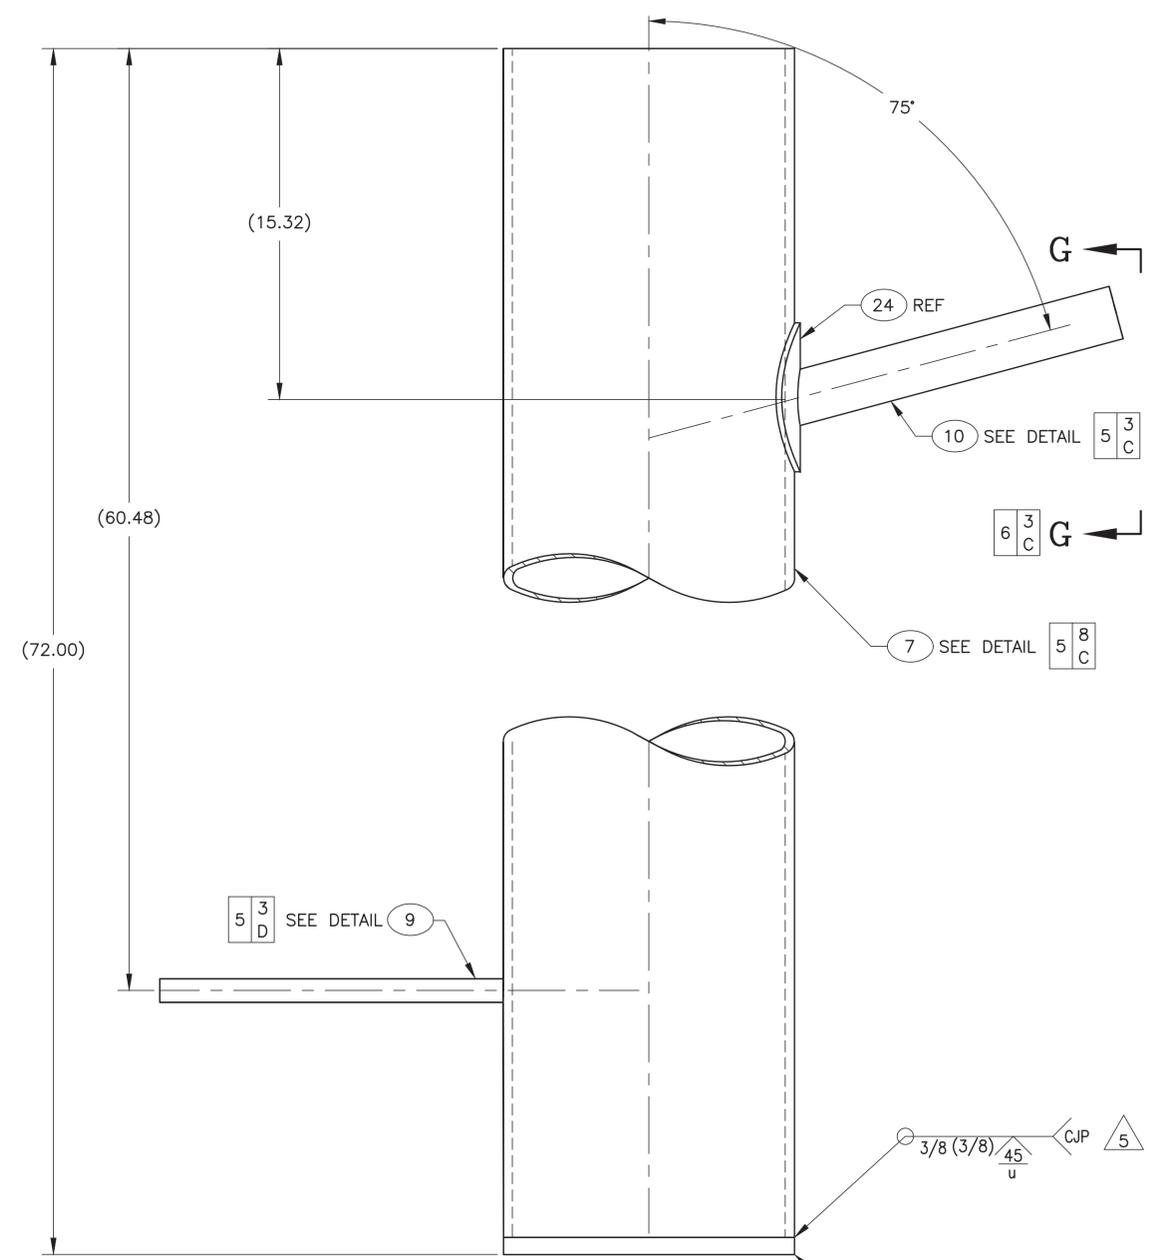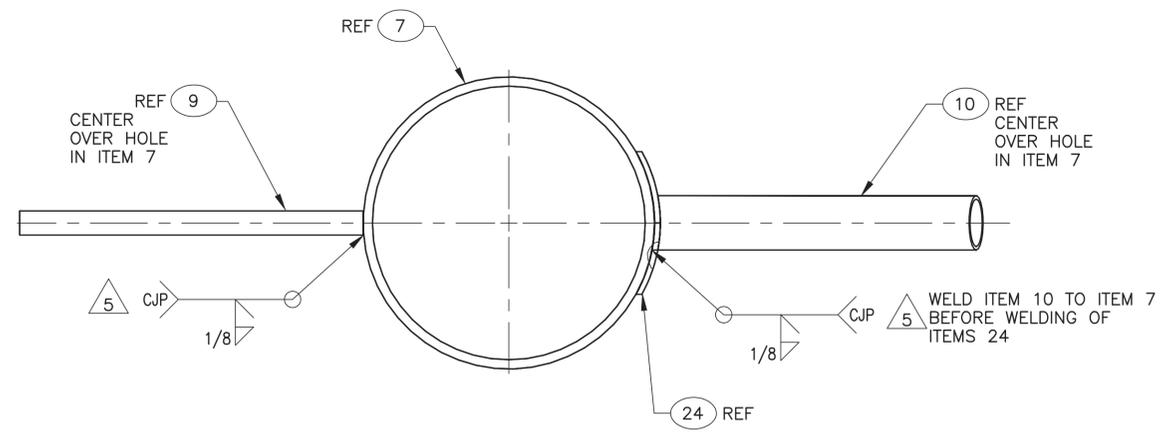


-4 ASSEMBLY
SCALE: 1/4

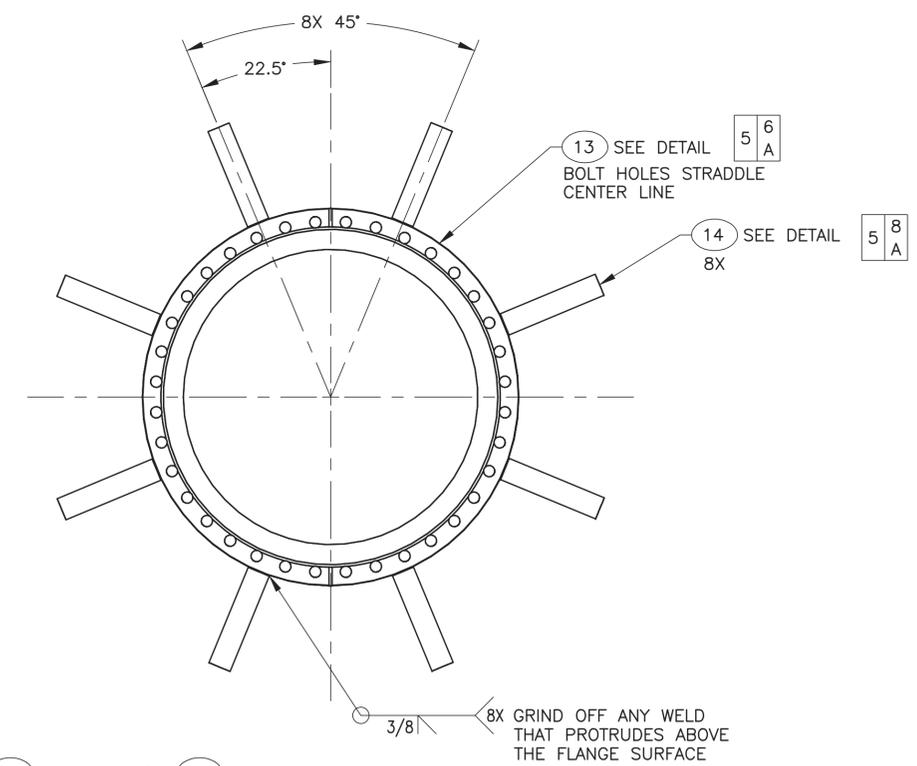


-5 ASSEMBLY
SCALE: 1/4

DATE	INDEX CODE	NUMBER	REV
03/20/14	200	0666 53 136	2
DWG- 571700			
SCALE: NOTED			SHEET 4


Date: 03/20/14 - 11:20 AM Layout Name: Sheet 4
Pat: K:\0-Signoff\Checker Review\Berthelson_Shawn\DRF-341137

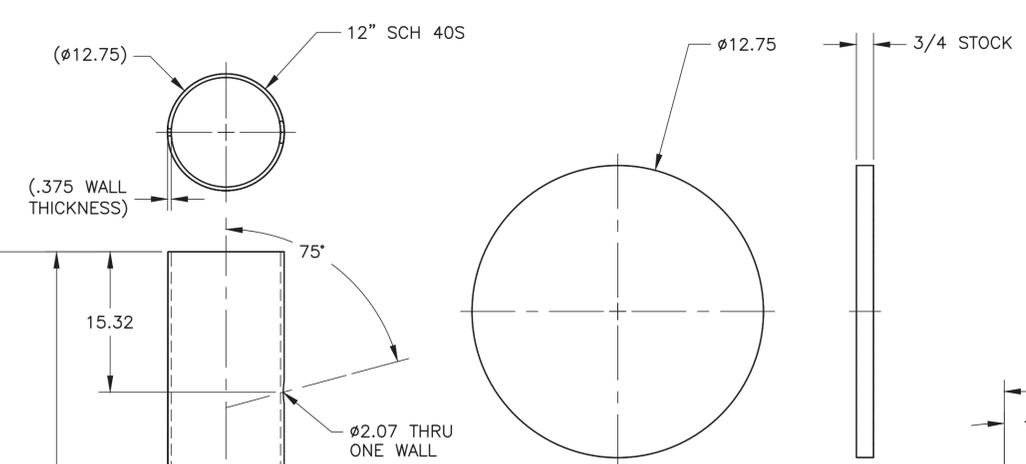


8 DETAIL
SCALE: 1/4

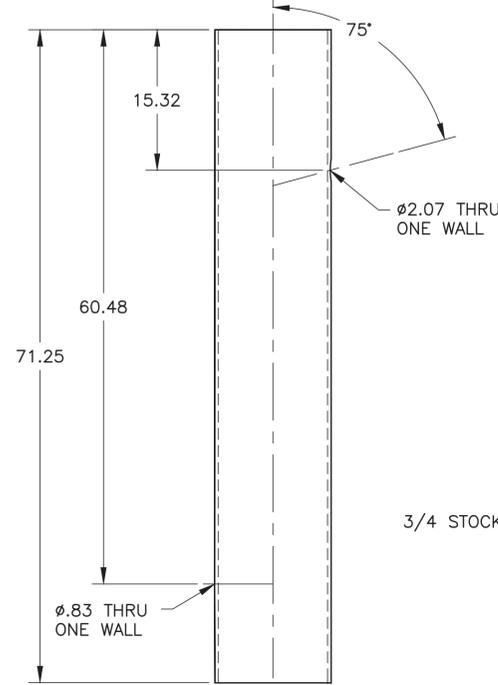


7 DETAIL
SCALE: 1/10

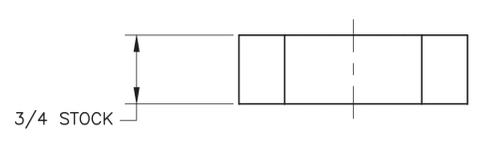


12 DETAIL
SCALE: 1/1

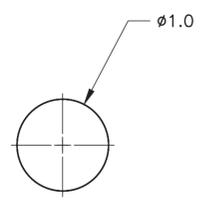


14 DETAIL
SCALE: 1/1

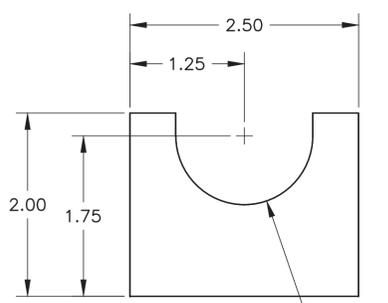


13 DETAIL
SCALE: 1/4

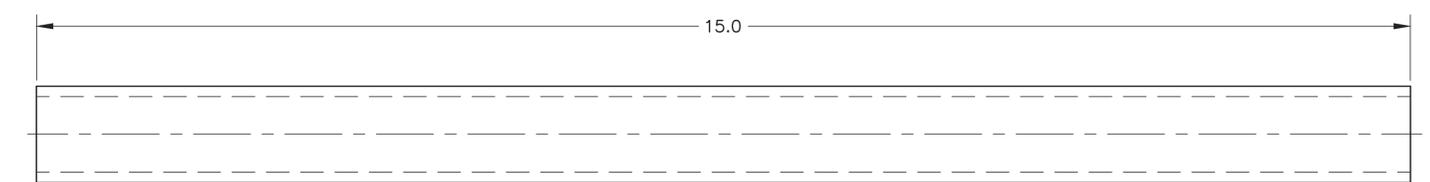




9 DETAIL
SCALE: 1/1

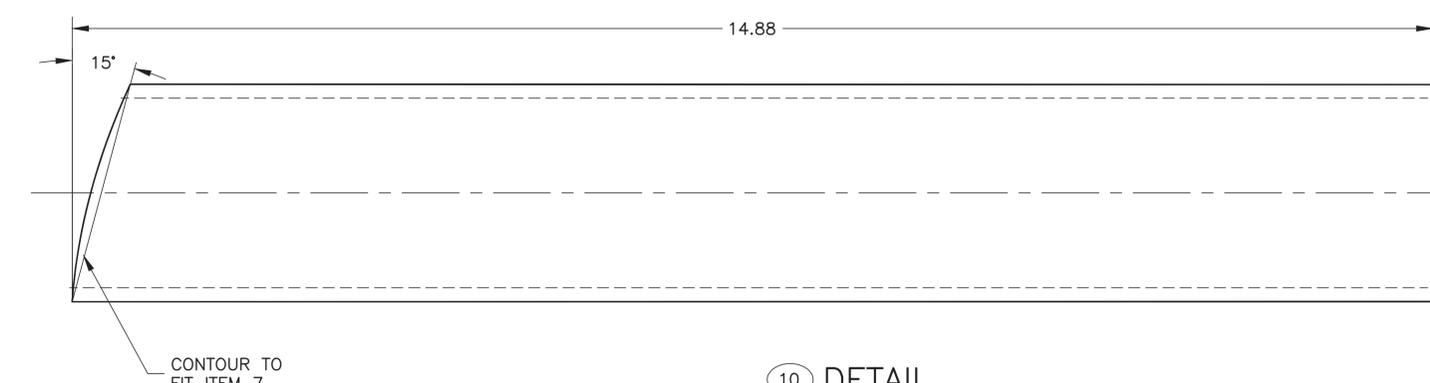

10 DETAIL
SCALE: 1/1

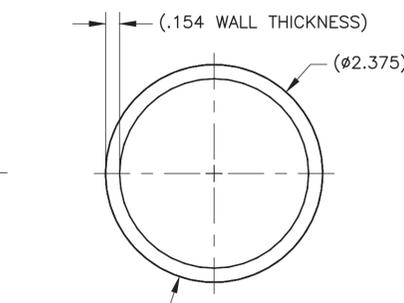


11 DETAIL
SCALE: 1/4

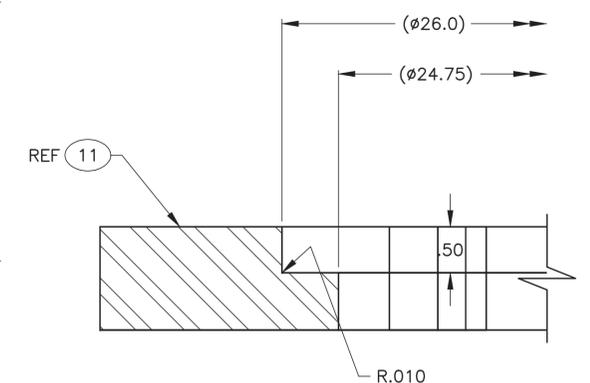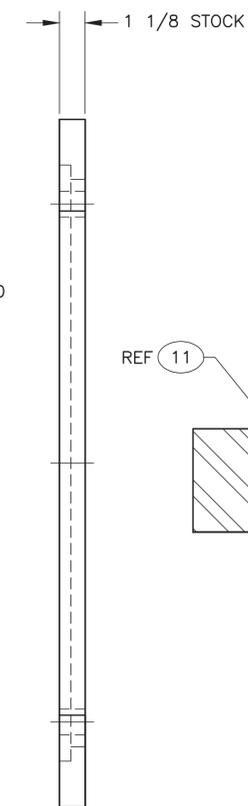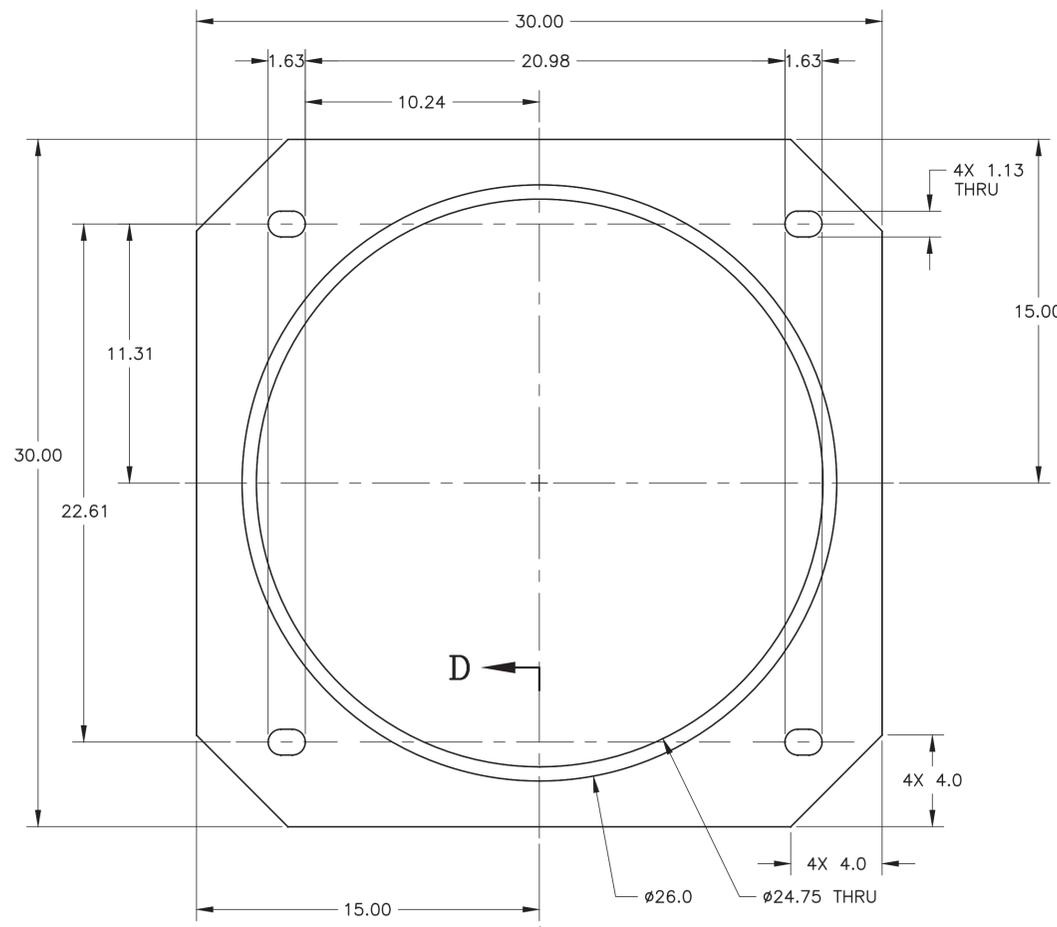


VIEW D-D
ROTATED 90° CW
SCALE: 1/1

SIZE	INDEX CODE	NUMBER	DWG-	571700	REV
D	AREA	TYPE	DL	ORIG	2
	200	0666	53	136	
SCALE: NOTED				SHEET	5


Date: 03/20/14 - 11:20 AM Layout Name: Sheet 5
File: 571700-2.dwg Pat: K:\0-Signoff\Checker Review\Berthelson_Shawn\DRF-341137

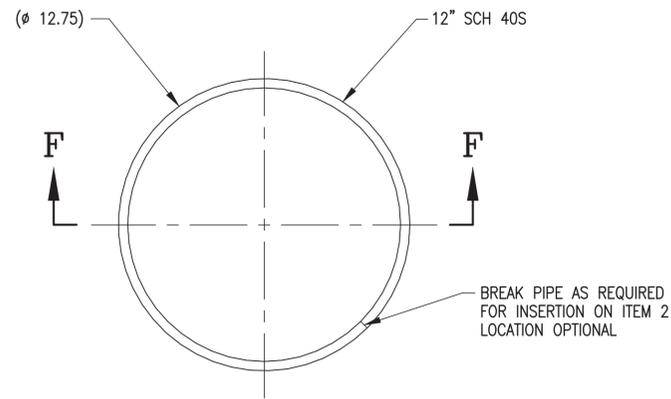


23 DETAIL
SCALE: 1/4

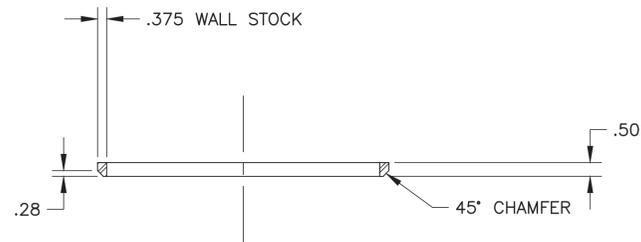

SECTION F-F
SCALE: 1/4

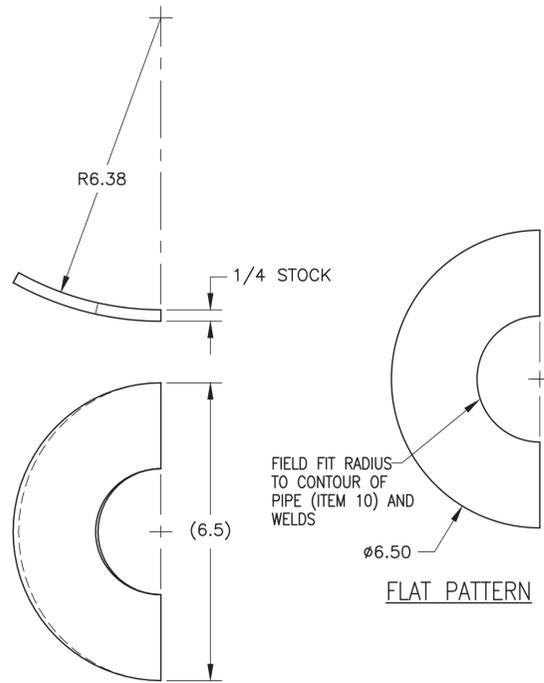

24 DETAIL
SCALE: 1/2

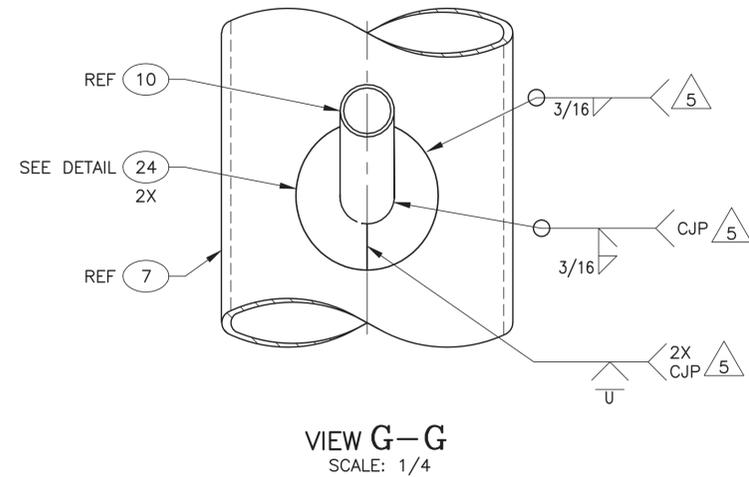


VIEW G-G
SCALE: 1/4

File: 571700-2.dwg
Date: 03/20/14 - 11:20 AM
Layout Name: Sheet 6
Pat: K:\0-Signoff\Checker Review\Berthelson_Shawn\DRF-341137

SIZE	INDEX CODE NUMBER			DWG-	571700	REV
D	AREA	TYPE	CL	ORIG		2
	200	0666	53	136		
SCALE: NOTED					SHEET	6

NOTES:

1. REMOVE ALL BURRS AND SHARP EDGES.
2. ALL MACHINED FILLET RADII .03 MAXIMUM UNLESS OTHERWISE NOTED.
3. ALL PRESSURE BOUNDARY WELDS SHALL COMPLY WITH BPV CODE SECTION VIII, DIV. 1, ASME SECTION X OR ASME B31.3.
4. ALL STRUCTURAL, NON-PRESSURE BOUNDARY WELDING SHALL BE PERFORMED IN ACCORDANCE WITH AWS D1.6, STRUCTURAL WELDING CODE FOR STAINLESS STEEL.
5. VISUALLY INSPECT ALL WELDS IN ACCORDANCE WITH ASME BPV CODE SECTION V, ARTICLE 9.
6. LIQUID PENETRANT EXAMINATION SHALL BE PERFORMED IN ACCORDANCE WITH THE BPV CODE SECTION V, ARTICLE 6. ACCEPTANCE CRITERIA SHALL BE:
 - a. ALL SURFACES TO BE EXAMINED SHALL BE FREE OF:
 - (1) RELEVANT LINEAR INDICATIONS
 - (2) RELEVANT ROUNDED INDICATIONS GREATER THAN 5MM (3/16")
 - (3) FOUR OR MORE RELEVANT ROUNDED INDICATIONS IN A LINE SEPARATED BE 1.5MM (1/16") OR LESS, EDGE-TO-EDGE.
 - b. CRACK LIKE INDICATIONS DETECTED, IRRESPECTIVE OF SURFACE CONDITIONS, ARE UNACCEPTABLE.
7. FINAL ASSEMBLY SHALL BE FREE OF DIRT, CHIPS, WELDING FLUX, SLAG, SCALE, OIL, GREASE, ETC. PERFORM A VISUAL INSPECTION OF THE FINAL ASSEMBLY PER ASTM A380, PARA 7.2.1.
8. MARK PER STD-7006-2A OR STD-7006-2D IN 1/2" HIGH CHARACTERS WITH INFORMATION AS SHOWN WHERE "ZZ" IS A UNIQUE NUMBER ASSIGNED FOR EACH ASSEMBLY BUILT AND "YY" IS THE MEASURED WEIGHT OF THE -1 ASSEMBLY. LOCATE APPROXIMATELY WHERE SHOWN. FILL CHARACTERS WITH SANFORD T.E.C. MARKER #13401 OR #13501, ITW DYMON FORMULA Q404 INK OR OTHER HIGH-PURITY LOW-CHLORIDE BLACK INK THAT COMPLIES WITH ASTM C1217-00 OR RDT F7-3T. DO NOT APPLY VARNISH OVER MARKING.
9. VERIFY MARKINGS HAVE BEEN ACCURATELY APPLIED AND RECORD THE UNIQUE NUMBER AND MEASURED WEIGHT.
10. COMPLETED ASSEMBLY SHALL UNDERGO A PNEUMATIC LEAK TEST IN ACCORDANCE WITH ASME B31.3 AT A PRESSURE OF 16.5 TO 18.5 PSIG. "SNOOP" ALL CONNECTIONS FOR LEAKS. PRESSURE DROP SHALL NOT EXCEED 0.1 PSIG OVER A 10 MINUTE PERIOD.
11. DESIGN PRESSURE: FULL VACUUM TO 15 PSIG.
12. DESIGN TEMPERATURE = 1000° F
13. TOLERANCES ON DECIMALS
 .XX = ± .06
 .XXX = ± .005
14. BOLT TORQUES:
 TORQUE 1/2-13 UNC BOLTS, ITEM 26, TO 32(+3/-0)FT-LB.
 TORQUE M8 BOLTS, SUPPLIED WITH ITEM 23, TO 15(+2/-0)FT LB.
15. APPLY THREAD LUBRICANT, ITEM 31, TO ALL SCREWS AND BOLTS.
16. TRIM PIPES, ITEMS 4 AND 28, TO MATCH EXTERIOR SURFACE OF ITEMS 6 AND 7 AS NEEDED. CUT HOLES IN ITEMS 6 AND 7 TO MATCH ID OF ITEMS 4 AND 28 AS NEEDED.

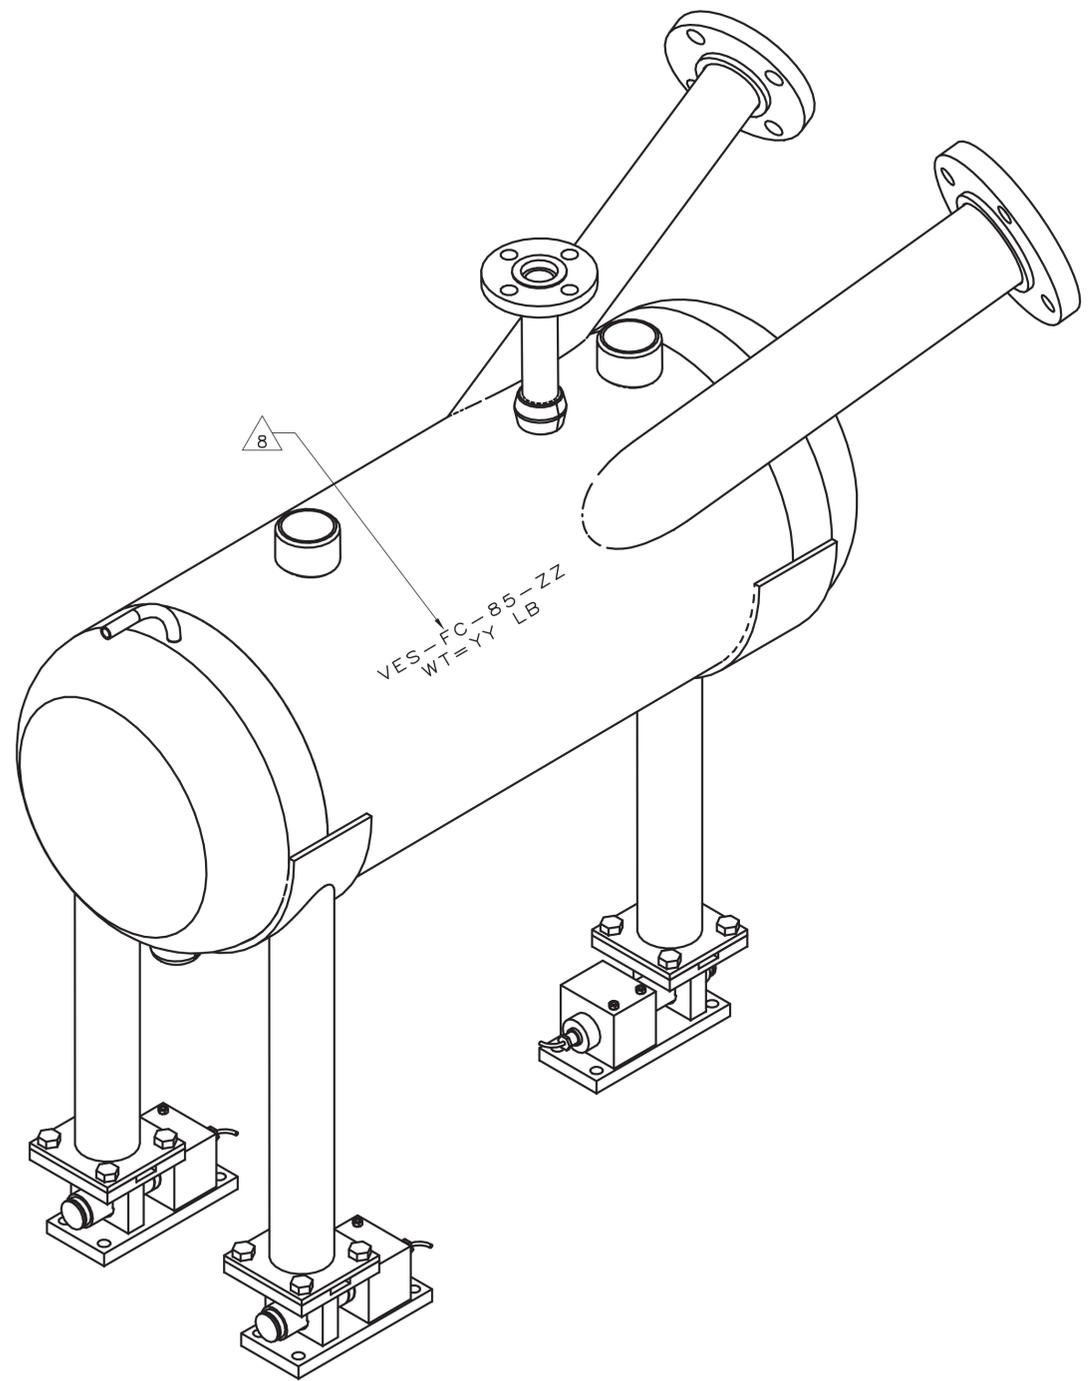

3D VIEW
 (SHOWN FOR CLARITY)
 SCALE: NONE

Randy Eastman
 CWI
 2014.03.20 08:03:30
4307
 PROFESSIONAL ENGINEER
 REGISTERED
 STATE OF IDAHO
 RANDY EASTMAN

I CERTIFY THAT THIS DRAWING REFLECTS THE CURRENT CONSTRUCTED CONDITION AS OF 3/18/2014

INSPECTION REQUIREMENTS	-1	571692
QC REQUIRED	DASH NO.	NEXT ASSY
Q DENOTES Q/C INSP. REQD.		

15

REVISIONS									
REV	DESCRIPTION								
3	INCORP'D FDCs 9468, 9510, 9535, 9587, & 9605 PREVIOUS HISTORY REMOVED; SEE DRF-341136								
4	AS-BUILT AS OF 3/18/2014, SUBMITTAL TO STATE FOR RCRA PERMIT, SEE DRF-341590								

QTY REQD	LEVEL	PART OR IDENTIFYING NO.	NOMENCLATURE OR DESCRIPTION	MATERIAL/SPECIFICATION OR VENDOR NAME	ITEM NO.
		AR 3	77124	LOCTITE NICKEL ANTI-SEIZE THREAD LUBRICANT	31
					30
		1	3	RF FLANGE, 2, SLIP ON, CLASS 150	F304H SST ASTM A182 29
		1	3	-28	LIGHT PORT PIPE, SEAMLESS TP304H SST ASTM A312 28
		12	3	WASHER, FLAT, 1/2	18-8 SST, ASME B18.22.1 27
		12	3	CAP SCREW, HEX HEAD 1/2-13 UNC X 3/4 LONG	18-8 SST, ASTM F593 26
		3	3	496471	DUMMY LOAD CELL VISHAY PRECISION GROUP 25
		3	3	471268	THERMAL INSULATION KIT VISHAY PRECISION GROUP 24
		3	3	473855	PRECISION LOAD CELL AND MOUNT VISHAY PRECISION GROUP 23
		1	3		END CAP, 1 1/2 SCH 40S, BW F304H SST, MSS-SP-43, ASTM A403 22
		2	3		WELDOLET, 2 CLASS 3000 FITTING F304H SST, MSS-SP-97, ASTM A182 21
		1	3		SOCKOLET, 1 CLASS 3000 FITTING F304H SST, MSS-SP-97, ASTM A182 20
		1	3		SOCKOLET, 3/4 CLASS 3000 FITTING F304H SST, MSS-SP-97, ASTM A182 19
		1	3		RF FLANGE, 1, SLIP ON, CLASS 150 F304H SST ASTM A182 18
		1	3	-17	SCALE SHEET 304/304L SST ASTM A240 17
		1	3	-16	1/2" OD TUBING, TYPE 316/316L SS .065" WALL THICKNESS SWAGelok MADE FROM SS-T8-S-065-20 16
		3	3	-15	LOAD CELL PLATE PLATE CS ASTM A36 15
		1	3	-14	LEVEL SWITCH PIPE PIPE, SEAMLESS TP304H SST ASTM A312 14
1	1	3	-13	BASE PLATE PLATE 304H SST ASTM A240 13	
1		3	-12	SUPPORT TUBE PIPE 304H SST ASTM A312 12	
1		3	-11	SUPPORT TUBE PIPE 304H SST ASTM A312 11	
1		3	-10	SADDLE PLATE 304H SST ASTM A240 10	
1		3	-9	HALF SADDLE PLATE 304H SST ASTM A240 9	
		1	3	-8	END CAP, 12, BW, SCH 40S 304H SST, MSS-SP-43, ASTM A403 8
		1	3		END CAP, 12, BW, SCH 40S 304H SST, MSS-SP-43, ASTM A403 7
		1	3	-6	VESSEL BODY PIPE, SEAMLESS TP304H SST ASTM A312 6
		1	3		RF FLANGE, 3, SLIP ON, CLASS 150 F304H SST ASTM A182 5
		1	3	-4	CAMERA PORT PIPE, SEAMLESS TP304H SST ASTM A312 4
		1	3	-3	SADDLE ASSEMBLY 3
		2	3	-2	HALF SADDLE ASSEMBLY 2
		3	-1	ASSEMBLY 1	

SIGNATURES/DATES APPLY TO CURRENT RELEASE ONLY		SIGN AND DATE	
DESIGN: NA			
DRAFTER: J. MONCUR	Jim Moncur CWI 2014.03.19 13:44:17 -0600		
TECHNICAL CHECK: NA			
ENG GROUP SUPERVISOR: NA			
DESIGN LEAD/AUTHORITY: D. MORGAN	David Morgan CWI 2014.03.20 08:36:30 -0600		
DRAFTING CHECK/EFFECTIVE DATE: K. KELLER	Kris Keller CWI 2014.03.20 09:50:49 -0600		
PROJECT NUMBER: 31720			
DRF NUMBER: 337562			

Idaho Cleanup Project				CHEM+WG IDAHO, LLC	
CPP-666					
RH-TRU DISTILLATION SYSTEM COLLECTION VESSEL ASSEMBLY VES-FC-85					
SIZE	INDEX CODE	NUMBER	DWG-	571699	REV
D	AREA	TYPE	CL	ORIG	4
200	0666	53	136		
SCALE: NOTED				SHEET 1 OF 4	

D

C

B

A

8

7

6

5


4

3



2

1


Date: 03/19/14 - 12:46 PM Layout Name: SHEET 1
 File: 571699-4.dwg
 Path: K:\RH-TRU Distillation\Drawings\DRF-341590

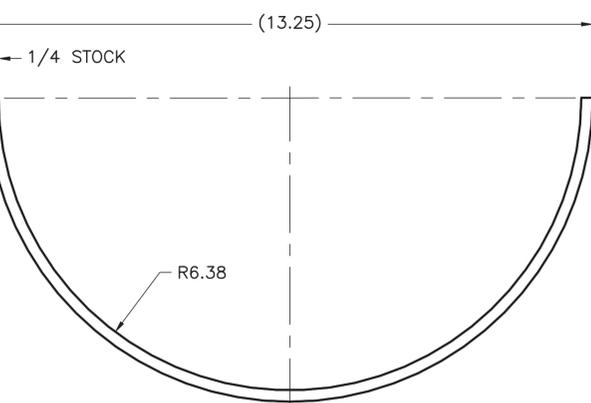


10 DETAIL
SCALE: 1/2

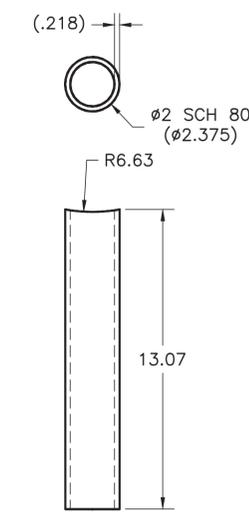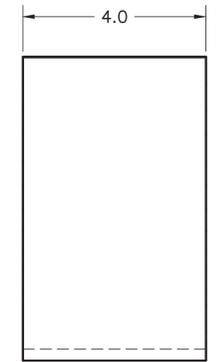


12 DETAIL
SCALE: 1/4

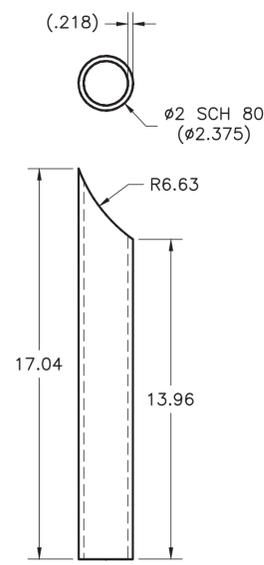



11 DETAIL
SCALE: 1/4

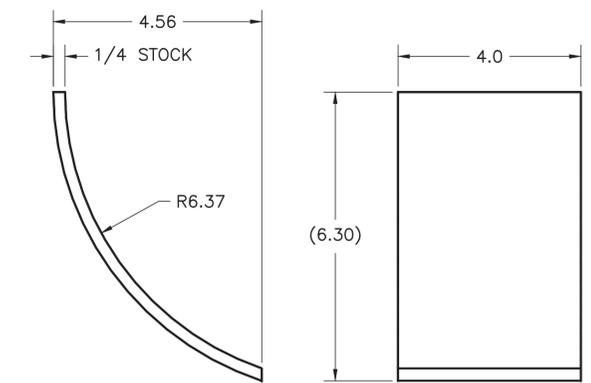


9 DETAIL
SCALE: 1/4

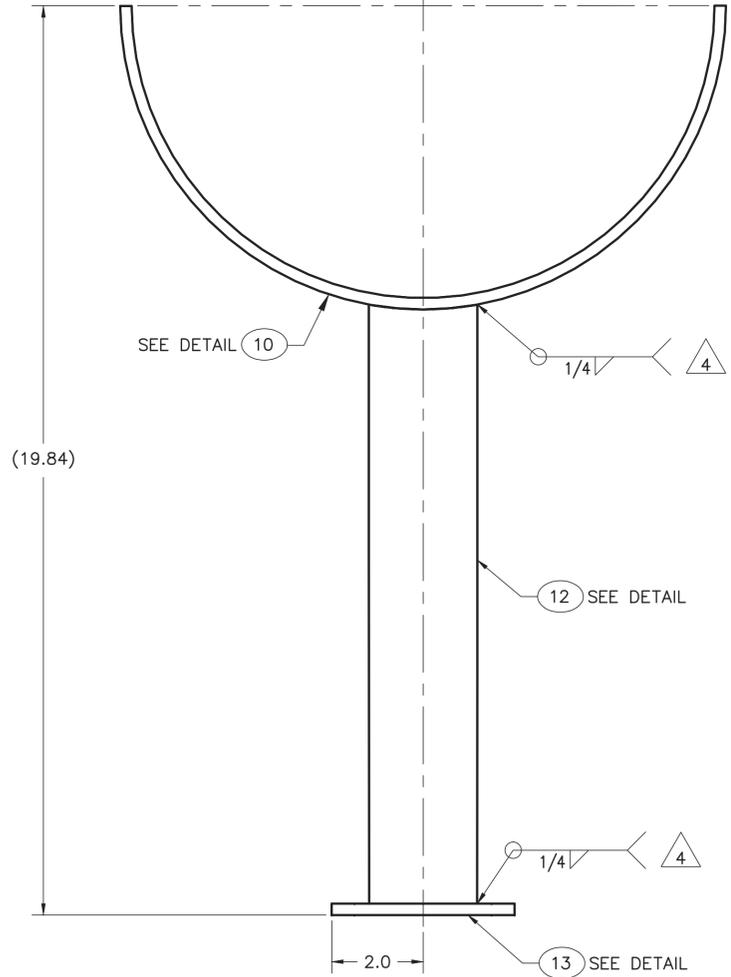

-3 ASSEMBLY
SCALE: 1/2

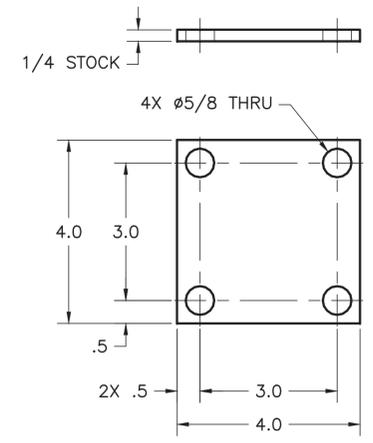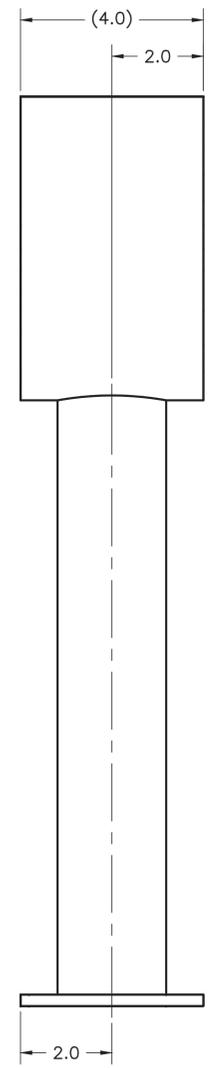


13 DETAIL
SCALE: 1/2

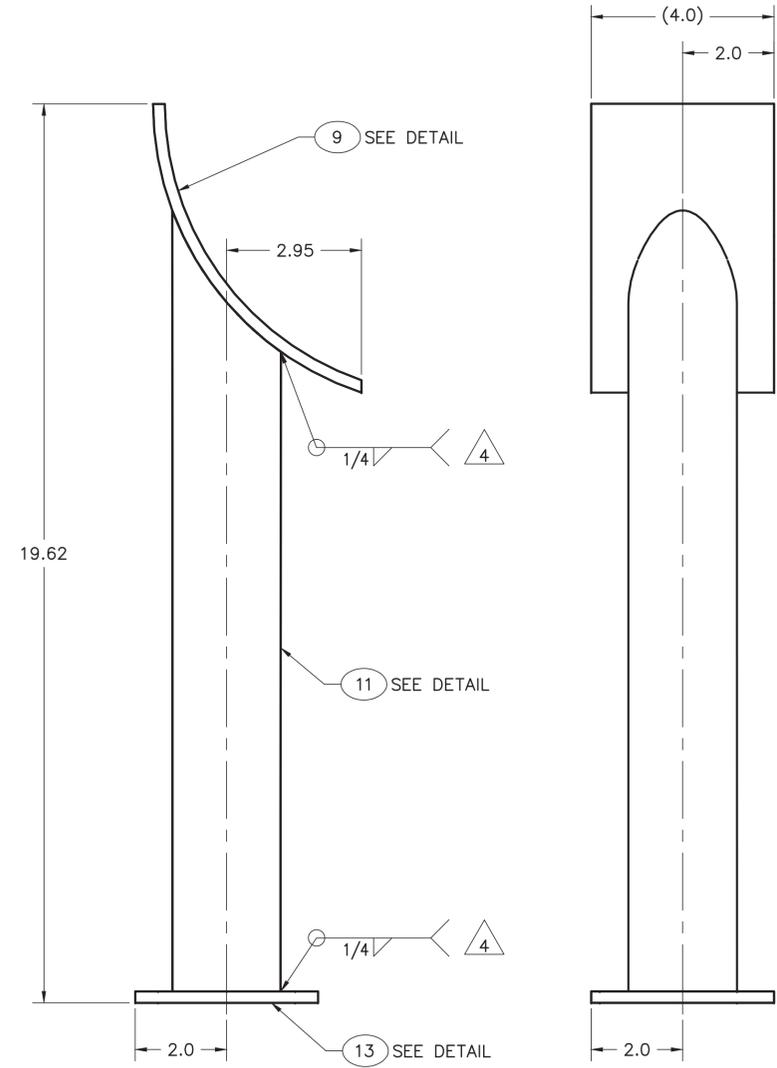


-2 ASSEMBLY
SCALE: 1/2

SIZE	INDEX CODE	NUMBER	DWG-	571699	REV	4
D	AREA	TYPE	CL	ORIG		
	200	0666	53	136		
SCALE: NOTED				SHEET	3	



Date: 03/19/14 - 12:46 PM | Layout Name: SHEET 3
 File: 571699-4.dwg
 Path: K:\RH-TRU Distillation\Drawings\DRF-341590

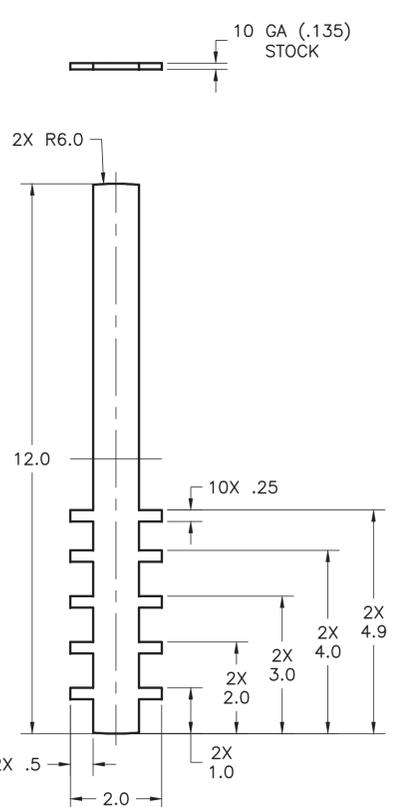



17 DETAIL
SCALE: 1/2

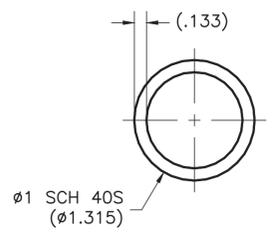



14 DETAIL
SCALE: 1/1

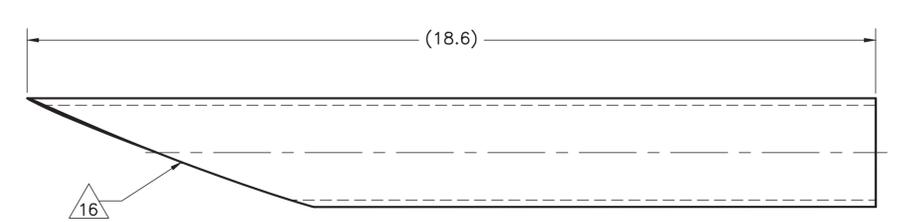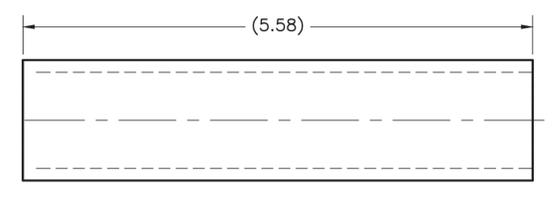



28 DETAIL
SCALE: 1/2

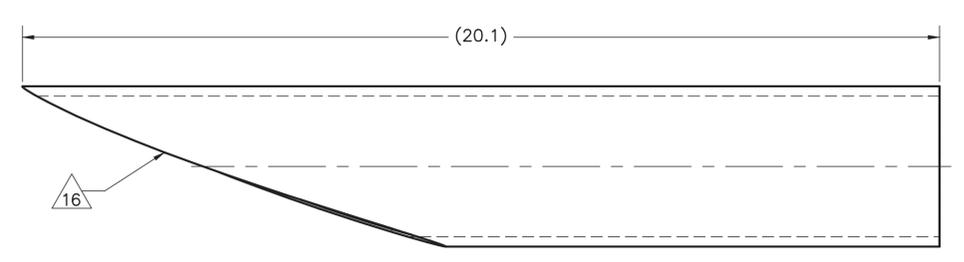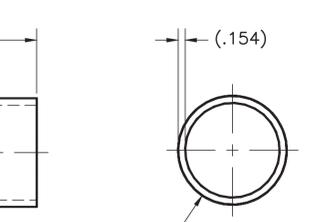


4 DETAIL
SCALE: 1/2

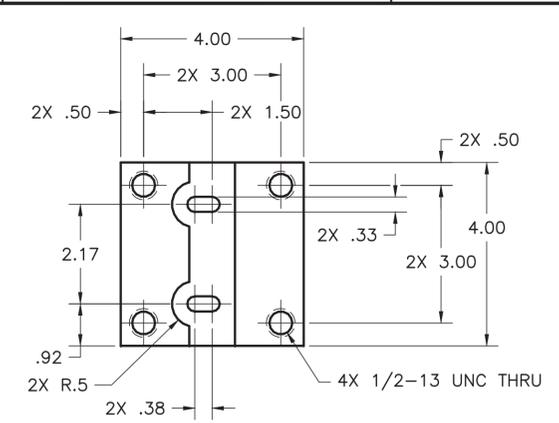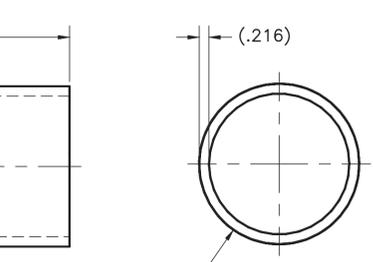




15 DETAIL
SCALE: 1/2

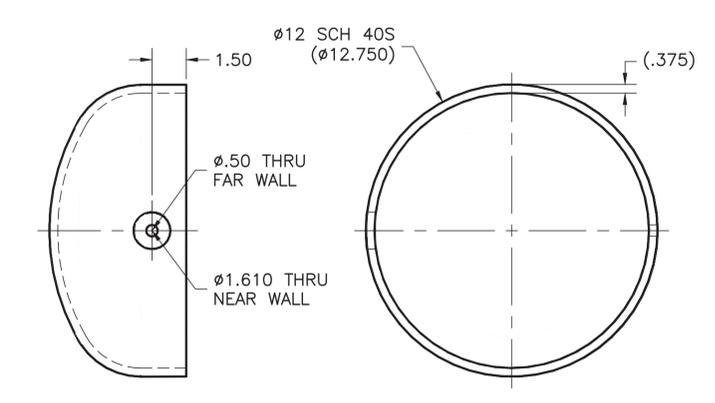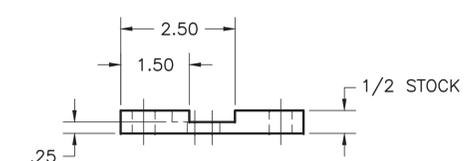


8 DETAIL
SCALE: 1/4

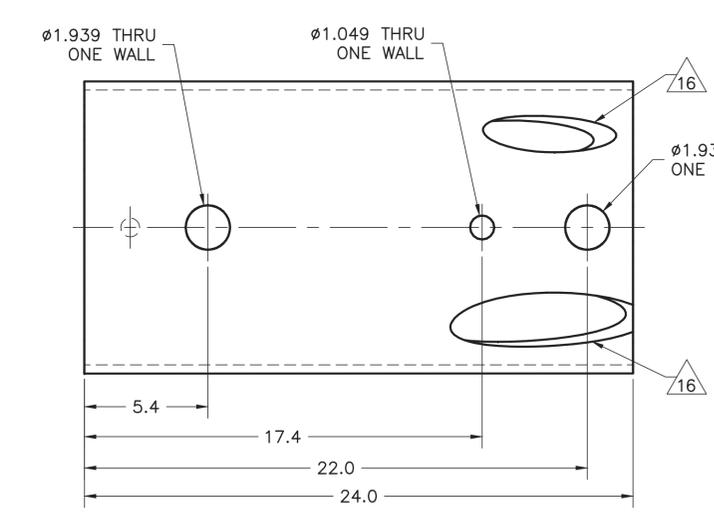

6 DETAIL
SCALE: 1/4

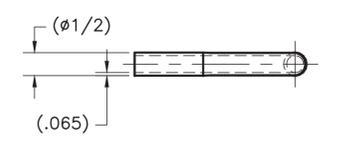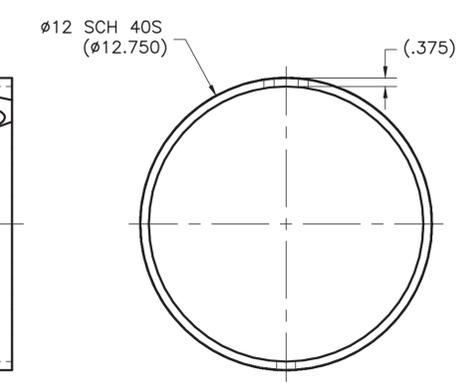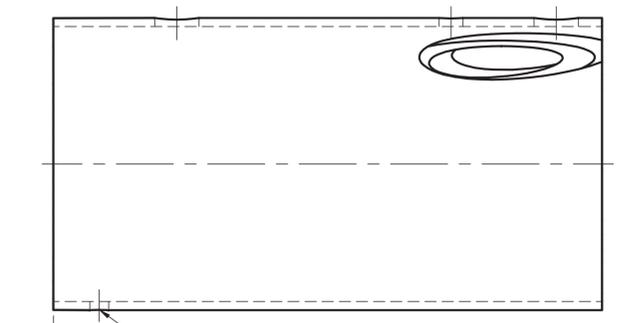

16 DETAIL
SCALE: 1/2

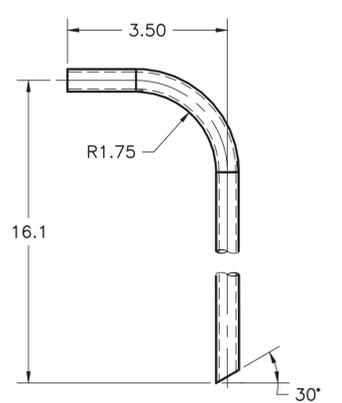


DATE	INDEX CODE NUMBER	REV
03/19/14		4
TIME	TYPE	CL
12:46 PM	0666	53
PROJECT	ORIG	
K:\RH-TRU Distillation\Drawings	571699	
DRF-341590		
SCALE: NOTED		SHEET 4

File: 571699-4.dwg
 Date: 03/19/14 - 12:46 PM
 Layout Name: SHEET 4
 Path: K:\RH-TRU Distillation\Drawings\DRF-341590

NOTES:

1. REMOVE ALL BURRS AND SHARP EDGES.
2. ALL MACHINED FILLET RADII .03 MAXIMUM UNLESS OTHERWISE NOTED.
3. USE THREAD LUBRICANT (ITEM 12) ON ALL BOLT THREADS.
4. FINAL ASSEMBLY SHALL BE FREE OF DIRT, CHIPS, WELDING FLUX, SLAG, SCALE, OIL, GREASE, ETC. PERFORM A VISUAL INSPECTION OF THE FINAL ASSEMBLY PER ASTM A380, PARA 7.2.1.
5. TORQUE BOLTS ON 4.5" O.D. CF FLANGES TO 15 (+2/-0) FT LB USING A STAR PATTERN.
6. COMPLETED ASSEMBLY SHALL UNDERGO A PNEUMATIC LEAK TEST IN ACCORDANCE WITH ASME B31.3 AT A PRESSURE OF 16.5 TO 18.5 PSIG. "SNOOP" ALL CONNECTIONS FOR LEAKS. PRESSURE DROP SHALL NOT EXCEED 0.1 PSIG OVER A 10 MINUTE PERIOD.
7. WELDING SHALL BE PERFORMED IN ACCORDANCE WITH ASME B31.3 USING ITEM 11.
8. VISUALLY INSPECT ALL WELDS IN ACCORDANCE WITH ASME B31.3, PARA. 344.4.1 (A) FOR NORMAL FLUID SERVICE. ACCEPTANCE CRITERIA SHALL BE PER ASME B31.3, PARA. 341.3.2
9. PERFORM IN-PROCESS INSPECTION OF WELDS WHERE SPECIFIED PER ASME B31.3, PARA. 344.7 USING LIQUID PENETRANT EXAMINATION OF THE ROOT AND FINAL PASS.
10. LIQUID PENETRANT EXAMINATION SHALL BE PERFORMED IN ACCORDANCE WITH THE BPV CODE SECTION V, ARTICLE 6. ACCEPTANCE CRITERIA SHALL BE:
 - A. ALL SURFACES TO BE EXAMINED SHALL BE FREE OF:
 - (1) RELEVANT LINEAR INDICATIONS
 - (2) RELEVANT ROUNDED INDICATIONS GREATER THAN 5 MM (.188")
 - (3) FOUR OR MORE RELEVANT ROUNDED INDICATIONS IN A LINE
 - B. SEPARATED BE 1.5 MM (.063") OR LESS, EDGE-TO-EDGE. CRACK LIKE INDICATIONS DETECTED, IRRESPECTIVE OF SURFACE CONDITIONS, ARE UNACCEPTABLE.
11. TOLERANCES ON DECIMALS
 - .XX = ± .06
 - .XXX = ± .005
12. DESIGN TEMPERATURE = 200° F.
13. DESIGN PRESSURE = FULL VACUUM TO 15 PSIG.

REVISIONS	
REV	DESCRIPTION
1	INCORPORATED FDC'S 8886, 8961, 9129 & 9415. SEE DRF-341131.
2	AS-BUILT AS OF 3/18/2014, SUBMITTAL TO THE STATE FOR RCRA PERMIT, SEE DRF-341590

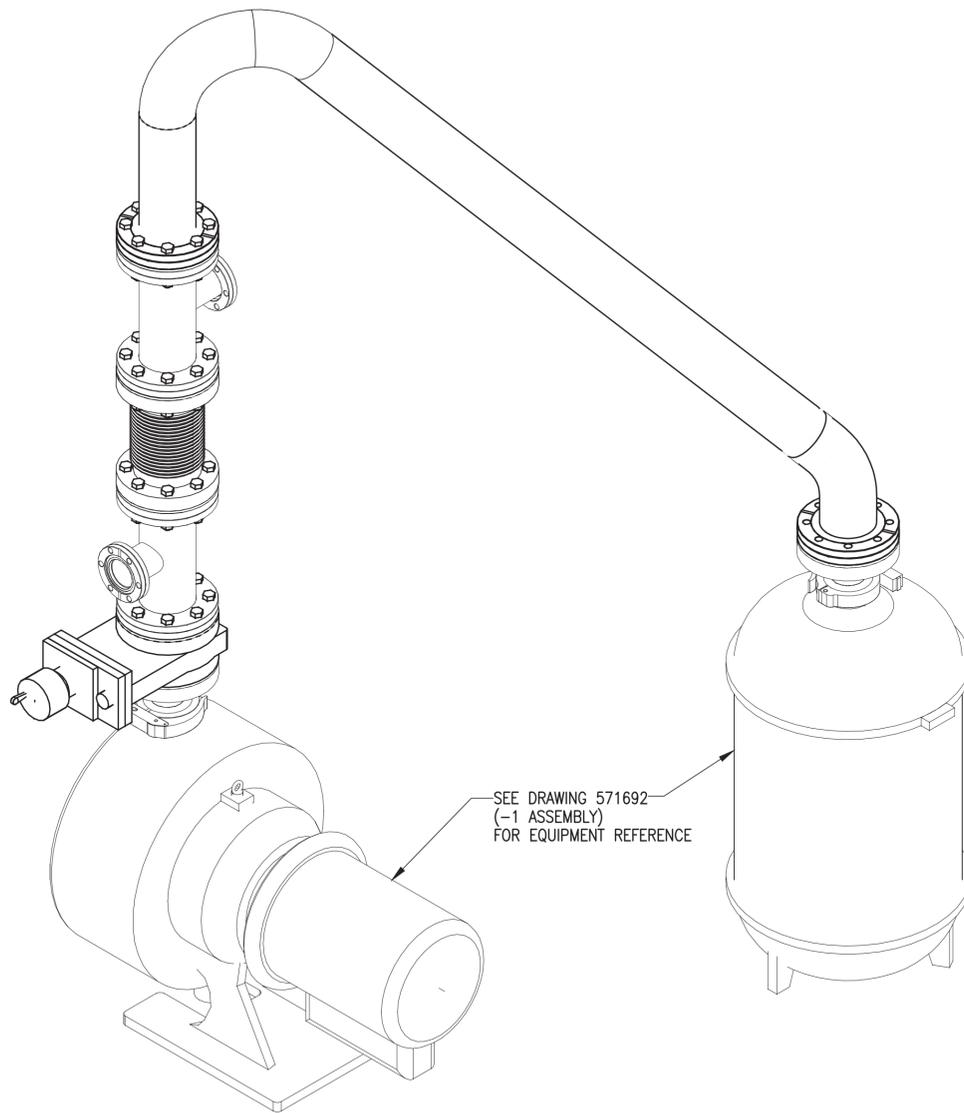

3D VIEW
(SHOWN FOR CLARITY)
SCALE: NONE

QTY REQD	LEVEL	PART OR IDENTIFYING NO.	NOMENCLATURE OR DESCRIPTION	MATERIAL/SPECIFICATION OR VENDOR NAME	ITEM NO.
8	3		M8 WASHER, HIGH STRENGTH	316 SS DIN EN ISO 7089	14
8	3		M8 X 35MM SCREW CLASS A4-80	316 SS DIN EN ISO 4017	13
AR	3	77124	NICKEL ANTI-SEIZE THREAD LUBRICANT	LOCTITE CORP.	12
AR	3		WELD FILLER METAL	ER 308H AWSA5.9	11
2	3	F0450X250R	4.5" CF FLANGE, TYPE 304H SS ROTATABLE, 2.5" TUBE	KURT J. LESKER CO.	10
1	3	100885030	BELLOWS SECTION, 4.5" CF FLANGE TYPE 321 STAINLESS STEEL	MKS INSTRUMENTS, INC	9
1	3	GVC 025 B65253000	PNEUMATIC GATE VALVE FOR VACUUM SERVICE WITH CF FLANGES, 4.5" OD	EDWARDS VACUUM	8
1	3	G-2WC-250	ELBOW, 90°, NO TANGENT 2.5" OD X .065" WALL THICKNESS	KURT J. LESKER CO.	7
1	3	G-2KL-250	ELBOW, 45°, WITH TANGENT 2.5" OD X .065" WALL THICKNESS	KURT J. LESKER CO.	6
1	3	G-2WK-250	ELBOW, 45°, NO TANGENT 2.5" OD X .065" WALL THICKNESS	KURT J. LESKER CO.	5
AR	3	SST-0250I	TUBING, STAINLESS STEEL 2.5" OD X .065" WALL THICKNESS	KURT J. LESKER CO.	4
2	3	T-0450-275	CF FLANGED REDUCING TEE 4.5" FLANGE X 2.75" FLANGE	KURT J. LESKER CO.	3
3	3	HBS31224200	BOLT & NUT SET 5/16-24 X 2" LONG	KURT J. LESKER CO.	2
4	3	GA-0450NSP	GASKET FOR 4.5" CF FLANGE SILVER PLATED COPPER	KURT J. LESKER CO.	1
	3	-0	ASSEMBLY		0

Randy Eastman
Professional Engineer
No. 4307
State of Idaho
Randy Eastman

I CERTIFY THAT THIS DRAWING REFLECTS THE CURRENT CONSTRUCTED CONDITION AS OF 3/18/2014

INSPECTION REQUIREMENTS	-0	571692
QC REQUIRED		NEXT ASSY
Q DENOTES Q/C INSP. REQD.		APPLICATION

DIMENSIONING AND SYMBOLY PER	ASME Y14.5-2009 AND STD-11 UNLESS OTHERWISE SPECIFIED
SURFACE ROUGHNESS 125/	
DIMENSIONS AND TOLERANCES	ARE IN INCHES
TOLERANCES:	X = ± .1
DECIMALS:	.XX = ± .06 .XXX = ± .005
FRACTIONS:	± 1/8
ANGULAR:	± 2'
DO NOT SCALE DRAWING	

SIGNATURES/DATES APPLY TO CURRENT RELEASE ONLY	SIGN AND DATE
DESIGN:	NA
DRAFTER:	J. MONCUR 2014.03.19 13:31:04 -0600
TECHNICAL CHECK:	NA
ENG GROUP SUPERVISOR:	NA
DESIGN LEAD/AUTHORITY:	David Morgan 2014.03.20 08:37:46 -0600
DRAFTING CHECK/EFFECTIVE DATE:	Kris Keller 2014.03.20 09:51:34 -0600
PROJECT NUMBER:	30062
DRF NUMBER:	337562

Idaho Cleanup Project

CPP-666

RH-TRU DISTILLATION SYSTEM


SPOOL PIECE 1

SIZE	AREA	TYPE	CL	ORIG	DWG-	571693	REV	2
D	200	0666	53	136				


SCALE: NONE

SHEET 1 OF 2

File: 571693-2.dwg
 Path: K:\RH-TRU Distillation\Drawings\DRF-341590
 Date: 03/19/14 - 11:42 AM
 Layout Name: 57169301
 ID: MXJ

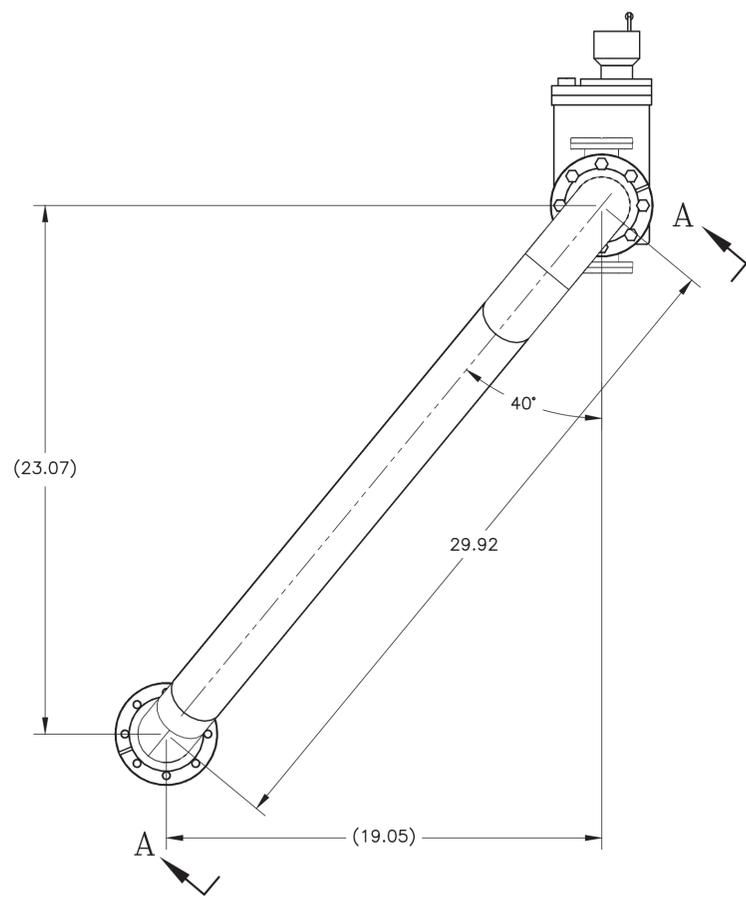

-0 ASSEMBLY
SCALE: 1/4

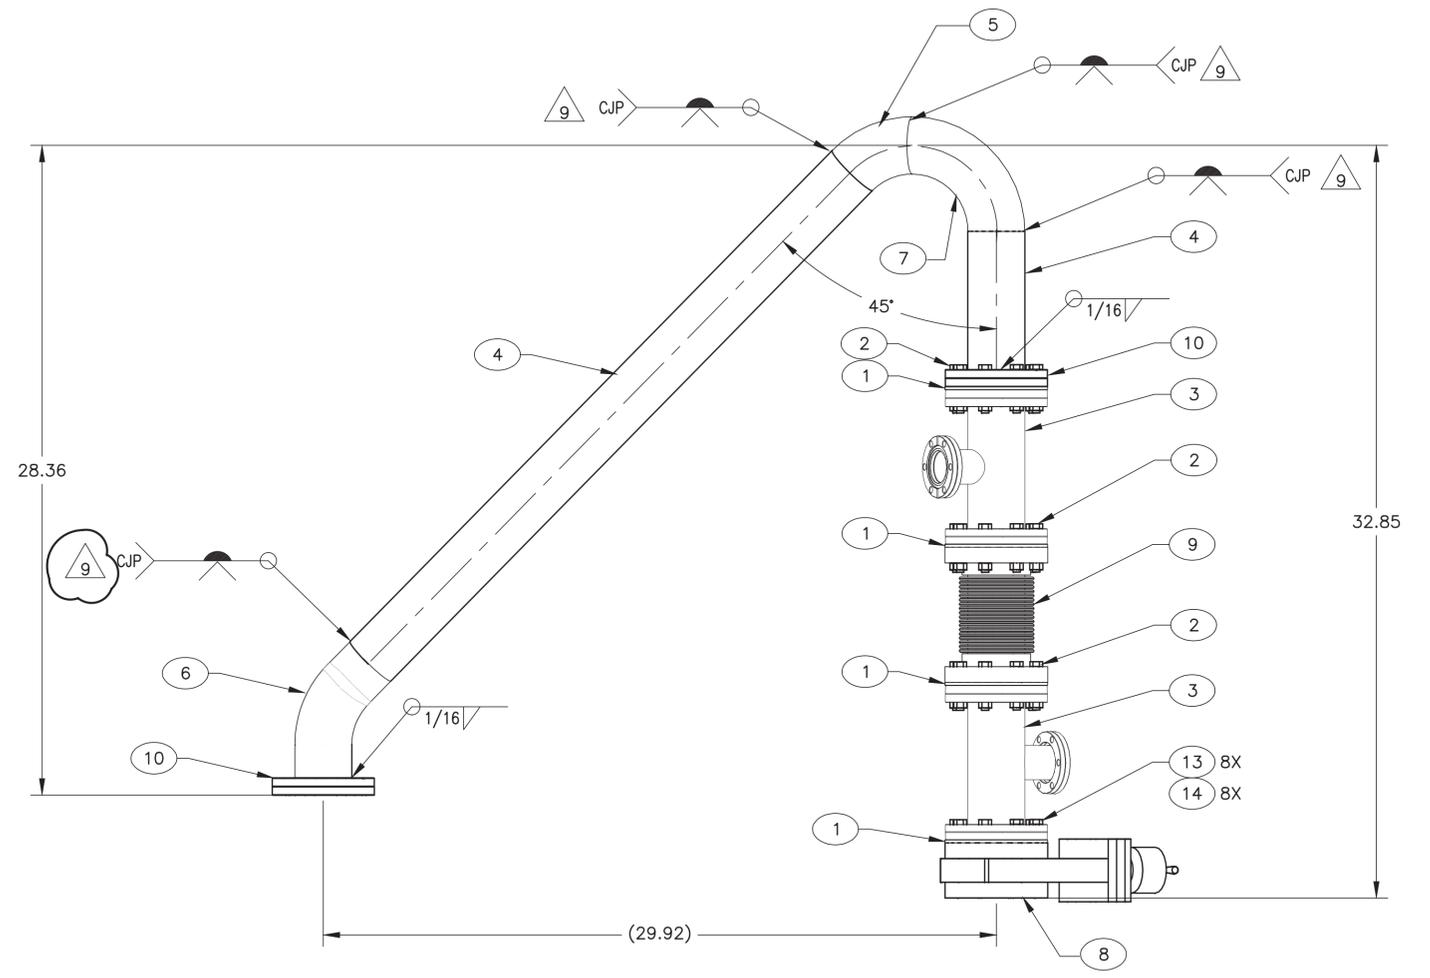

VIEW A-A
SCALE: 1/4


File: 571693-2.dwg
 Pat: K:\RH-TRU Distillation\Drawings\DRF-341390
 Date: 03/19/14 - 11:42 AM
 Layout Name: 57169302
 ID: MKJ

SIZE	INDEX CODE	NUMBER	REV
D	AREA	TYPE	BL
200	0666	53	136
SCALE: NOTED			DWG-
			571693
			2
SHEET			2

NOTES:

1. REMOVE ALL BURRS AND SHARP EDGES.
2. ALL MACHINED FILLET RADII .03 MAXIMUM UNLESS OTHERWISE NOTED.
3. USE THREAD LUBRICANT (ITEM 13) ON ALL BOLT THREADS.
4. FINAL ASSEMBLY SHALL BE FREE OF DIRT, CHIPS, WELDING FLUX, SLAG, SCALE, OIL, GREASE, ETC. PERFORM A VISUAL INSPECTION OF THE FINAL ASSEMBLY PER ASTM A380, PARA 7.2.1.
5. TORQUE BOLTS ON 4.5" O.D. CF FLANGES TO 15 (+2/-0) FT LB USING A STAR PATTERN.
6. COMPLETED ASSEMBLY SHALL UNDERGO A PNEUMATIC LEAK TEST IN ACCORDANCE WITH ASME B31.3 AT A PRESSURE OF 16.5 TO 18.5 PSIG. "SNOOP" ALL CONNECTIONS FOR LEAKS. PRESSURE DROP SHALL NOT EXCEED 0.1 PSIG OVER A 10 MINUTE PERIOD.
7. WELDING SHALL BE PERFORMED IN ACCORDANCE WITH ASME B31.3 USING ITEM 12.
8. VISUALLY INSPECT ALL WELDS IN ACCORDANCE WITH ASME B31.3, PARA. 344.4.1 (A) FOR NORMAL FLUID SERVICE. ACCEPTANCE CRITERIA SHALL BE PER ASME B31.3, PARA. 341.3.2
9. PERFORM IN-PROCESS INSPECTION OF WELDS WHERE SPECIFIED PER ASME B31.3, PARA. 344.7 USING LIQUID PENETRANT EXAMINATION OF THE ROOT AND FINAL PASS.
10. LIQUID PENETRANT EXAMINATION SHALL BE PERFORMED IN ACCORDANCE WITH THE BPV CODE SECTION V, ARTICLE 6. ACCEPTANCE CRITERIA SHALL BE:
 - A. ALL SURFACES TO BE EXAMINED SHALL BE FREE OF:
 - (1) RELEVANT LINEAR INDICATIONS
 - (2) RELEVANT ROUNDED INDICATIONS GREATER THAN 5 MM (.188")
 - (3) FOUR OR MORE RELEVANT ROUNDED INDICATIONS IN A LINE
 - B. SEPARATED BE 1.5 MM (.063") OR LESS, EDGE-TO-EDGE. CRACK LIKE INDICATIONS DETECTED, IRRESPECTIVE OF SURFACE CONDITIONS, ARE UNACCEPTABLE.
11. TOLERANCES ON DECIMALS
 - .XX = ± .06
 - .XXX = ± .005
12. PIPING DESIGN TEMPERATURE = 1000° F.
TUBING DESIGN TEMPERATURE = 300° F.
13. DESIGN PRESSURE = FULL VACUUM TO 15 PSIG.

REVISIONS	
REV	DESCRIPTION
1	INCORPORATED FDC'S 8886, 8897, 8961 & 9338. SEE DRF-341132.
2	AS-BUILT AS OF 3/18/2014, SUBMITTAL TO THE STATE FOR RCRA PERMIT, SEE DRF-341590

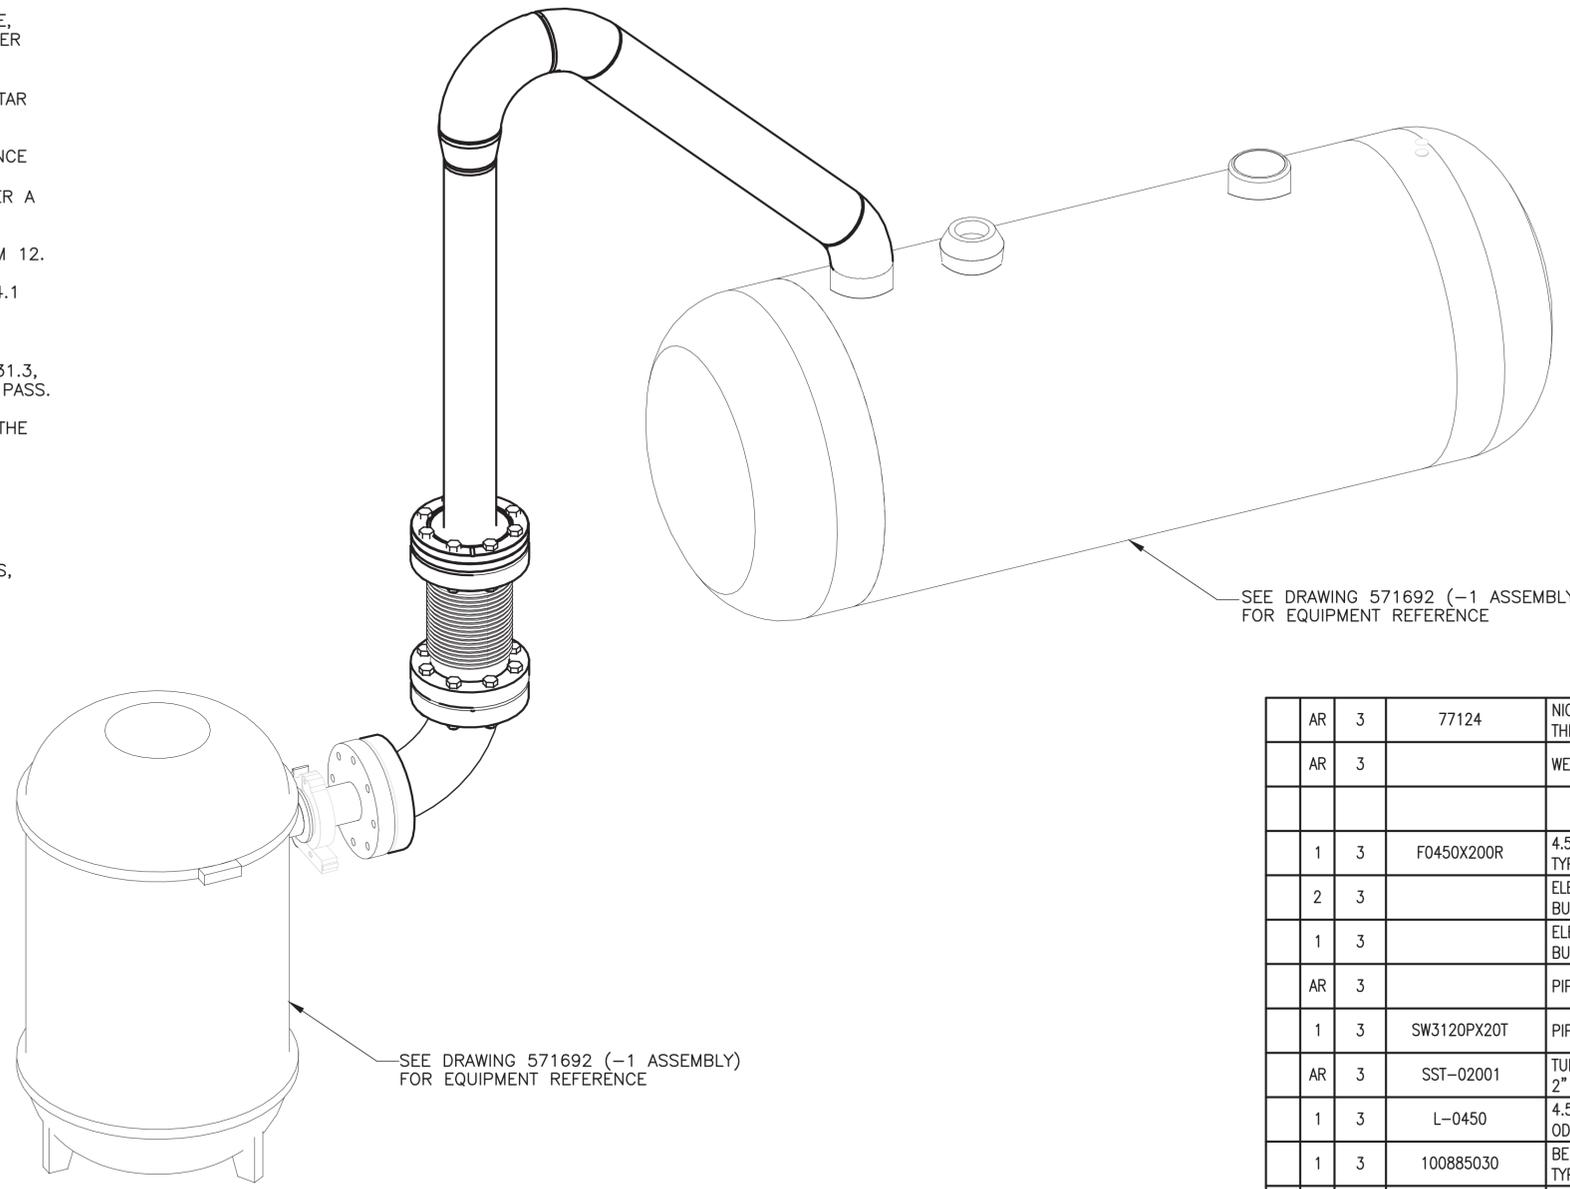

3D VIEW
(SHOWN FOR CLARITY)
SCALE: NONE

QTY REQD	AR	LEVEL	PART OR IDENTIFYING NO.	NOMENCLATURE OR DESCRIPTION	MATERIAL/SPECIFICATION OR VENDOR NAME	ITEM NO.
	AR	3	77124	NICKEL ANTI-SEIZE THREAD LUBRICANT	LOCTITE CORP.	13
	AR	3		WELD FILLER METAL	ER 308H AWSA5.9	12
						11
1	3		F0450X200R	4.5" CF FLANGE, ROTABLE, 2" TUBE TYPE 304L STAINLESS STEEL	KURT J. LESKER CO.	10
2	3			ELBOW, 2", 45', SCHED 40, SR BUTT WELD FITTING	TYPE 304H SST ASTM A403	9
1	3			ELBOW, 2", 90', SCHED 40, SR BUTT WELD FITTING	TYPE 304H SST ASTM A403	8
	AR	3		PIPE, 2", SCHED 40, SEAMLESS	TYPE 304H SST, ASTM A 312	7
1	3		SW3120PX20T	PIPE TO TUBING ADAPTER, BUTT WELD	CENTRAL STATES INDUSTRIAL EQUIPMENT CO.	6
	AR	3	SST-02001	TUBING, TYPE 304L, SS 2" OD X .065" WALL THICKNESS	KURT J. LESKER CO.	5
1	3		L-0450	4.5" CF FLANGED ELBOW, 90°, 2.5" OD X .065" WALL THICKNESS	KURT J. LESKER CO.	4
1	3		100885030	BELLOWS SECTION, 4.5" CF FLANGE TYPE 321 STAINLESS STEEL	MKS INSTRUMENTS, INC.	3
2	3		HBS31224200	BOLT & NUT SET 5/16-24 X 2" LONG	KURT J. LESKER CO.	2
2	3		GA-0450NSP	GASKET FOR 4.5" CF FLANGE SILVER PLATED COPPER	KURT J. LESKER CO.	1
		3	-0	ASSEMBLY		0
	-0	QUAL				

Randy Eastman
CWI
2014.03.19.13:33:34 -0600

I CERTIFY THAT THIS DRAWING REFLECTS THE CURRENT CONSTRUCTED CONDITION AS OF 3/18/2014

INSPECTION REQUIREMENTS		DASH NO.	NEXT ASSY	APPLICATION
QC REQUIRED		-0	571692	
Q DENOTES Q/C INSP. REQD.				

SIGNATURES/DATES APPLY TO CURRENT RELEASE ONLY

DESIGN:	NA	SIGN AND DATE:	
DRAFTER:	J. MONCUR	2014.03.19.13:33:34 -0600	
TECHNICAL CHECK:	NA		
ENG GROUP SUPERVISOR:	NA		
DESIGN LEAD/AUTHORITY:	D. MORGAN	2014.03.20.08:37:30 -0600	
DRAFTING CHECK/EFFECTIVE DATE:	K. KELLER	2014.03.20.09:51:22 -0600	



PROJECT NUMBER: 31720
DRF NUMBER: 337562

Idaho Cleanup Project CHEM-WG
CPP-666
RH-TRU DISTILLATION SYSTEM
SPOOL PIECE 2

SIZE	AREA	TYPE	BL	ORIG	DWG-	571694	REV	2
D	200	0666	53	136				

SCALE: NONE SHEET 1 OF 2

File: 571694-2.dwg
 Pat: K:\RH-TRU Distillation\Drawings\DRF-341590
 Date: 03/19/14 - 11:46 AM
 Layout Name: 57169401
 ID: MKJ

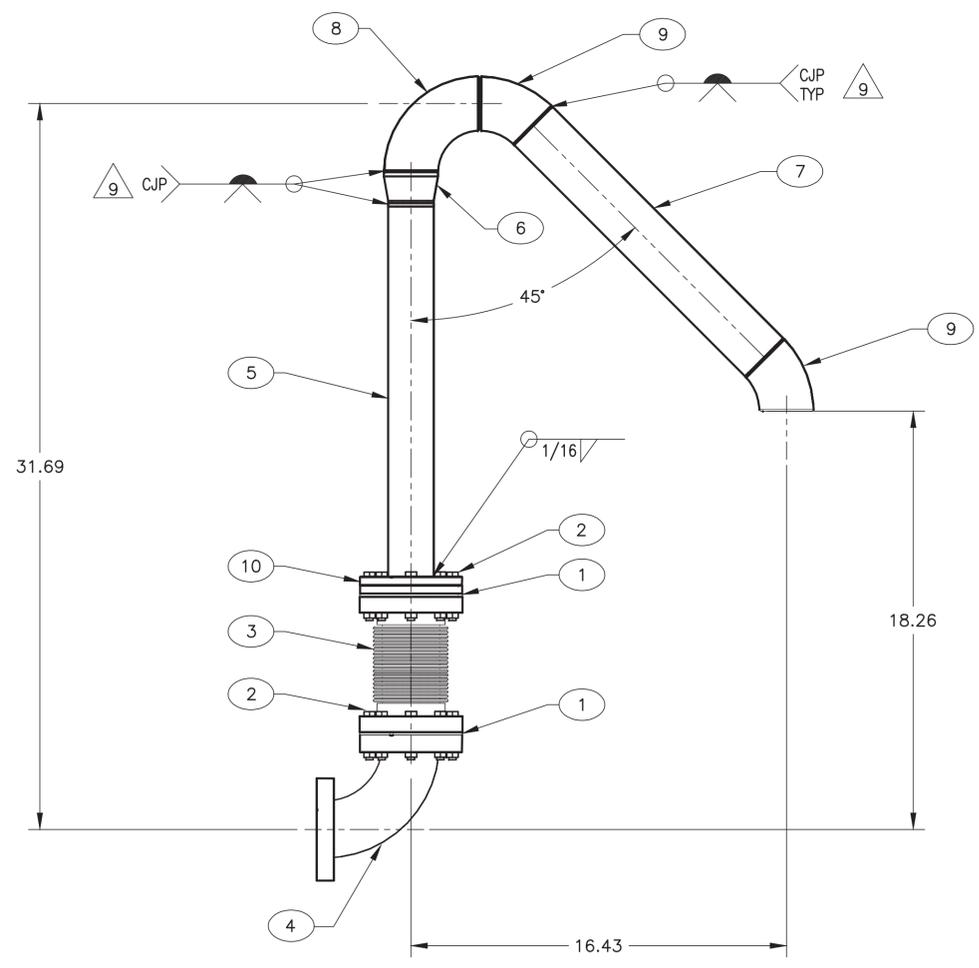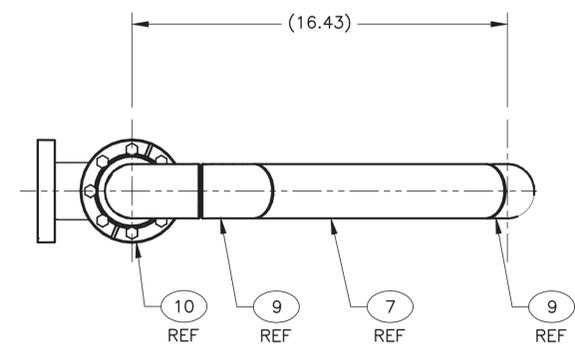


-0 ASSEMBLY
SCALE: 1/4

File: 571694-2.dwg
 Date: 03/19/14 - 11:46 AM
 Layout Name: 57169402
 Path: K:\RH-TRU Distillation\Drawings\DRF-341390

SIZE	AREA	TYPE	DL	ORIG	DWG-	REV
D	200	0666	53	136	571694	2
SCALE: NOTED						SHEET 2

NOTES:


- 1. REMOVE ALL BURRS AND SHARP EDGES.
- 2. ALL MACHINED FILLET RADII .03 MAXIMUM UNLESS OTHERWISE NOTED.
- 3. FINAL ASSEMBLY SHALL MEET CLEANLINESS REQUIREMENTS OF STD-7022, LEVEL C.
- 4. REMOVED
- 5. COMPLETED ASSEMBLY SHALL UNDERGO A PNEUMATIC LEAK TEST IN ACCORDANCE WITH TPR-4976 "LEAK TEST PROCEDURE", APPENDIX A "BUBBLE TEST-DIRECT PRESSURE TECHNIQUE". USE AIR OR INERT GAS AT A PRESSURE OF 3 PSIG, +0/-0.1 PSIG.
- 6. WELDING SHALL BE PERFORMED IN ACCORDANCE WITH INL WELD S2.0 USING WELD FILLER METAL, ITEM 7, FOR 304H STAINLESS STEEL FITTINGS AND PIPE OR WELD FILLER METAL. CHARPY IMPACT REQUIREMENTS WILL NOT BE IMPOSED.
- 7. VISUALLY INSPECT ALL WELDS IN ACCORDANCE WITH TPR-4981, 'VISUAL EXAMINATION' FOR NORMAL FLUID SERVICE. ACCEPTANCE CRITERIA SHALL BE PER APPENDIX A "VISUAL ACCEPTANCE CRITERIA FOR ASME B31.3 WELDS, BASE MATERIALS AND BRAZING" AS SHOWN IN TABLE A-1.
- 8. PERFORM IN-PROCESS EXAMINATION PER TPR-4981 AND ASME B31.3, PARAGRAPH 344.7.1.
- 9. LIQUID PENETRANT EXAMINATION SHALL BE PERFORMED ON ALL WELDS IN ACCORDANCE WITH TPR-4975 "LIQUID PENETRANT EXAMINATION", APPENDIX B WITH ACCEPTANCE PER APPENDIX J, ACCEPTANCE CRITERIA FOR ASME B31.3 WELDS, NORMAL FLUID SERVICE. USE LIQUID PENETRANT EXAMINATION OF ROOT AND FINAL PASS FOR BUTT WELDS AND THE FINAL PASS FOR FILLET WELDS.
- 10. TOLERANCES ON DECIMALS
.XX = ± .06
.XXX = ± .005
- 11. DESIGN TEMPERATURE = 1000' F.
- 12. DESIGN PRESSURE = FULL VACUUM TO 3 PSIG.

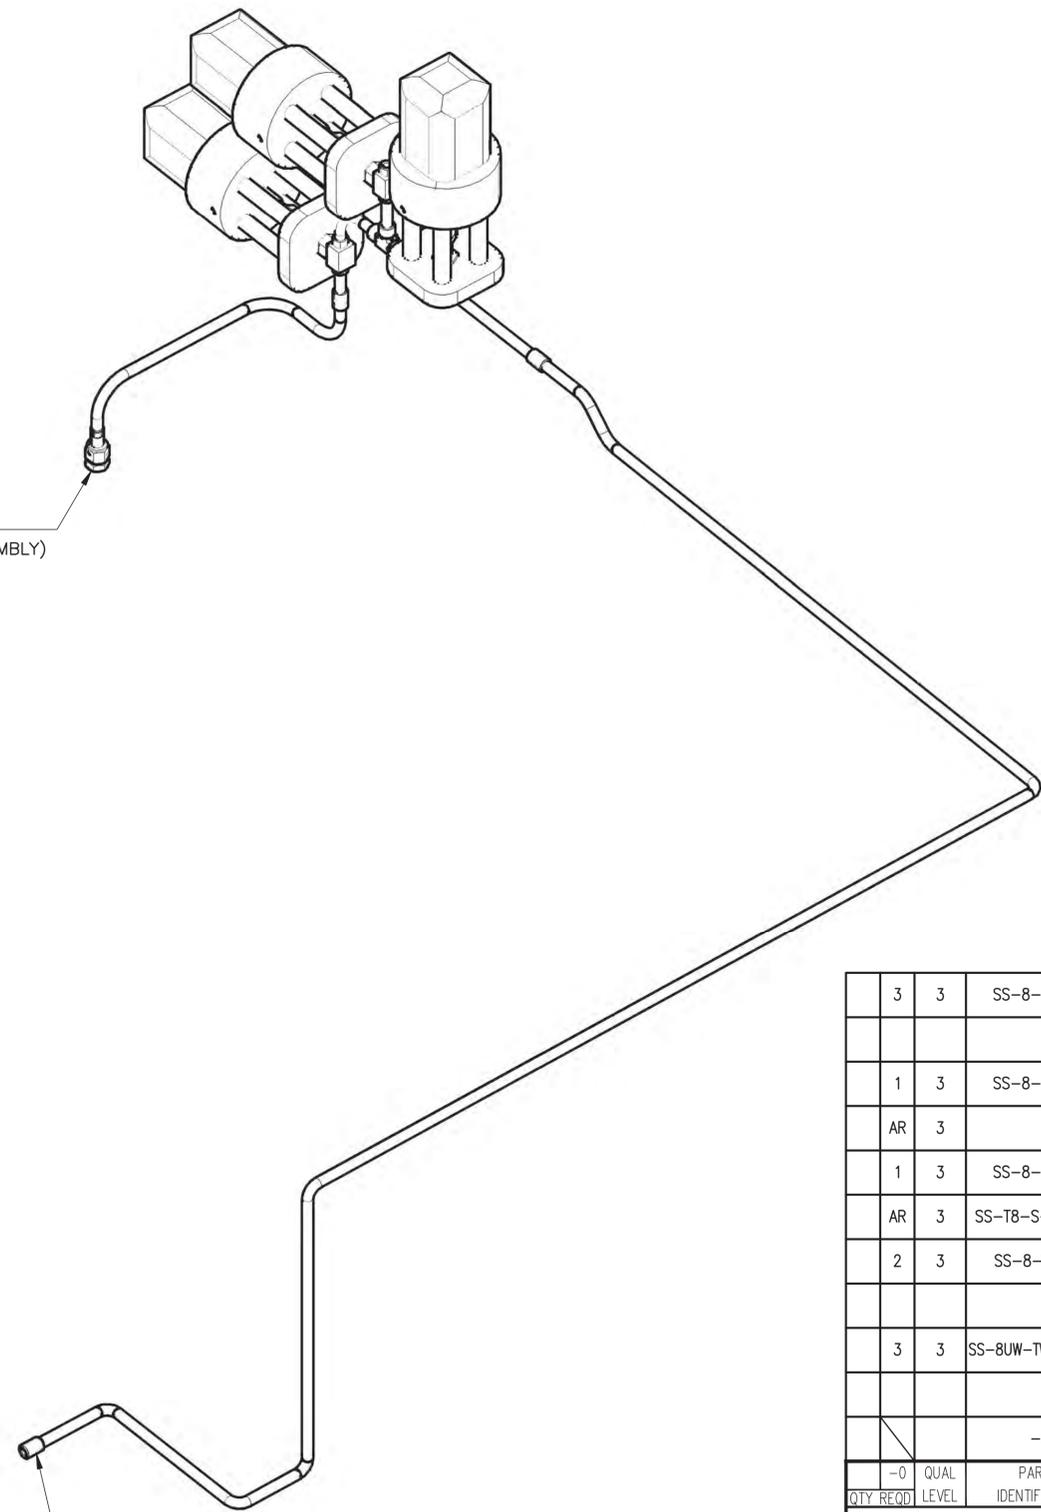

REVISIONS	
REV	DESCRIPTION
1	INCORPORATED FDC-8784, 8883, 8887, 8937, 8961, AND 8974, SEE DRF-339588
2	AS-BUILT AS OF 3/18/2014, ADDED SHEETS 3 & 4, SUBMITTAL TO STATE FOR RCRA PERMIT SEE DRF-341589

QTY REQD	LEVEL	PART OR IDENTIFYING NO.	NOMENCLATURE OR DESCRIPTION	MATERIAL/SPECIFICATION OR VENDOR NAME	ITEM NO.
3	3	SS-8-TSW-6	1/2" TUE SOCKET WELD UNION, TYPE 316 SS	SWAGELOK	10
1	3	SS-8-VCR-3	SOCKET WELD GLAND, TYPE 316 SS 1/2" VCR X 1/2" TUBE	SWAGELOK	8
AR	3		WELD FILLER METAL	ER 308 OR 308L AWSA5.9	7
1	3	SS-8-TSW-3	TUBE SOCKET WELD TEE, TYPE 316 SS 1/2" X 1/2" X 1/2"	SWAGELOK	6
AR	3	SS-T8-S-065-20	1/2" OD TUBING, TYPE 316 SS .065" WALL THICKNESS	SWAGELOK	5
2	3	SS-8-VCR-1	1/2" VCR FEMALE NUT TYPE 316 STAINLESS STEEL	SWAGELOK	4
					3
3	3	SS-8UW-TW-HT-6CM	BELLOWS, SEALED VALVE, 1/2" TUBE SOCKET WELD CONNECTIONS	SWAGELOCK	2
					1
		-0	ASSEMBLY		0

3D VIEW
(SHOWN FOR CLARITY)
SCALE: NONE

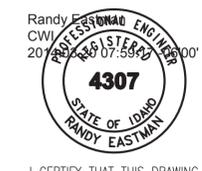

I CERTIFY THAT THIS DRAWING REFLECTS THE CURRENT CONSTRUCTED CONDITION AS OF 3/18/2014

INSPECTION REQUIREMENTS	-0	571692
QC REQUIRED		
Q DENOTES Q/C INSP. REQD.		

DIMENSIONING AND SYMBOLY PER ASME Y14.5-2009 AND STD-11 UNLESS OTHERWISE SPECIFIED SURFACE ROUGHNESS 125/ DIMENSIONS AND TOLERANCES ARE IN INCHES TOLERANCES: X = ± .1 DECIMALS: .XX = ± .06 .XXX = ± .005 FRACTIONS: ± 1/8 ANGULAR: ± 2'	DASH NO.	571692	NEXT ASSY	
DO NOT SCALE DRAWING	APPLICATION			

Idaho Cleanup Project

CPP-666

RH-TRU DISTILLATION SYSTEM

SPOOL PIECE 3

SIZE	AREA	TYPE	CL	ORIG	DWG-	571695	REV	2
D	200	0666	53	136				

SCALE: NONE

SHEET 1 OF 4

Date: 03/19/14 10:20 AM
 Layout Name: SHEET 1
 File: 571695-2.dwg
 Path: K:\RH-TRU Distillation\Drawings\DRF-341589

D

D

C


C

B

B

A


A

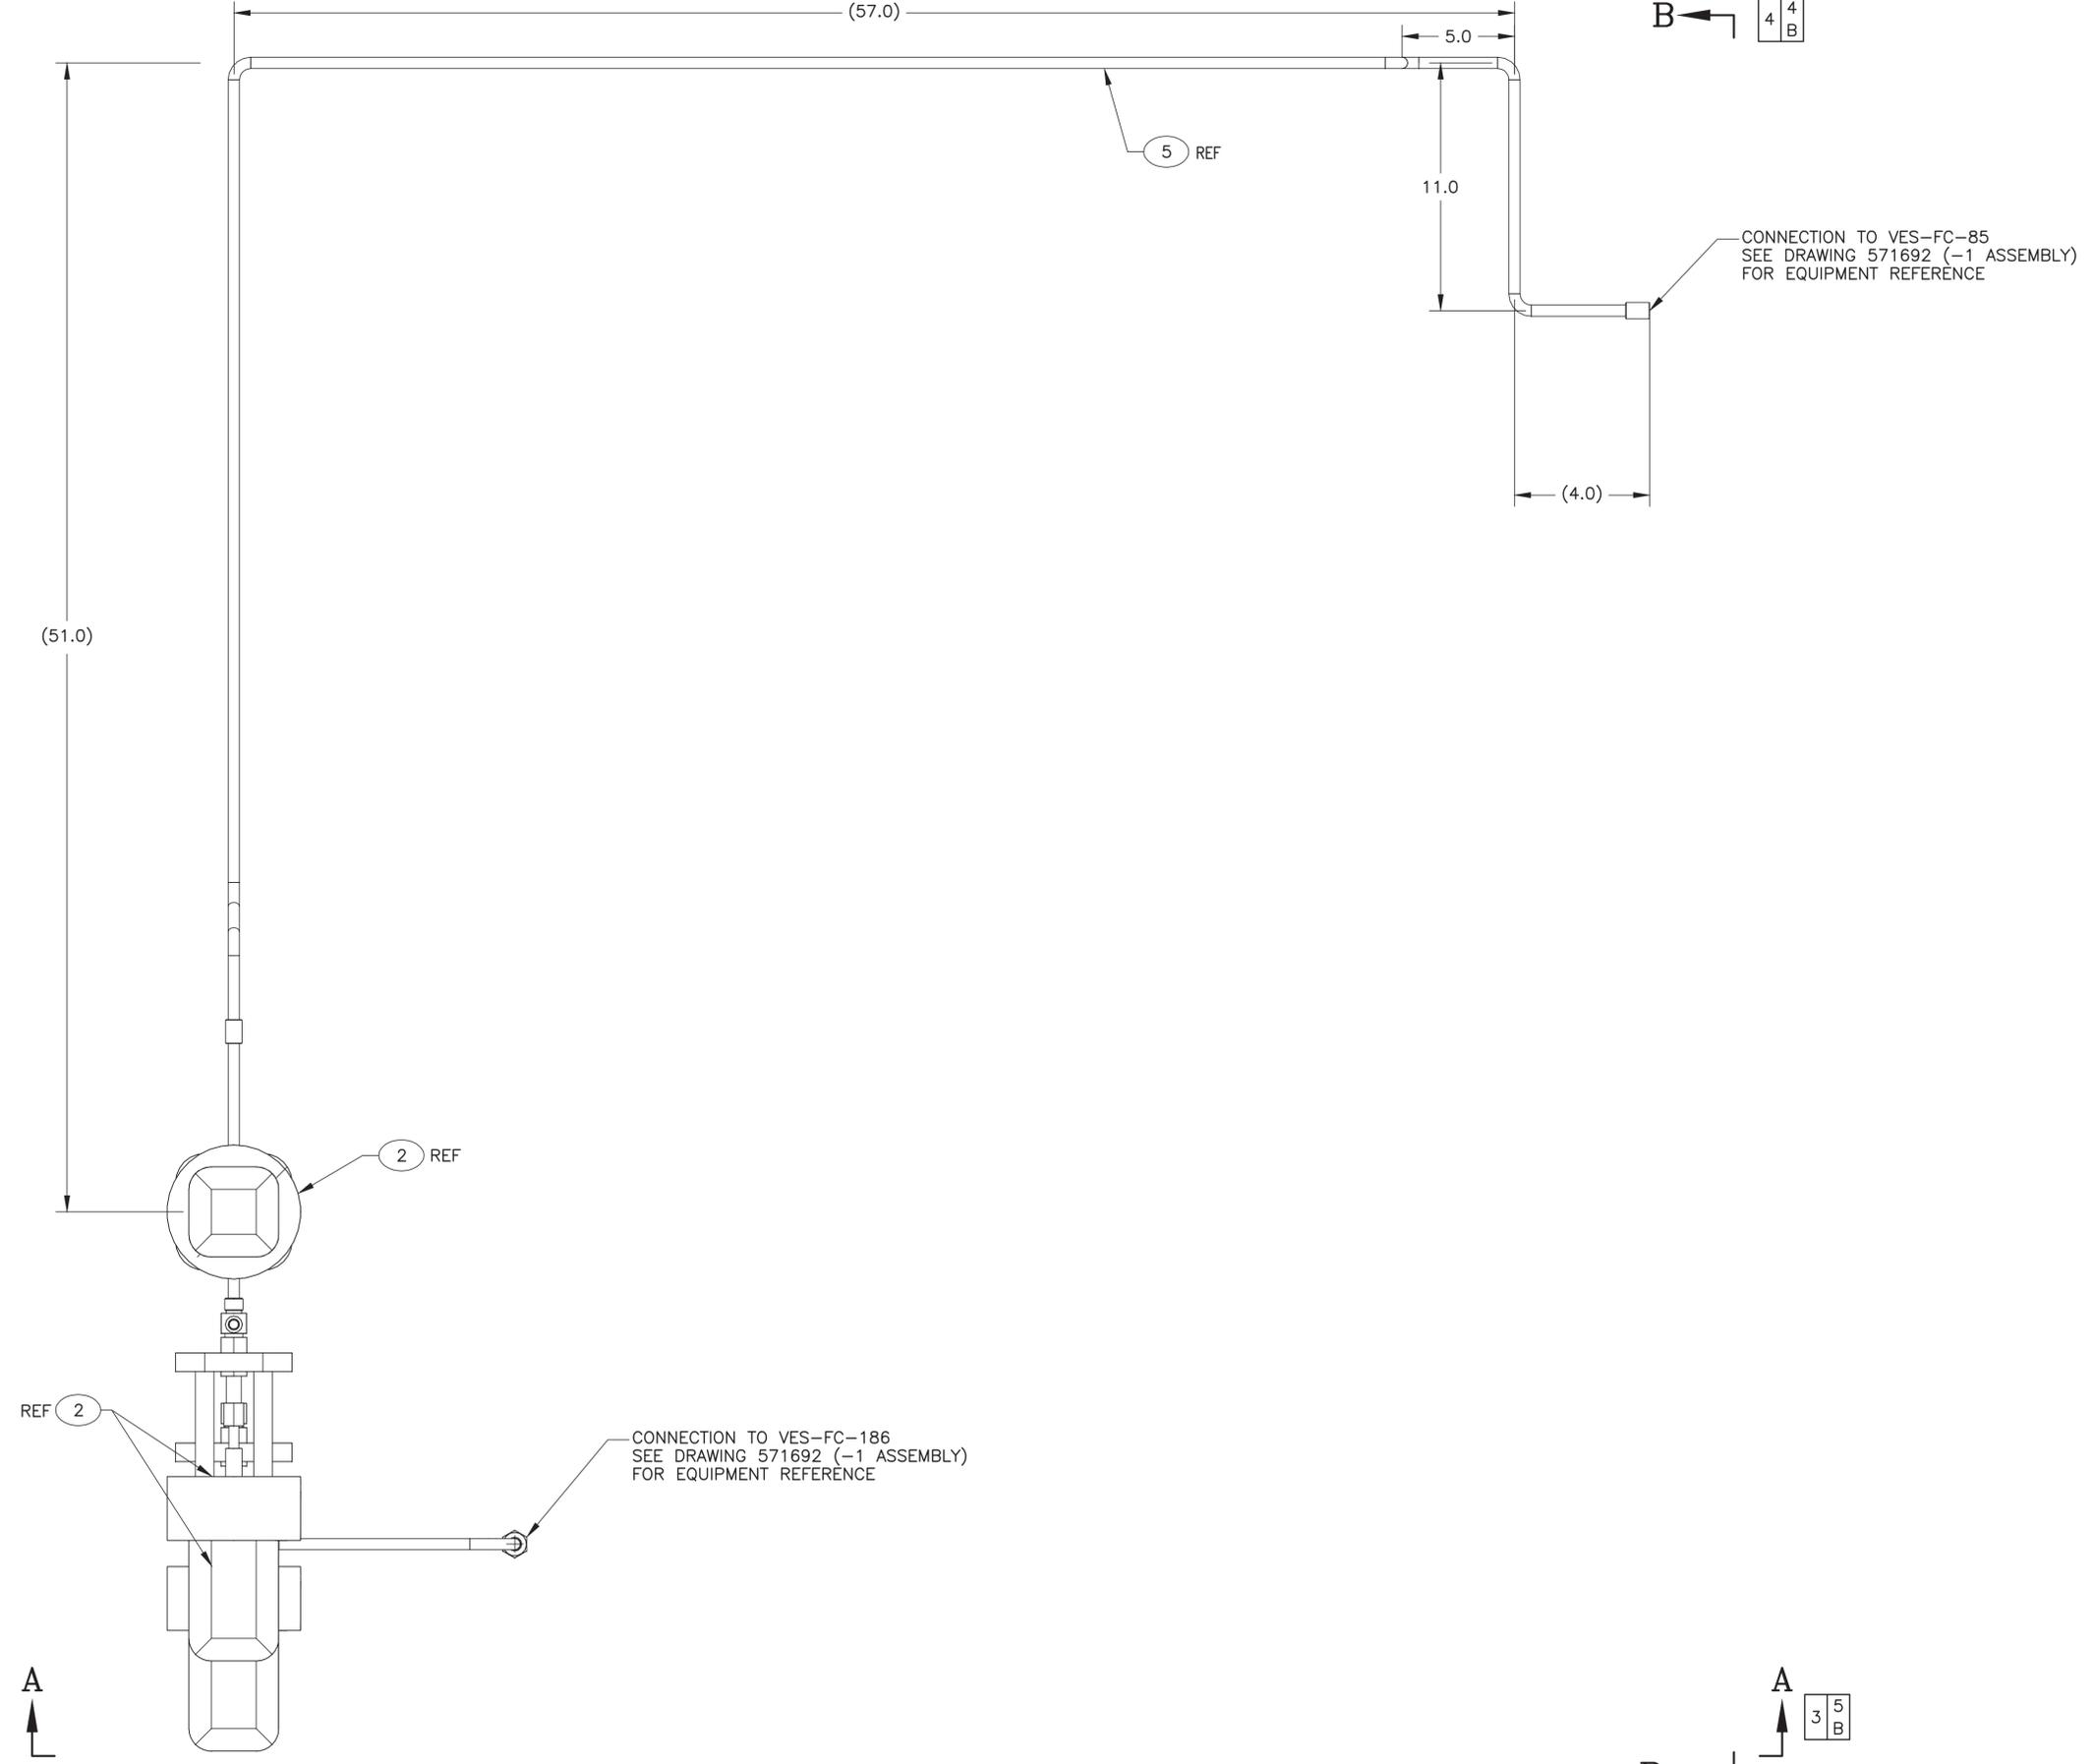

-0 ASSEMBLY
SCALE: 1/4

SIZE	CAGE CODE	INDEX CODE NUMBER			DWG-	571695	REV
D	01MF3	AREA	TYPE	CL	ORIG		2
SCALE: NOTED		200	0666	53	136	SHEET	2


File: 571695-2.dwg
 Date: 03/19/14 - 10:20 AM
 Layout Name: SHEET 2
 Pat: K:\RH-TRU Distillation\Drawings\DRF-341369

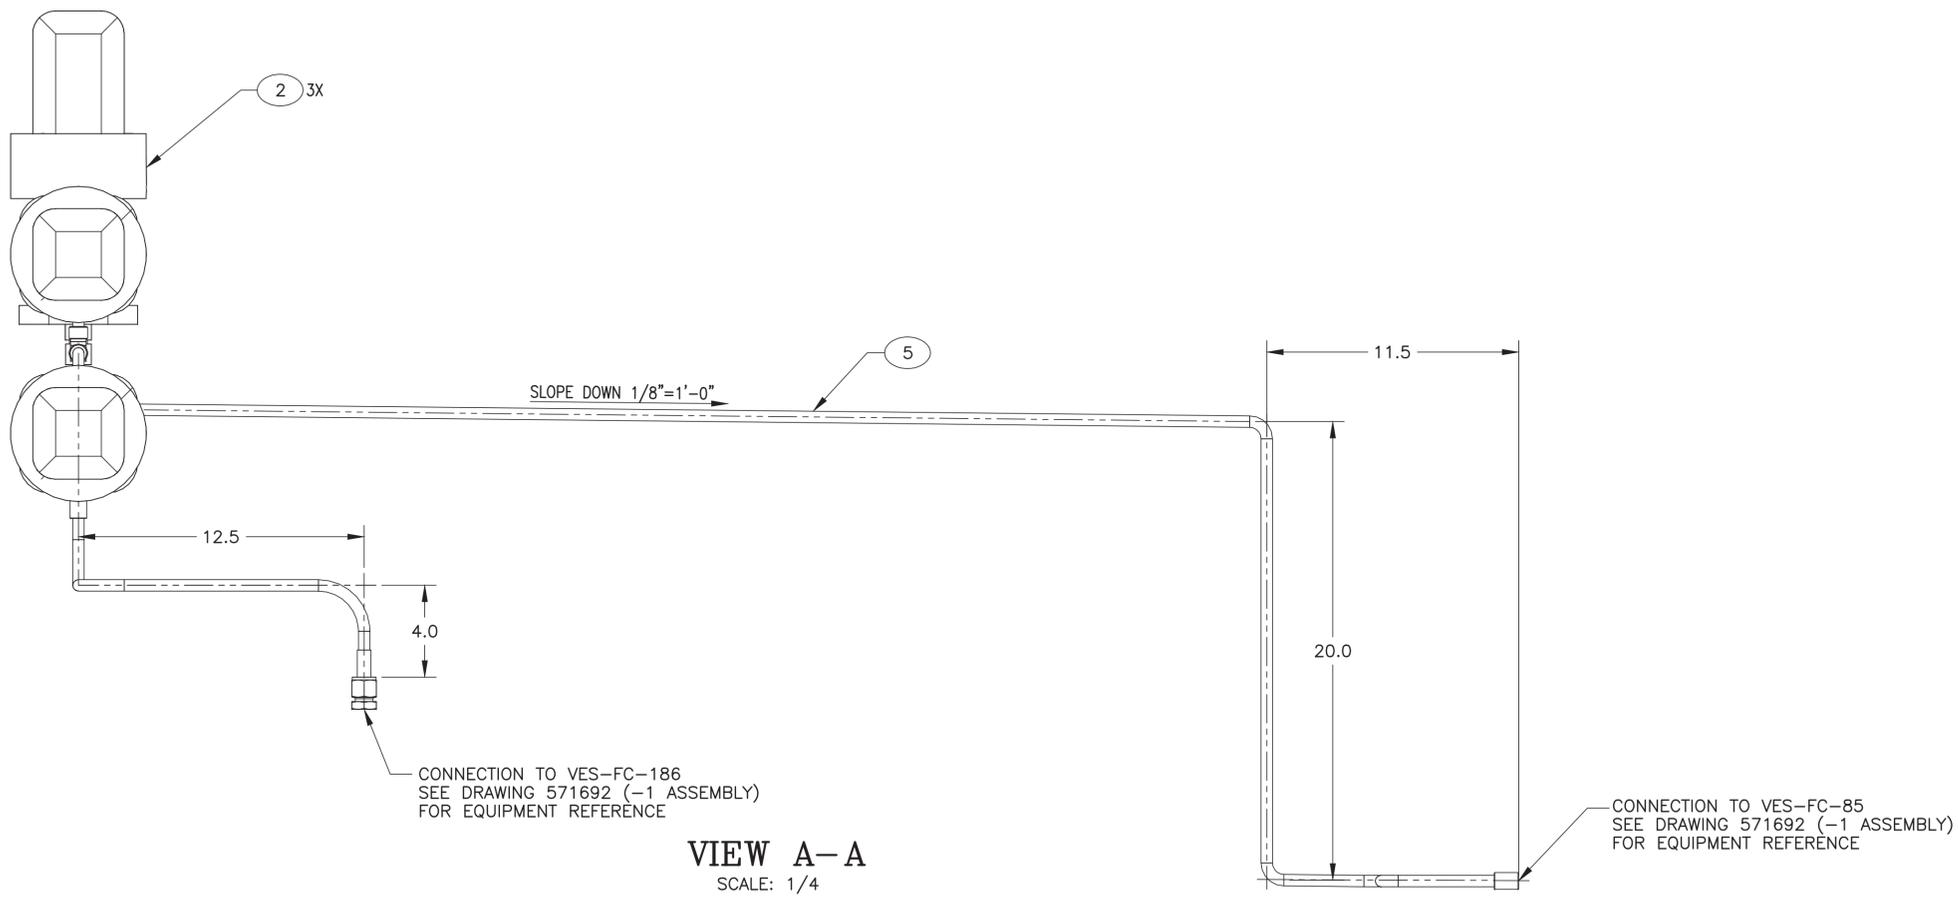

VIEW A-A
SCALE: 1/4

File: 571695-2.dwg
 Pat: K:\RH-TRU Distillation\Drawings\DRF-341589
 Date: 03/19/14 - 10:20 AM
 Layout Name: SHEET 3
 ID: MXJ

SIZE	CAGE CODE	INDEX CODE NUMBER			DWG-571695	REV
D	01MF3	AREA	TYPE	CL	ORIG	2
		200	0666	53	136	
SCALE: NOTED					SHEET	3

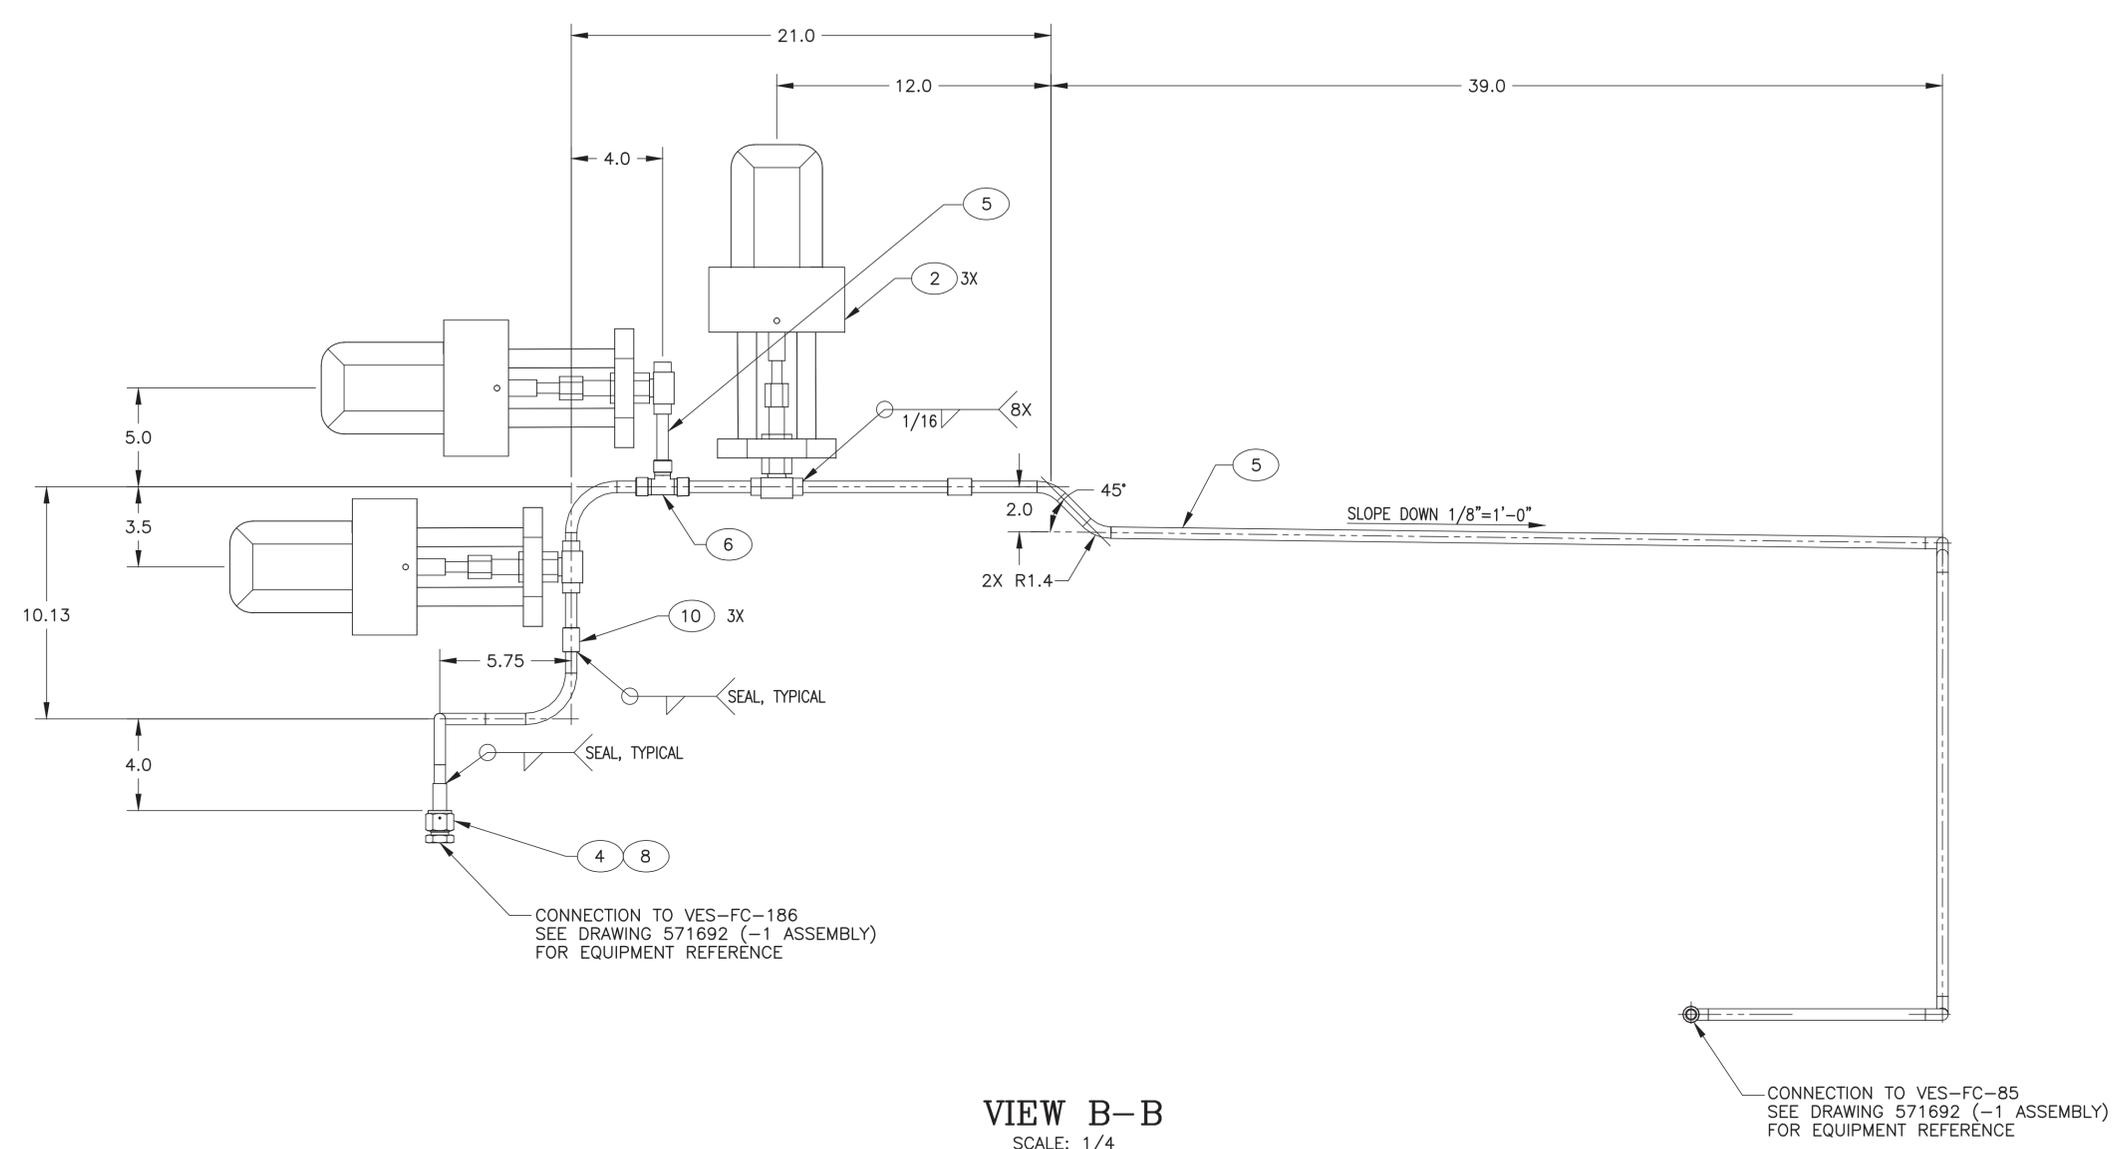

VIEW B-B
SCALE: 1/4

CONNECTION TO VES-FC-85
SEE DRAWING 571692 (-1 ASSEMBLY)
FOR EQUIPMENT REFERENCE

CONNECTION TO VES-FC-186
SEE DRAWING 571692 (-1 ASSEMBLY)
FOR EQUIPMENT REFERENCE


File: 571695-2.dwg
Date: 03/19/14 - 10:20 AM
Layout Name: SHEET 4
Pat: K:\RH-TRU Distillation\Drawings\DRF-341369

SIZE	CAGE CODE	INDEX CODE NUMBER			DWG-	571695	REV
D	01MF3	AREA	TYPE	CL	ORIG		2
		200	0666	53	136		
SCALE: NOTED						SHEET	4

NOTES:

- 1. REMOVE ALL BURRS AND SHARP EDGES.
- 2. ALL MACHINED FILLET RADII .03 MAXIMUM UNLESS OTHERWISE NOTED.
- 3. FINAL ASSEMBLY SHALL BE FREE OF DIRT, CHIPS, WELDING FLUX, SLAG, SCALE, OIL, GREASE, ETC. PERFORM A VISUAL INSPECTION OF THE FINAL ASSEMBLY PER ASTM A380, PARA 7.2.1.
- 4. COMPLETED ASSEMBLY SHALL UNDERGO A PNEUMATIC LEAK TEST IN ACCORDANCE WITH ASME B31.3 AT A PRESSURE OF 16.5 TO 18.5 PSIG. "SNOOP" ALL CONNECTIONS FOR LEAKS. PRESSURE DROP SHALL NOT EXCEED 0.1 PSIG OVER A 10 MINUTE PERIOD.
- 5. WELDING SHALL BE PERFORMED IN ACCORDANCE WITH ASME B31.3 USING ITEM 4.
- 6. VISUALLY INSPECT ALL WELDS IN ACCORDANCE WITH ASME B31.3, PARA. 341.4.1 (A) FOR NORMAL FLUID SERVICE. ACCEPTANCE CRITERIA SHALL BE PER ASME B31.3, PARA. 341.3.2
- 7. PERFORM IN-PROCESS INSPECTION OF WELDS WHERE SPECIFIED PER ASME B31.3, PARA. 344.7 USING LIQUID PENETRANT EXAMINATION OF THE ROOT AND FINAL PASS.
- 8. LIQUID PENETRANT EXAMINATION SHALL BE PERFORMED IN ACCORDANCE WITH THE BPV CODE SECTION V, ARTICLE 6. ACCEPTANCE CRITERIA SHALL BE:
 - A. ALL SURFACES TO BE EXAMINED SHALL BE FREE OF:
 - (1) RELEVANT LINEAR INDICATIONS
 - (2) RELEVANT ROUNDED INDICATIONS GREATER THAN 5 MM (3/16")
 - (3) FOUR OR MORE RELEVANT ROUNDED INDICATIONS IN A LINE
 - B. SEPARATED BY 1.5 MM (1/16") OR LESS, EDGE-TO-EDGE. CRACK LIKE INDICATIONS DETECTED, IRRESPECTIVE OF SURFACE CONDITIONS, ARE UNACCEPTABLE.
- 9. TOLERANCES ON DECIMALS
 - .XX = ± .06
 - .XXX = ± .005
- 10. DESIGN TEMPERATURE = 800° F.
- 11. DESIGN PRESSURE = FULL VACUUM TO 15 PSIG.
- 12. REMOVED.
- 13. REMOVED.

REVISIONS	
REV	DESCRIPTION
1	INCORPORATED FDC-8784, 8961, 9109, 9196, 9338, 9369 AND 9402 SEE DRF-340403
2	INCORPORATED FDC-9528. SEE DRF-341257.
3	AS-BUILT AS OF 3/18/2014, SUBMITTAL TO STATE FOR RCRA PERMIT, SEE DRF-341590

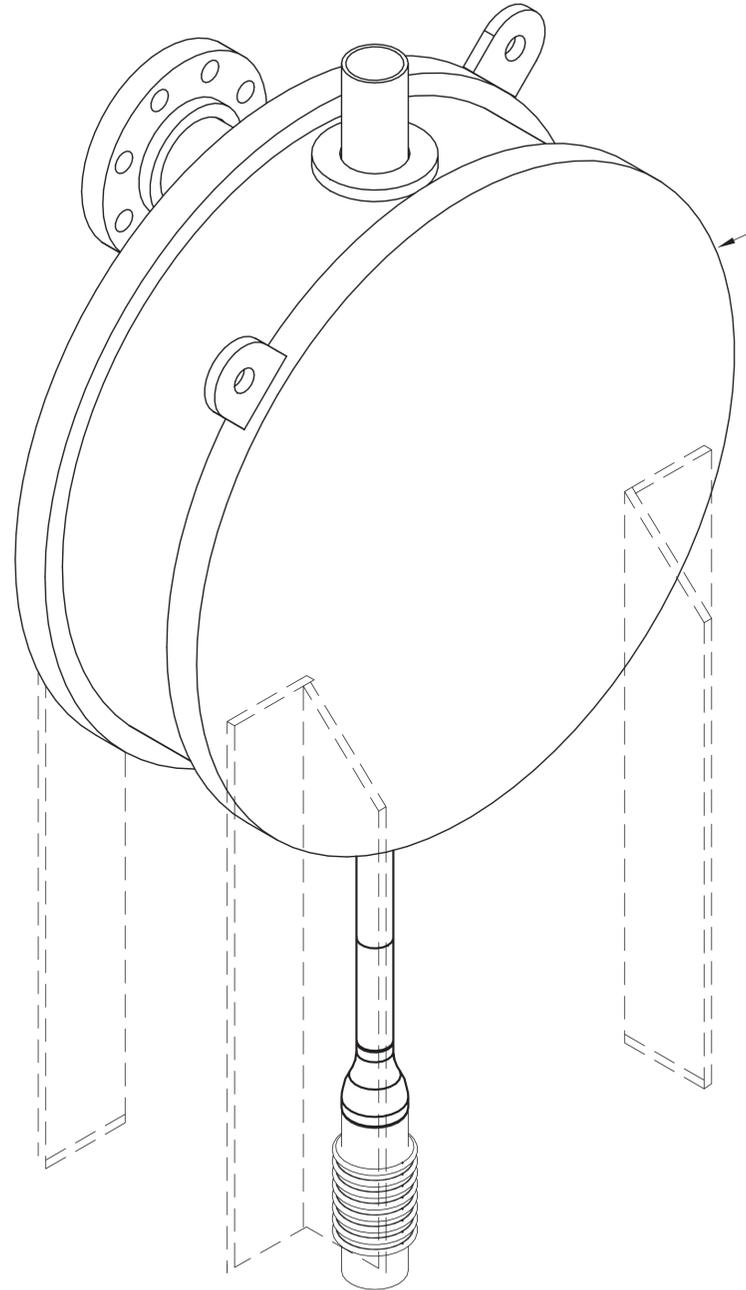

SEE DRAWING 571692 (-1 ASSEMBLY) FOR EQUIPMENT REFERENCE

3D VIEW
(SHOWN FOR CLARITY)
SCALE: NONE



I CERTIFY THAT THIS DRAWING REFLECTS THE CURRENT CONSTRUCTED CONDITION AS OF 3/18/2014

INSPECTION REQUIREMENTS	-0	571692
QC REQUIRED	DASH NO.	NEXT ASSY
Q DENOTES Q/C INSP. REQD.	APPLICATION	

QTY REQD	QUAL LEVEL	PART OR IDENTIFYING NO.	NOMENCLATURE OR DESCRIPTION	MATERIAL/SPECIFICATION OR VENDOR NAME	ITEM NO.
1	3		PIPE, 1" SCHED 40S, SEAMLESS	304H SST ASTM A312	15
			REMOVED		14
			REMOVED		13
			REMOVED		12
			REMOVED		11
					10
					9
					8
					7
			REMOVED		6
					5
5	AR	3	WELD FILLER METAL	ER 308H AWSA5.9	4
1	3		REDUCER, 2" X 1", BUTT WELD SCHED 40	304H SST, ASTM A403	3
					2
1	3	US-2-12-85L	BELLOWS EXPANSION JOINT, 2" X WELDED ENDS, SST, ASTM A240-T321	U. S. BELLOWS	1
					0
					0

DIMENSIONING AND SYMBOLY PER ASME Y14.5-2009 AND STD-11 UNLESS OTHERWISE SPECIFIED SURFACE ROUGHNESS 125/ DIMENSIONS AND TOLERANCES ARE IN INCHES	
TOLERANCES: X = ± .1	
DECIMALS: .XX = ± .06	
FRACIONS: ± 1/8	
ANGULAR: ± 2'	
DO NOT SCALE DRAWING	

SIGNATURES/DATES APPLY TO CURRENT RELEASE ONLY SIGN AND DATE

Idaho Cleanup Project CHEM-WG

CPP-666


RH-TRU DISTILLATION SYSTEM

SPOOL PIECE 5

PROJECT NUMBER: 31720	DRF NUMBER: 337562
SIZE: D	AREA: 200
INDEX CODE: 0666	NUMBER: 53136
DWG- 571701	REV 3
SCALE: NONE	
SHEET 1 OF 2	

Date: 03/19/14 - 12:46 PM
 Layout Name: 57170101
 File: 571701-3.dwg
 Path: K:\RH-TRU Distillation\Drawings\DRF-341590

File: 571701-3.dwg
Date: 03/19/14 - 12:46 PM
Layout Name: 57170102
Pat: K:\RH-TRU Distillation\Drawings\DRF-341390

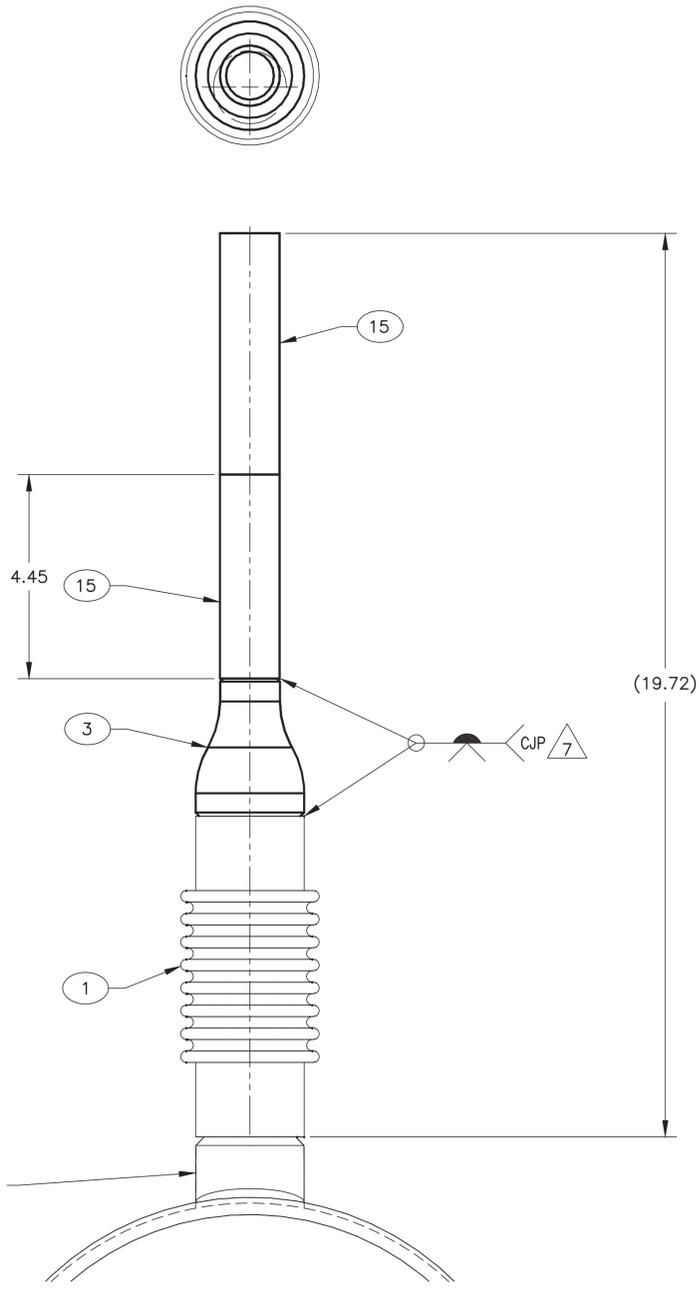

COLLECTION VESSEL
SEE DRAWING 571692


-0 ASSEMBLY
SCALE: 1/2

SIZE	AREA	TYPE	CL	ORIG	DWG-	REV
D	200	0666	53	136	571701	3
SCALE: NOTED						SHEET 2

NOTES:

- 1. REMOVE ALL BURRS AND SHARP EDGES.
- 2. ALL MACHINED FILLET RADII .03 MAXIMUM UNLESS OTHERWISE NOTED.
- 3. WELDING SHALL BE PERFORMED IN ACCORDANCE WITH AWS D1.1 AND USING ITEM 6.
- 4. VISUALLY INSPECT FINAL PASS OF ALL WELDS. ACCEPTANCE CRITERIA SHALL BE:
 - NO CRACKS.
 - COMPLETE FUSION SHALL EXIST BETWEEN WELD METAL AND BASE METAL.
 - UNDERCUT SHALL NOT EXCEED .01" FOR MATERIAL LESS THAN 3/16". FOR MATERIAL 3/16" AND THICKER, UNDERCUT NOT TO EXCEED 1/32".
 - FOR ALL WELDS THE SUM OF VISIBLE POROSITY 1/32" OR GREATER IN DIAMETER SHALL NOT EXCEED 3/8" IN ANY LINEAR INCH OF WELD AND SHALL NOT EXCEED 3/4" IN ANY 12" LENGTH OF WELD.
 - ALL CRATERS SHALL BE FILLED TO THE FULL CROSS-SECTION OF THE WELD EXCEPT FOR ENDS OF FILLET WELDS OUTSIDE THEIR EFFECTIVE LENGTH.
 - FILLET WELDS SHALL BE AT LEAST THE SIZE SPECIFIED IN THE WELD SYMBOL.

- 5. FINAL ASSEMBLY SHALL BE FREE OF DIRT, CHIPS, WELDING FLUX, SLAG, SCALE, OIL, GREASE, ECT. PERFORM A VISUAL INSPECTION OF THE FINAL ASSEMBLY.
- 6. MARK PER STD-7006-2A OR STD-7006-2D IN 1/2" HIGH CHARACTERS WITH INFORMATION AS SHOWN WHERE YYY IS THE MEASURED WEIGHT OF THE ASSEMBLY. LOCATE APPROXIMATELY WHERE SHOWN. FILL CHARACTERS WITH SANFORD T.E.C. MARKER #13401 OR #13501, ITW DYMON FORMULA Q404 INK OR OTHER HIGH-PURITY, LOW-CHLORIDE BLACK INK THAT COMPLIES WITH ASTM C1217-00 OR RTD F7-3T. DO NOT APPLY VARNISH OVER MARKING.
- 7. VERIFY MARKINGS HAVE BEEN ACCURATELY APPLIED AND RECORD THE MEASURED WEIGHT.

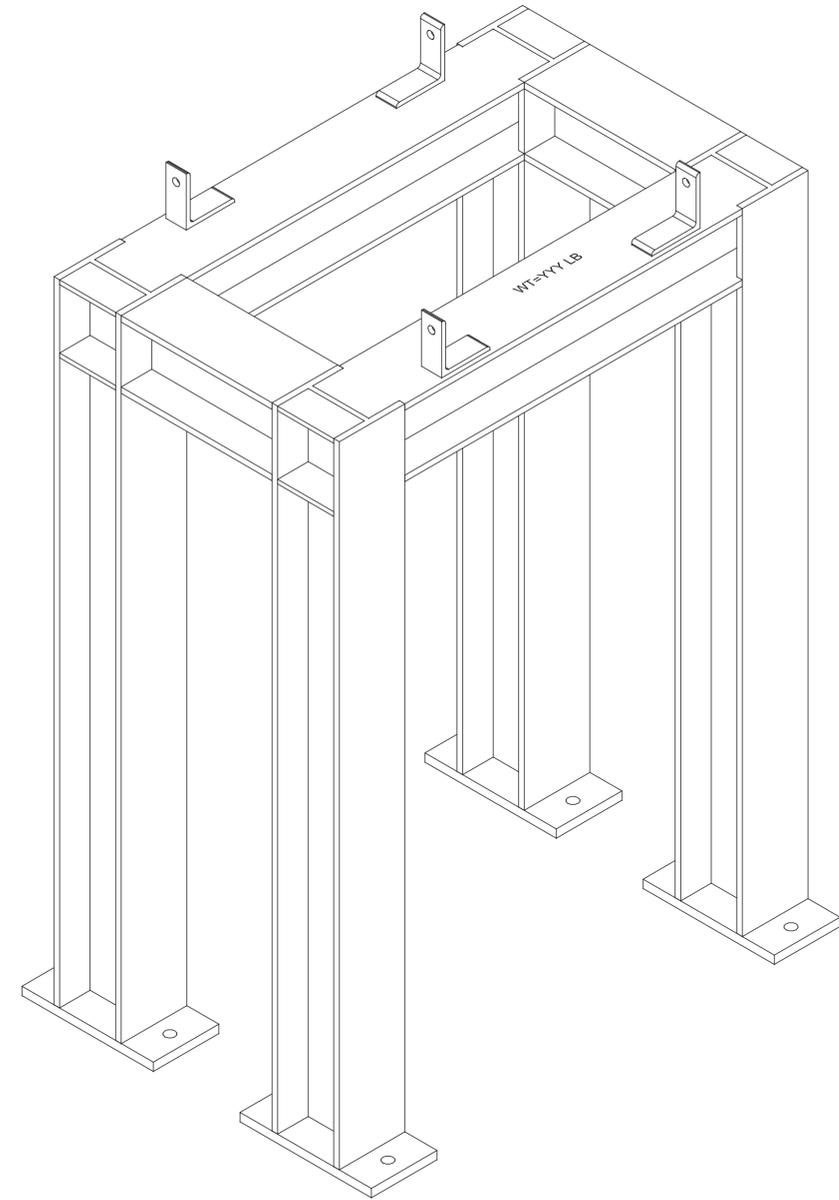

3D VIEW
(SHOWN FOR CLARITY)
SCALE: 1/4

REVISIONS	
REV	DESCRIPTION
1	INCORPORATED FDC-8784, 8946, 8972, 8991 AND 9468 SEE DRF-341134
2	AS-BUILT AS OF 3/18/2014, SUBMITTAL TO STATE FOR RCRA PERMIT, SEE DRF-341590

QTY REQD	QUAL LEVEL	PART OR IDENTIFYING NO.	NOMENCLATURE OR DESCRIPTION	MATERIAL/SPECIFICATION OR VENDOR NAME	ITEM NO.
4	3	-7	BOLTING CLIP	ANGLE CS ASTM A36	7
AR	3		WELD FILLER METAL	ER70S AWS A5.18	6
2	3	-5	SHORT SUPPORT BEAM	BEAM CS ASTM A36	5
2	3	-4	LONG SUPPORT BEAM	BEAM CS ASTM A36	4
4	3	-3	SUPPORT LEG	BEAM CS ASTM A36	3
4	3	-2	BASE PLATE	BAR OR PLATE CS ASTM A36	2
8	3	-1	SIDE PLATE	BAR OR PLATE CS ASTM A36	1
	3	-0	ASSEMBLY		0

Randy Eastman
Professional Engineer
No. 4307
State of Idaho
Randy Eastman

I CERTIFY THAT THIS DRAWING REFLECTS THE CURRENT CONSTRUCTED CONDITION AS OF 3/18/2014

DIMENSIONING AND SYMBOLY PER	
ASME Y14.5-2009 AND STD-11 UNLESS OTHERWISE SPECIFIED	
SURFACE ROUGHNESS 125/	
DIMENSIONS AND TOLERANCES ARE IN INCHES	
TOLERANCES: .X = ± .1	
DECIMALS: .XX = ± .03	
.XXX = ± .010	
FRACTIONS ± 1/8	
ANGULAR ± 2'	

Idaho Cleanup Project

INTEC-666

RH-TRU DISTILLATION SYSTEM

CONDENSER SUPPORT ASSEMBLY

SIZE	AREA	TYPE	CL	ORIG	DWG-	571697	REV	2
D	200	0666	61	136				

SCALE: NOTED




SHEET 1 OF 2

INSPECTION REQUIREMENTS	
QC REQUIRED	
Q DENOTES Q/C INSP. REQD.	

DASH NO.	NEXT ASSY
-0	571692




SIGNATURES/DATES APPLY TO CURRENT RELEASE ONLY		SIGN AND DATE	
DESIGN:	NA		
DRAFTER:	J. MONCUR	Jim Moncur CWI 2014.03.19 13:38:51 -0600'	
TECHNICAL CHECK:	NA		
ENG GROUP SUPERVISOR:	NA		
DESIGN LEAD/AUTHORITY:	D. MORGAN	David Morgan CWI 2014.03.20 08:36:58 -0600'	
DRAFTING CHECK/EFFECTIVE DATE:	K. KELLER	Kris Keller CWI 2014.03.20 09:51:02 -0600'	
PROJECT NUMBER:	31720		
DRF NUMBER:	337681		

File: 571697-2.dwg
 Pat: K:\RH-TRU Distillation\Drawings\DRF-341590
 Date: 03/19/14 - 12:34 PM
 Layout Name: 571697_1
 ID: MKJ

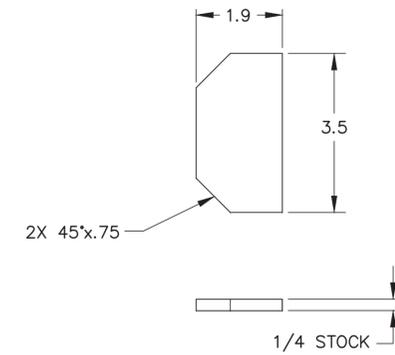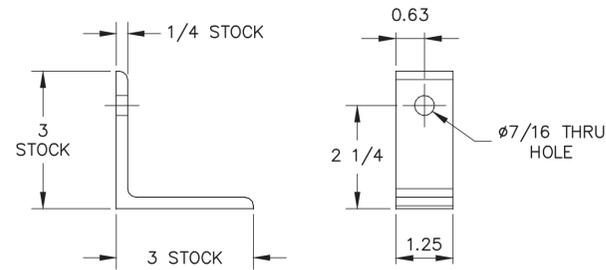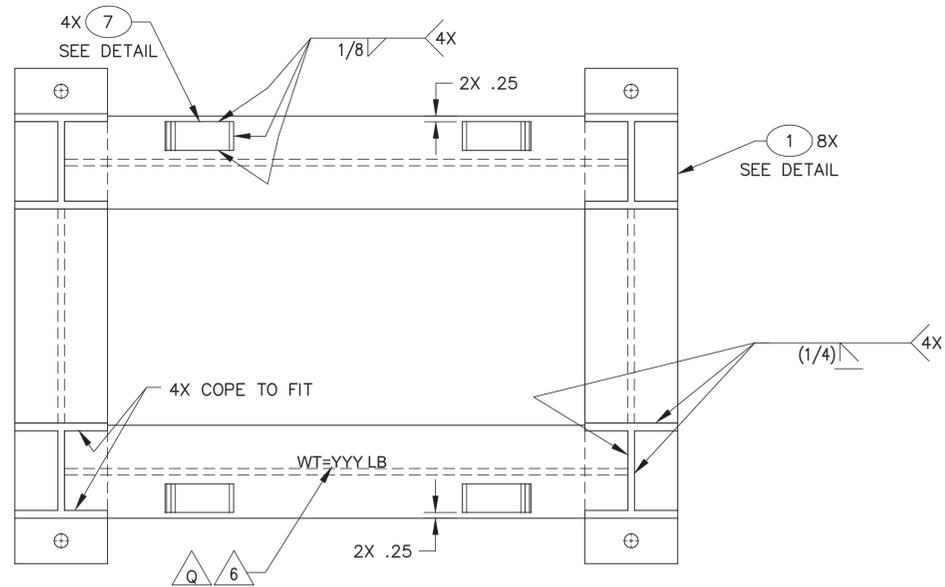

(7) DETAIL
SCALE 1/2

(1) DETAIL
SCALE 1/2

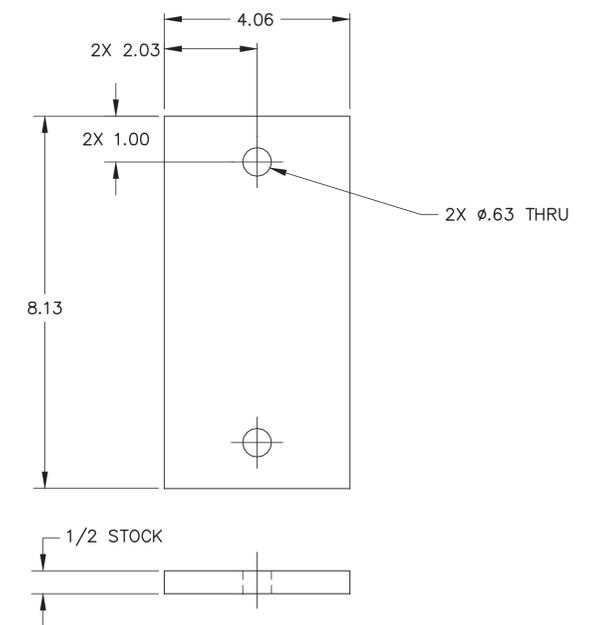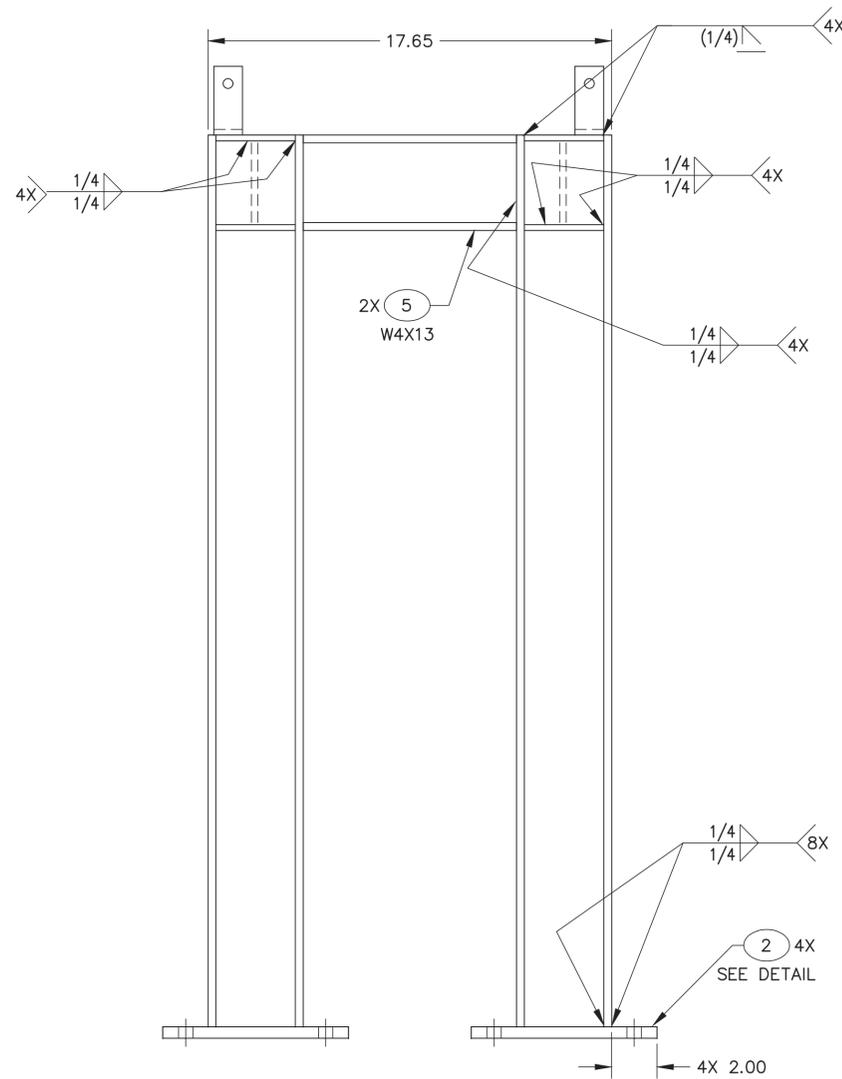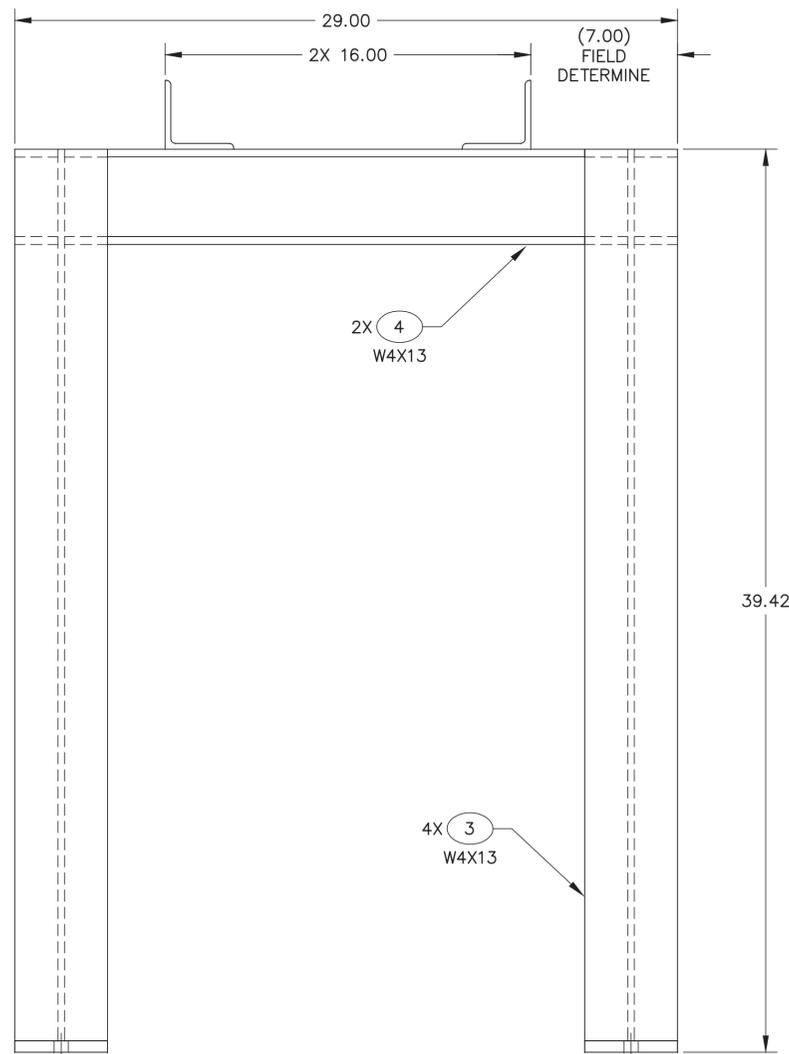

(2) DETAIL
SCALE 1/2

-0 ASSEMBLY
SCALE: 1/4


SIZE	AREA	TYPE	CL	ORIG	DWG-	REV
D	200	0666	61	136	571697	2
SCALE: NOTED						SHEET 2

NOTES:

- 1. REMOVE ALL BURRS AND SHARP EDGES.
- 2. FINAL ASSEMBLY SHALL MEET CLEANLINESS REQUIREMENT OF STD-7022 LEVEL D.
- 3. WELD PER INL WELD PROCEDURE S2.0 USING WELD FILLER METAL (ITEM 6).
- 4. WELD JOINT PREPARATION GEOMETRY IS AT WELDERS DISCRETION.
- 5. VISUALLY INSPECT FINAL PASS OF ALL WELDS. ACCEPTANCE CRITERIA SHALL BE PER TPR-4981, APPENDIX H VISUAL ACCEPTANCE CRITERIA FOR AWS D1.3 WELDS AND BASE MATERIALS.
- 6. MATERIAL MUST HAVE TYPICAL CERTIFIED MATERIAL TEST REPORTS (CMTRs) ISSUED BY THE ORIGINAL MANUFACTURER OR INDEPENDENT TESTING LABORATORY PERFORMING MATERIAL TESTING WHICH CERTIFIES THAT THE MATERIAL HAS BEEN INSPECTED AND TESTED IN ACCORDANCE WITH THE REQUIREMENTS OF THE SPECIFICATION AND THAT THE RESULTS OF THE CHEMICAL ANALYSES AND MECHANICAL TESTS MEET THE REQUIREMENTS OF THE SPECIFICATION FOR THE SPECIFIC GRADE. THE HEAT NUMBER SHALL BE MARKED ON THE CMTRs.
- 7. MATERIAL MUST HAVE TYPICAL CERTIFIED MATERIAL TEST REPORTS (CMTRs) ISSUED BY THE ORIGINAL MANUFACTURER OR INDEPENDENT TESTING LABORATORY PERFORMING MATERIAL TESTING WHICH CERTIFIES THAT THE MATERIAL HAS BEEN INSPECTED AND TESTED IN ACCORDANCE WITH THE REQUIREMENTS OF THE SPECIFICATION AND THAT THE RESULTS OF THE CHEMICAL ANALYSES MEET THE REQUIREMENTS OF THE SPECIFICATION FOR THE AWS MATERIAL CLASSIFICATION. EACH END OF CUT LENGTHS OF WELD FILLER METAL SHALL BE MARKED (OR MARK THE END OF THE SPOOLED WIRE) SHOWING THE AWS MATERIAL CLASSIFICATION AND HEAT NUMBER. THE HEAT NUMBER MUST APPEAR ON THE CMTRs.
- 8. THE PAN ASSEMBLY CONSTITUTES A SECONDARY CONFINEMENT FOR RCRA PURPOSES.
- 9. THE PAN ASSEMBLY HAS A CAPACITY OF APPROXIMATELY 65.5 GALLONS.
- 10. ALL FUTURE PENETRATIONS SHALL BE SEALED USING HEAT RESISTANT SEALANT (ITEM 5).
- 11. PT ALL INSIDE WELDS IN ACCORDANCE WITH TPR-4975, APPENDIX B. ACCEPTANCE CRITERIA SHALL BE NO CRACKS AND NO ROUNDED INDICATIONS GREATER THAN 1/8-INCH.

FIELD INSTALLATION NOTES:

- 15. ALL MEASUREMENTS SHALL BE FIELD VERIFIED.
- 16. EACH OF THE FLOOR CONTAINMENT SECTIONS SHALL BE FIELD FIT.
- 17. ANY PENETRATIONS SHALL BE SEALED BY USING HEAT RESISTANT SEALANT (ITEM 5) OR EQUIVALENT.
- 18. ALL FLOOR OBSTRUCTIONS WILL BE REMOVED PRIOR TO INSTALLING FLOOR CONTAINMENT.
- 19. FIELD FIT AND MATCH DRILL EXTENSION ASSEMBLY (ITEM 1). INSTALL ANCHORS (ITEM 4) PER MANUFACTURER'S INSTRUCTIONS.
- 20. OVERALL DIMENSIONS OF THE FLOOR CONTAINMENT ARE APPROXIMATE AND SHALL BE ALTERED AS NEEDED TO ACHIEVE DESIRED COVERAGE.
- 21. FIELD MEASURE AND CUT THRESHOLD (ITEM 3) AS NEEDED.

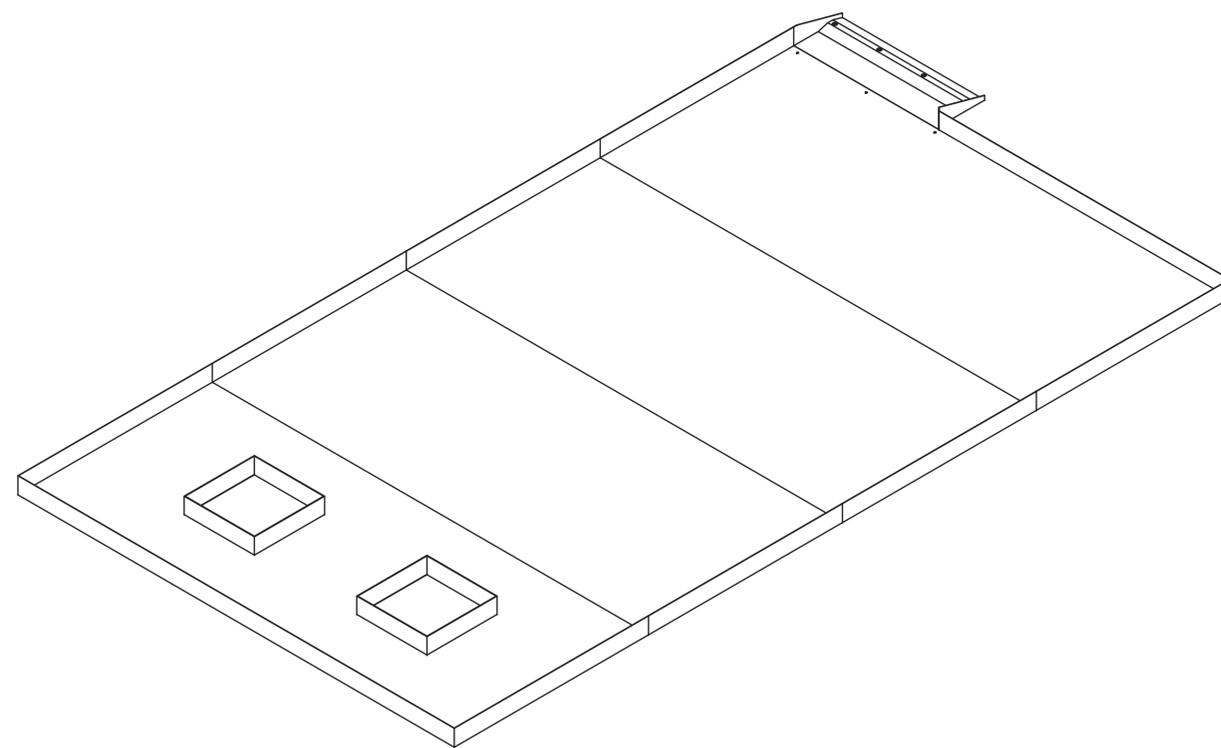

3D VIEW (SHOWN FOR CLARITY) SCALE: NONE

REVISIONS	
REV	DESCRIPTION
1	INCCORP'D FDCs 8964, 8965, 9017, 9053, 9064; COMPLETELY REVISED; ADDED SHEET 3; SEE DRF-341386
2	AS-BUILT AS OF 3/18/2014, SUBMITTAL TO STATE FOR RCRA PERMIT, SEE DRF-341590

QTY REQD	LEVEL	QUAL	PART OR IDENTIFYING NO.	NOMENCLATURE OR DESCRIPTION	MATERIAL/SPECIFICATION OR VENDOR NAME	ITEM NO.
3				WELD FILLER MATERIAL	ER308 OR ER308L AWS A5.9	6
3			736	HEAT RESISTANT SEALANT	DOW CORNING OR EQUAL	5
3			00418055	SCREW ANCHOR WITH WASHER KH-EZ 3/8 X 1-7/8 LONG	HILTI	4
3			571518-0	THRESHOLD		3
3			-2	FLOOR CONTAINMENT SHEETING	SHEET 304 OR 304L SST ASTM A240	2
3			-1	EXTENSION ASSEMBLY		1
3			-0	ASSEMBLY		0



I CERTIFY THAT THIS DRAWING REFLECTS THE CURRENT CONSTRUCTED CONDITION AS OF 3/18/2014

INSPECTION REQUIREMENTS	QC REQUIRED	Q DENOTES Q/C INSP. REQD.
-------------------------	-------------	---------------------------

DIMENSIONING AND SYMBOLOLOGY PER ASME Y14.5-2009 AND STD-11 UNLESS OTHERWISE SPECIFIED SURFACE ROUGHNESS 125/ DIMENSIONS AND TOLERANCES ARE IN INCHES TOLERANCES: .X = ± .1 DECIMALS: .XX = ± .03 .XXX = ± .010 FRACTIONS ± 1/8 ANGULAR ± 2	DASH NO.	FINAL	APPLICATION
---	----------	-------	-------------

Idaho Cleanup Project

INTEC CPP-666

RH-TRU DISTILLATION SYSTEM

DNI ROOM SECONDARY CONTAINMENT


PAN ASSEMBLY

PROJECT NUMBER: 31720
DRF NUMBER: 338608

SCALE: NONE

DWG- 571718


SHEET 1 OF 3

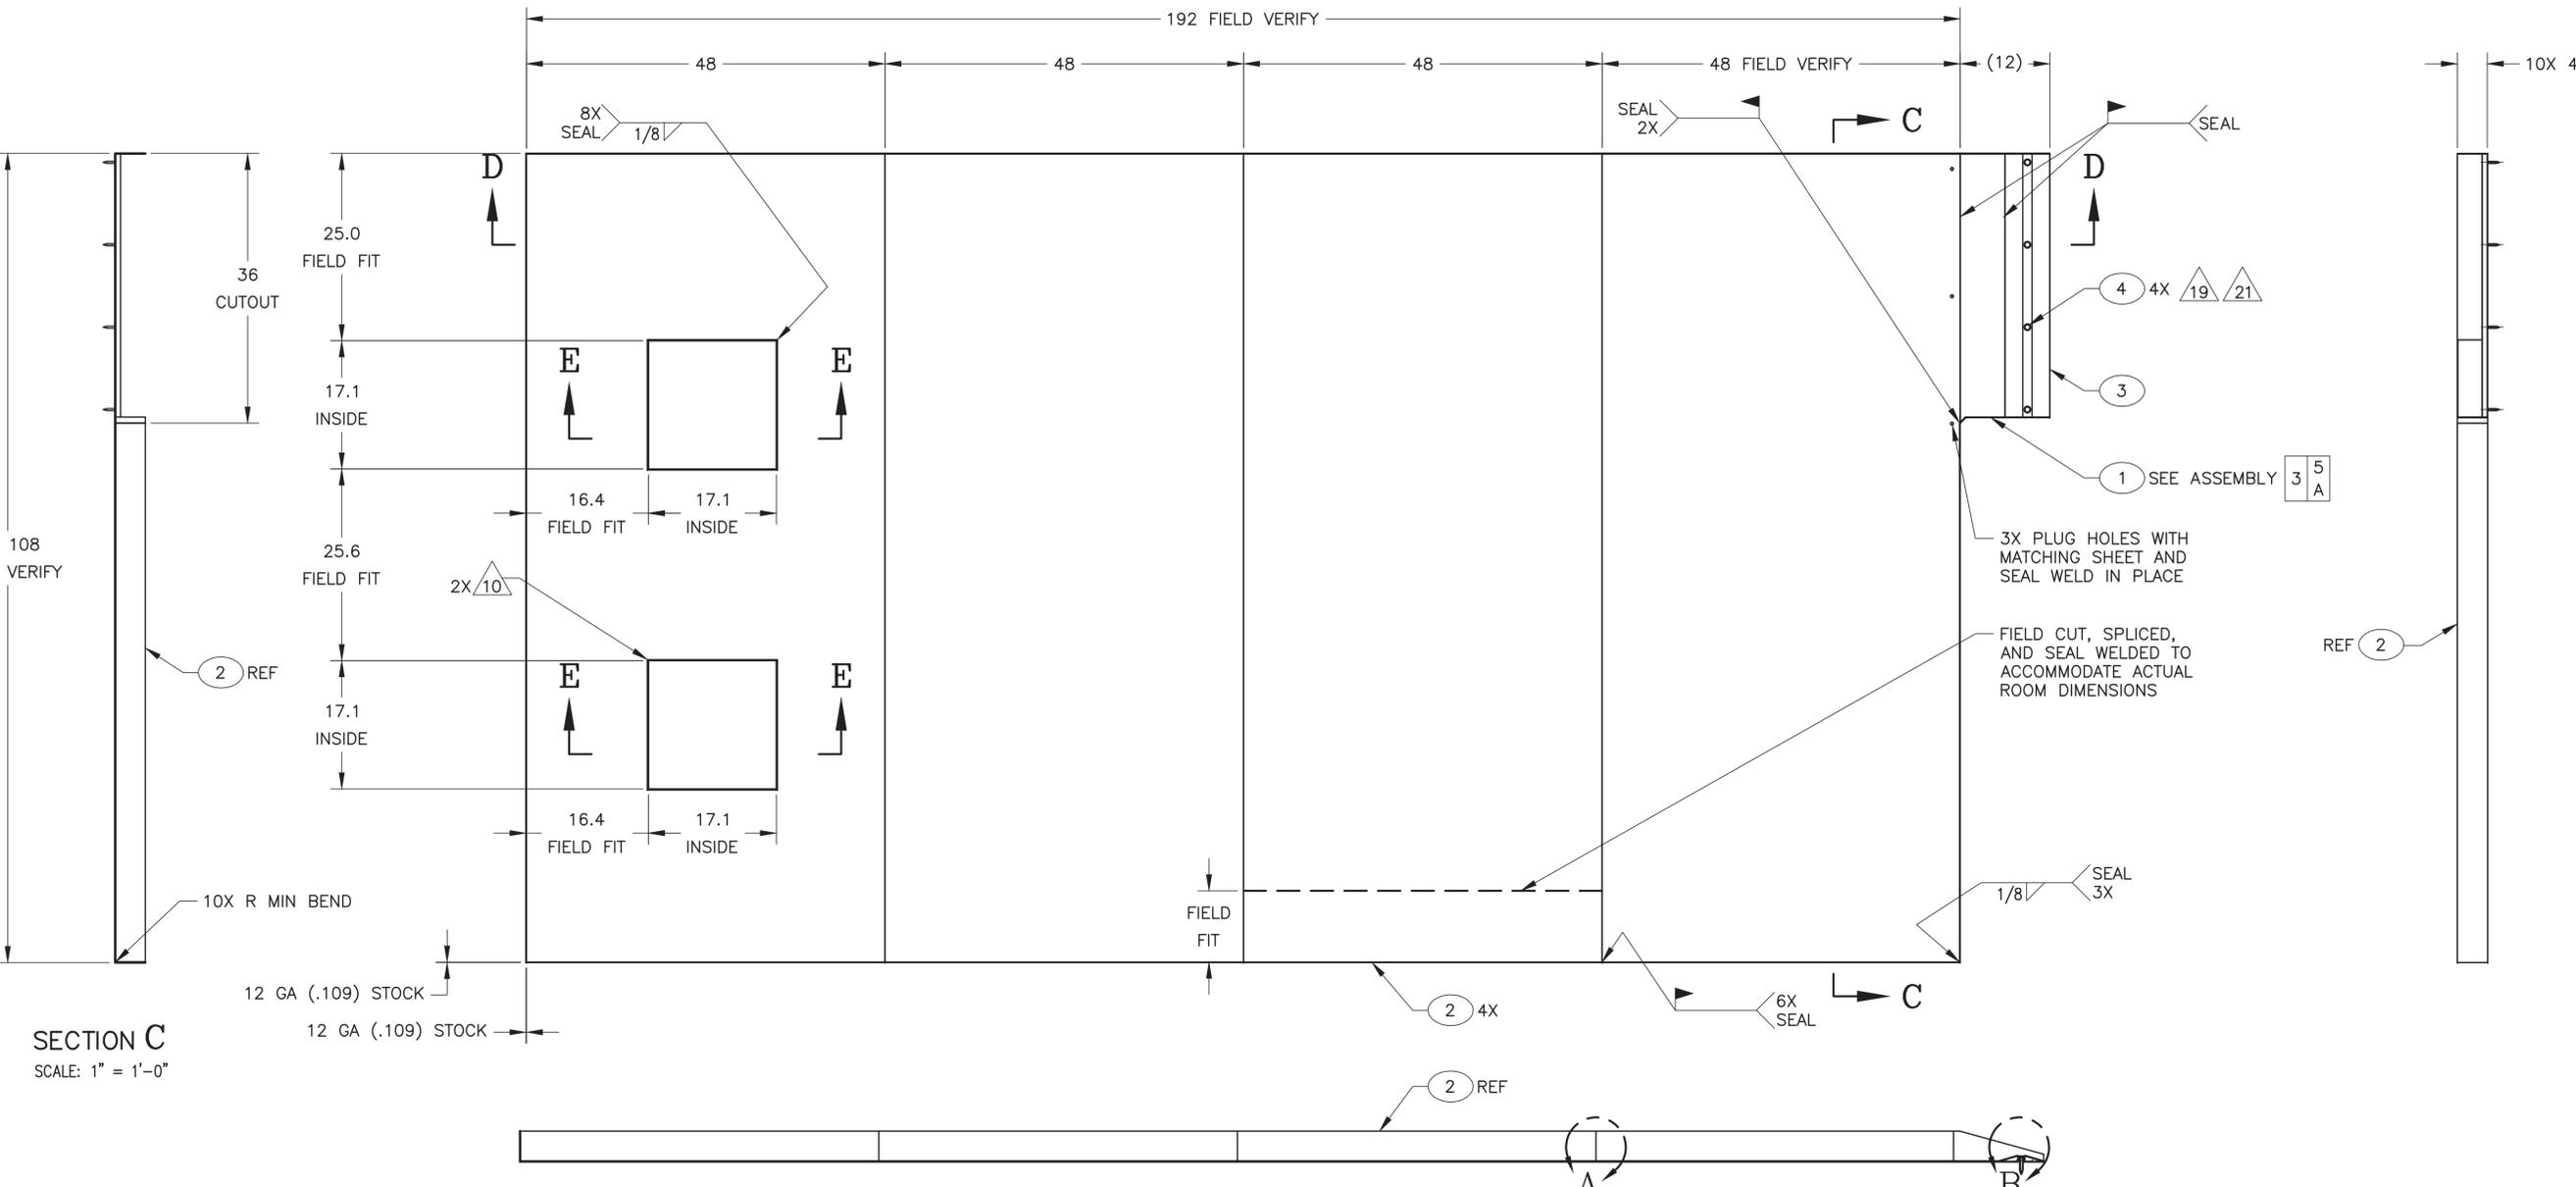


SECTION C
SCALE: 1" = 1'-0"

SECTION D-D
SCALE: 1" = 1'-0"


-0 ASSEMBLY
SCALE: 1" = 1'-0"

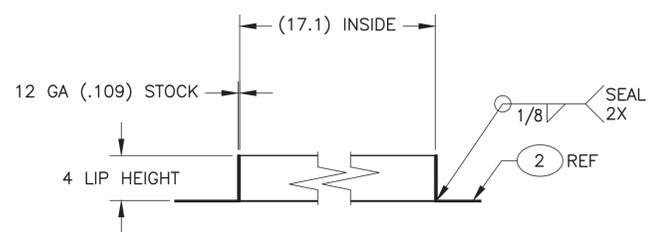

SECTION E-E
SCALE: 1/8
2X

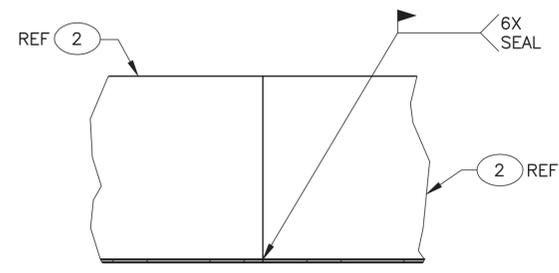


VIEW A
SCALE: 1/2
3X

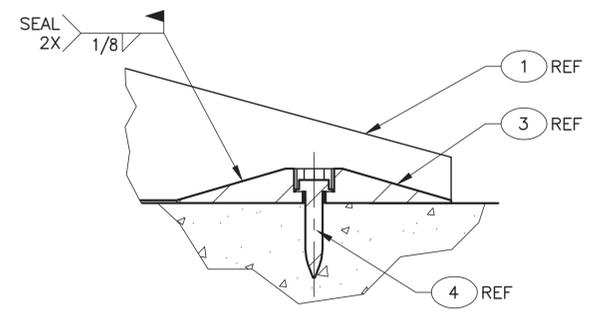


VIEW B
SCALE: 1/2

SIZE	INDEX CODE NUMBER	DWG-	571718	REV	2
D	200 0666 62 136				
SCALE: NOTED			SHEET	2	

File: 571718-2.dwg
Date: 03/19/14 - 8:39 AM
Layout Name: Sheet 2
Path: K:\RH-TRU Distillation\Drawings\DRF-341590

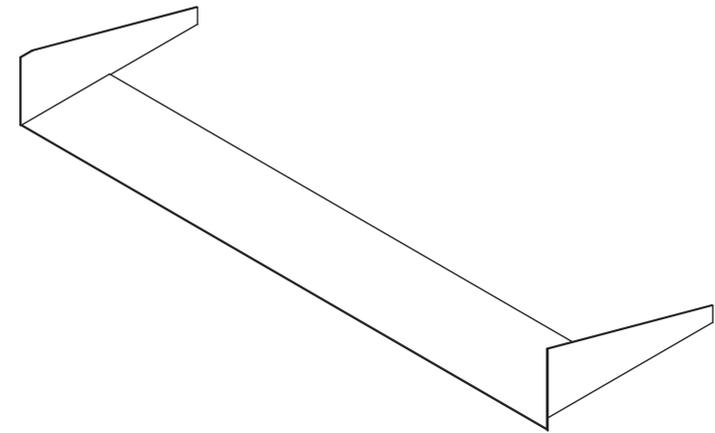

3D VIEW
 (SHOWN FOR CLARITY)
 SCALE: NONE

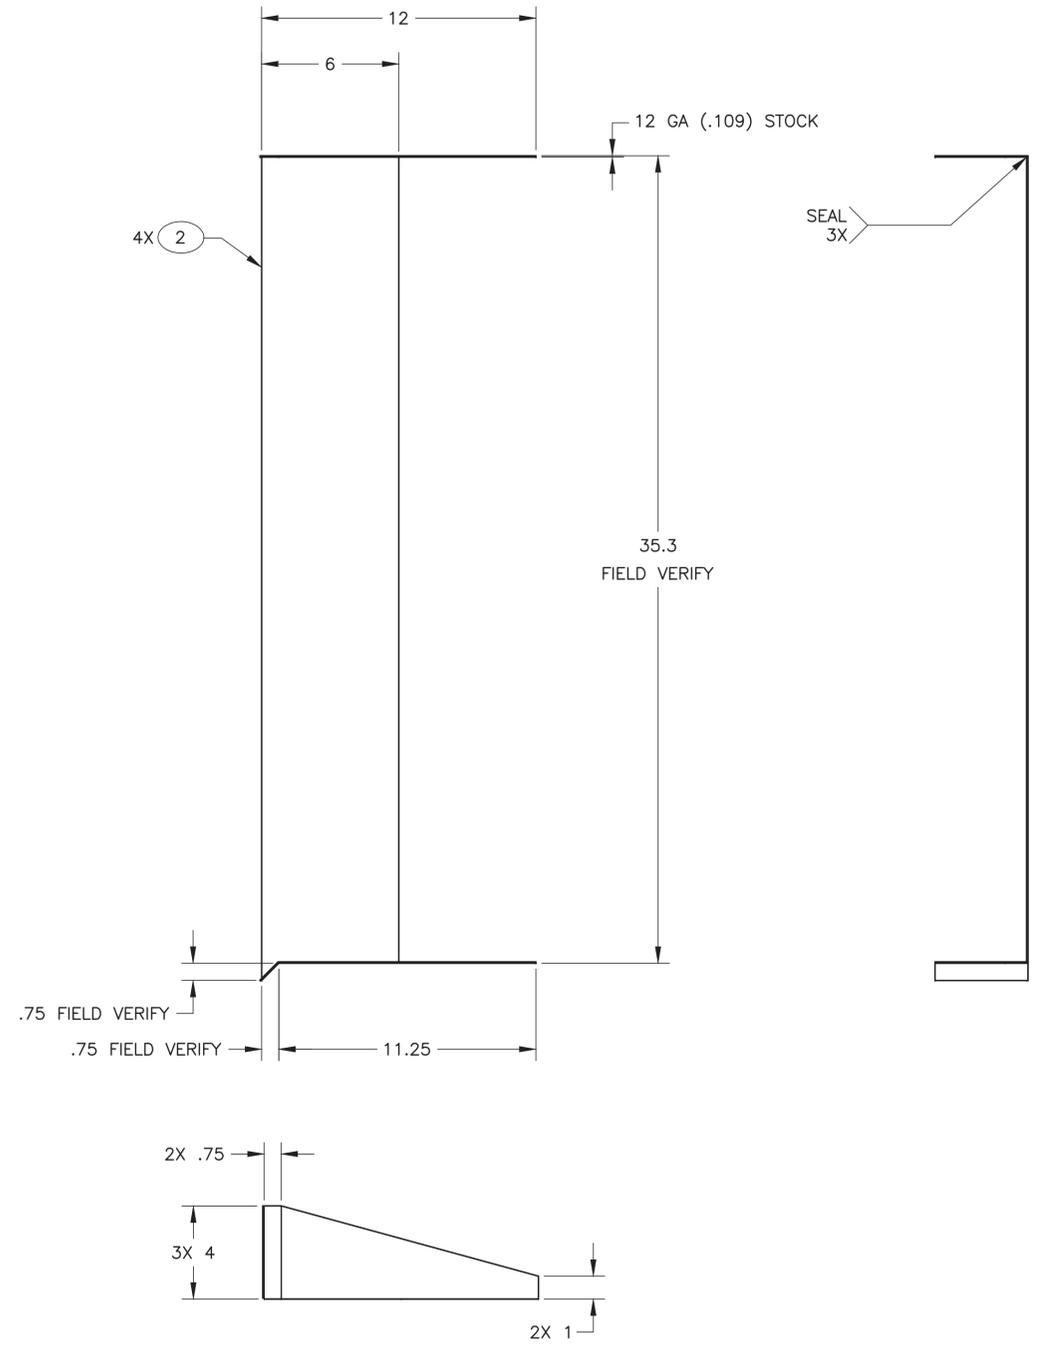

-1 ASSEMBLY
 SCALE: 1/4

File: 571718-2.dwg
 Path: K:\RH-TRU Distillation\Drawings\DRF-341590
 Date: 03/19/14 - 8:39 AM
 Layout Name: Sheet 3
 ID: MXJ



SIZE	INDEX CODE NUMBER			DWG-	571718	REV 2
D	AREA	TYPE	CL			
	200	0666	62	136		
SCALE: NOTED					SHEET	3

NOTES:


- 1. REMOVE ALL BURRS AND SHARP EDGES.
- 2. FINAL ASSEMBLY SHALL MEET CLEANLINESS REQUIREMENT OF STD-7022, LEVEL D.




REVISIONS	
REV	DESCRIPTION
1	INCORPORATED FDC-9610; SHEET 2 REMOVED; REVISED TITLE BLOCK; AS-BUILT AS OF 3/18/2014, SUBMITTAL TO STATE FOR RCRA PERMIT, SEE DRF-341590

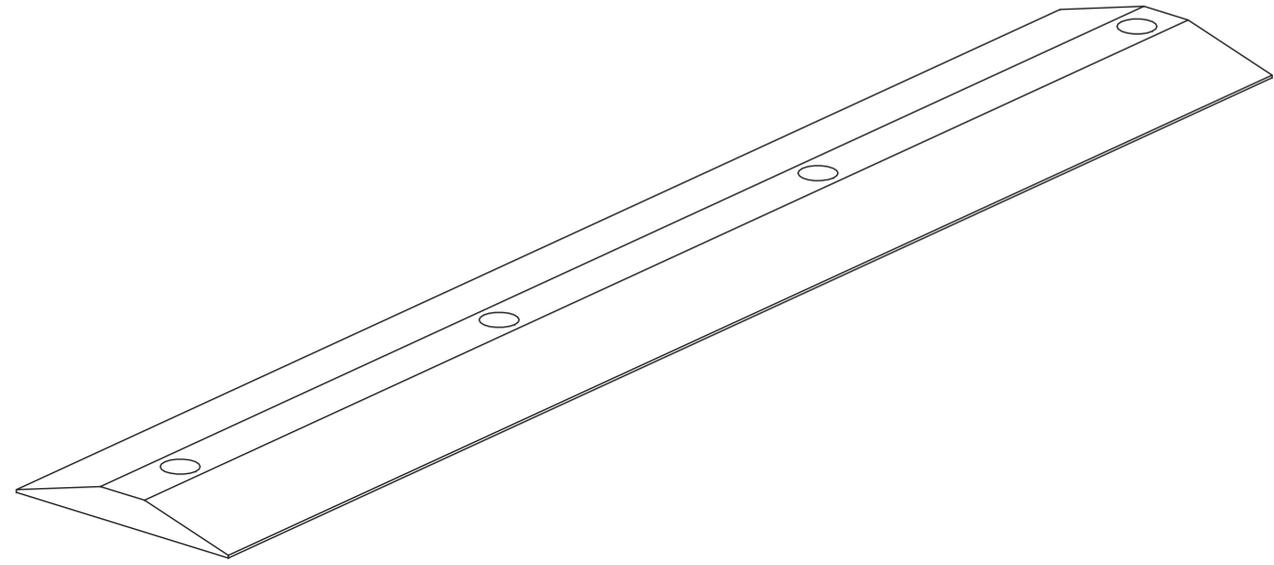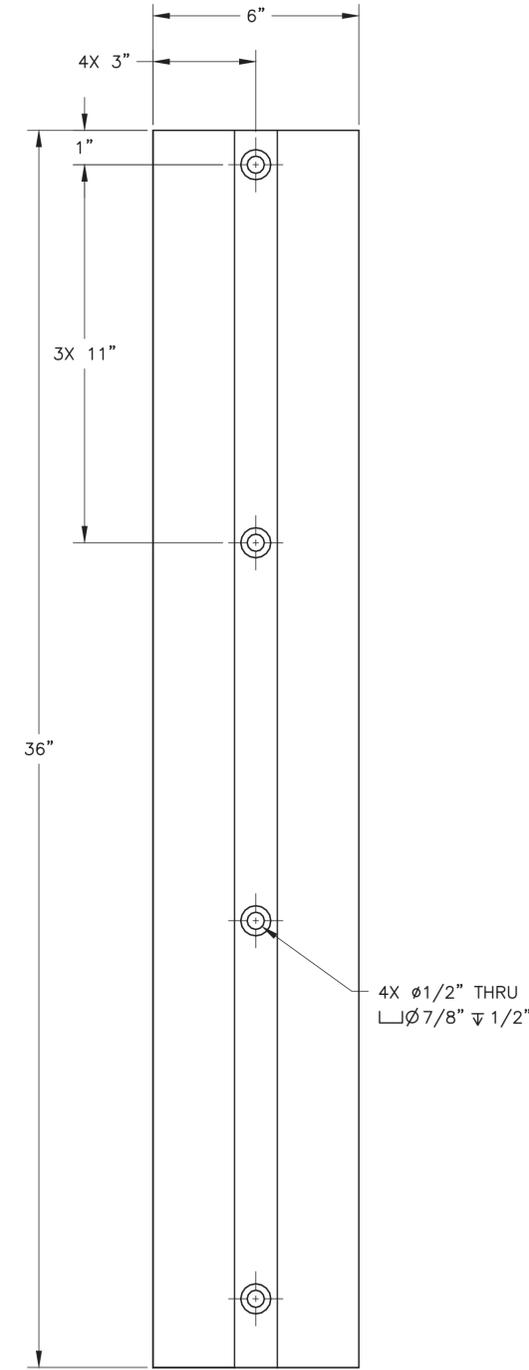

3D VIEW
(SHOWN FOR CLARITY)
SCALE: NONE

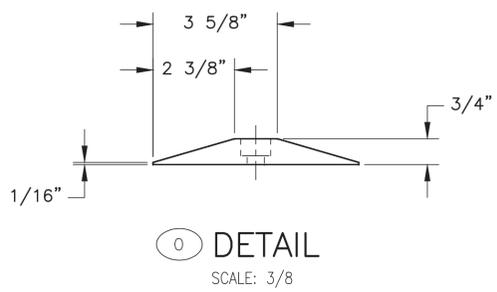

0 DETAIL
SCALE: 3/8

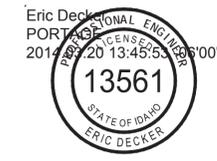

I CERTIFY THAT THIS DRAWING REFLECTS THE CURRENT CONSTRUCTED CONDITION AS OF 3/18/2014


INSPECTION REQUIREMENTS	-0	571718
QC REQUIRED		
Q DENOTES Q/C INSP. REQD.		

DASH NO.	-0
NEXT ASSY	571718
APPLICATION	

QTY REQD	QUAL LEVEL	PART OR IDENTIFYING NO.	NOMENCLATURE OR DESCRIPTION	MATERIAL/SPECIFICATION OR VENDOR NAME	ITEM NO.
N	3	-0	THRESHOLD	BAR 304 OR 304L SST ASTM A276	0

SIGNATURES/DATES APPLY TO CURRENT RELEASE ONLY		SIGN AND DATE
DESIGN:	NA	- -
DRAFTER:	C. WRIDE	2014.03.20 08:38:53 -0600
TECHNICAL CHECK:	NA	- -
ENG GROUP SUPERVISOR:	NA	- -
DESIGN LEAD/AUTHORITY:	David Morgan	2014.03.20 08:38:53 -0600
DRAFTING CHECK/EFFECTIVE DATE:	Kris Keller	2014.03.20 14:02:46 -0600
PROJECT NUMBER:	31720	
DRF NUMBER:	341311	

Idaho Cleanup Project		CHEM+WG IDAHO, LLC	
INTEC CPP-666 RH-TRU DISTILLATION SYSTEM DNI ROOM SECONDARY CONTAINMENT			
THRESHOLD			
SIZE	INDEX CODE	NUMBER	REV
D	200	0666 62 136	1
SCALE: NONE			DWG-- 571518
SHEET 1 OF 1			

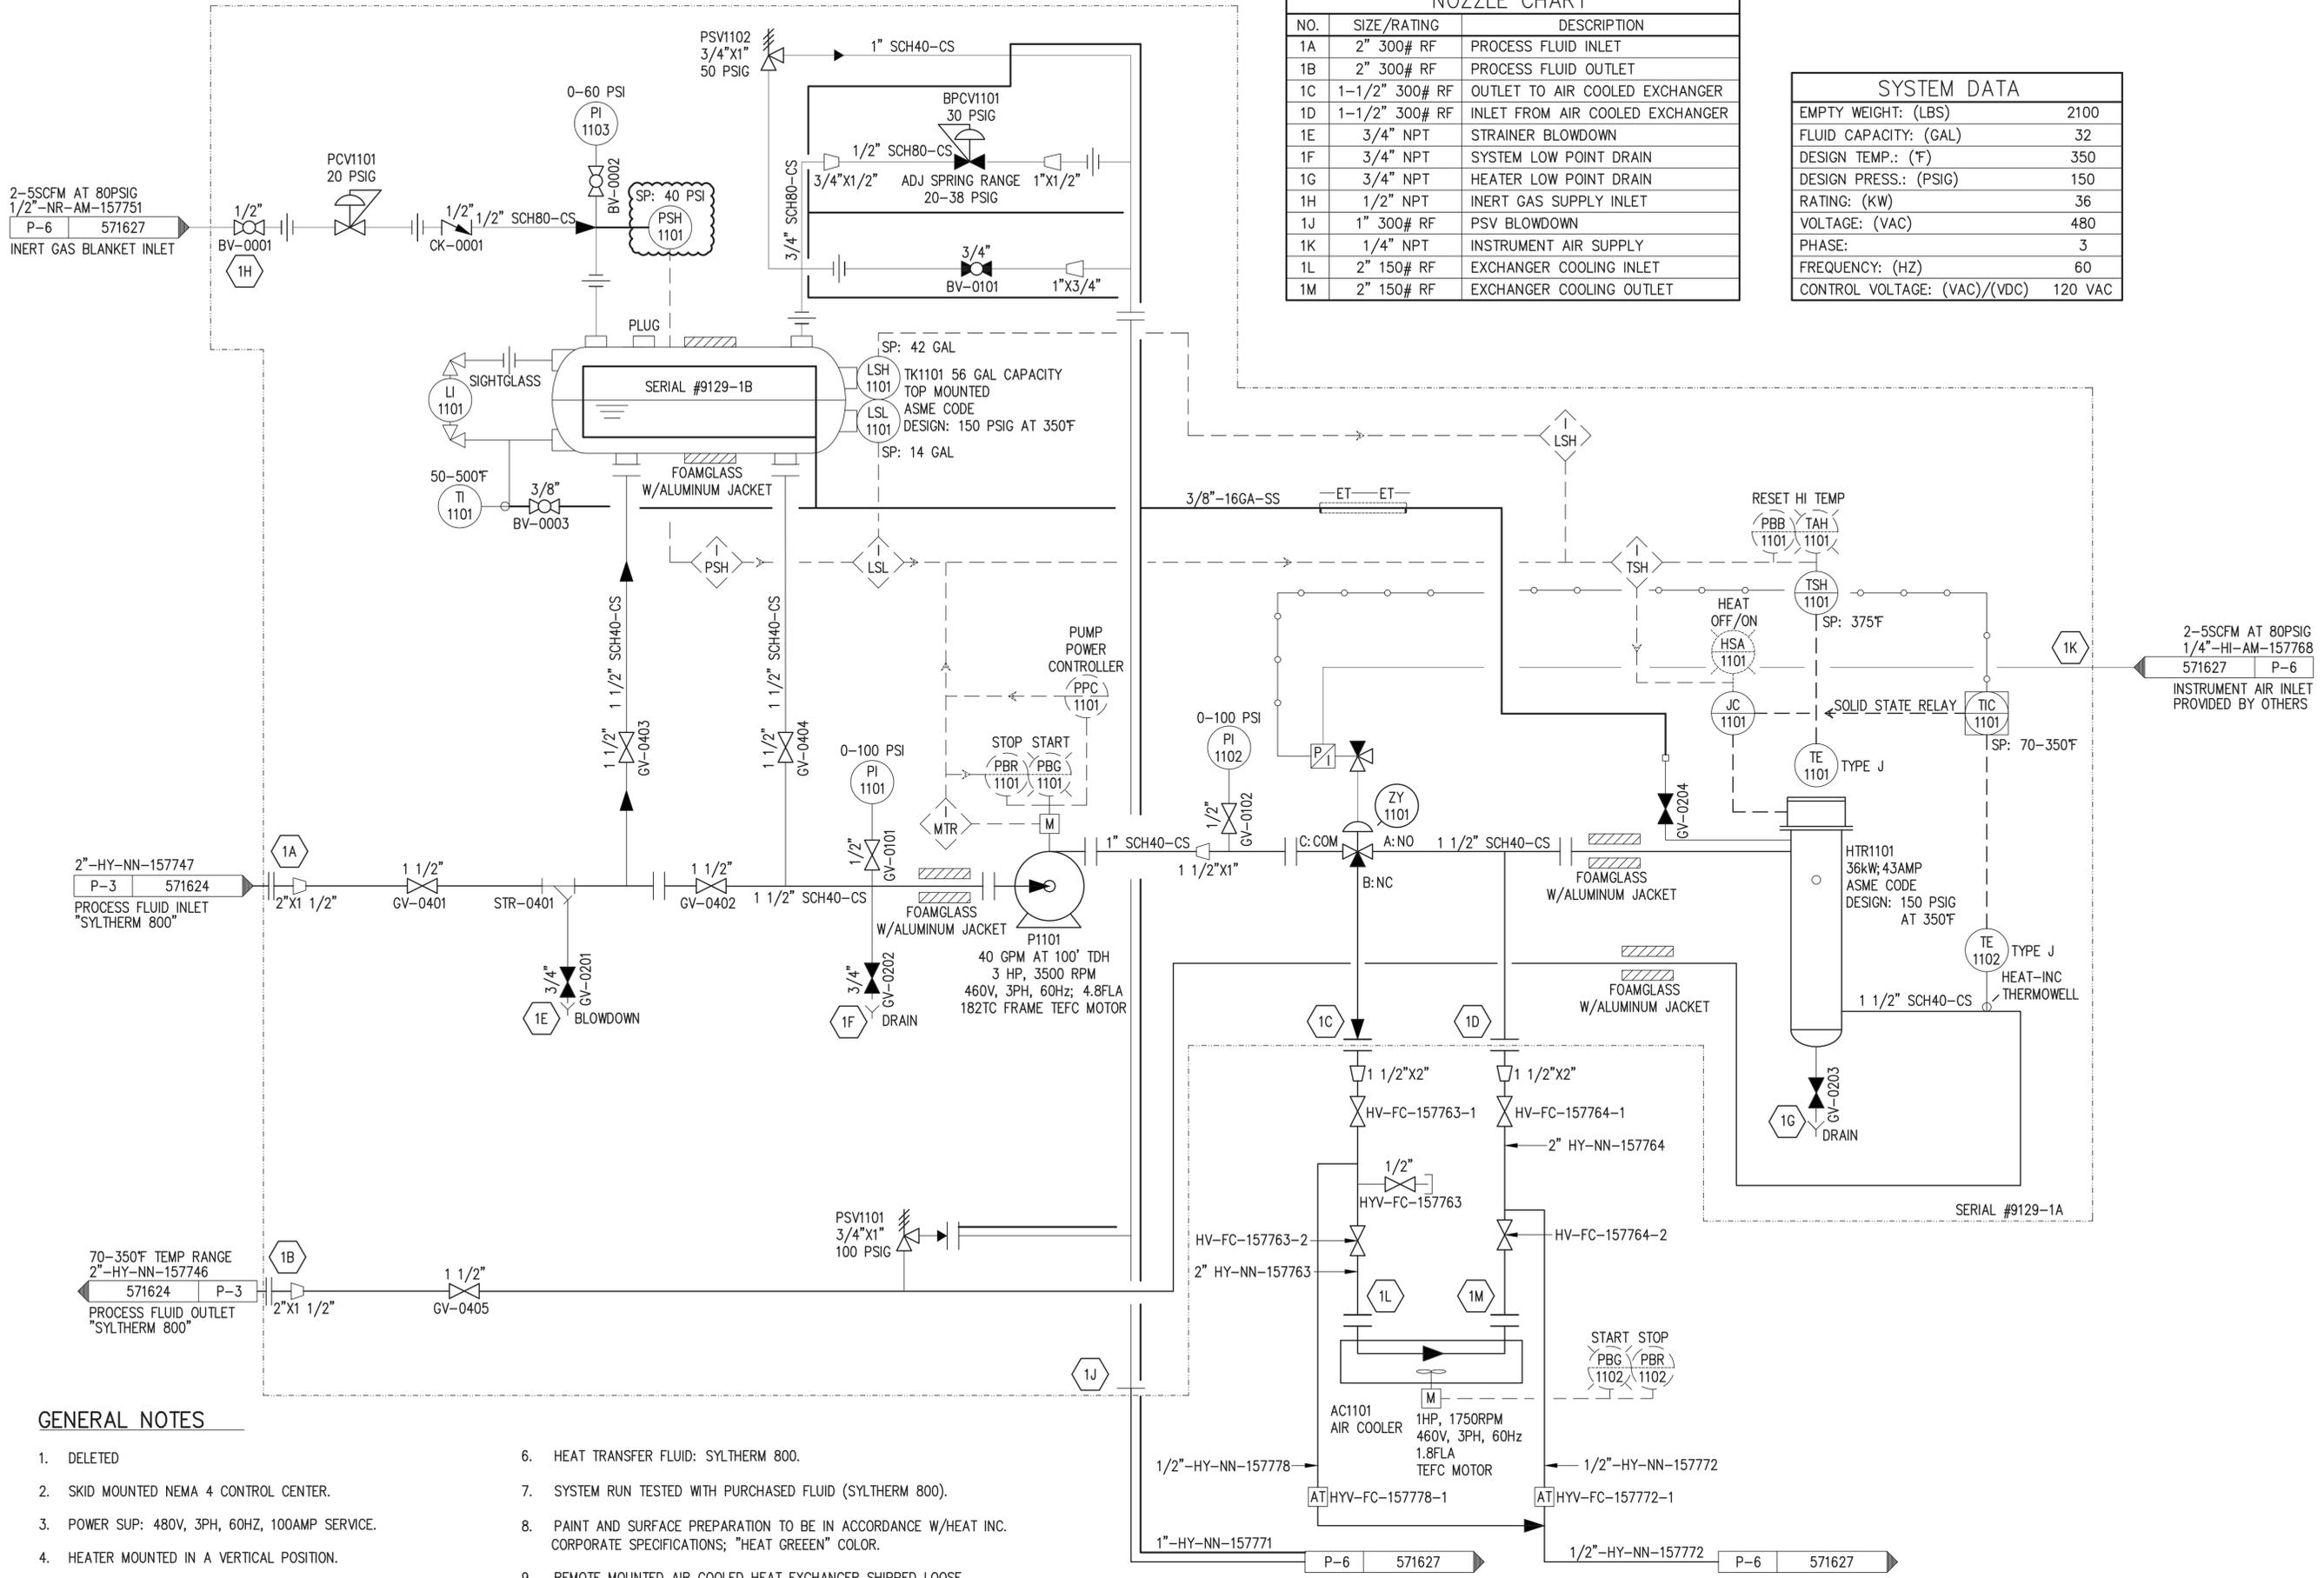

NO.	SIZE/RATING	DESCRIPTION
1A	2" 300# RF	PROCESS FLUID INLET
1B	2" 300# RF	PROCESS FLUID OUTLET
1C	1-1/2" 300# RF	OUTLET TO AIR COOLED EXCHANGER
1D	1-1/2" 300# RF	INLET FROM AIR COOLED EXCHANGER
1E	3/4" NPT	STRAINER BLOWDOWN
1F	3/4" NPT	SYSTEM LOW POINT DRAIN
1G	3/4" NPT	HEATER LOW POINT DRAIN
1H	1/2" NPT	INERT GAS SUPPLY INLET
1J	1" 300# RF	PSV BLOWDOWN
1K	1/4" NPT	INSTRUMENT AIR SUPPLY
1L	2" 150# RF	EXCHANGER COOLING INLET
1M	2" 150# RF	EXCHANGER COOLING OUTLET

SYSTEM DATA	
EMPTY WEIGHT: (LBS)	2100
FLUID CAPACITY: (GAL)	32
DESIGN TEMP.: (°F)	350
DESIGN PRESS.: (PSIG)	150
RATING: (KW)	36
VOLTAGE: (VAC)	480
PHASE:	3
FREQUENCY: (HZ)	60
CONTROL VOLTAGE: (VAC)/(VDC)	120 VAC

GENERAL NOTES

- DELETED
- SKID MOUNTED NEMA 4 CONTROL CENTER.
- POWER SUP: 480V, 3PH, 60HZ, 100AMP SERVICE.
- HEATER MOUNTED IN A VERTICAL POSITION.
- CELLULAR FOAMGLASS INSULATION WITH ALUMINUM JACKET.
- HEAT TRANSFER FLUID: SYLTHERM 800.
- SYSTEM RUN TESTED WITH PURCHASED FLUID (SYLTHERM 800).
- PAINT AND SURFACE PREPARATION TO BE IN ACCORDANCE W/HEAT INC. CORPORATE SPECIFICATIONS; "HEAT GREEN" COLOR.
- REMOTE MOUNTED AIR COOLED HEAT EXCHANGER SHIPPED LOOSE.

REVISION HISTORY	
REV	DESCRIPTION
1	REVISED FOR WORK ORDER
2	REVISED BY CP, SEE DWF-339488
3	REVISED TITLE BLOCK, INCORP FDC-9067, 9347, 9470, AS-BUILT AS OF 1/29/2014, SEE DWF-341174
4	AS-BUILT AS OF 3/24/2014, SUBMITTAL TO STATE FOR RCRA PERMIT, SEE DWF-341665
5	AS-BUILT AS OF 2/02/2016, INCORP DDC-9923, SEE DWF-347766

Idaho Cleanup Project
INTEC-666

**RH-TRU SODIUM DISTILLATION SYSTEM
INSTALLATION**

THERMAL FLUID SKID P&ID

SIGNATURES/DATES APPLY TO CURRENT RELEASE ONLY	
DESIGNER:	SIGN AND DATE
NA	-
DRAFTER:	Angela L Key Nuclear Technology 2016.02.10 15:08:51 -0700
J. MONCUR	-
TECHNICAL CHECK:	-
NA	-
ENG GROUP SUPERVISOR:	-
NA	-
DESIGN LEAD/AUTHORITY:	David Morgan CWI 2016.02.11 09:31:26 -0700
D. MORGAN	-
DRAFTING CHECK/EFFECTIVE DATE:	Kris Keller CWI 2016.02.11 10:37:05 -0700
K. KELLER	-


NO SCALE

DESIGN PHASE:			
QUALITY LEVEL:	3		
HORIZONTAL SCALE:	NONE		
VERTICAL SCALE:	NA		
FOR DRAWING INDEX SEE DRAWING NO.	571425		
PROJECT NUMBER:	31720		
INDEX CODE NUMBER			
AREA	TYPE	CL	ORIG
200	0666	24	136
SIZE	DWG-	571623	REV
D			4
DRF NO.	SHEET	P-7	
33458			

NOTES:

- REMOVE ALL BURRS AND SHARP EDGES.
- ALL MACHINED FILLET RADII .03 MAXIMUM UNLESS OTHERWISE NOTED.
- USE THREAD LUBRICANT (ITEM 21) ON ALL BOLT THREADS.
- FINAL ASSEMBLY SHALL BE FREE OF DIRT, CHIPS, WELDING FLUX, SLAG, SCALE, OIL, GREASE, ETC. PERFORM A VISUAL INSPECTION OF THE FINAL ASSEMBLY PER ASTM A380, PARA 7.2.1.
- REMOVED
- DESIGN PRESSURE = FULL VACUUM TO 15 PSIG.
- REMOVED.
- WELDING SHALL BE PERFORMED IN ACCORDANCE WITH ASME B&PV CODE SECTION IX. WELD PER INL WELD PROCEDURE SPECIFICATION S2.0 USING ITEM 20.
- PERFORM VISUAL EXAMINATION OF THE FINAL PASS OF ALL WELDS IN ACCORDANCE WITH ASME B31.3, PARAGRAPH 344.2, WITH ACCEPTANCE CRITERIA IN ACCORDANCE WITH TABLE 341.3.2 FOR NORMAL FLUID SERVICE.
- PERFORM IN-PROCESS INSPECTION OF WELDS WHERE SPECIFIED PER ASME B31.1, PARAGRAPH 344.7 USING LIQUID PENETRANT EXAMINATION OF THE ROOT AND FINAL PASS.
- LIQUID PENETRANT EXAMINATION FOR THE ROOT AND FINAL PASS OF BUTT-WELDS AND FINAL PASS OF FILLET WELDS SHALL BE PERFORMED IN ACCORDANCE WITH ASME B31.3, PARAGRAPH 344.4 WITH ACCEPTANCE CRITERIA IN ACCORDANCE WITH TABLE 341.3.2 FOR NORMAL FLUID SERVICE.
- REMOVED.
- FOR SODIUM DISTILLATE ENCLOSURE SEE DRAWINGS 779875 THROUGH 779894 AND 780219 THROUGH 780223.
- LOCATION OF EQUIPMENT MAY BE ADJUSTED AS NECESSARY.
- DESIGN TEMPERATURE = SEE SUBASSEMBLIES.
- COMPLETED ASSEMBLY SHALL UNDERGO A PNEUMATIC LEAK TEST IN ACCORDANCE WITH ASME B31.3 USING A DIRECT PRESSURE BUBBLE TEST TECHNIQUE, PERFORM TEST AT A PRESSURE OF 14.5 TO 15.0 PSIG. "SNOOP" ALL CONNECTIONS & WELDED JOINTS FOR LEAKS.
- EXISTING EQUIPMENT SHOWN AS LIGHT GRAY.
- THIS DRAWING WAS GENERATED FROM DRAWING 571692.
- TORQUE BOLTS ON GRAYLOK CLAMP TO 55 (+5.5/-0) FT-LB.
- TORQUE BOLTS ON 2-3/4" OD CF FLANGES TO 12 (+1/-0) FT. LB.
- PERFORM IN-PROCESS INSPECTION OF WELDS WHERE SPECIFIED PER ASME B31.3, PARAGRAPH 344.7 USING LIQUID PENETRANT EXAMINATION OF THE ROOT AND FINAL PASS OF BUTT-WELDS AND FINAL PASS OF FILLET WELDS

REVISIONS	
REV	DESCRIPTION
1	RELOCATED CONDENSER/COLLECTION VESSEL AND PIPING SEE DRF-344903
2	INCORP'D FDC-10409, 10453, 10474, AND 10529, SEE DRF-346066

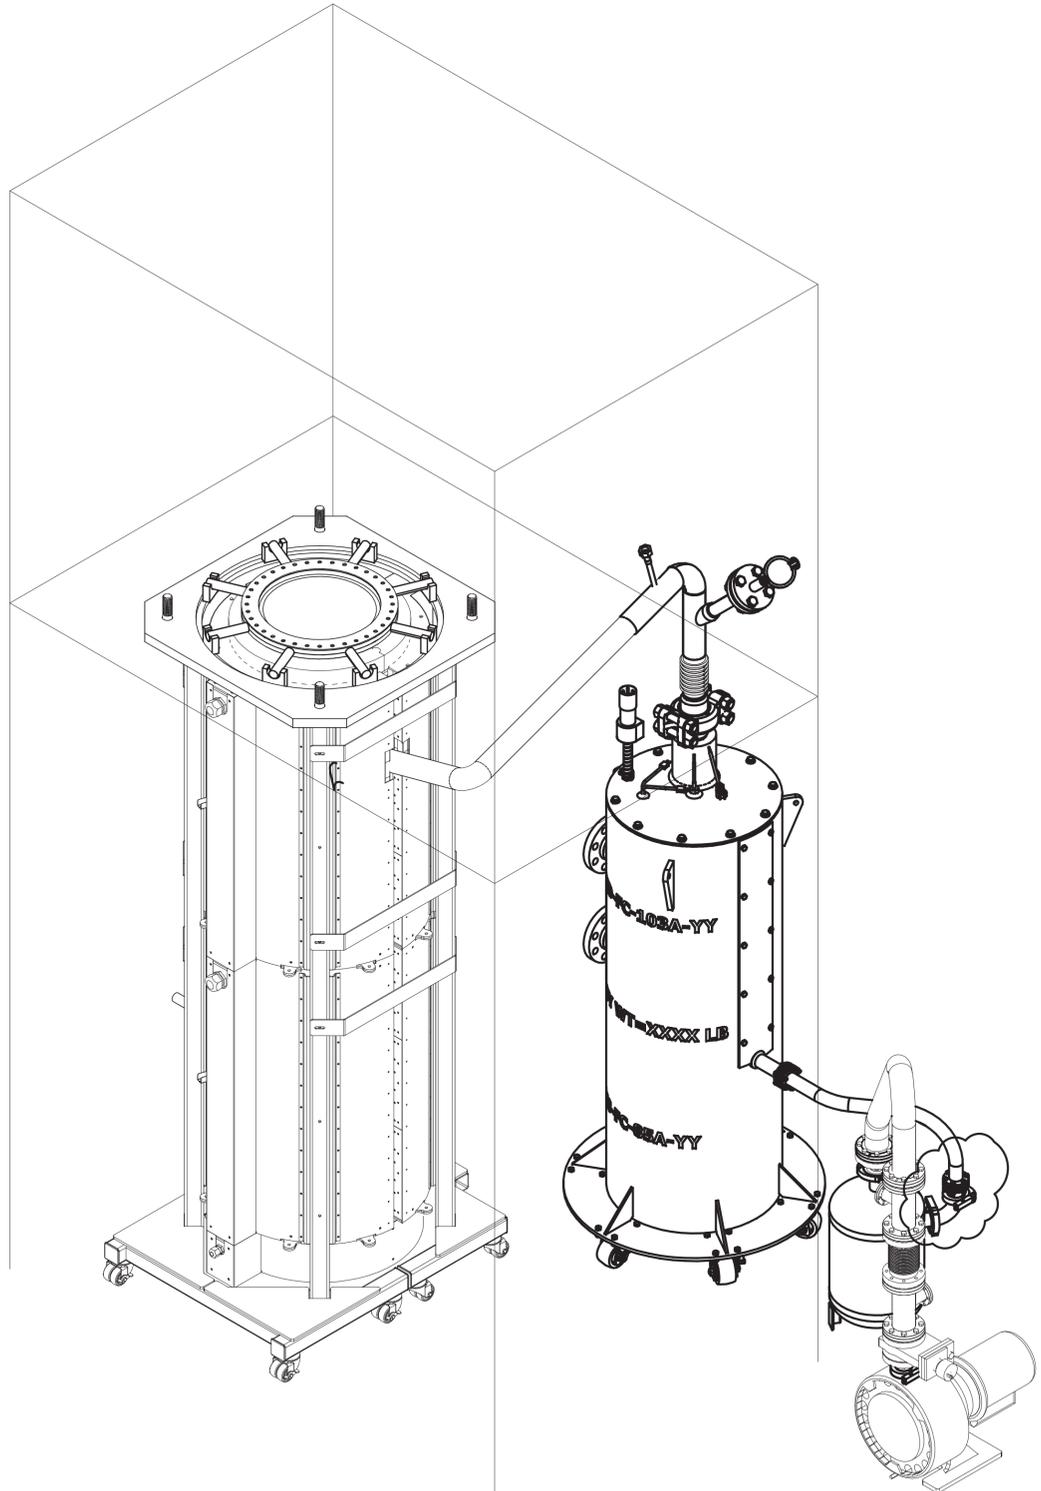

3D VIEW
(SHOWN FOR CLARITY)
SCALE: NONE



I CERTIFY THE CHANGES SHOWN ON THIS DRAWING REFLECT THE CURRENT CONSTRUCTED CONDITION AS OF 07/15/2015

INSPECTION REQUIREMENTS	-1 FINAL
QC REQUIRED	DASH NO. NEXT ASSY
Q DENOTES Q/C INSP. REQ.	APPLICATION

QTY REQD	LEVEL	PART OR IDENTIFYING NO.	NOMENCLATURE OR DESCRIPTION	MATERIAL/SPECIFICATION OR VENDOR NAME	ITEM NO.
1	3	H90243-38WB-1	CLAMP, 2 PIECE	GRAYLOC	25
1	3	H90174-18	SEAL RING, 20, HIGH STRENGTH	GRAYLOC	24
1	3	HBS-25028138	BOLT, HEX HEAD/NUT SETS 1/4-28UNF	KURT J. LESKER COMPANY	23
3	3	GA-0275NSP	GASKET, FOR 2 3/4" OD CF FLANGE, SILVER PLATED COPPER	KURT J. LESKER COMPANY	22
AR	3	77124	NICKEL ANTI-SEIZE THREAD LUBRICANT	LOCTITE CORP.	21
AR	3		WELD FILLER METAL	ER308H AWS A5.9	20
4	3	QF40-150-OPR	OVER-PRESSURE RING KF-40	KURT J. LESKER	19
1	3	F0275XQF40	CF TO KF FLANGE ADAPTER 2.75" CF FLANGE TO KF40 FLANGE	KURT J. LESKER COMPANY	18
					17
1	3	QF40-150-E90	ELBOW, KF-40 90° FLANGED	KURT J. LESKER COMPANY	16
					15
1	3	MHB-CF-C30	HYDRAULICALLY FORMED BELLOWS SST, FLANGED BELLOWS, 24" LONG	KURT J. LESKER COMPANY	14
1	3	788579	SPOOL PIECE 8		13
					12
					11
4	3	QF40-150-CS	MACHINED CLAMP FOR KF40 FLANGE	KURT J. LESKER	10
4	3	QF40-150-SRB	CENTERING RING W/ BUNA-N O-RING FOR KF40 FLANGE	KURT J. LESKER	9
					8
1	3	785276-0	COLD TRAP FILTER		7
					6
					5
					4
1		786868-0	CONDENSER / COLLECTION VESSEL		3
					2
	3	-1	ASSEMBLY		1

SIGNATURES/DATES APPLY TO CURRENT RELEASE ONLY		SIGN AND DATE	
DESIGNER: R. CAMPBELL	Rodney C. Campbell Nuclear Engineering 2015.08.05 14:47:25 -0600	DRAFTER: A. KEY	Angela L. Key Nuclear Technology 2015.08.05 15:02:25 -0600
TECHNICAL CHECK: T. BURNETT P.E.	Troy P. Burnett Wash Engineering 2015.08.05 15:13:18 -0600	ENG GROUP SUPERVISOR: R. EASTMAN P. E.	Randy Eastman CWI 2015.08.05 15:18:49 -0600
DESIGN LEAD/AUTHORITY: D. MORGAN	David Morgan CWI 2015.08.05 14:52:32 -0600	DRAFTING CHECK/ EFFECTIVE DATE: S. BERTHELSON	Shawn Berthelson CWI 2015.08.05 17:23:12 -0600
PROJECT NUMBER: 31720		DRF NUMBER: 343941	

Idaho Cleanup Project

CPP-666


**RH-TRU SODIUM DISTILLATION SYSTEM
DISTILLATION SYSTEM
ASSEMBLY MODIFICATION**

SIZE	INDEX CODE NUMBER	DWG-	571515	REV	2
D	200 0666 53 136				

SCALE: NOTED

SHEET 1 OF 5


Layout Name: Sheet 1
Date: 08/05/15 - 9:42 AM
Path: K:\RH-TRU Distillation Drawings\DRF-346066

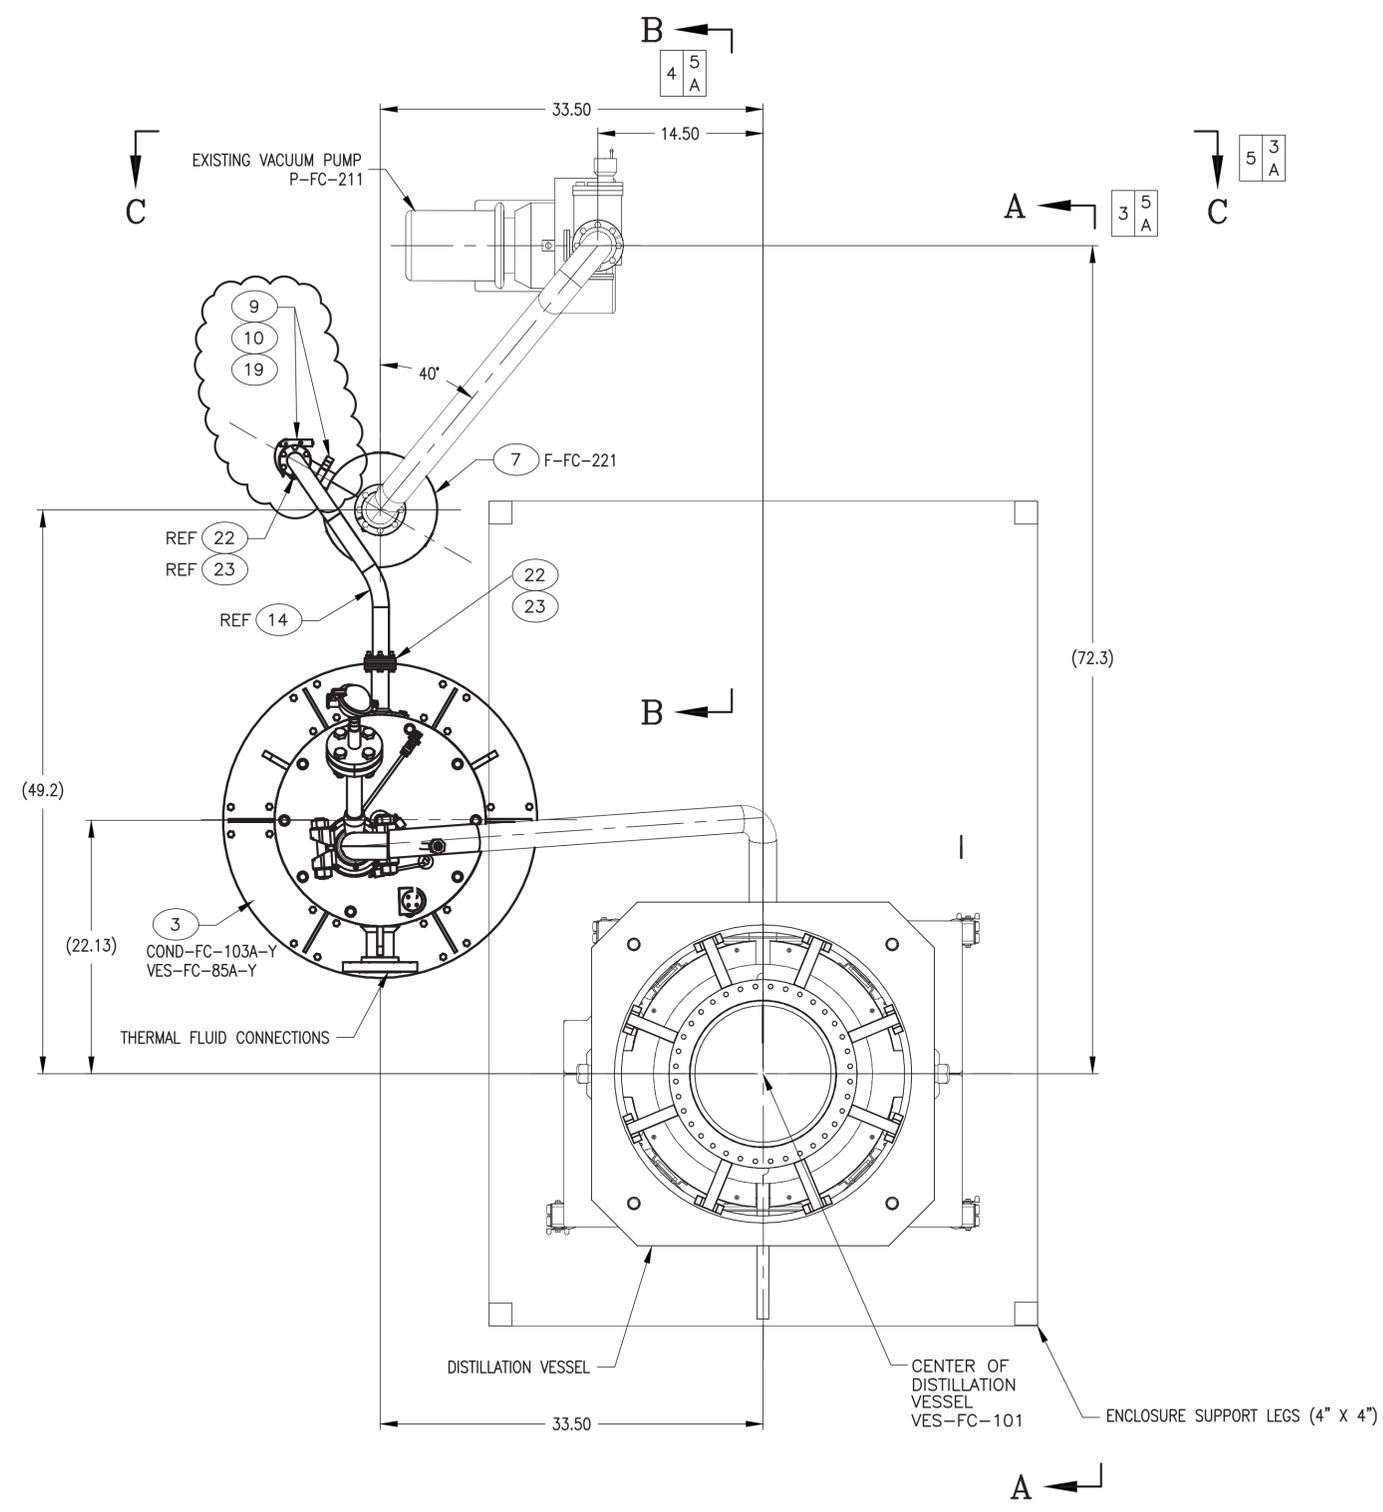

-1 ASSEMBLY
SCALE: 1/8

SIZE	INDEX CODE	NUMBER	DWG-	571515	REV
D	AREA	TYPE	CL	ORIG	2
	200	0666	53	136	
SCALE: NOTED				SHEET	2


File: 571515-2.dwg
 Date: 08/05/15 - 9:42 AM
 Path: K:\RH-TRU_Distillation\Drawings\DRF-346066
 Layout Name: Sheet 2
 D: KEVAL

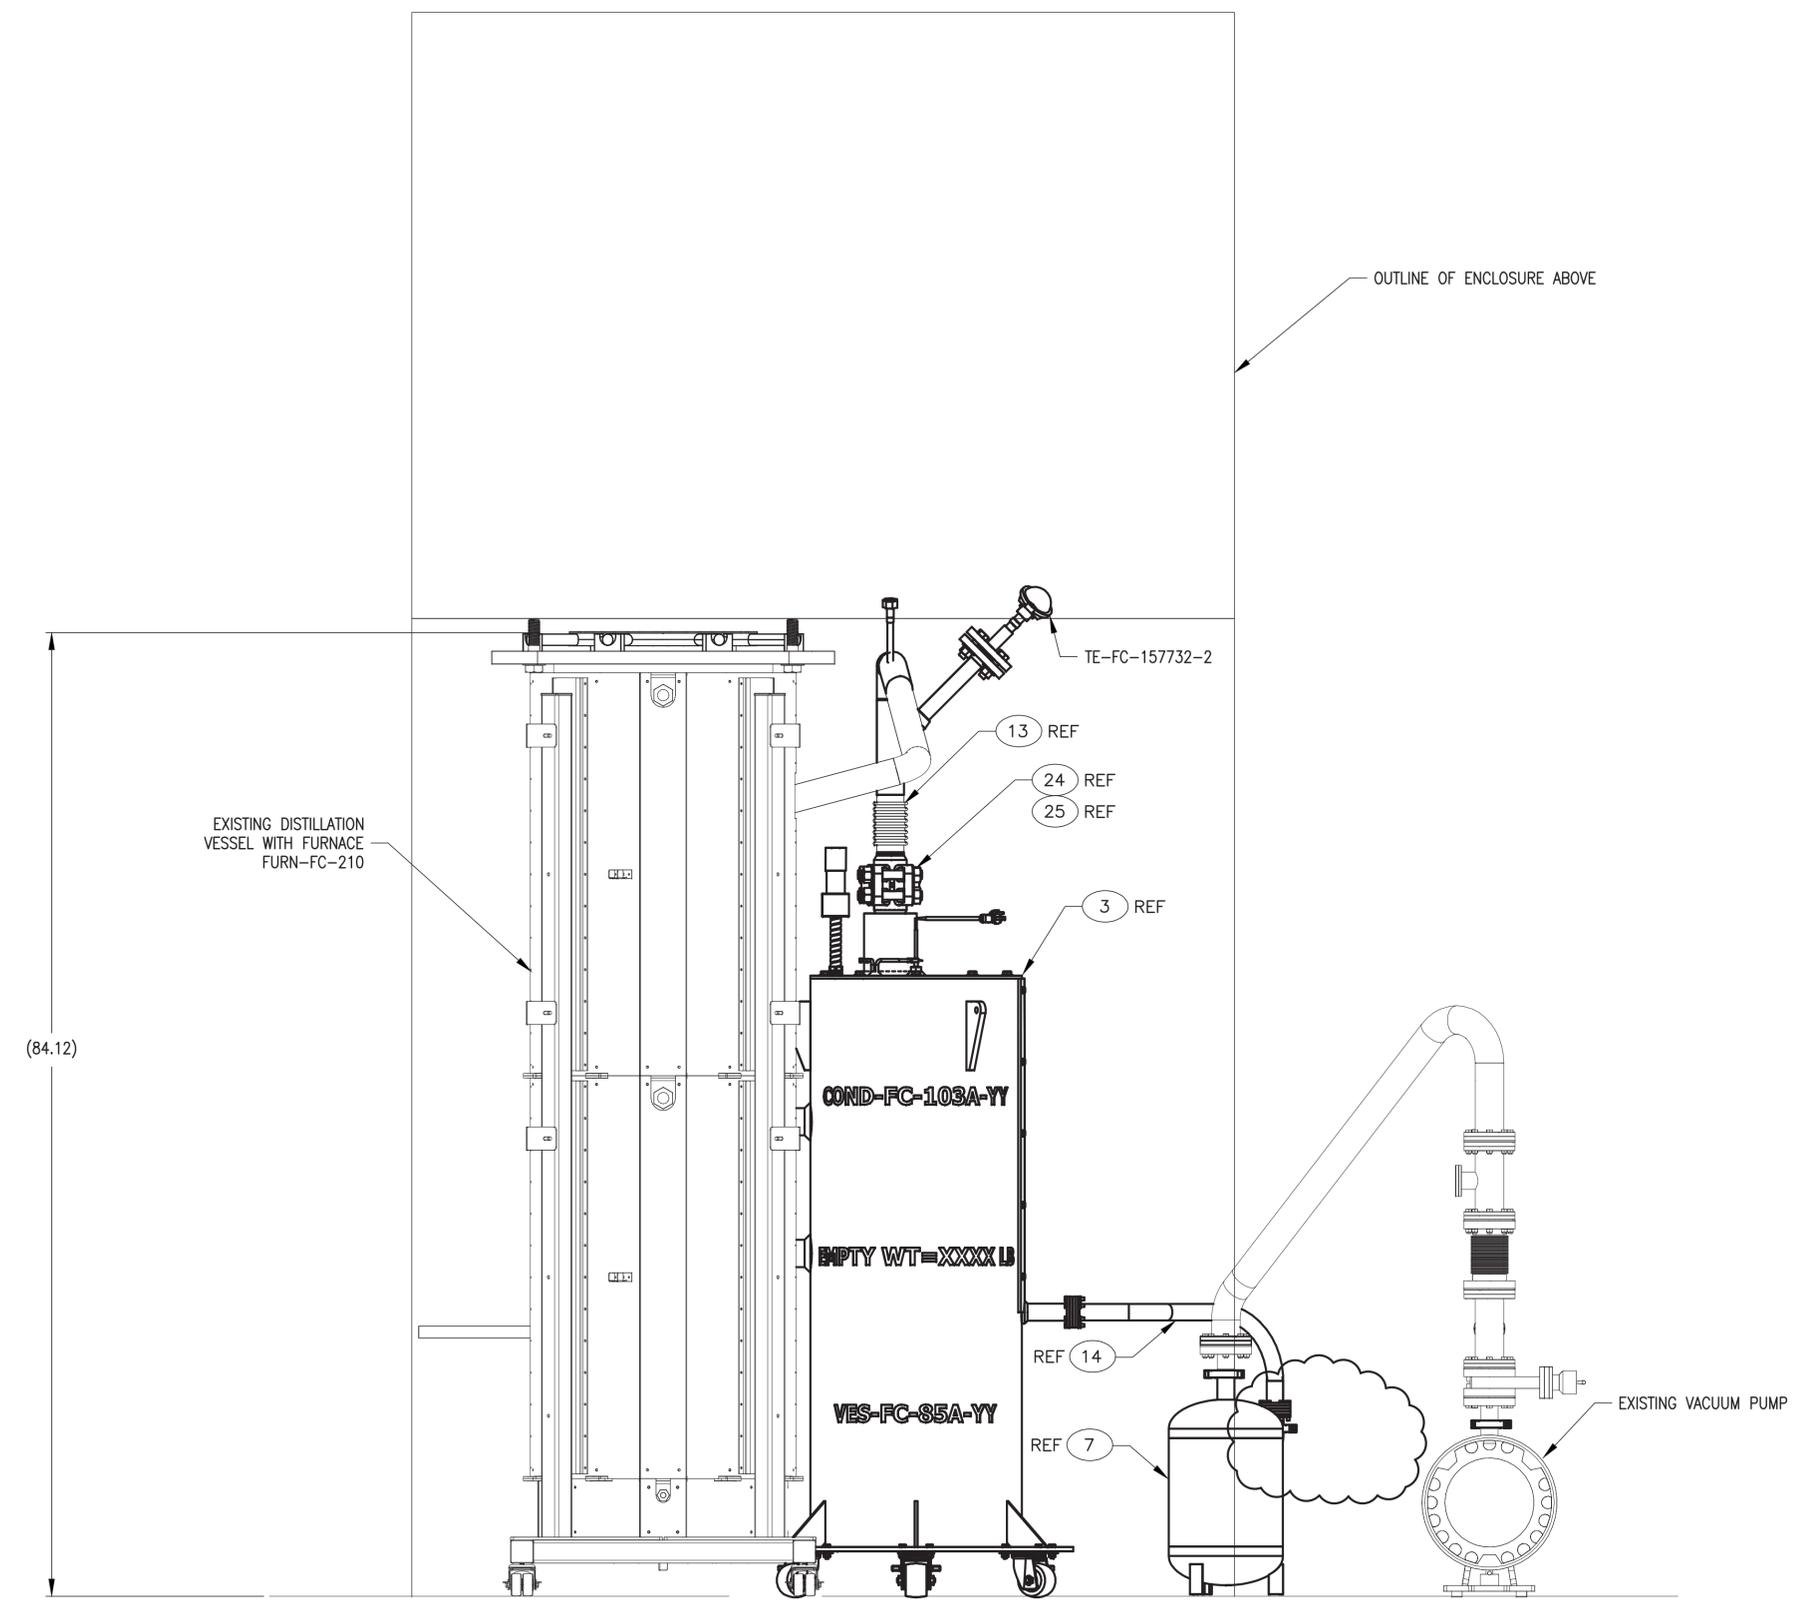

VIEW A-A 
 SCALE: 1/8

SIZE	INDEX CODE	NUMBER	DWG-	571515	REV	2
D	AREA	TYPE	CL	ORIG		
	200	0666	53	136		
SCALE: NOTED				SHEET	3	

File: 571515-2.dwg
 Path: K:\RH-TRU Distillation\Drawings\DRF-346066
 Date: 08/05/15 - 9:42 AM
 Layout Name: Sheet 3
 D: KEYAL

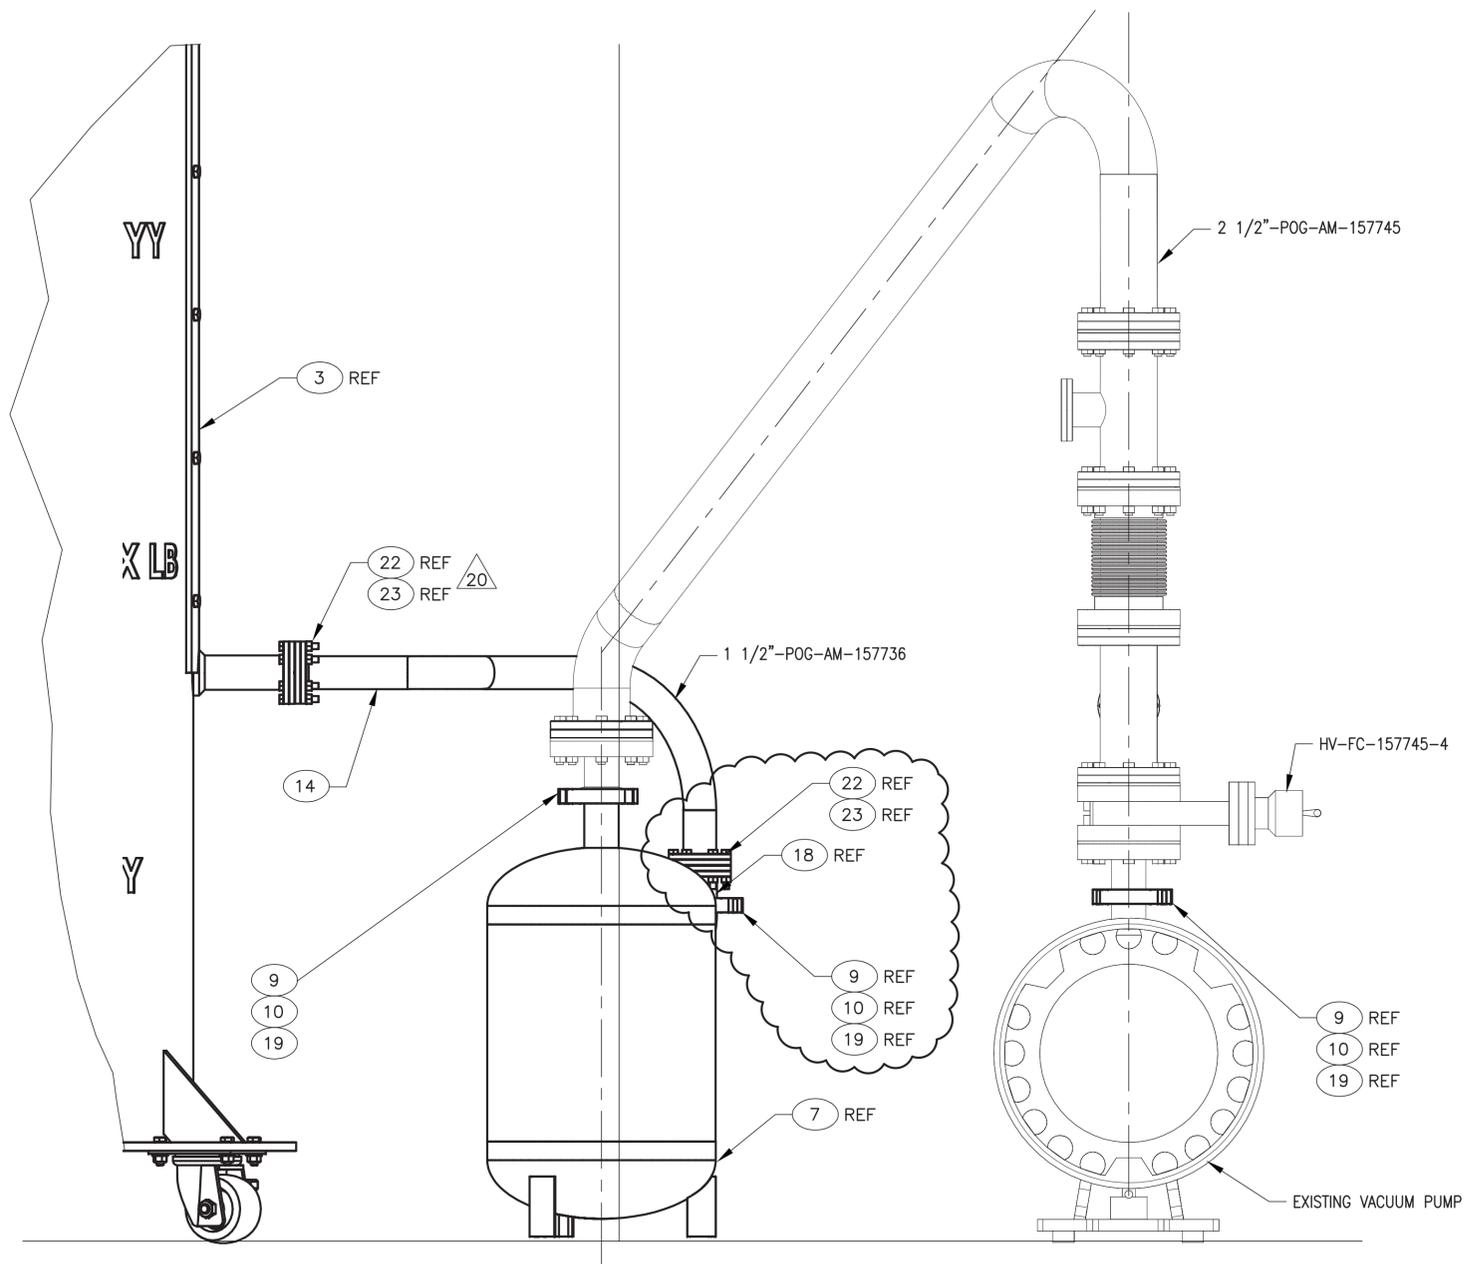

VIEW B-B
SCALE: 1/4

SIZE	INDEX CODE	NUMBER	REV
D	200	0666	53
SCALE: NOTED			DWG- 571515
SHEET 4			2

File: 571515-2.dwg
 Path: K:\RH-TRU Distillation\Drawings\DRF-346066
 Date: 08/05/15 - 9:42 AM
 Layout Name: Sheet 4
 D: KEVAL

8 7 6 5 4 3 2 1

8 7 6 5 4 3 2 1

D
 C
 B
 A

D
 C
 B
 A

D

D

C


C

B

B

A

A

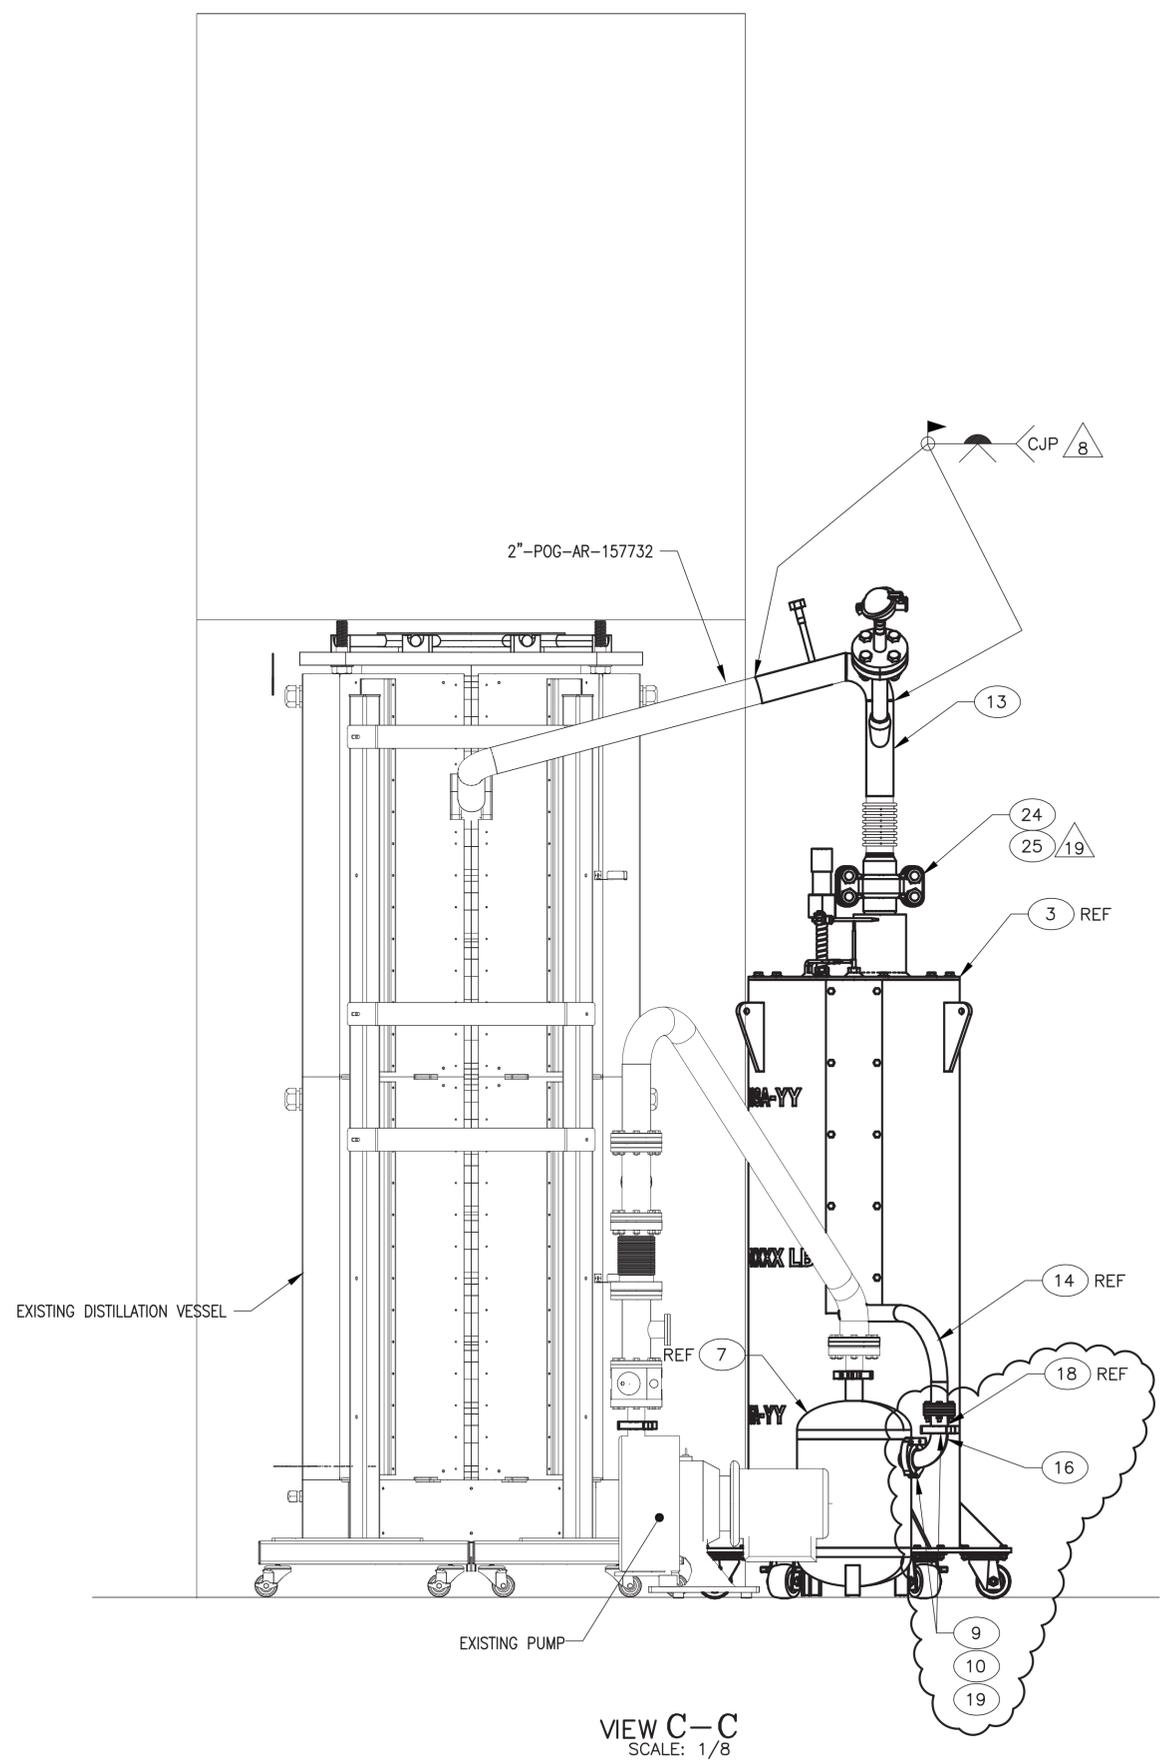


VIEW C-C
SCALE: 1/8

File: 571515-2.dwg
 Path: K:\RH-TRU Distillation\Drawings\DRF-346066
 Date: 08/05/15 - 9:42 AM
 Layout Name: Sheet 5
 D: KEVAL

SIZE	INDEX CODE	NUMBER	DWG-	571515	REV
D	AREA	TYPE	CL	ORIG	2
	200	0666	53	136	
SCALE: NOTED				SHEET	5

EQUIP NO.	(A)	(B)	(C)	(D)	(E)	(F)	(G)	(H)
NAME	DISTILLATION VESSEL	CONDENSER	COLLECTION VESSEL	FILTER	VACUUM PUMP		FURNACE	KNIFE GATE
SIZE	Ø12 3/4" x 6'	Ø10.75" x 30"	Ø10.75" x 15"	Ø10" x 18"	18.56"x13.98"x11.8"		26.5" x 68.5"	66.17"x24.5"x7.38"
VOLUME	34 GALLONS	6 1/2 GALLONS	5 GALLONS	6 GALLONS	70 LB			361 LB
WEIGHT	550 LB	1,195 LB	200 LB					
POWER		460V, 3 PH	460V, 3 PH		460V, 3 PH		208V, 3 PH	230V, 1 PH
HEAT INPUT	32 kW	XX kW	2 kW					
RATING					17.7 SCFM		30 kW	
DESIGN TEMP	1250° F	800° F	400° F	300° F			1200° F	1200° F
DESIGN PRESS	±15 PSIG	150 PSIG	±15 PSIG	±15 PSIG	7 mTORR			±15 PSIG
WAI DATA REQ'D								

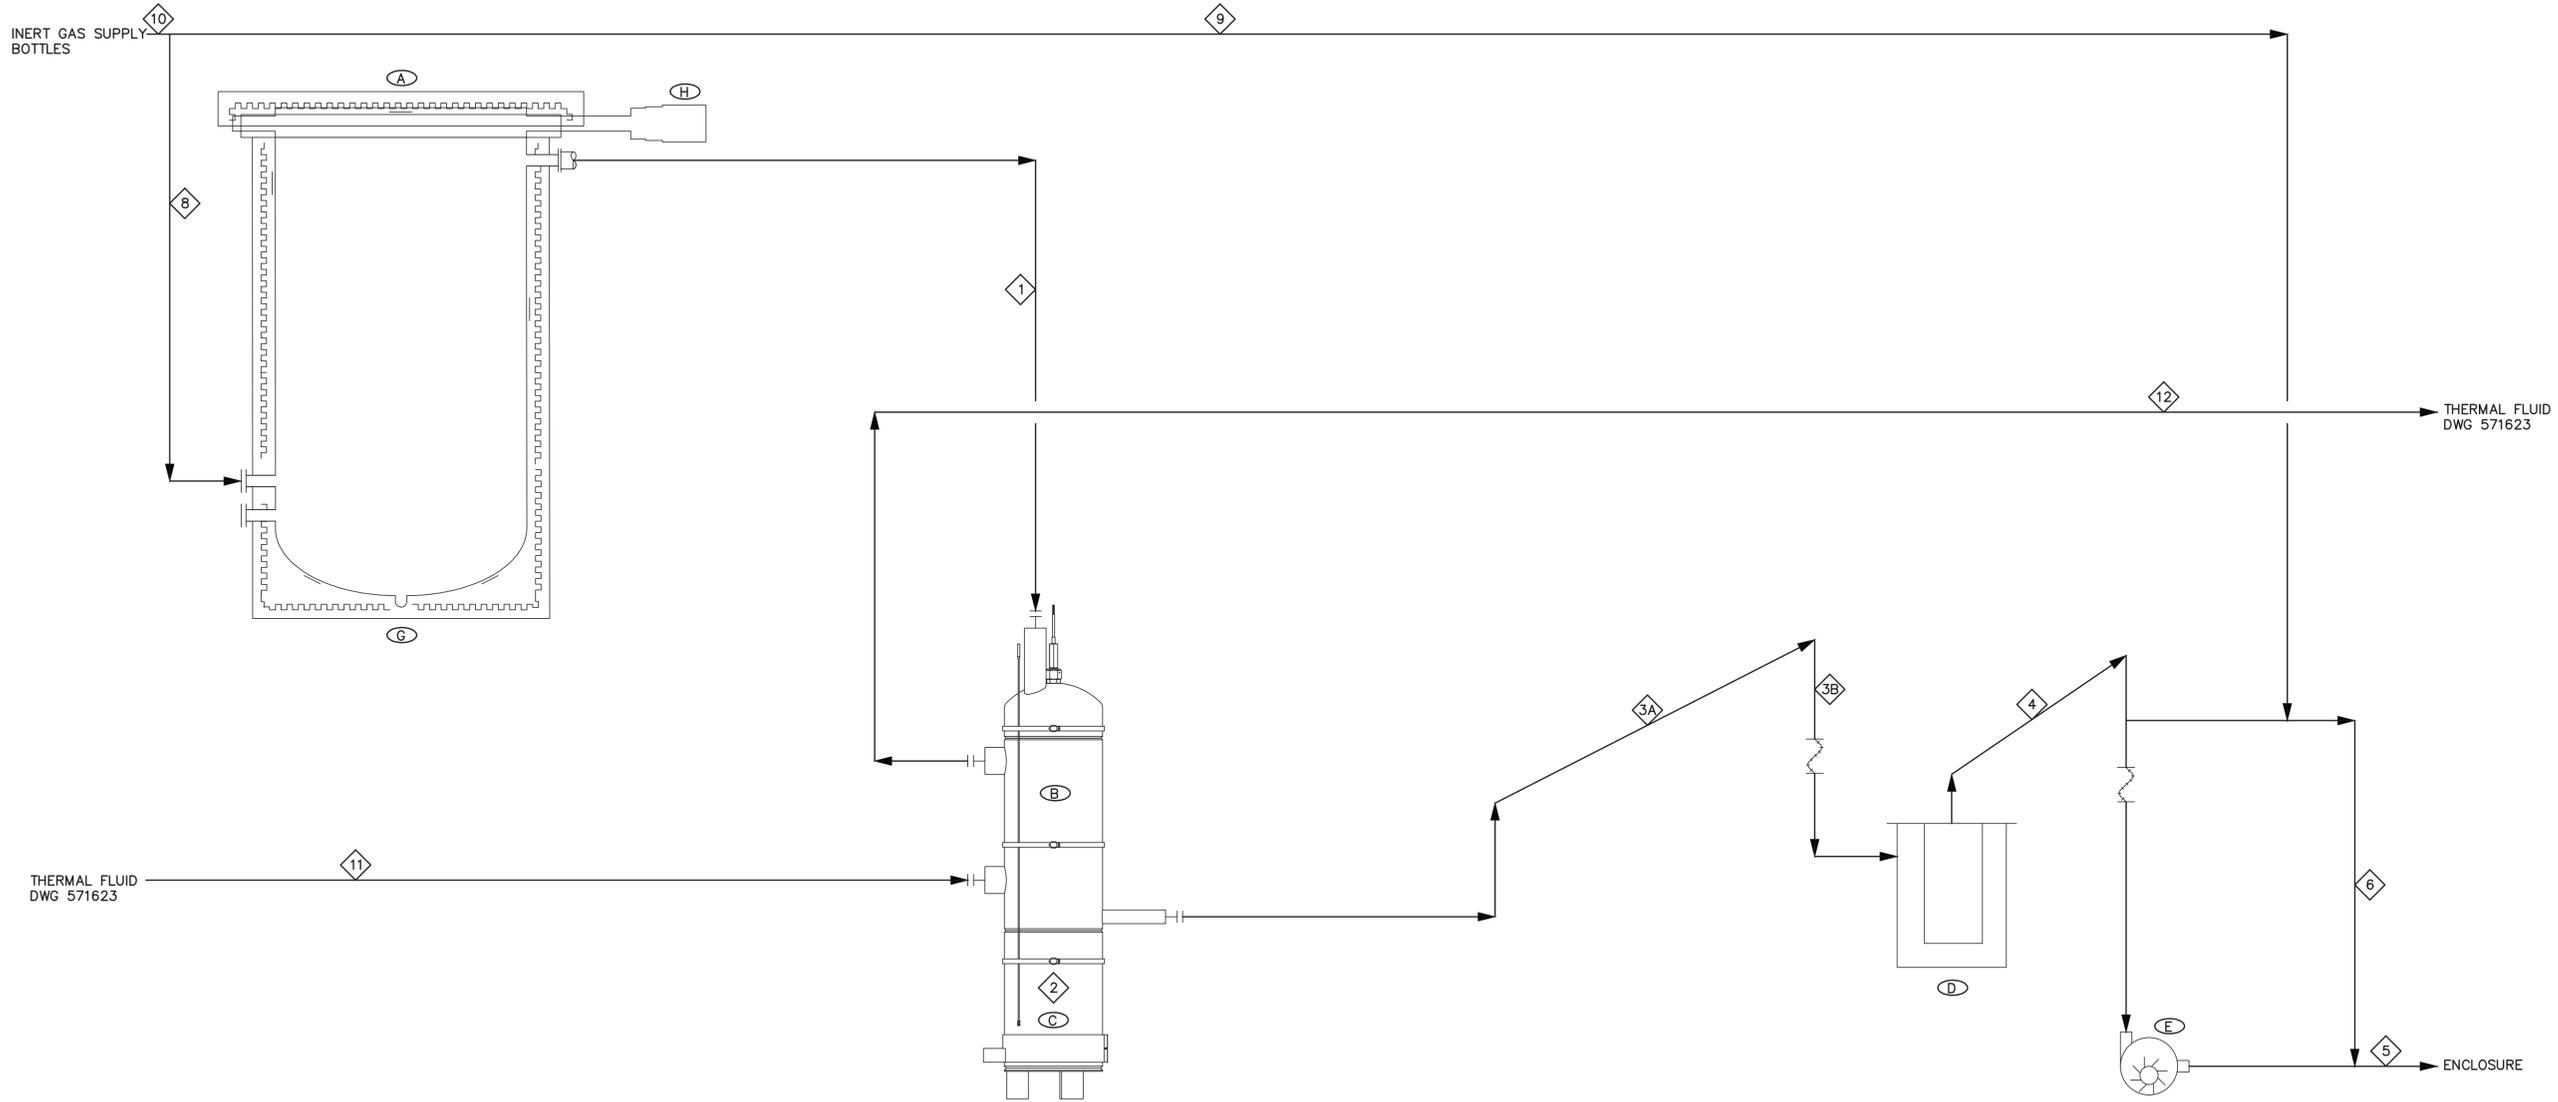

STREAM NO.		1	2	3A	3B	4	5	6	7	8	9	10	11	12
STREAM NAME		SODIUM VAPOR TO CONDENSER	SODIUM TO COLLECTION VESSEL	COLLECTION VESSEL TO FILTER	COLLECTION VESSEL TO FILTER	FILTER TO PUMP	SUSPECT EXHAUST	VACUUM PUMP BYPASS		INERT GAS PURGE TO DISTILLATION VESSEL	INERT GAS PURGE TO VACUUM LINES	TOTAL INERT GAS	THERMAL FLUID TO CONDENSER	THERMAL FLUID FROM CONDENSER
VARIABLE	UNITS													
DESIGN PRESSURE	psia	0-27.4	0-27.4	0-27.4	0-27.4	0-27.4	27.4	15.4		27.4	27.4		165	165
DESIGN TEMPERATURE	°F	1200	400	400	300	200	200	200					350	350
GAS VOL. FLOW	ACFM SCFM	17.7	17.7	17.7	17.7	17.7	17.7				1-2	15		
LIQUID MASS FLOW								10		10				
LIQUID VOL. FLOW	gpm												40	40
SPEC. GRAVITY													0.93	0.93
WAI DATA REQUIRED														

NOTES

1. ATMOSPHERIC PRESSURE AT INTEC IS 12.4 PSIA.



I CERTIFY THE CHANGES SHOWN ON THIS DRAWING REFLECT THE CURRENT CONSTRUCTED CONDITION AS OF 07/15/2015

REV	DESCRIPTION	DATE
1	INCORP'D CDC-10492. SEE DRG-346066	

Idaho Cleanup Project
CPP-666

HEMANG
IDAH0, LLC


RH-TRU SODIUM DISTILLATION SYSTEM
CONDENSER/COLLECTION VESSEL

PROCESS FLOW DIAGRAM

SIGNATURES/DATES APPLY TO CURRENT RELEASE ONLY	
DESIGN:	SIGN AND DATE
R. CAMPBELL	Rodney C. Campbell 2015.08.05 14:47:04 -0600'
A. KEY	Angela L. Key Nuclear Technology 2015.08.05 15:01:57 -0600'
T. BURNETT, P.E.	Troy P. Burnett Walsh Engineering 2015.08.05 15:12:27 -0600'
R. EASTMAN, P.E.	Randy Eastman CWI 2015.08.05 16:19:04 -0600'
D. MORGAN	David Morgan CWI 2015.08.05 14:52:05 -0600'
S. BERTHELSON	Shawn Berthelson CWI 2015.08.05 17:23:04 -0600'

NO SCALE

DESIGN PHASE:	AFC
QUALITY LEVEL:	3
HORIZONTAL SCALE:	NONE
VERTICAL SCALE:	NA
FOR DRAWING INDEX SEE DRAWING NO.	571500
PROJECT NUMBER:	31720
INDEX CODE NUMBER	AREA TYPE CL ORIG
	200 0666 24 136
SIZE	D
DWG-	571505
REV	1
DRF NO.	343942
SHEET	PF-1

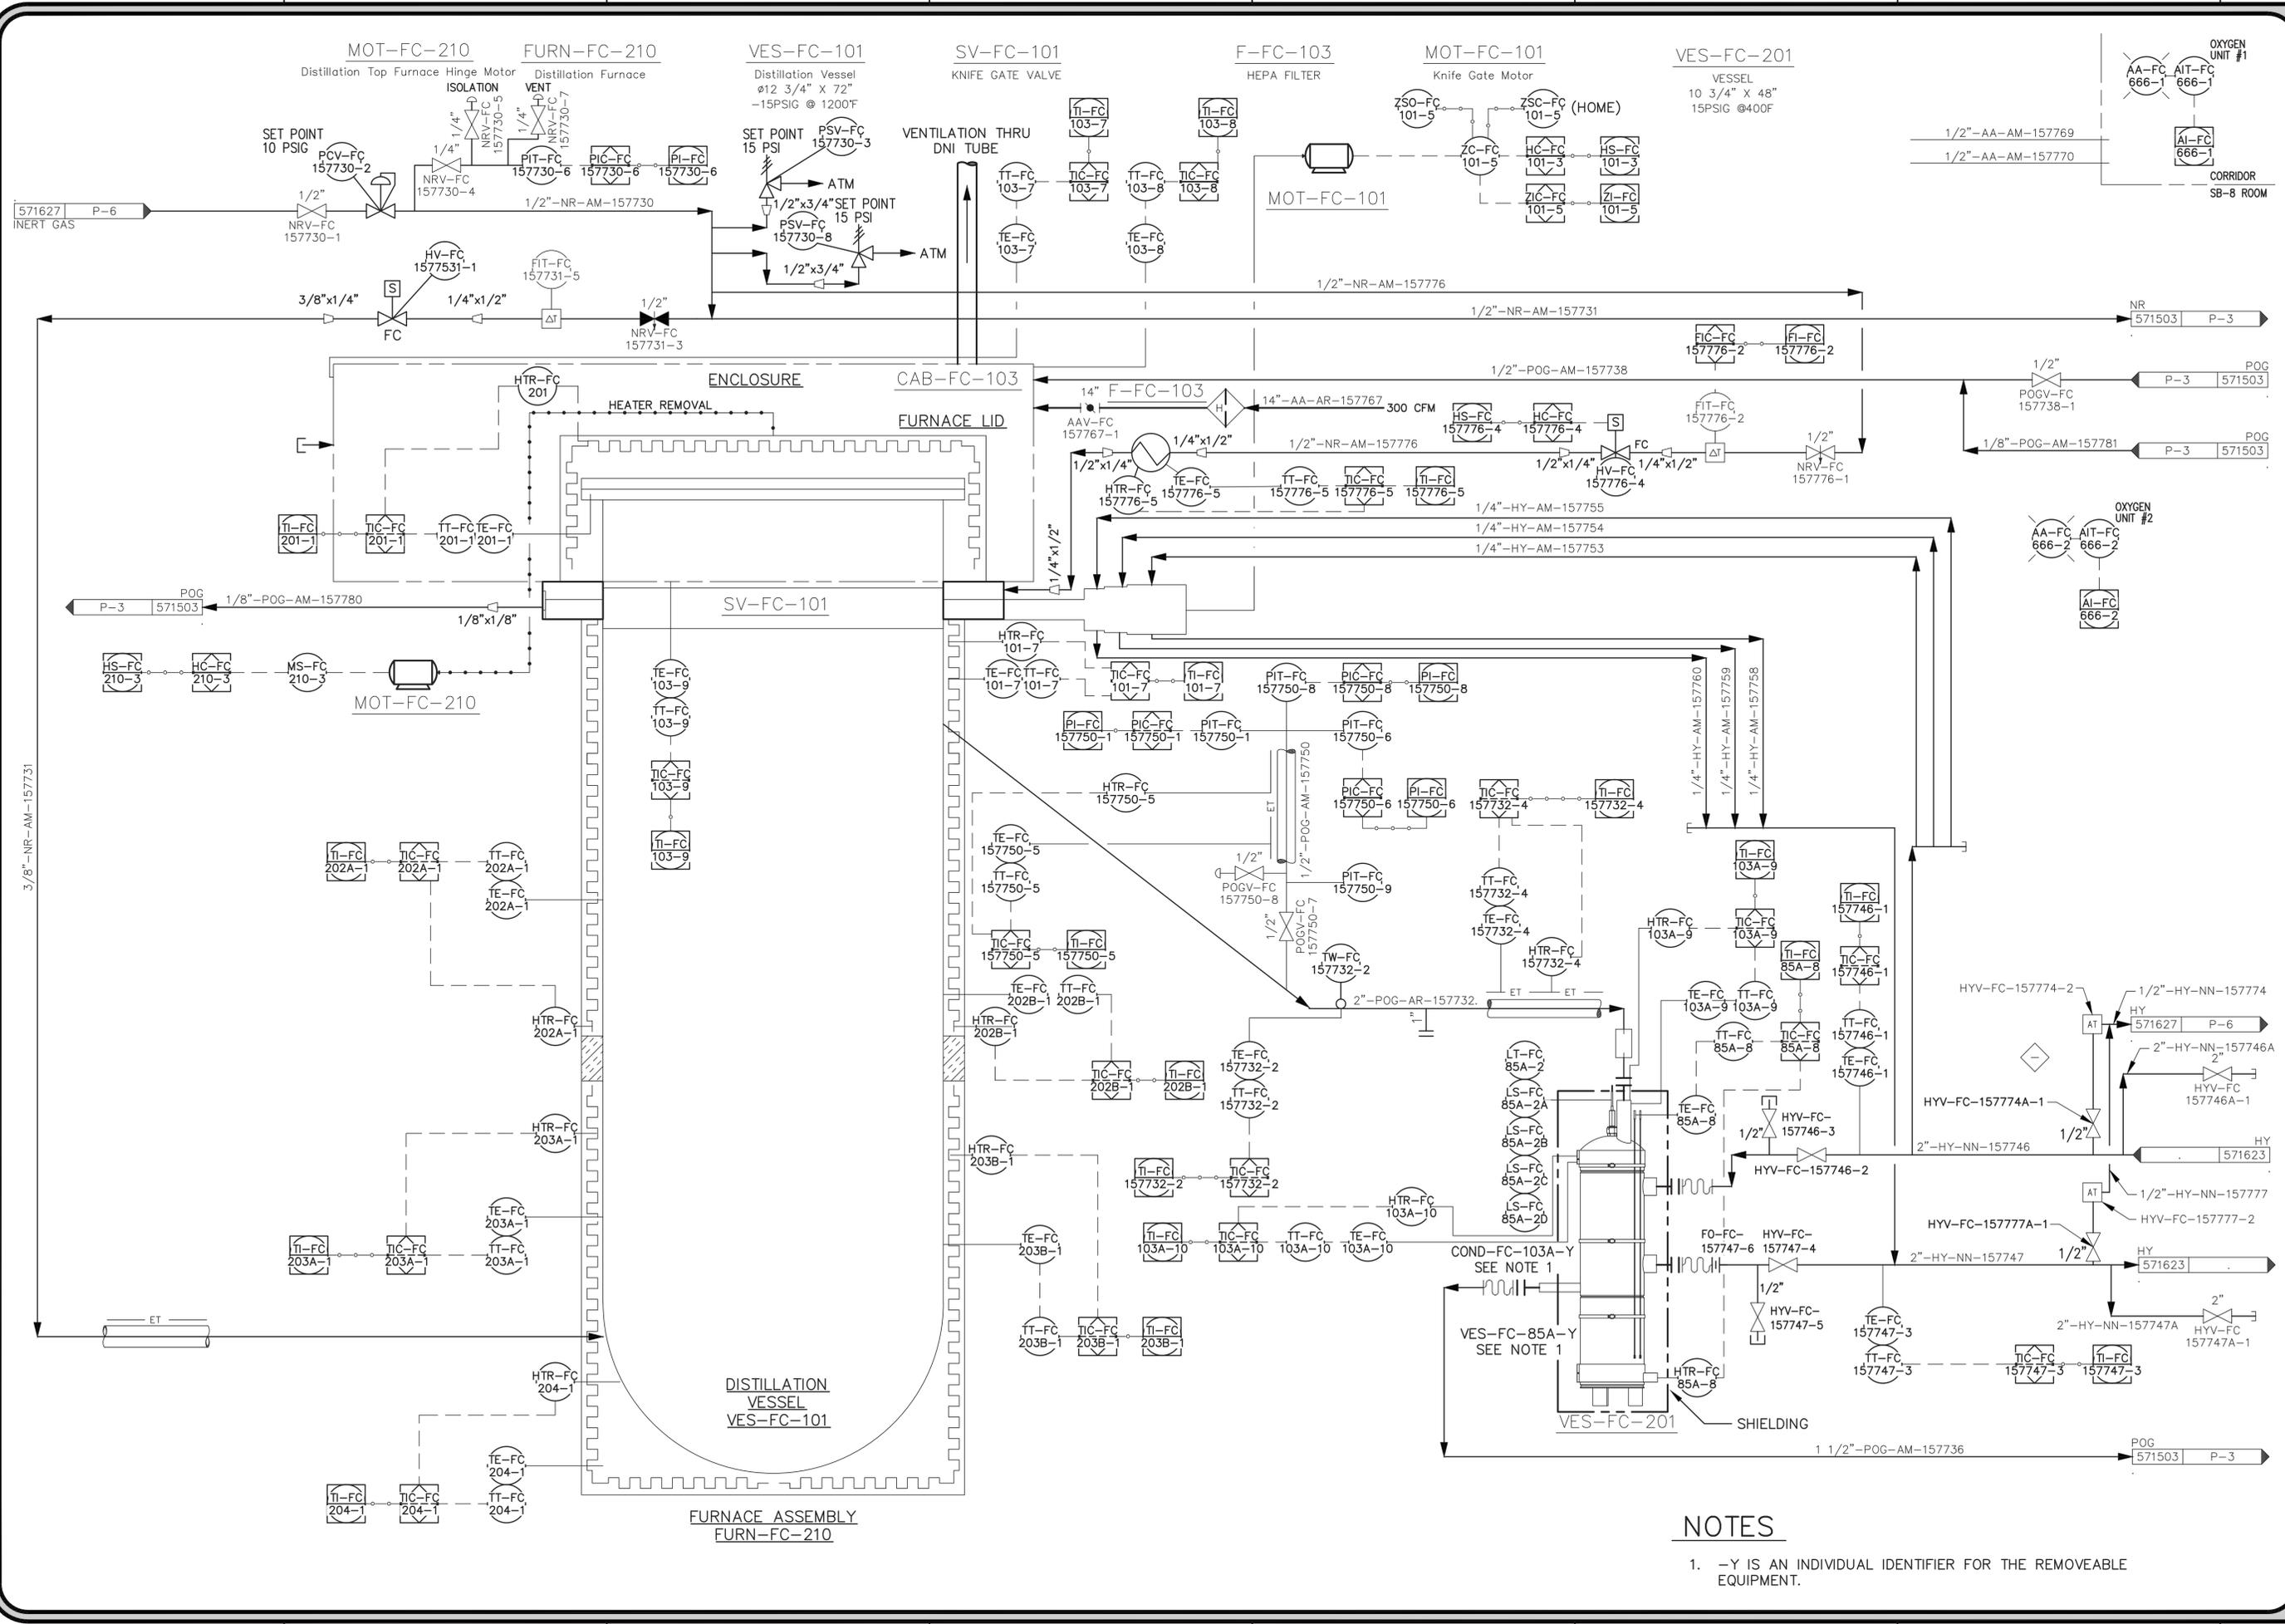

NOTES

- Y IS AN INDIVIDUAL IDENTIFIER FOR THE REMOVEABLE EQUIPMENT.

REV	DESCRIPTION
1	INCORP'D FCC-10251 AND 10267, SEE DRG-344903
2	INCORP'D FCC-10473, SEE DRG-346066
3	AS-BUILT AS OF 12/08/2016, INCORP'D FCC-1046, SEE DRG-352417


Idaho Cleanup Project
Fluor IDAHO
 CPP-666
RH-TRU SODIUM DISTILLATION SYSTEM
CONDENSER/COLLECTION VESSEL
 DISTILLATION VESSEL AND CONDENSER
 PIPING AND INSTRUMENTATION DIAGRAM

SIGNATURES/DATES APPLY TO CURRENT RELEASE ONLY	
DESIGNER:	SIGN AND DATE
NA	-
DRAFTER:	Jim Moncur Fluor Idaho 2016.12.13 07:20:09 -0700
TECHNICAL CHECK:	-
ENG GROUP SUPERVISOR:	-
DESIGN LEAD/AUTHORITY:	David Morgan Fluor Idaho, Inc 2016.12.13 09:42:12 -0700
DRAFTING CHECK/EFFECTIVE DATE:	Kris Keller Fluor Idaho 2016.12.13 09:59:53 -0700

NO SCALE

DESIGN PHASE:	
QUALITY LEVEL:	3
HORIZONTAL SCALE:	NONE
VERTICAL SCALE:	NA
FOR DRAWING INDEX SEE DRAWING NO.	571500
PROJECT NUMBER:	31720
INDEX CODE NUMBER:	AREA TYPE CL ORIG
	200 0666 24 136
SIZE:	D
DWG-NO:	571501
SHEET:	P-1
REV:	3
DRF-NO:	343942

File: 571501 P-1.dwg Date: 12/12/16 7:19 AM Layout Name: 571624
 Pat: K:\RH-TRU Distillation\Drawing\&IDS\CPP-666 CONDENSOR\ID_DWG

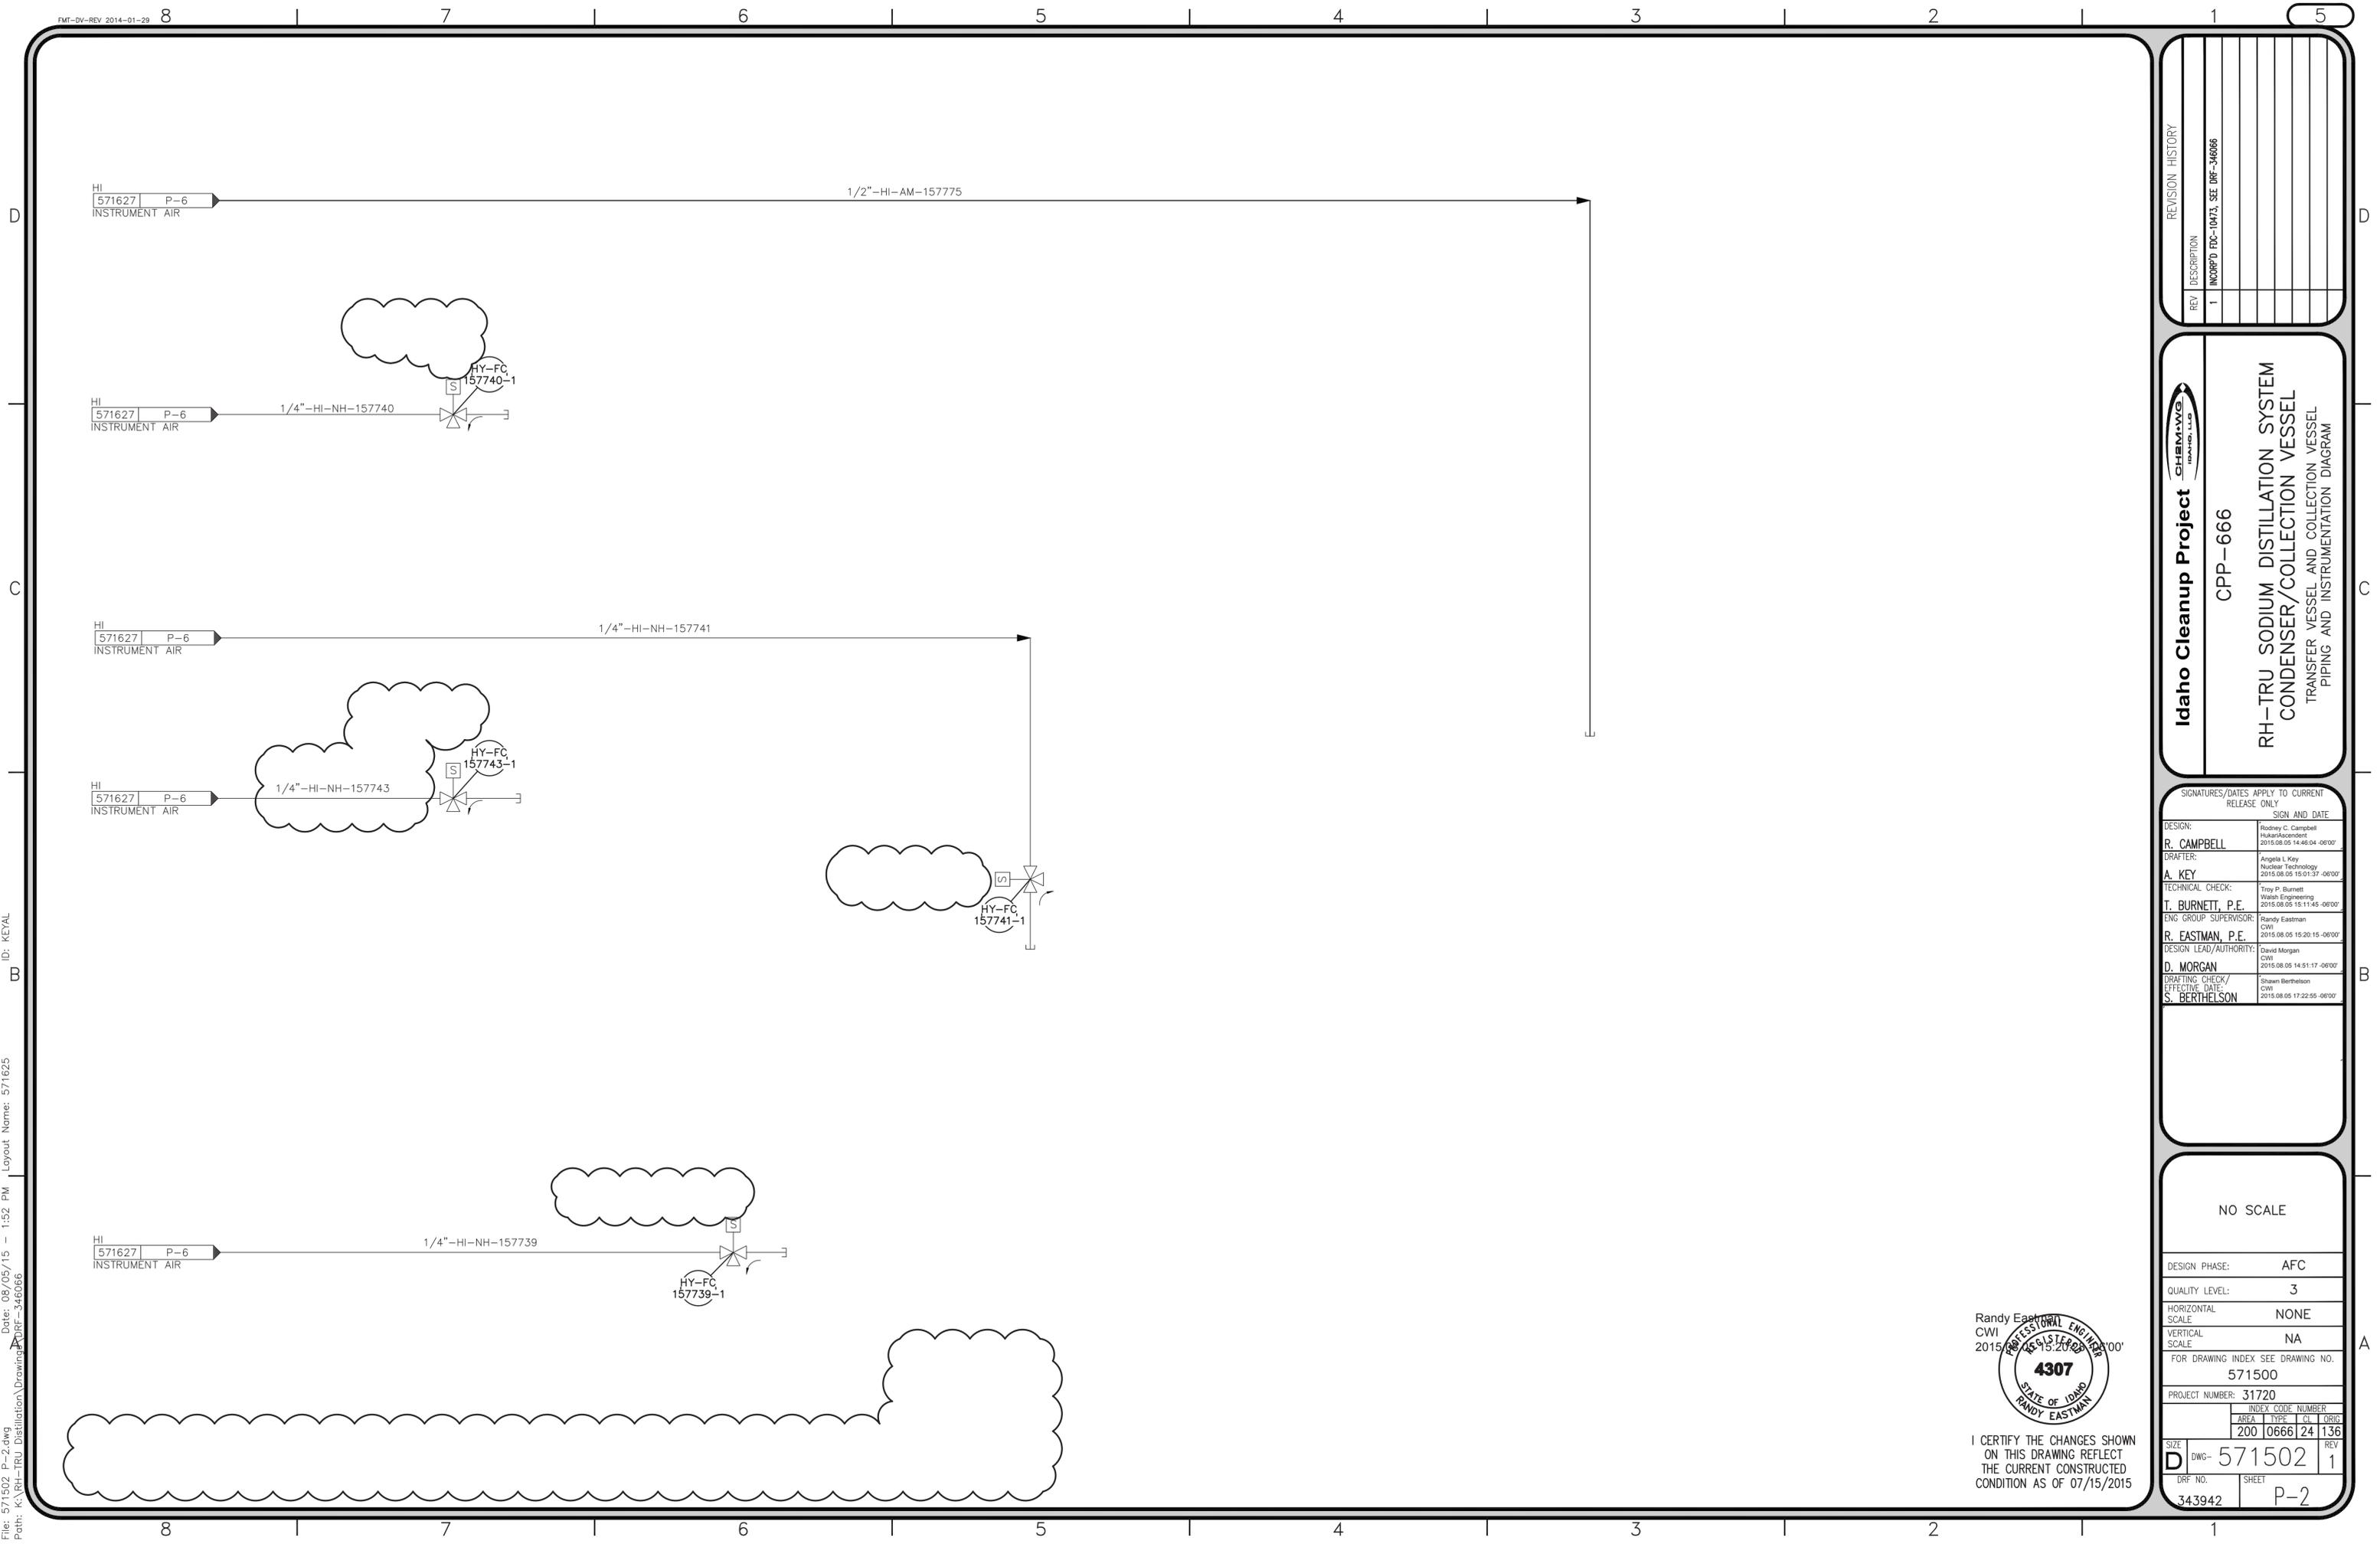

REV	DESCRIPTION
1	INCORP'D FCC-10473. SEE DRP-346066

Idaho Cleanup Project
CPP-666

RH-TRU SODIUM DISTILLATION SYSTEM
CONDENSER/COLLECTION VESSEL
TRANSFER VESSEL AND COLLECTION VESSEL
PIPING AND INSTRUMENTATION DIAGRAM

SIGNATURES/DATES APPLY TO CURRENT RELEASE ONLY	
DESIGN:	SIGN AND DATE
R. CAMPBELL	Rodney C. Campbell HukarAscendent 2015.08.05 14:46:04 -0600
A. KEY	Angela L. Key Nuclear Technology 2015.08.05 15:01:37 -0600
T. BURNETT, P.E.	Troy P. Burnett Walsh Engineering 2015.08.05 15:11:45 -0600
R. EASTMAN, P.E.	Randy Eastman CWI 2015.08.05 15:20:15 -0600
D. MORGAN	David Morgan CWI 2015.08.05 14:51:17 -0600
S. BERTHELSON	Shawn Bertelson CWI 2015.08.05 17:22:55 -0600


NO SCALE

DESIGN PHASE:	AFC
QUALITY LEVEL:	3
HORIZONTAL SCALE:	NONE
VERTICAL SCALE:	NA
FOR DRAWING INDEX SEE DRAWING NO.	571500
PROJECT NUMBER:	31720
INDEX CODE NUMBER	AREA TYPE CL ORIG
	200 0666 24 136
SIZE	DWG- 571502 REV 1
DRP NO.	SHEET P-2
343942	



I CERTIFY THE CHANGES SHOWN ON THIS DRAWING REFLECT THE CURRENT CONSTRUCTED CONDITION AS OF 07/15/2015

File: 571502 P-2.dwg
 Patn: K:\RH-TRU Distillation\Drawing
 Date: 08/05/15 - 1:52 PM
 Layout Name: 571625
 ID: KEYAL

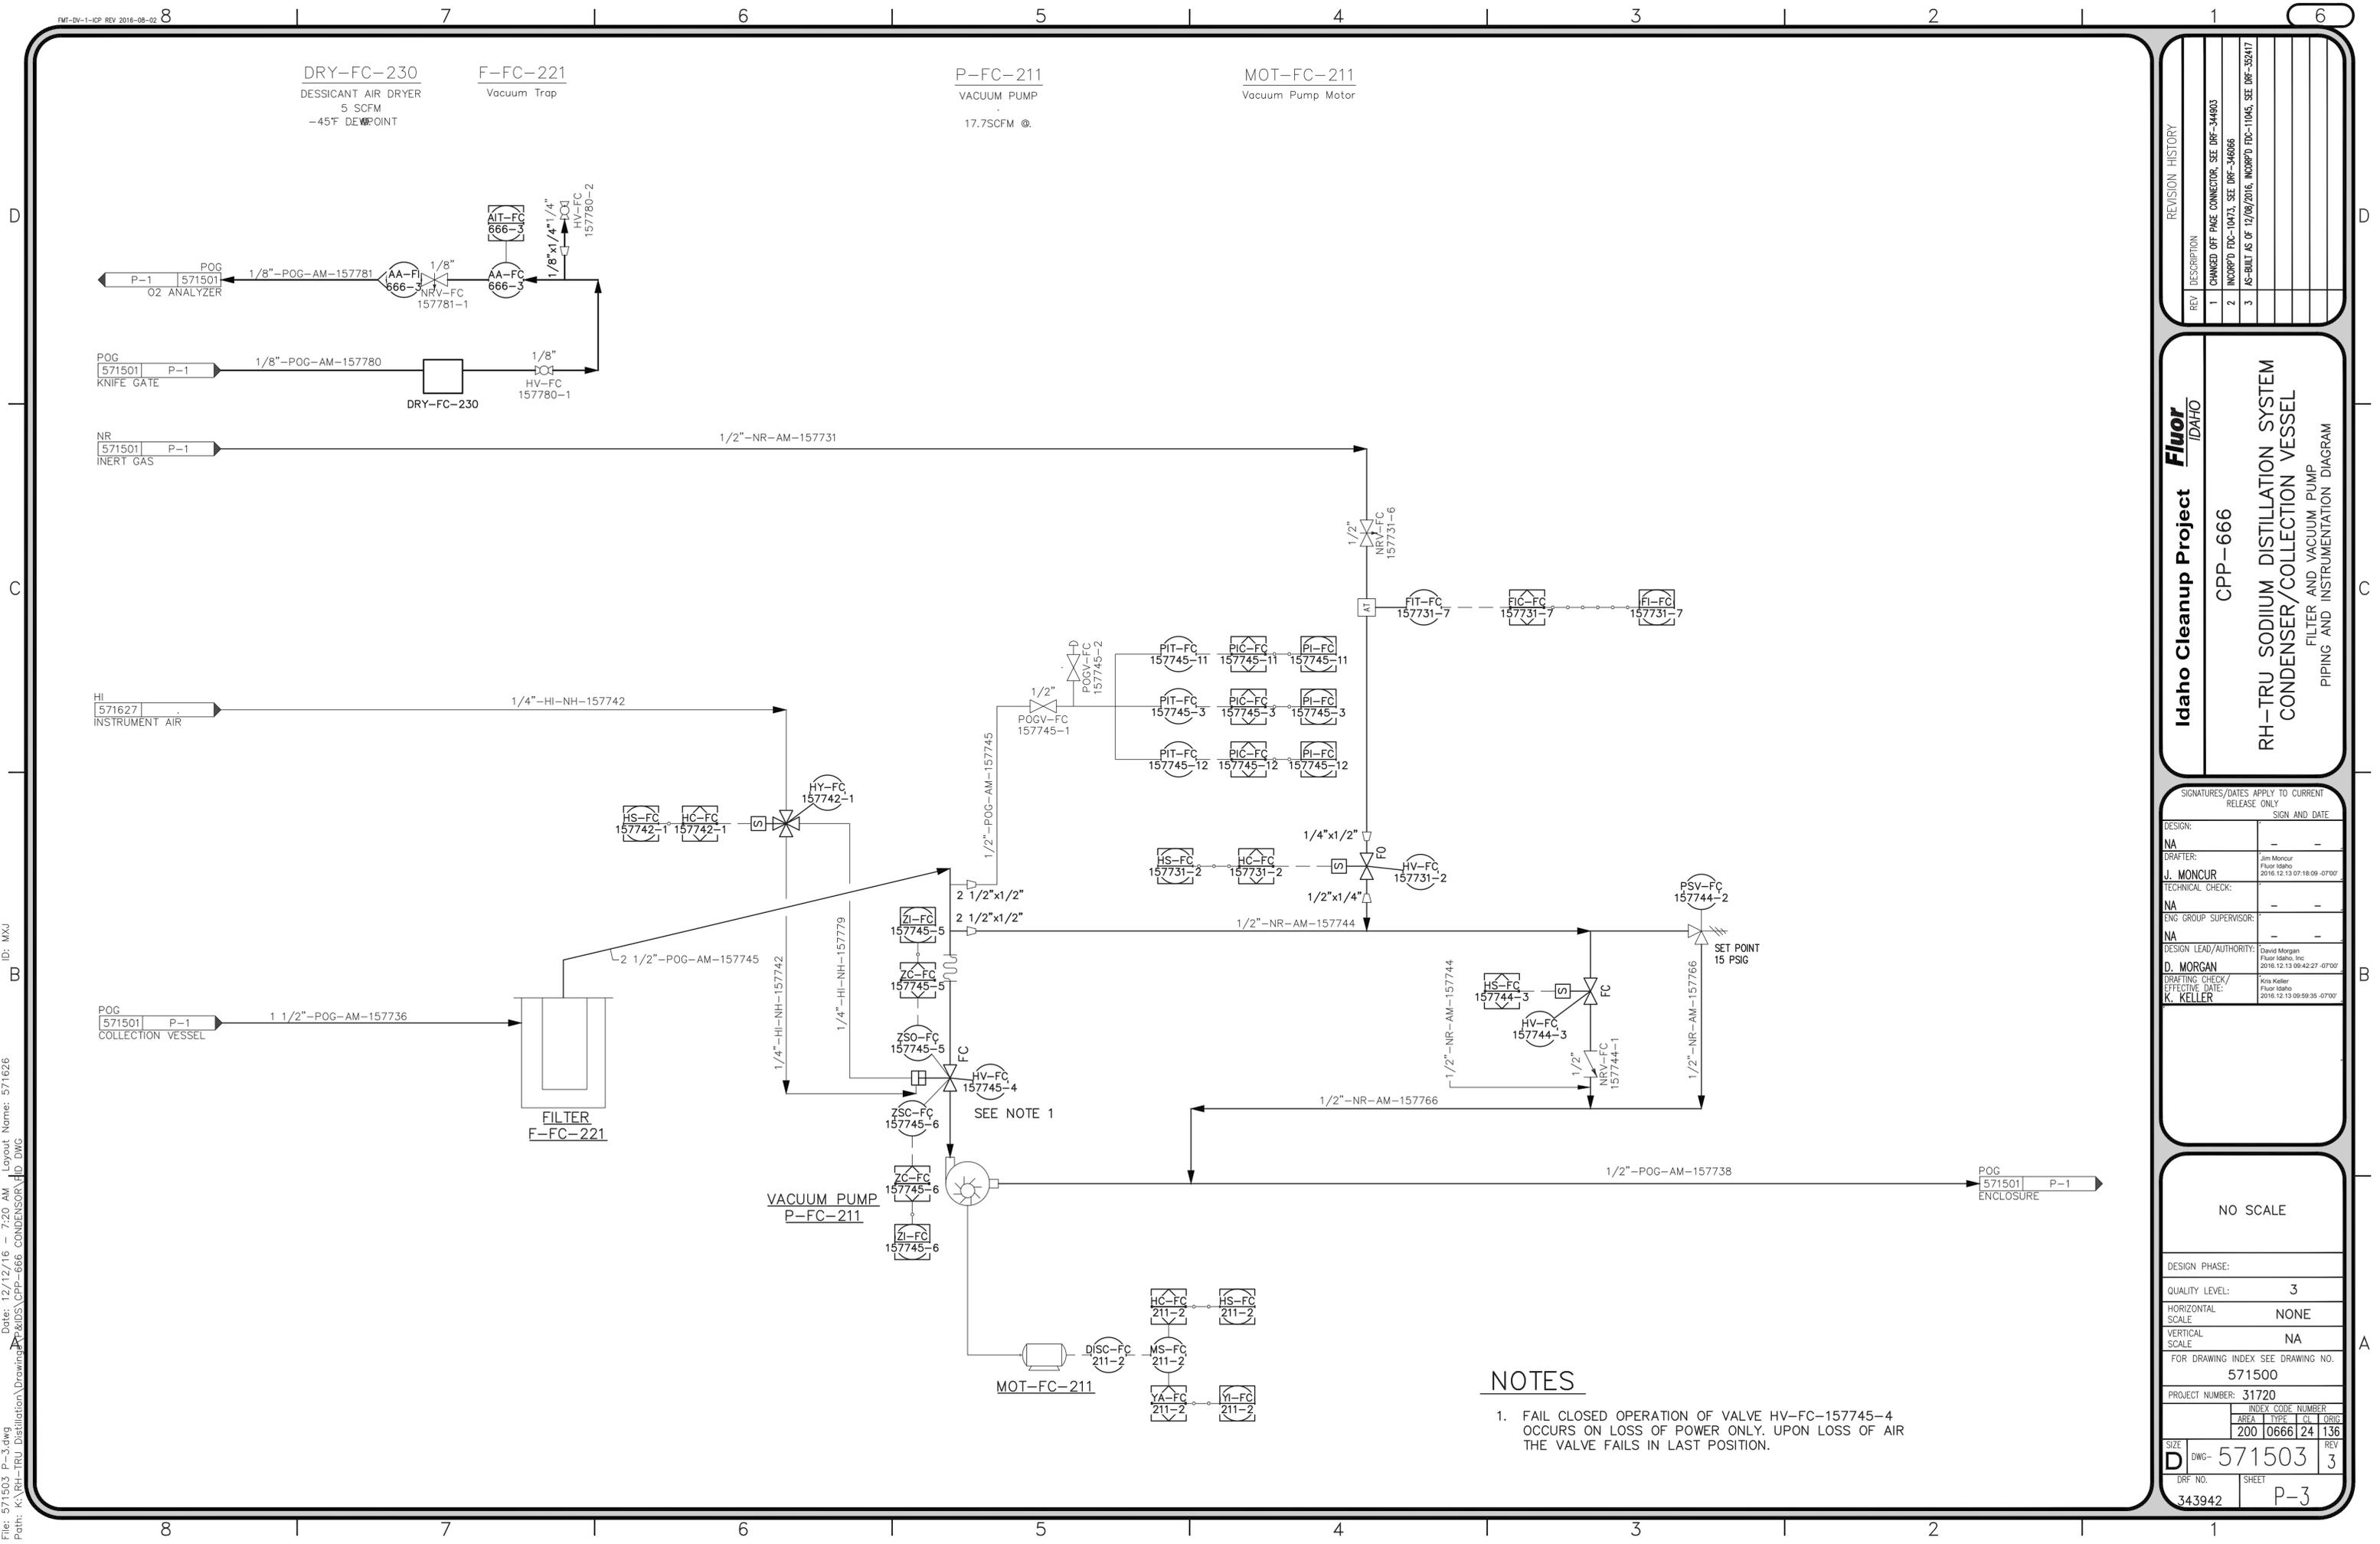

DRY-FC-230
DESSICANT AIR DRYER
5 SCFM
-45°F DEWPOINT

F-FC-221
Vacuum Trap

P-FC-211
VACUUM PUMP
17.7SCFM @

MOT-FC-211
Vacuum Pump Motor

REV	DESCRIPTION	REVISION HISTORY
1	CHANGED OFF PAGE CONNECTOR, SEE DRP-344803	
2	INCORPORATED FDC-10473, SEE DRP-346086	
3	AS-BUILT AS OF 12/08/2016, INCORPORATED FDC-11046, SEE DRP-352417	

Idaho Cleanup Project
IDaho
CPP-666

RH-TRU SODIUM DISTILLATION SYSTEM
CONDENSER/COLLECTION VESSEL
FILTER AND VACUUM PUMP
PIPING AND INSTRUMENTATION DIAGRAM

SIGNATURES/DATES APPLY TO CURRENT RELEASE ONLY	
DESIGN:	SIGN AND DATE
NA	- -
DRAFTER:	Jim Moncur Fluor Idaho 2016.12.13 07:18:09 -0700
TECHNICAL CHECK:	NA
ENG GROUP SUPERVISOR:	NA
DESIGN LEAD/AUTHORITY:	David Morgan Fluor Idaho, Inc 2016.12.13 09:42:27 -0700
DRAFTING CHECK/EFFECTIVE DATE:	Kris Keller Fluor Idaho 2016.12.13 09:59:35 -0700

NO SCALE

DESIGN PHASE:			
QUALITY LEVEL:	3		
HORIZONTAL SCALE:	NONE		
VERTICAL SCALE:	NA		
FOR DRAWING INDEX SEE DRAWING NO.	571500		
PROJECT NUMBER:	31720		
INDEX CODE NUMBER			
AREA	TYPE	CL	ORIG
200	0666	24	136
SIZE	DWG-	571503	REV
D			3
DRP NO.	SHEET		
343942	P-3		

NOTES

1. FAIL CLOSED OPERATION OF VALVE HV-FC-157745-4 OCCURS ON LOSS OF POWER ONLY. UPON LOSS OF AIR THE VALVE FAILS IN LAST POSITION.

File: 571503 P-3.dwg
 Date: 12/12/16 - 7:20 AM
 Pat: K:\RH-TRU Distillation\Drawing\&IDS\CPP-666 CONDENSOR\ID_DWG

ID: MXU
 B
 C
 D

A
 B
 C
 D

NOTES:

- 1. REMOVE ALL BURRS AND SHARP EDGES.
- 2. ALL MACHINED FILLET RADII .030 MAXIMUM UNLESS OTHERWISE NOTED.
- 3. FINAL ASSEMBLY SHALL BE FREE OF DIRT, CHIPS, WELDING FLUX, SLAG, SCALE OIL, GREASE, ETC. PERFORM A VISUAL INSPECTION ON THE FINAL ASSEMBLY PER ASTM A380, PARA 7.2.1 FOR OFF-SITE FABRICATION OR FINAL ASSEMBLY SHALL MEET CLEANLINESS REQUIREMENTS OF STD-7022, LEVEL D FOR ON-SITE FABRICATION.
- 4. WELDING SHALL BE PERFORMED IN ACCORDANCE WITH ASME B&PV CODE SECTION IX USING ITEM 9 FOR OFF-SITE FABRICATION OR WELD PER INL WELD PROCEDURE SPECIFICATION S2.0 USING ITEM 9 FOR ON-SITE FABRICATION.
- 5. VISUALLY INSPECT ALL WELDS IN ACCORDANCE WITH ASME B&PV CODE, SECTION V, ARTICLE 9 FOR OFF-SITE FABRICATION OR VISUALLY INSPECT ALL WELDS IN ACCORDANCE WITH TPR-4981 "VISUAL EXAMINATION" FOR PRESSURE VESSELS. ACCEPTANCE CRITERIA SHALL BE PER APPENDIX B, "ACCEPTANCE CRITERIA FOR ASME CODE, SECTION VIII, DIVISION 1 WELDS, BASE MATERIALS AND BRAZING" FOR ON-SITE FABRICATION.
- 6. LIQUID PENETRANT EXAMINATION FOR OFF-SITE FABRICATION SHALL BE PERFORMED IN ACCORDANCE WITH THE B&PV CODE SECTION V ARTICLE 6. ACCEPTANCE CRITERIA SHALL BE:
 - A. ALL SURFACES TO BE EXAMINED SHALL BE FREE OF:
 - I. RELEVANT LINEAR INDICATIONS
 - II. RELEVANT ROUNDED INDICATIONS GREATER THAN 5 MM (3/16")
 - III. FOUR OR MORE RELEVANT ROUNDED INDICATIONS IN A LINE SEPARATED BY 1.5 MM (1/16") OR LESS, EDGE-TO-EDGE.
 - B. CRACK LIKE INDICATIONS DETECTED, IRRESPECTIVE OF SURFACE CONDITIONS, ARE UNACCEPTABLE.

LIQUID PENETRANT EXAMINATION FOR ON-SITE FABRICATION SHALL BE PERFORMED ON ALL WELDS IN ACCORDANCE WITH TPR-4975 "LIQUID PENETRANT EXAMINATION," APPENDIX G, WITH ACCEPTANCE PER APPENDIX G, "ACCEPTANCE CRITERIA FOR ASME SECTION VIII WELDS." USE LIQUID PENETRANT EXAMINATION OF ROOT AND FINAL PASS FOR BUTT WELDS AND FINAL PASS FOR FILLET WELDS.

- 7. MARK PER STD-7006-2A OR STD-7006-2D IN 1 1/2" HIGH CHARACTERS WITH INFORMATION AS SHOWN WHERE "YY" IS THE UNIQUE NUMBER ASSIGNED TO EACH ASSEMBLY BUILT AND "XXXX" IS THE MEASURED WEIGHT OF THE -0 ASSEMBLY TO THE NEAREST POUND. LOCATE APPROXIMATELY WHERE SHOWN. FILL CHARACTERS WITH SANFORD T.E.C. MARKER #13401 OR #13501, ITW DYMON FORMULA Q404 INK OR OTHER HIGH-PURITY LOW-CHLORIDE BLACK INK THAT COMPLIES WITH ASTM C1217-00 OR RDT F7-3T. DO NOT APPLY VARNISH OVER MARKING.

- 8. VERIFY MARKINGS HAVE BEEN ACCURATELY APPLIED AND RECORD THE MEASURED WEIGHT.
- 9. BOLT TORQUES:
 - TORQUE 7/16"-14UNC BOLTS, ITEM 6 TO 40 (+4/-0) FT-LBS
 - TORQUE 1/4"-20UNC BOLTS, ITEM 18 TO 12 (+2/-0) FT-LBS

- 10. USE THREAD LUBRICANT, ITEM 12, ON ALL BOLT THREADS.

- 11. BEFORE WELDING TOP FLANGE (ITEM 19) TO OUTER TANK ASSEMBLY (ITEM 1), PLACE THE INNER TANK ASSEMBLY INTO THE OUTER TANK ASSEMBLY AND CENTER THE INNER TANK ASSEMBLY USING THE TOP COVER FLANGE. AFTER CENTERING THE INNER TANK ASSEMBLY, INSTALL ITEMS 5 & 6 THEN CAREFULLY FILL THE OUTER TANK WITH LEAD SHOT (ITEM 8) AVOIDING MOVING THE INNER TANK ASSEMBLY.

- 12. DESIGN PRESSURE = FULL VACUUM TO 15 PSIG.

- 13. DESIGN TEMPERATURE: SEE DDS-1547

- 14. SEAL OPENINGS IN TOP HEAD FLANGE PENETRATIONS WITH SILICONE SEALANT, ITEM 10, TO ENSURE LEAD SHOT (ITEM 8) IS RETAINED.

- 15. USE PIPE THREAD SEALANT, ITEM 20, ON ALL THREADED PIPE CONNECTIONS.

- 16. COMPLETED THERMAL FLUID SIDE OF THE CONDENSER SHALL UNDERGO A PNEUMATIC LEAK TEST IN ACCORDANCE WITH ASME B&PV CODESECTION V, ARTICLE 10 "LEAK TESTING", MANDATORY APPENDIX PRESSURE OF 165 PSIG. INSPECT FOR LEAKS. PRESSURE DROP SHALL NOT EXCEED 1.0 PSIG OVER A 10 MINUTE PERIOD FOR OFF-SITE FABRICATION.

COMPLETED THERMAL FLUID SIDE OF THE CONDENSER SHALL UNDERGO A PNEUMATIC LEAK TEST IN ACCORDANCE WITH TPR-4976 "LEAK TEST" APPENDIX C "PRESSURE CHANGE TEST" AT A PRESSURE OF 165 PSIG. INSPECT FOR LEAKS. PRESSURE DROP SHALL NOT EXCEED 1.0 PSIG OVER A 10 MINUTE PERIOD FOR ON-SITE FABRICATION.

LEAK TEST SHALL BE PERFORMED BEFORE LEAD SHOT IS INSTALLED SO THREADED JOINTS CAN BE OBSERVED.

(NOTES CONTINUED)

- 17. COMPLETED VACUUM SIDE OF THE CONDENSER SHALL UNDERGO A PNEUMATIC LEAK TEST IN ACCORDANCE WITH ASME B&PV CODE SECTION V, ARTICLE 10 "LEAK TESTING" MANDATORY APPENDIX VI "PRESSURE CHANGE TEST" AT A PRESSURE OF 14-14.9 PSIG. INSPECT FOR LEAKS. PRESSURE DROP SHALL NOT EXCEED 0.1 PSIG OVER A 10 MINUTE PERIOD FOR OFF-SITE FABRICATION.
- COMPLETED VACUUM SIDE OF THE CONDENSER SHALL UNDERGO A PNEUMATIC LEAK TEST IN ACCORDANCE WITH TPR-4976, "LEAK TEST" APPENDIX C "PRESSURE CHANGE TEST" AT A PRESSURE OF 14-14.9 PSIG. INSPECT FOR LEAKS. PRESSURE DROP SHALL NOT EXCEED 0.1 PSIG OVER A 10 MINUTE PERIOD FOR ON-SITE FABRICATION.

(NOTES CONTINUED)

- 18. VERIFY INDICATED DIMENSIONS WITH THE VENDOR DRAWING.
- 19. ADD HANDLES ABOVE & BELOW CENTER OF GRAVITY TO AID IN MOVING VESSEL. TYPE & LOCATION TO BE DETERMINED.
- 20. ELECTRICAL CONNECTIONS SHALL BE AT LEAST 5 FT FROM THE TOP OF THE LID TO THE CONNECTORS FOR THE HEATERS THERMOCOUPLES AND LEVEL SENSOR SHALL BE AS PROVIDED FROM VENDOR.
- 21. FACTORY ACCEPTANCE TEST FOR ALL ELECTRICAL COMPONENTS TO BE DETERMINED.

(NOTES CONTINUED)

22. ESTIMATED WEIGHT = 2, 800 LBS.

REV	DESCRIPTION
1	SEE DRF-346066 INCORPORATED FDC-10284, FDC-10297 FDC-10312, FDC-10426, FDC-10441, FDC-10445, FDC-10482. ADDED NEW SHEET 2

QTY REQD	QUAL LEVEL	PART OR IDENTIFYING NO.	NOMENCLATURE OR DESCRIPTION	MATERIAL/SPECIFICATION OR VENDOR NAME	ITEM NO.
1	3	H90070-210	GRAYLOC HUB, BW, 2 GR20, 2 SCH 40 X 2.067	GRAYLOC PRODUCTS	23
1	3	9P3304	PLUG, DURATITE, 480 VAC, 2P3W, 30 A	RUSSEL STOLL (T&B)	22
1	4	CGB396	CABLE GLAND	CROUSE-HINDS	21
AR	4	31227	GRAY PIPE JOINT COMPOUND	OATEY	20
1	3	-19	TOP FLANGE	PLATE, 304 OR 304L SST ASTM A240	19
10	3		BOLT 1/4-20 UNC 5/8 LG	GRADE B8 SST ASTM A193	18
1	3	-17	SLOT COVER	PLATE, 304 OR 304L SST ASTM A240	17
AR	3	9328K41	1" THK. MINERAL WOOL INSULATION HIGH TEMPERATURE	McMASTER-CARR	16
			REMOVED		15
1	4	TJ36-ICSS-316U-12-S B-HFSTW-M-PD	TEMPERATURE SENSOR, HEAVY DUTY	OMEGA ENGINEERING INC.	14
1	3	AWH-052-080D-SP	HEAT TRACE	HTS/AMPTEK CO.	13
AR	4	PN77124	NICKEL ANTI-SIEZE THREAD LUBRICANT	LOCTITE	12
10	4		WASHER, FLAT, 7/16 TYPE 3 CIRCULAR	ASTM F436	11
AR	4	732	INDUSTRIAL SEALANT	DOW CORNING	10
AR	3		WELD FILLER METAL	ER308 OR 308L AWS A5.9	9
AR	4		LEAD SHOT #4 (.13 DIA.)	MARSHIELD	8
1	3	5000070	C.F. FLANGE, 2 3/4" DIA. FOR 1.5 DIA TUBE FIXED NON-ROTATING, TAPPED	A & N CORP.	7
2	3		FLANGE, 2 SLIP ON 300 LB, RAISED FACE	A304 SST ASTM A182	6
2	3	-5	PIPE	PIPR, SEAMLESS, 304 SST ASTM A 312	5
10	3		BOLT, HEX HD 7/16-14UNC X 1 LG	ASTM A193 GRADE B8	4
1	3	-3	TOP PLATE	PLATE, 304 OR 304L SST ASTM A 240	3
1	3	786869-0	CONDENSER / COLLECTION VESSEL		2
1	3	786870-0	CONDENSER / COLLECTION OUTER SHELL		1
			ASSEMBLY		0

QTY REQD	QUAL LEVEL	PART OR IDENTIFYING NO.	NOMENCLATURE OR DESCRIPTION	MATERIAL/SPECIFICATION OR VENDOR NAME	ITEM NO.
1	3	P/N S607BLPTS	SINGLE GANG BLANK DEVICE COVER, SST	CALBRITE	30
2	3	P/N S60700FB05	3/4" X 1/2" FACE BUSHING, SST	CALBRITE	29
1	3	P/N S60500CFX	1/2" BARE FLEX CONDUIT 4 FT LONG	CALBRITE	28
1	3	P/N S60500FC45	1/2" FLEX CONNECTOR MALE 45 ELBOW	CALBRITE	27
1	3	P/N S40501GR00	CORD GRIP, SST, .125 - .188" CABLE SIZE	CALBRITE	26
2	3		BOLT, HEX HD, 1/4" 20UNC X 3/4" LG	GRADE B8 SST ASTM A 193	25
1	3	P/N S60700FDCS	3/4" SINGLE GANG BOX, SST	CALBRITE	24



ELECTRICAL MECHANICAL
I CERTIFY THAT THIS DRAWING REFLECTS THE CURRENT CONSTRUCTED CONDITION AS OF 7-15-15

QC REQUIRED	DASH NO.	FINAL	NEXT ASSY
Q			

DIMENSIONING AND SYMBOLS PER		SIGNATURES/DATES APPLY TO CURRENT RELEASE ONLY	
ASME Y14.5-2009 AND STD-11	UNLESS OTHERWISE SPECIFIED	DESIGN: R. CAMPBELL	2015.08.05 14:48:45 -0600
SURFACE ROUGHNESS 125/	DIMENSIONS AND TOLERANCES ARE IN INCHES	DRAFTER: O. MORGAN	2015.08.05 14:16:08 -0600
TOLERANCES .X ± .1	DECIMALS .XX ± .03	TECHNICAL CHECK: T. BURNETT P.E.	2015.08.05 15:14:13 -0600
FRACTIONS ± 1/8	ANGULAR ± 2'	ENG GROUP SUPERVISOR: R. EASTMAN P.E.	2015.08.05 15:17:32 -0600
DO NOT SCALE DRAWING		DESIGN LEAD/AUTHORITY: D. MORGAN	2015.08.05 14:54:01 -0600
		DRAFTING CHECK/EFFECTIVE DATE: S. BERTHELSON	2015.08.05 17:21:13 -0600
		PROJECT NUMBER: 31720	
		DRF NUMBER: 343891	

Idaho Cleanup Project

CPP-666
RH-TRU DISTILLATION SYSTEM
CONDENSER / COLLECTION VESSEL ASSEMBLY
COND-FC-103A / VES-FC-85A

SCALE: NOTED

DWG- 786868

REV 1

SHEET 1 OF 5

File: 786868-1.dwg Path: \\VA-Yout\Designs\MISC\AMFC\CONDENSER NEW\786868-1.dwg

D

Q

Q

C

B

Q

Q

B

Q

A

D

Q

Q

C

B


Q

Q

B


Q

A

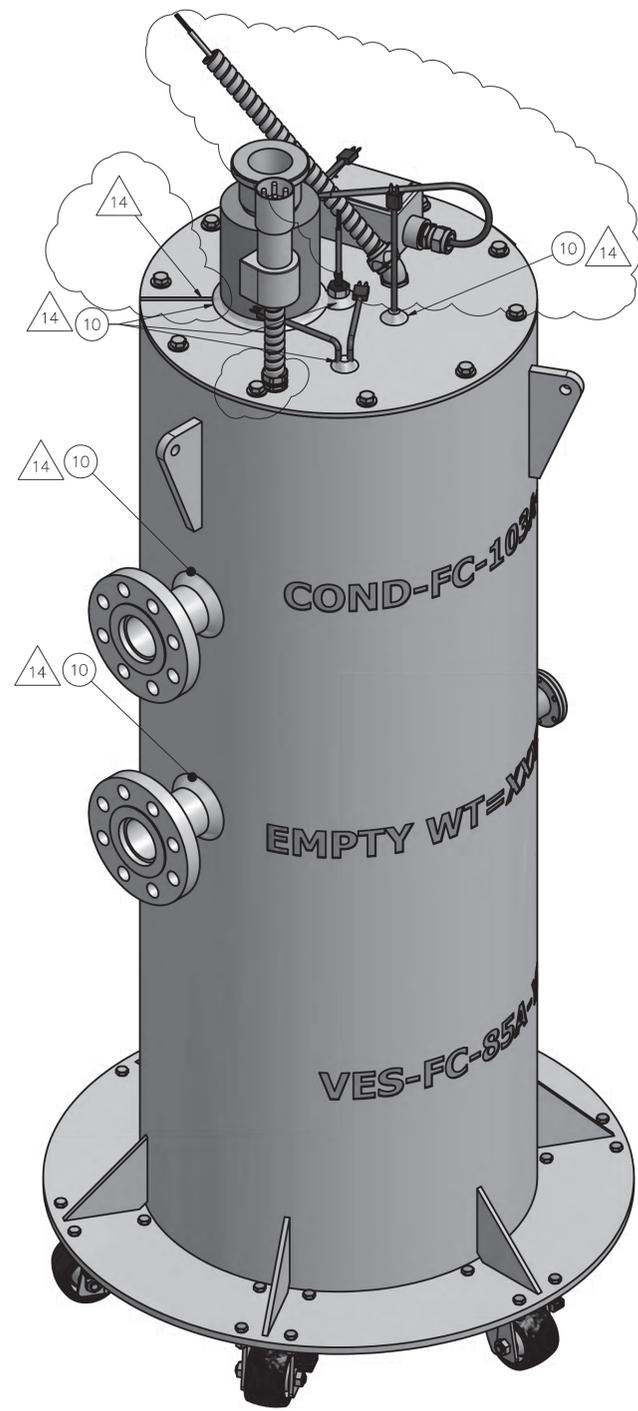

3D VIEW
 (SHOWN FOR CLARITY)
 SCALE: NONE


-0 ASSEMBLY

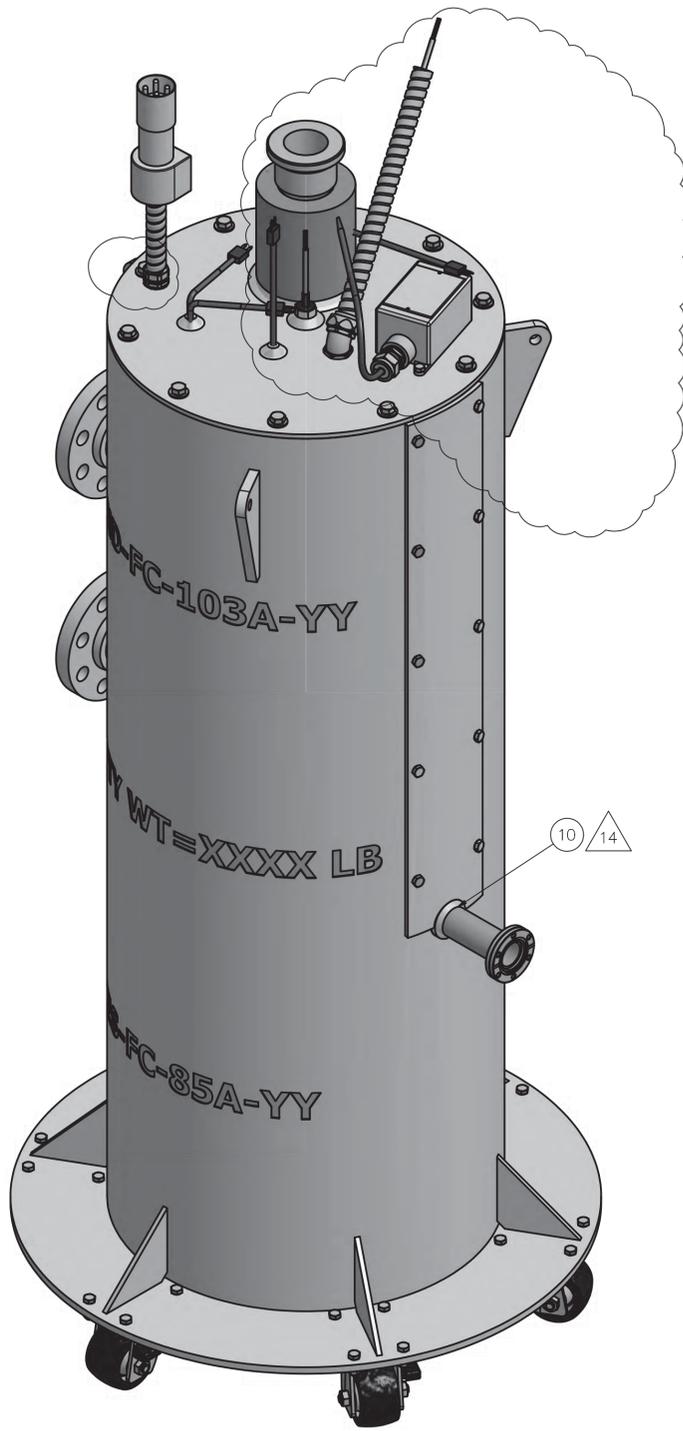


3D VIEW
 (SHOWN FOR CLARITY)
 SCALE: NONE

File: 786868-1.dwg
 Path: \\VA-Yout\Designs\MISC\MECA\CONDENSER_NEW\786868-1.dwg
 Layout Name: ID: penmr


SIZE	INDEX CODE NUMBER			DWG-	786868	REV	1
D	AREA	TYPE	CL	ORIG			
	200						
SCALE:					FS	SHEET	2

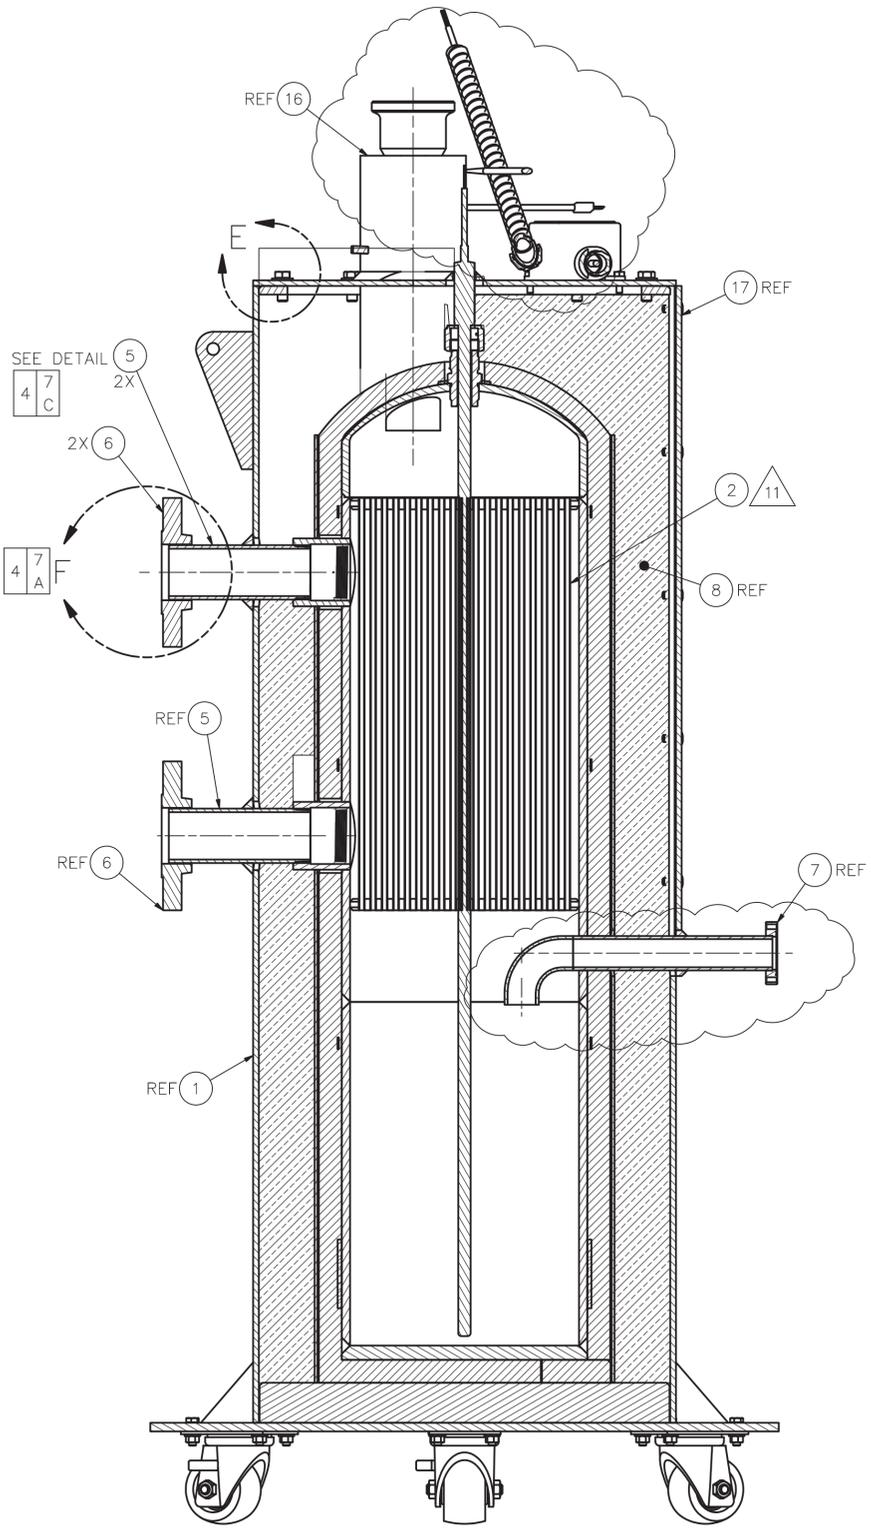


SECTION A-A
SCALE: 1/4

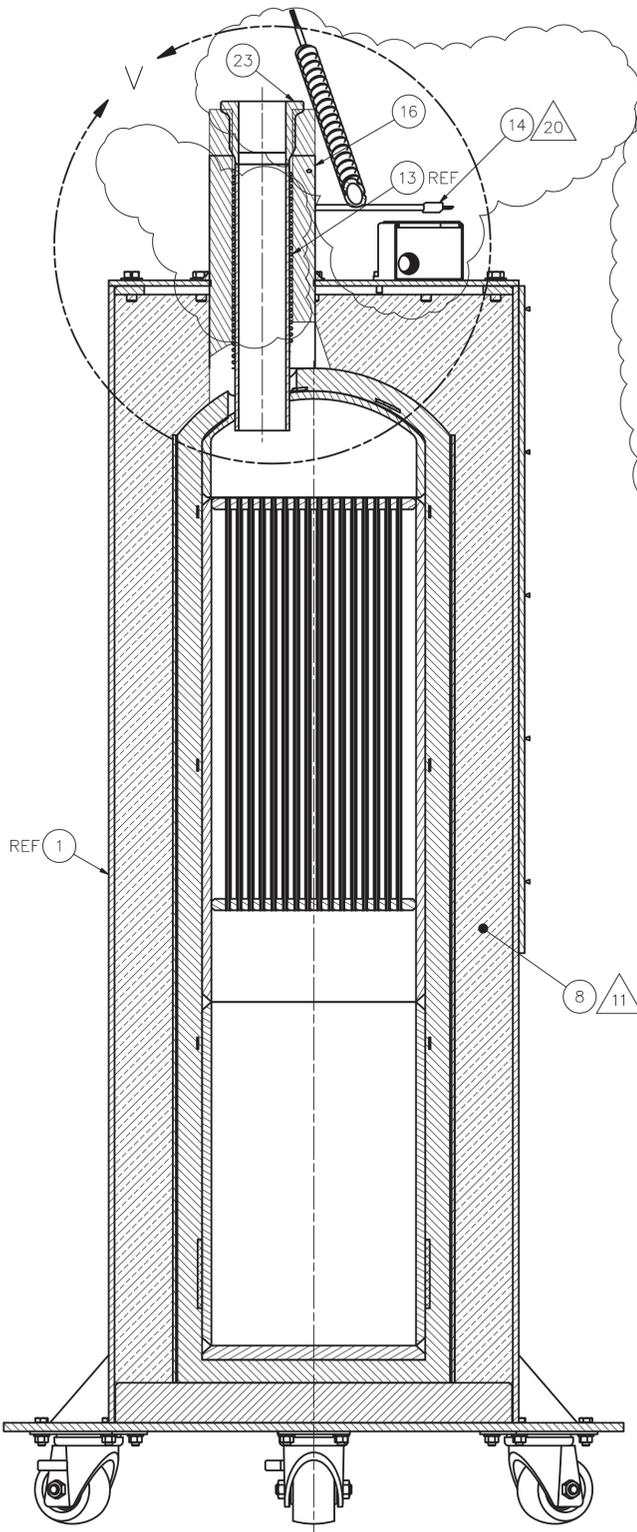


SECTION D-D
SCALE: 1/4

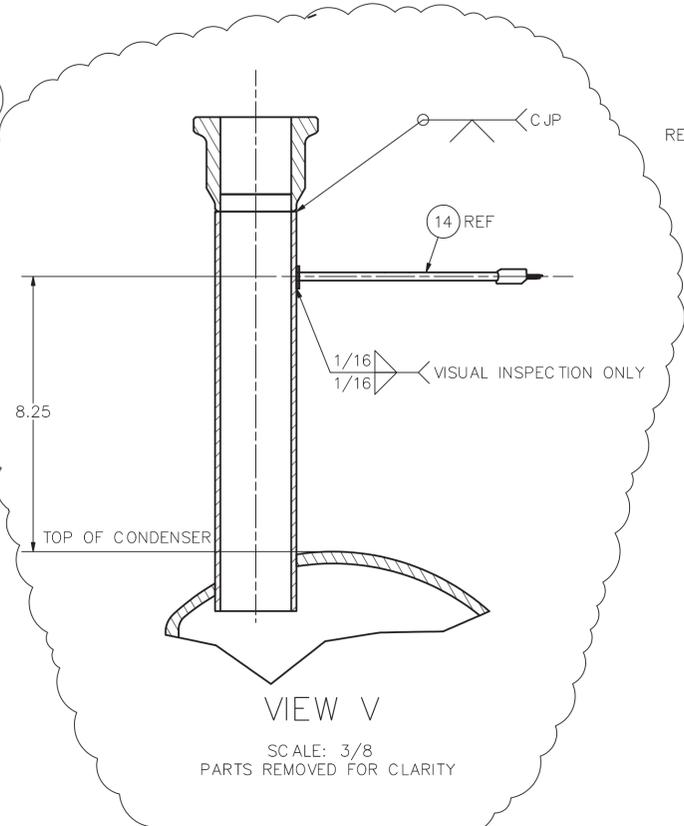


VIEW V
SCALE: 3/8
PARTS REMOVED FOR CLARITY

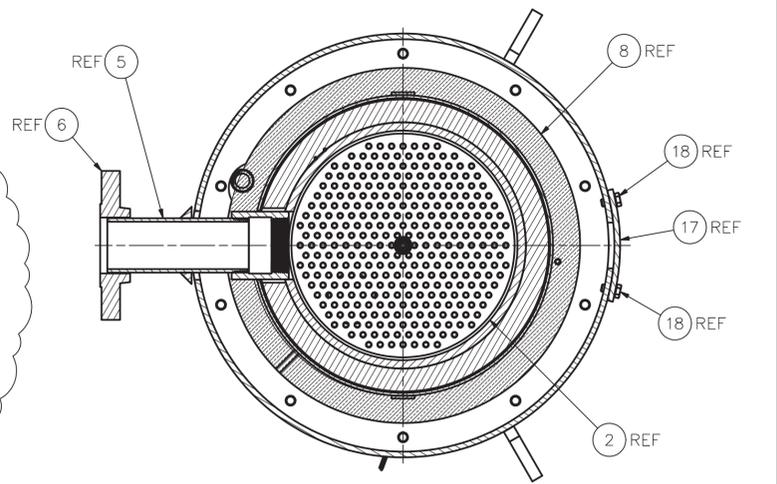

SECTION B-B
SCALE: 1/4

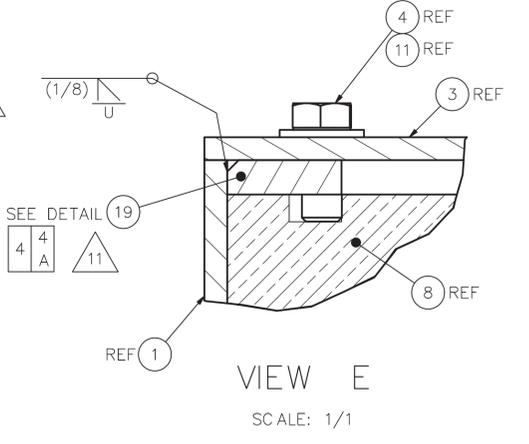

VIEW E
SCALE: 1/1

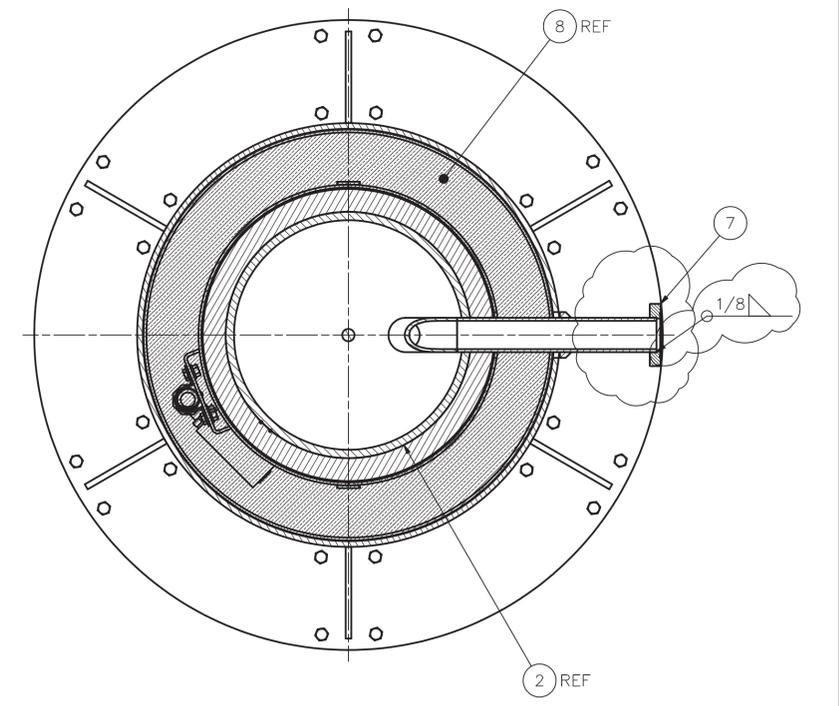


SECTION C-C
SCALE: 1/4

Layout Name: ID: penmr
File: 786868-1.dwg
Path: \\VA-YOUTH\Designs\MISC\MISC\CONDENSER NEW\786868-1.dwg

SIZE	INDEX	CODE	NUMBER	DWG-	786868	REV	1
D	AREA	TYPE	CL	ORIG			
	200	0666	53	136			
SCALE: NOTED				FS	SHEET	4	

NOTES:


- REMOVE ALL BURRS AND SHARP EDGES.
 - ALL MACHINED FILLET RADII .030 MAXIMUM UNLESS OTHERWISE NOTED.
 - FINAL ASSEMBLY SHALL FREE OF DIRT, CHIPS, WELDING FLUX, SLAG, SCALE OIL, GREASE, ETC. FOR OFF-SITE FABRICATION OR FINAL ASSEMBLY SHALL MEET CLEANLINESS REQUIREMENTS OF STD-7022, LEVEL D FOR ON-SITE FABRICATION.
 - WELDING SHALL BE PERFORMED IN ACCORDANCE WITH ASME B&PV CODE SECTION IX USING ITEM 20 FOR OFF-SITE FABRICATION OR WELD PER INL WELD PROCEDURE SPECIFICATION S2.0 USING ITEM 20 FOR ON-SITE FABRICATION.
 - VISUALLY INSPECT ALL WELDS IN ACCORDANCE WITH ASME B&PV CODE, SECTION V, ARTICLE 9 FOR OFF-SITE FABRICATION OR VISUALLY INSPECT ALL WELDS IN ACCORDANCE WITH TPR-4981 "VISUAL EXAMINATION" FOR PRESSURE VESSELS. ACCEPTANCE CRITERIA SHALL BE PER APPENDIX B, "ACCEPTANCE CRITERIA FOR ASME CODE, SECTION VIII, DIVISION 1 WELDS, BASE MATERIALS AND BRAZING" FOR ON-SITE FABRICATION.
 - LIQUID PENETRANT EXAMINATION FOR OFF-SITE FABRICATION SHALL BE PERFORMED IN ACCORDANCE WITH THE B&PV CODE SECTION V ARTICLE 6. ACCEPTANCE CRITERIA SHALL BE:
 - ALL SURFACES TO BE EXAMINED SHALL BE FREE OF:
 - RELEVANT LINEAR INDICATIONS
 - RELEVANT ROUNDED INDICATIONS GREATER THAN 5 MM (3/16")
 - FOUR OR MORE RELEVANT ROUNDED INDICATIONS IN A LINE SEPARATED BY 1.5 MM (1/16") OR LESS, EDGE-TO-EDGE.
 - CRACK LIKE INDICATIONS DETECTED, IRRESPECTIVE OF SURFACE CONDITIONS, ARE UNACCEPTABLE.
- LIQUID PENETRANT EXAMINATION FOR ON-SITE FABRICATION SHALL BE PERFORMED ON ALL WELDS IN ACCORDANCE WITH TPR-4975 "LIQUID PENETRANT EXAMINATION," APPENDIX G, WITH ACCEPTANCE PER APPENDIX G, "ACCEPTANCE CRITERIA FOR ASME SECTION VIII WELDS." USE LIQUID PENETRANT EXAMINATION OF ROOT AND FINAL PASS FOR BUTT WELDS AND FINAL PASS FOR FILLET WELDS.
- COMPLETED ASSEMBLY SHALL UNDERGO A PNEUMATIC LEAK TEST IN ACCORDANCE WITH B&PV CODE SECTION V, ARTICLE 10 AND B&PV CODE SECTION VIII, SECTION UG-100 FOR OFF-SITE FABRICATION OR IN ACCORDANCE WITH TPR-4976 "LEAK TEST PROCEDURE," APPENDIX A "BUBBLE TEST-DIRECT PRESSURE TECHNIQUE," FOR ON-SITE FABRICATION, AT A PRESSURE OF 16.5 TO 18.8 PSIG. "SNOOP" ALL CONNECTIONS FOR LEAKS, PRESSURE DROP SHALL NOT EXCEED 0.1 PSIG OVER A 15 MINUTE PERIOD.
 - USE THREADLOCKER, ITEM 26, ON THREADS OF FITTING, AVOIDING PLACING ANY ON THE SEALING SURFACES. IF ANY IS ON THE SEALING SURFACE, IMMEDIATELY CLEAN IT UP.
 - DESIGN TEMPERATURE = SEE DDS-1547.
 - DESIGN PRESSURE = FULL VACUUM TO 15 PSIG.
 - INSULATION (ITEM 8) TO BE INSTALLED BY FABRICATOR, AND ATTACHED TO CONDENSER/COLLECTION VESSEL AT FABRICATORS DISCRETION.
 - REMOVED
 - PERFORM PRESSURE TEST BEFORE INSULATION AND LINER IS APPLIED.
 - VERIFY WITH CONDENSER DIMENSIONS.
 - USABLE LIQUID LEVEL 14.625" FROM BOTTOM OF COLLECTION VESSEL.

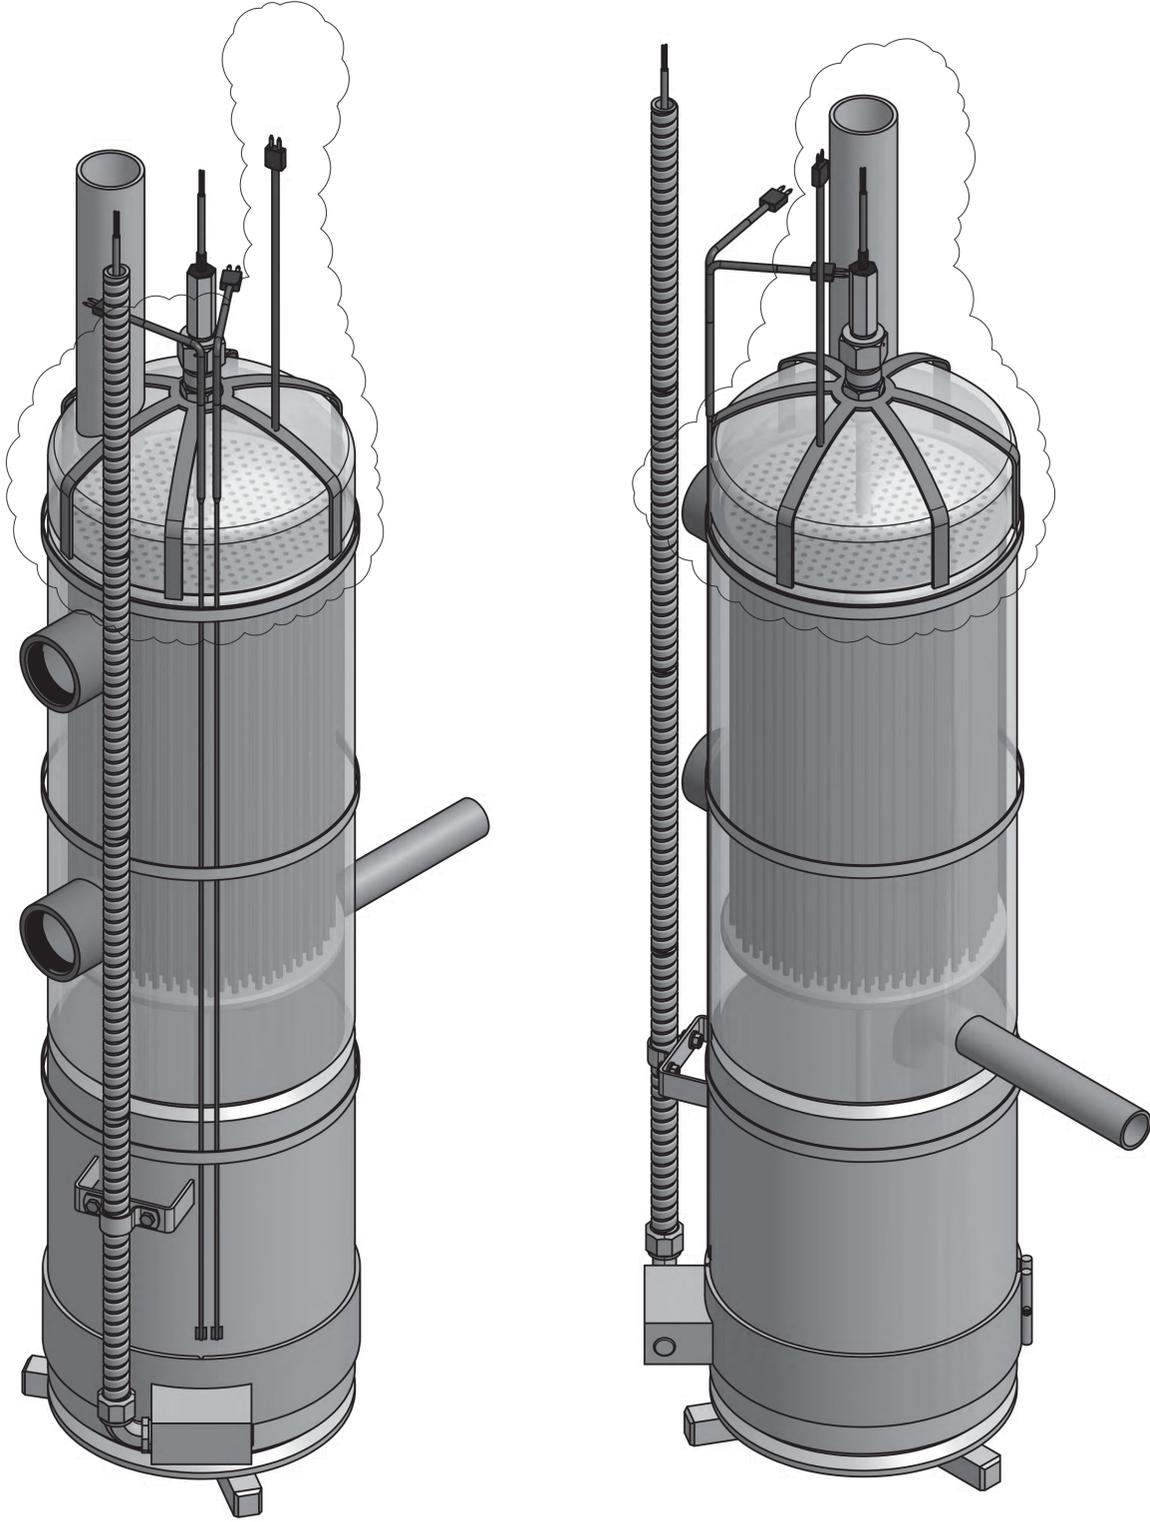

REV	DESCRIPTION
1	SEE DRF-346066 INCORPORATED FDC-10284, FDC-10316, FDC-10323, FDC-10425, FDC-10430, FDC-10441, FDC-10456, FDC-10472, FDC-10499

AR	QTY	DESCRIPTION	MATERIAL/SPECIFICATION	ITEM NO.
AR	4	2422	THREAD-LOCKER, BLUE HIGH TEMP	26
1	3	NI-12-VCR-2	GASKET, 3/4" VCR, NICKEL SILVER PLATED	25
4	3	HT-13-10	HIGH TEMPERATURE RING TERMINAL 12-10AWG, #10 STUD	24
1	3	S50	SNAP-IN KNOCKOUT BLANKS	23
1	3	A520-IDNL0115-24	CONDENSOR HEAT TRACE	22
AR	AR	3	WELD FILLER METAL	20
AR	3	12MTMP	WIRE, HIGH TEMPERATURE, 600V-1200 DEG F, UL LISTED ONE CONDUCTOR SIZE 12 AWG	19
1	3	MB100N3AP-3001	BAND HEATER, 10.75 I.D. 3" WIDE, 3 KW 480 VAC	18
2	3		NUT, HEX 1/4-20UNC	17
2	3		WASHER, FLAT 1/4"	16
2	3		BOLT, HEX HEAD 1/4-20UNC X 1 LG	15
1	3	HS901-SS	CONDUIT CLAMP	14
1	3	-13	CONDUIT MOUNTING BRACKET	13
1	3	-12	BACK LINER ASSEMBLY	12
2	3	-11	LINER JOINT BAR	11
1	3	-10	FRONT LINER	10
1	3	-9	BACK LINER	9
AR	4	9328K41	1" THK. MINERAL WOOL INSULATION, HIGH TEMPERATURE	8
4	3	S60500CFX	1/2" BARE FLEX CONDUIT	7
1	4	S60500CF90	1/2" FLEX CONNECTOR MALE 90 DEG. ELBOW	6
3	4	5416K44	HOSE CLAMP, WORM DRIVE	5
2	4	TJ36-ICSS-316U-36-S R-SMPW-M-PD	TEMPERATURE SENSOR, HEAVY DUTY	4
1	3	LLS110-CD0002-XX	CONDUCTIVITY LEVEL SWITCH LLS110 CUSTOM WITH LSC4	3
1	3	NETO-18-1	CONDENSER ASSEMBLY	2
1	3	786871-0	COLLECTION TANK ASSEMBLY	1
	3	-0	ASSEMBLY	0

-0 ASSEMBLY
3D VIEW
(SHOWN FOR CLARITY)
SCALE: NONE

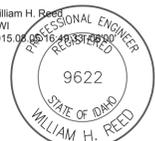

I CERTIFY THAT THIS DRAWING REFLECTS THE CURRENT CONSTRUCTED CONDITION AS OF 7-15-15

INSPECTION REQUIREMENTS	-0	786868
QC REQUIRED		
QC DENOTES Q/C INSP. RECD.		

DASH NO.	786868
NEXT ASSY	
APPLICATION	

DIMENSIONING AND SYMBOLY PER	ASME Y14.5-2009 AND STD-11
UNLESS OTHERWISE SPECIFIED	
SURFACE ROUGHNESS	125/
DIMENSIONS AND TOLERANCES ARE IN INCHES	
TOLERANCES	.X ± .1
DECIMALS	.XX ± .03
FRACTIONS	± 1/8
ANGULAR	± 2'
DO NOT SCALE DRAWING	

Idaho Cleanup Project

CPP-666
RH-TRU DISTILLATION SYSTEM
CONDENSER / COLLECTION VESSEL
INNER ASSEMBLY
COND-FC-103A/VES-FC-85A



CH2M WILCOX

SCALE: NOTED

DWG- 786869


REV 1

SHEET 1 OF 4

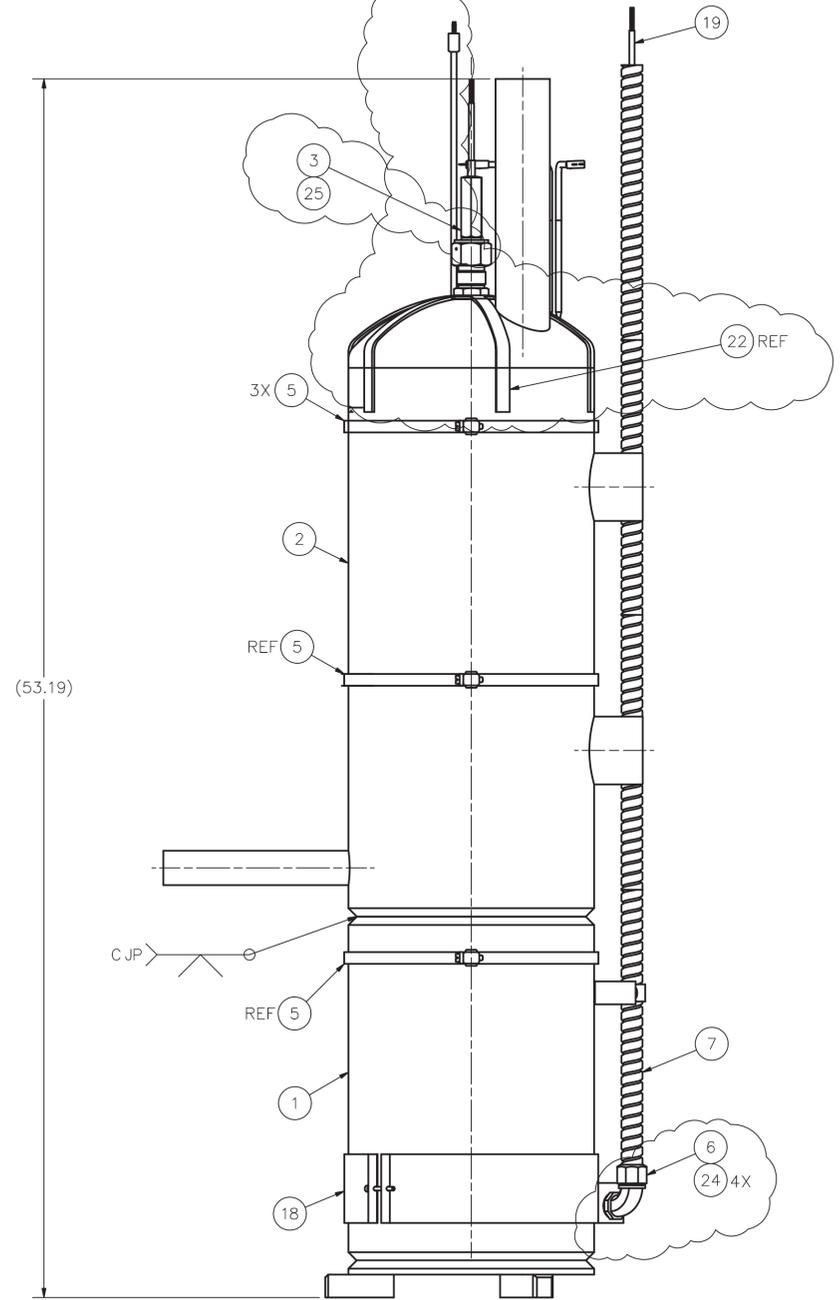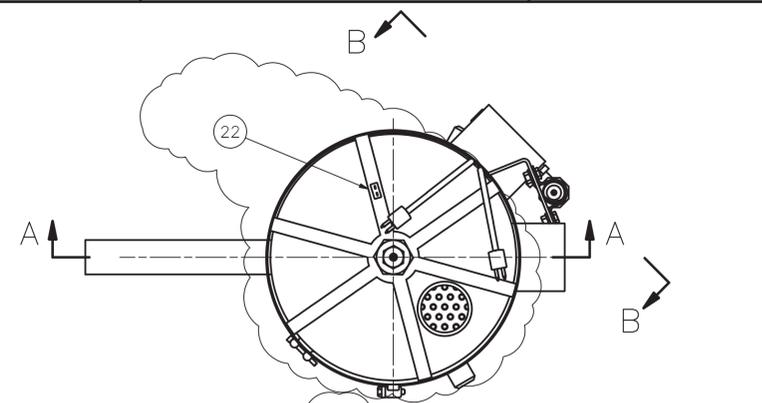


-0 ASSEMBLY

SCALE: 1/4
INSULATION AND LINER NOT SHOWN FOR CLARITY

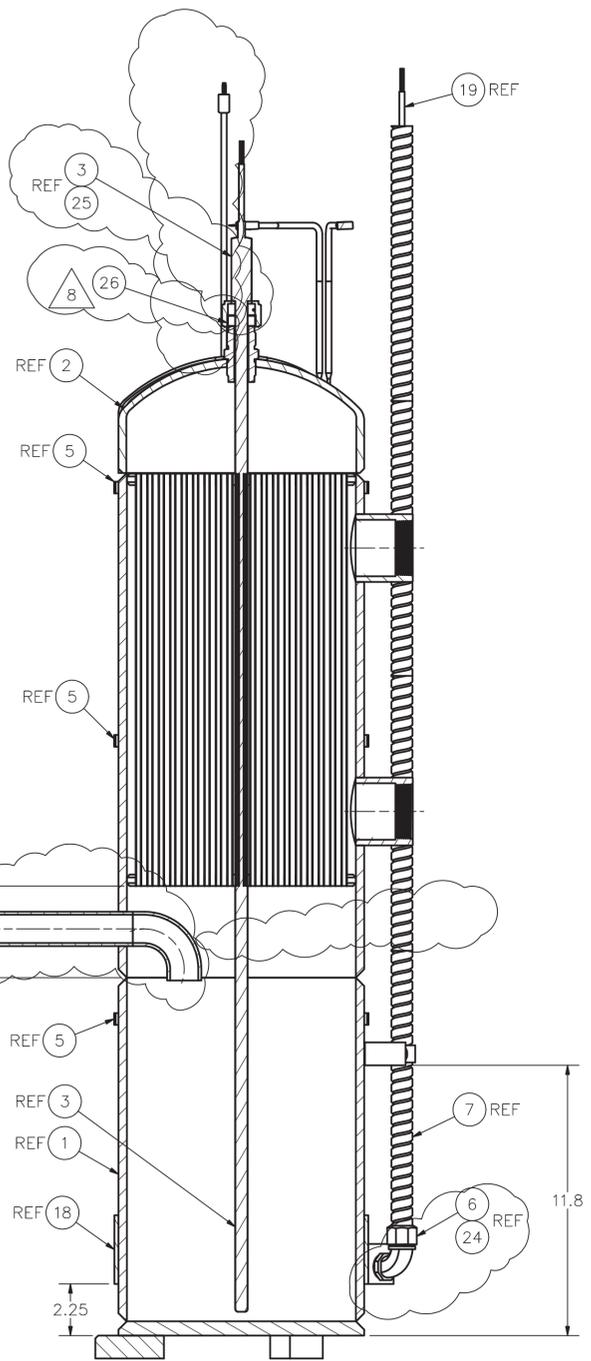

SECTION A-A

SCALE: 1/4
INSULATION AND LINER NOT SHOWN FOR CLARITY


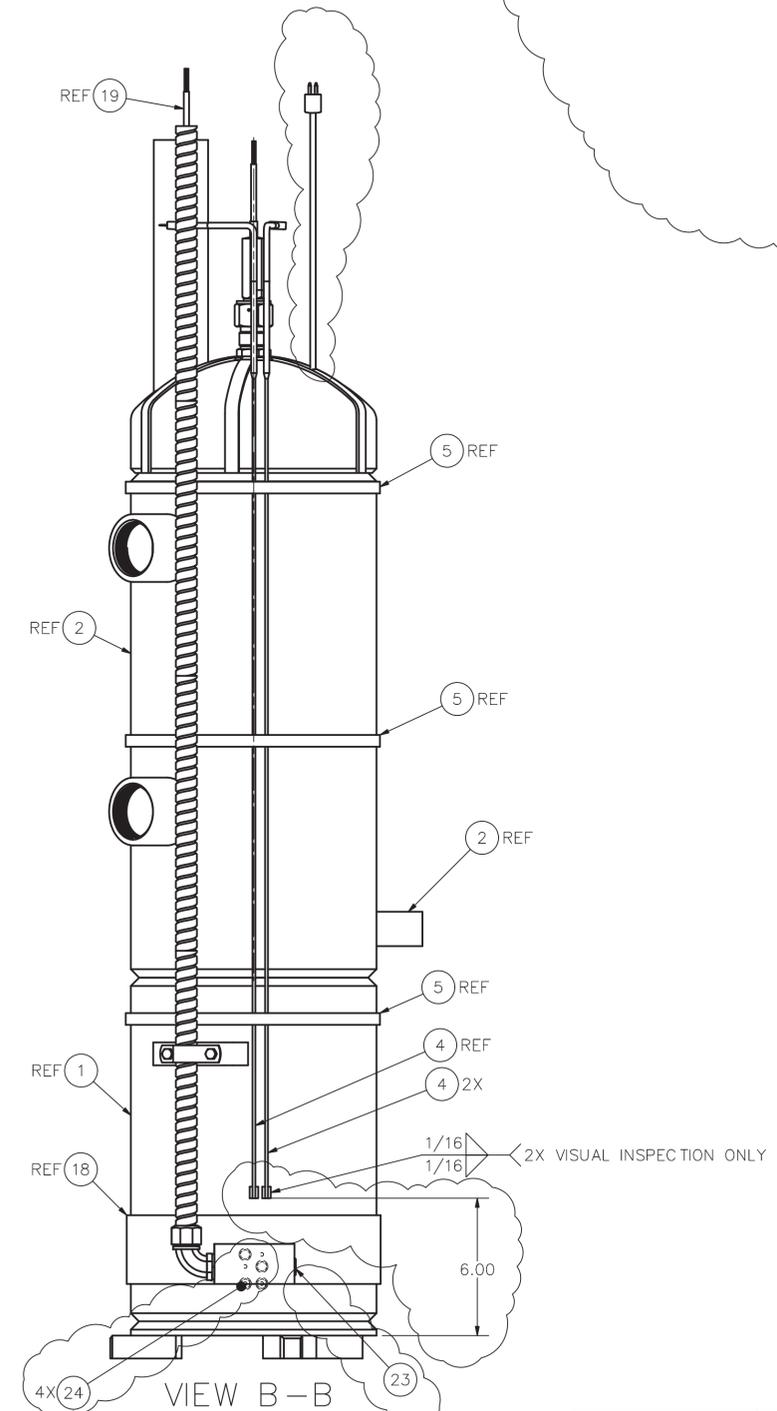


VIEW B-B


SCALE: 1/4
INSULATION AND LINER NOT SHOWN FOR CLARITY

SIZE	INDEX	CODE	NUMBER	DWG-	786869	REV	1
D	AREA	TYPE	CL	ORIG			
	200	0666	53	136			
SCALE: NOTED				FS	SHEET	2	


File: 786869-1.dwg
Path: \\VA-Yout\Designs\MISC\MECA\CONDENSER_NEW\786869-1.dwg
Layout Name: ID: penmr

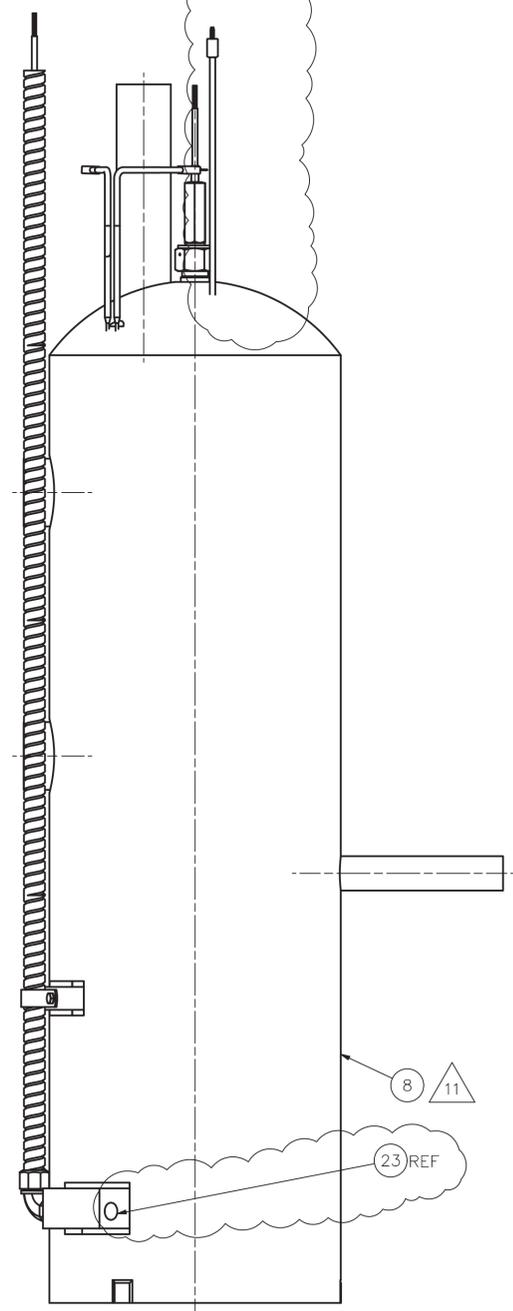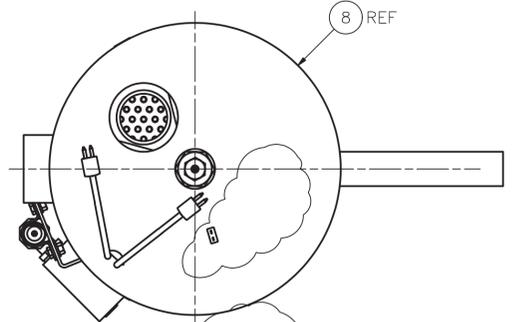



INSULATION INSTALLATION VIEW
SCALE: 1/4

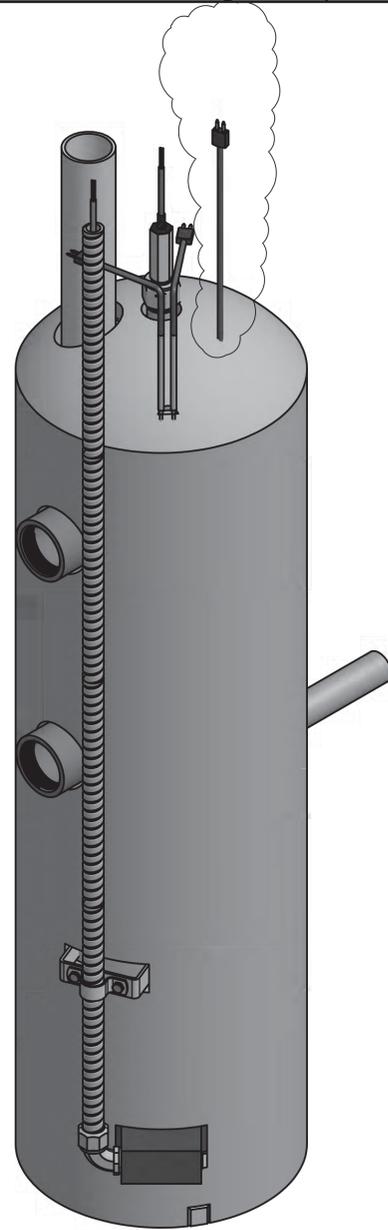


INSULATION
3D VIEW
(SHOWN FOR CLARITY)
SCALE: NONE

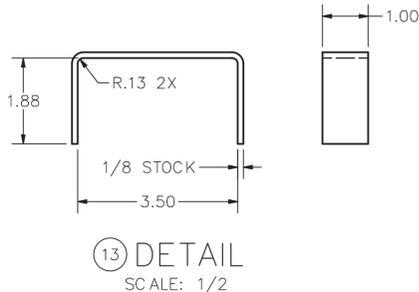


(13) DETAIL
SCALE: 1/2

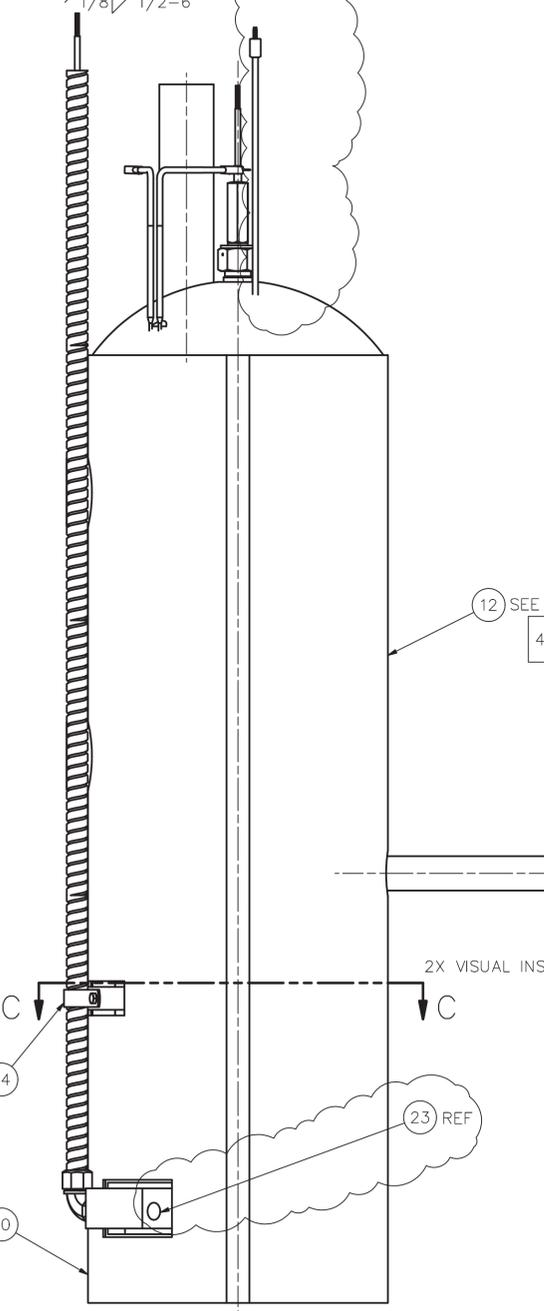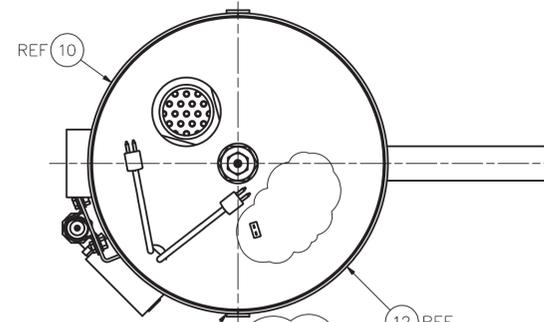

INSULATION SHIELD INSTALLATION VIEW
SCALE: 1/4

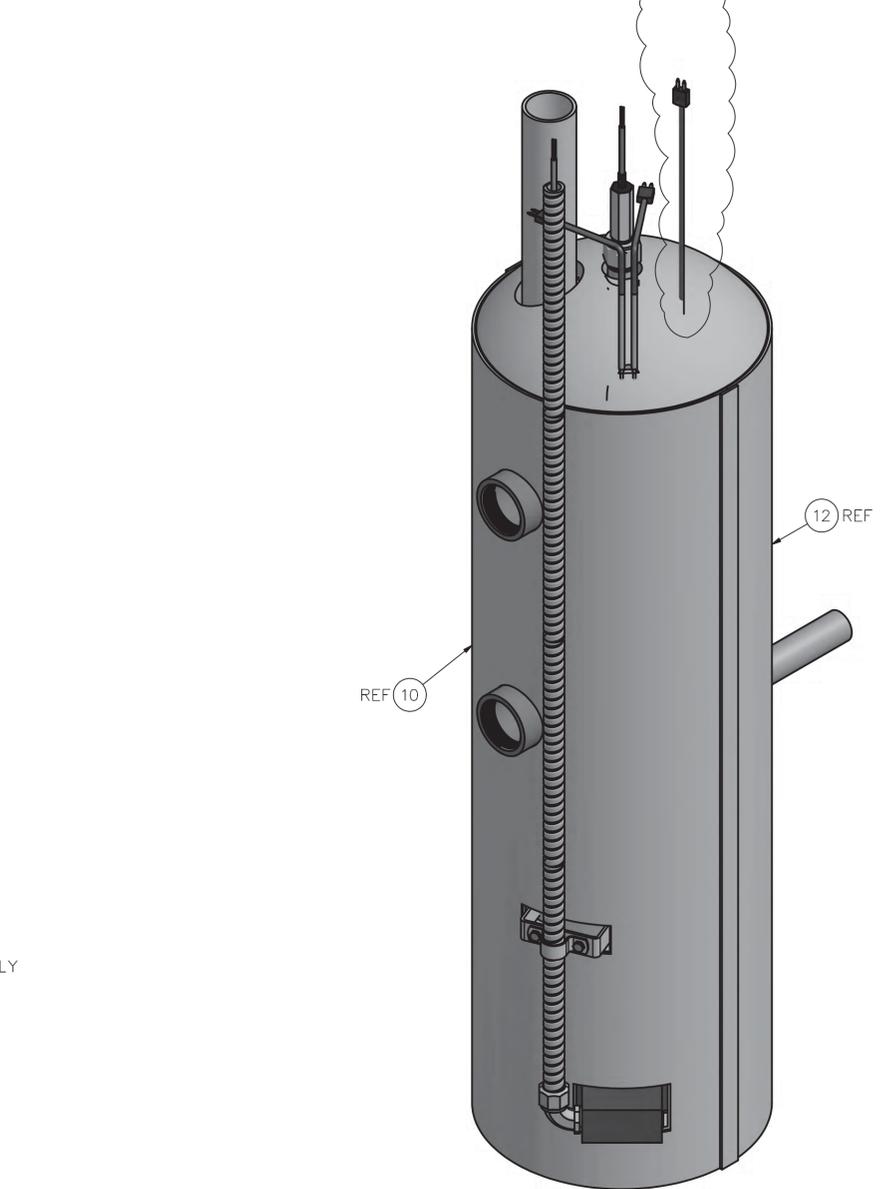

LINER
3D VIEW
(SHOWN FOR CLARITY)
SCALE: NONE

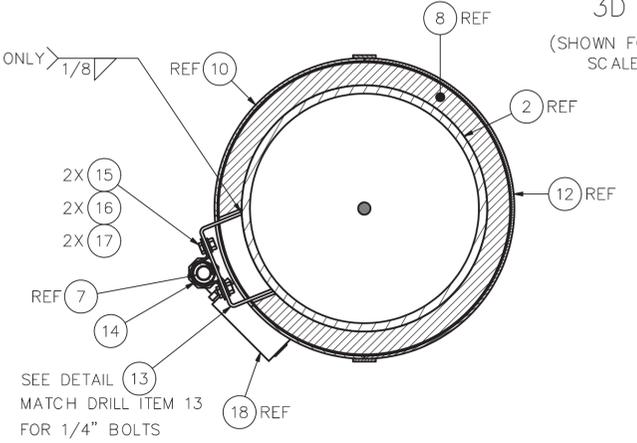

SECTION C-C
SCALE: 1/4

SIZE	INDEX	CODE	NUMBER	DWG-	786869	REV	1
D	AREA	TYPE	CL	ORIG			
	200	0666	53	136			
SCALE: NOTED				FS	SHEET	3	

D

C

B





A

D



C

B


A

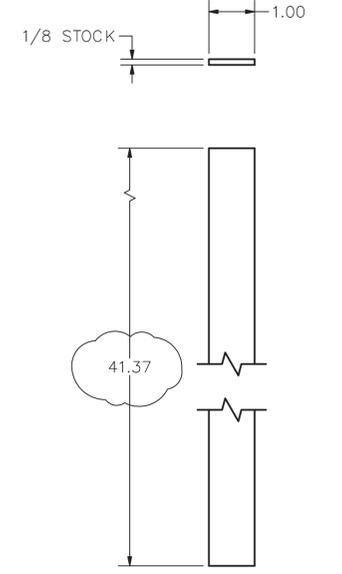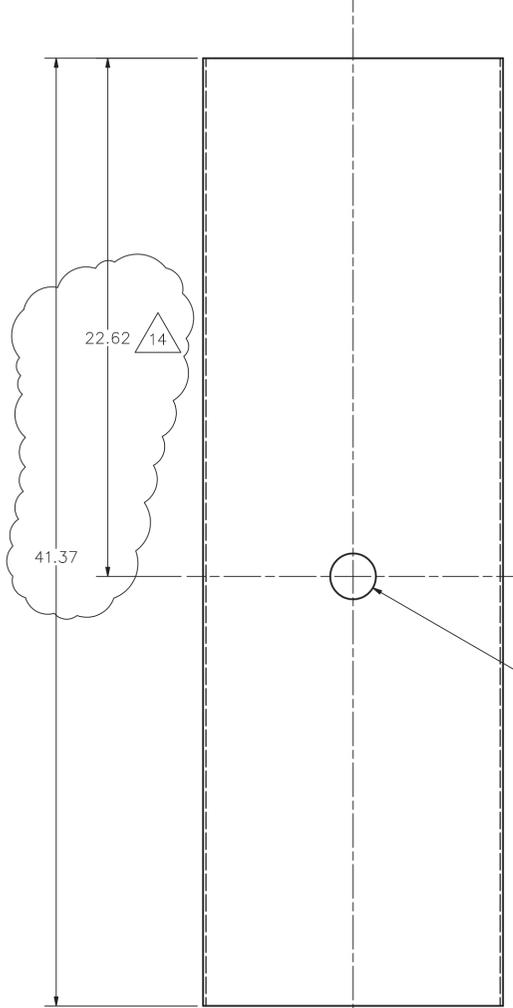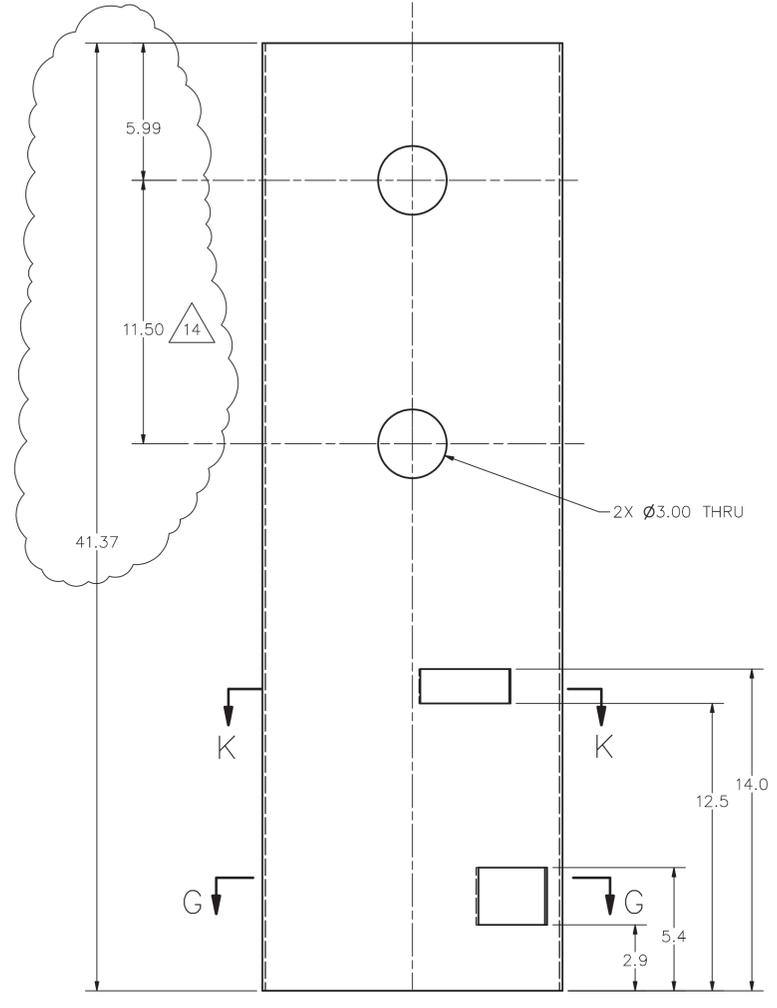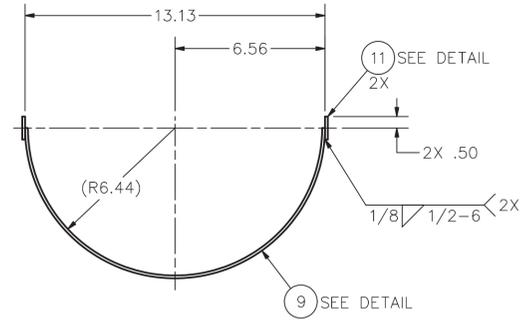


11 DETAIL SCALE: 1/2

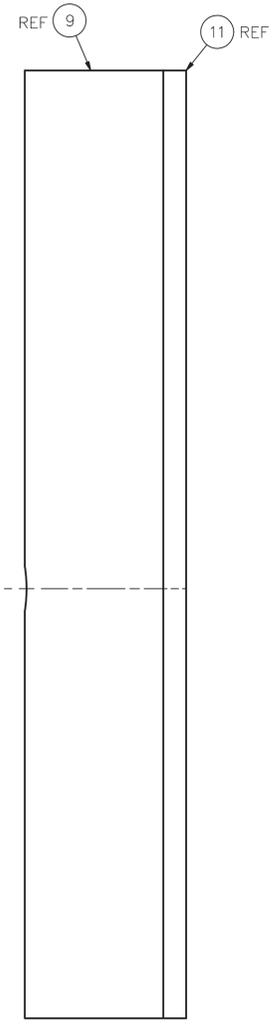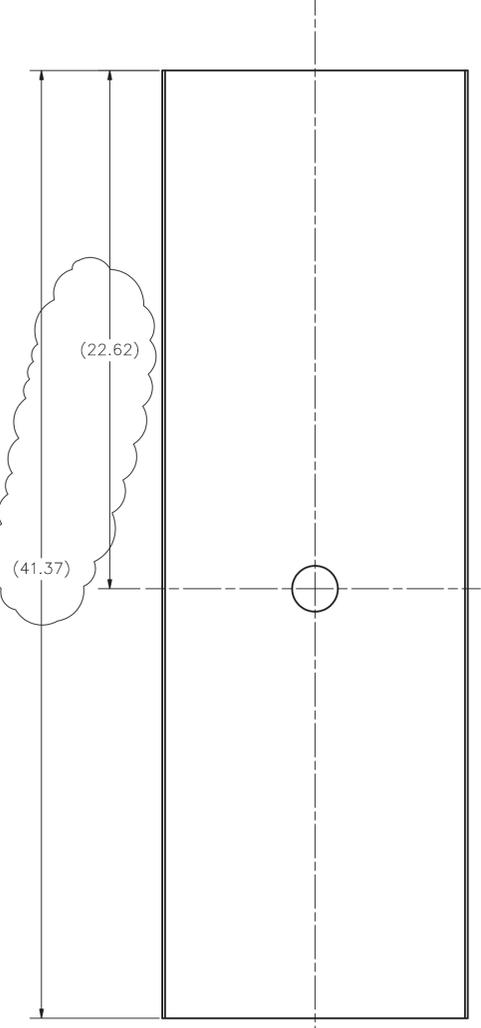

- 12 ASSEMBLY SCALE: 1/4

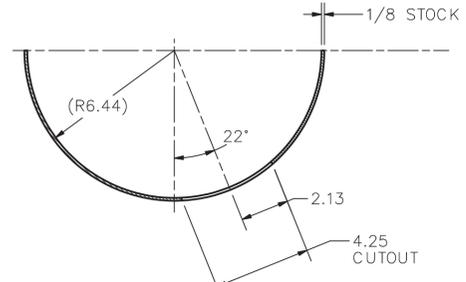

SECTION K-K SCALE: 1/4

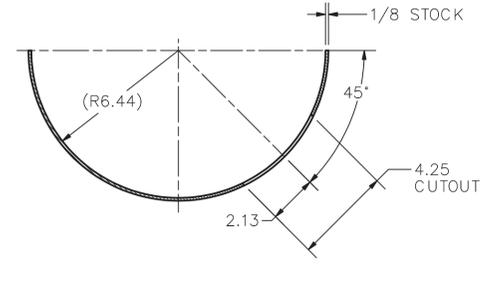

SECTION G-G SCALE: 1/4

10 DETAIL SCALE: 1/4

9 DETAIL SCALE: 1/4

SIZE	INDEX	CODE	NUMBER	DWG-	786869	REV	1
D	AREA	TYPE	CL	ORIG			
	200	0666	53	136			
SCALE: NOTED					FS	SHEET	4

File: 786869-1.dwg
Path: \\VA-Yout\Designs\MISC\MECA\CONDENSER_NEW\786869-1.dwg
Layout Name: ID: penimr

REV	DESCRIPTION
1	SEE DRF-346066 INCORPORATED FDC-10284, FDC-10309 FDC-10323, FDC-10432

NOTES:

- REMOVE ALL BURRS AND SHARP EDGES.
- ALL MACHINED FILLET RADII .030 MAXIMUM UNLESS OTHERWISE NOTED.
- FINAL ASSEMBLY SHALL BE FREE OF DIRT, CHIPS, WELDING FLUX, SLAG, SCALE OIL, GREASE, ETC. PERFORM A VISUAL INSPECTION ON THE FINAL ASSEMBLY PER ASTM A380, PARA 7.2.1 FOR OFF-SITE FABRICATION OR FINAL ASSEMBLY SHALL MEET CLEANLINESS REQUIREMENTS OF STD-7022, LEVEL D FOR ON-SITE FABRICATION.
- WELDING SHALL BE PERFORMED IN ACCORDANCE WITH ASME B&PV CODE, SECTION IX USING ITEM 9 FOR OFF-SITE FABRICATION OR WELD PER INL WELD PROCEDURE SPECIFICATION S2.0 USING ITEM 9 FOR ON-SITE FABRICATION.
- VISUALLY INSPECT FINAL PASS OF ALL WELDS. ACCEPTANCE CRITERIA SHALL BE:
NO CRACKS.


COMPLETE FUSION SHALL EXIST BETWEEN WELD METAL AND BASE METAL UNDERCUT SHALL NOT EXCEED 0.01" FOR MATERIAL 3/16". FOR MATERIAL 3/16" AND THICKER, UNDERCUT NOT TO EXCEED 1/32".

FOR ALL WELDS, THE SUM OF VISIBLE POROSITY 1/32" OR GREATER IN DIAMETER SHALL NOT EXCEED 3/8" IN ANY LINEAR INCH OF WELD AND SHALL NOT EXCEED 3/4" IN ANY 12" LENGTH OF WELD.

ALL CRATERS SHALL BE FILLED TO THE FULL CROSS-SECTION OF THE WELD EXCEPT FOR ENDS OF FILLET WELDS OUTSIDE THEIR EFFECTIVE LENGTH.


FILLET WELDS SHALL BE AT LEAST THE SIZE SPECIFIED IN THE WELD SYMBOL.

- TORQUE 5/16" BOLTS TO 11 FT LBS (+1/-0 FT LBS).
- VERIFY WITH CONDENSER DIMENSIONS.

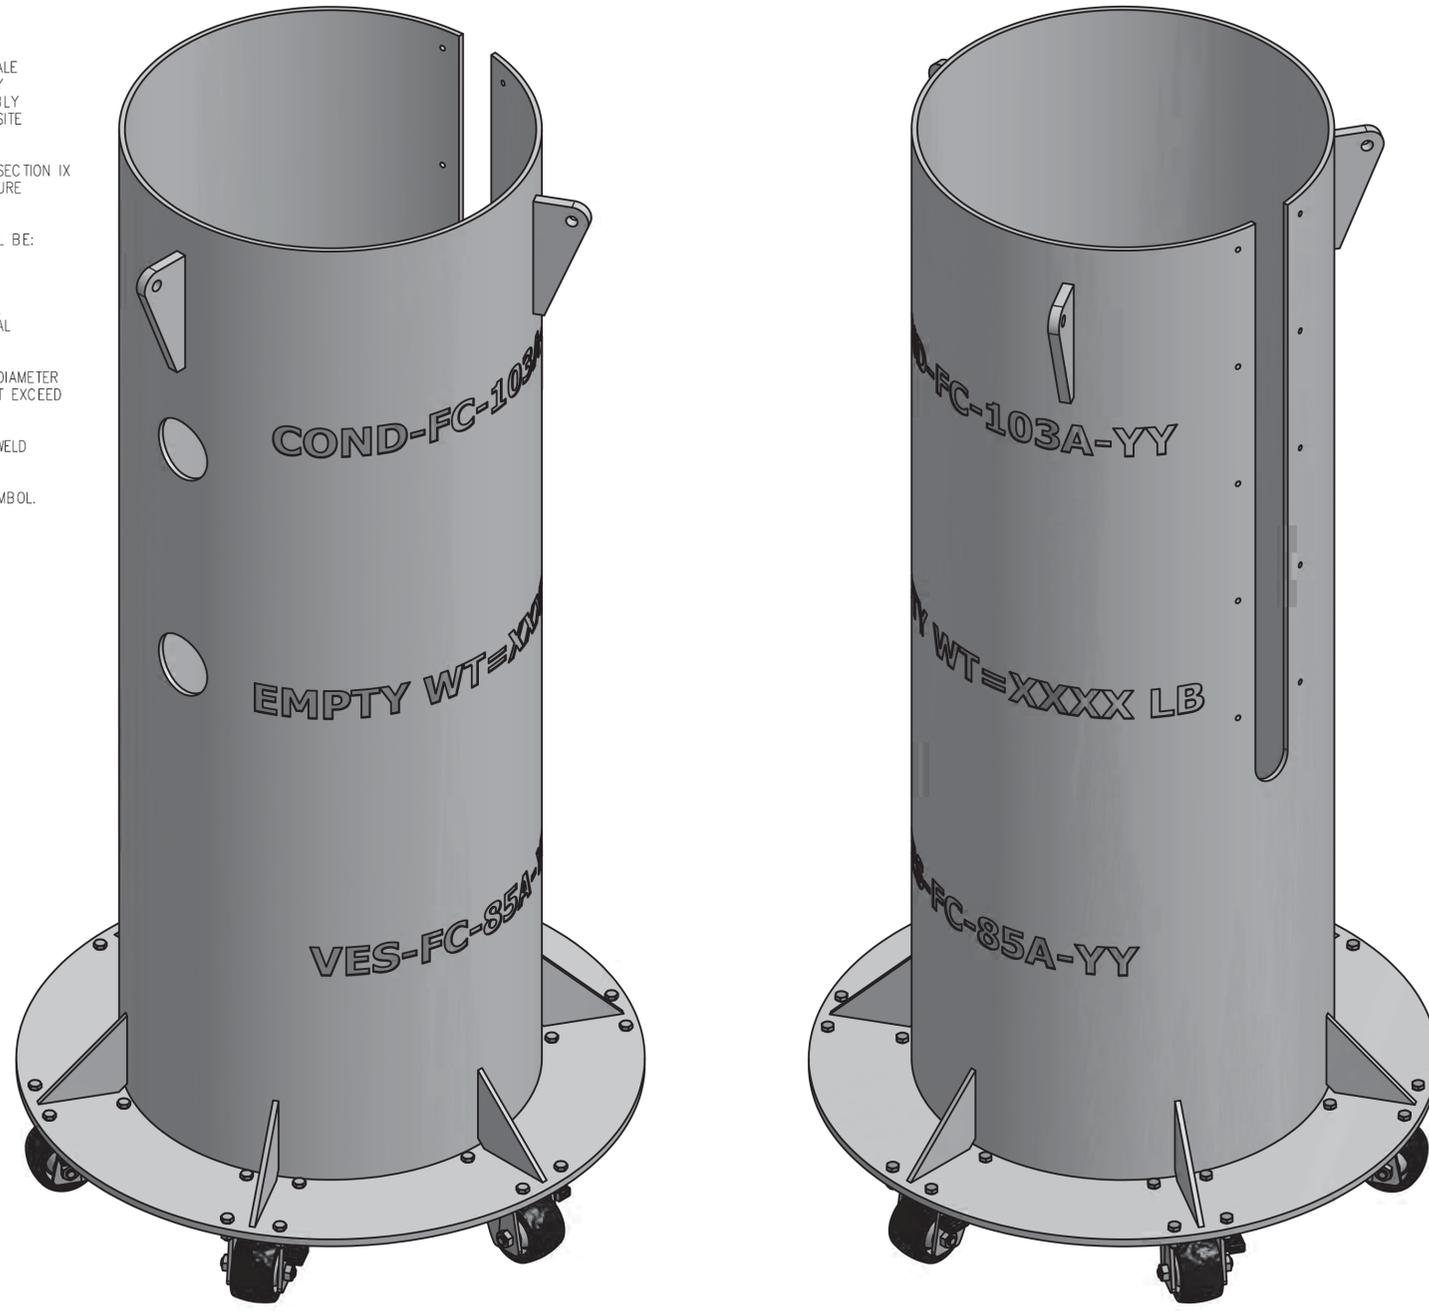

3D VIEW
(SHOWN FOR CLARITY)
SCALE: NONE

-0 ASSEMBLY

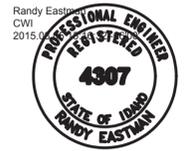

I CERTIFY THAT THIS DRAWING REFLECTS THE CURRENT CONSTRUCTED CONDITION AS OF 7-15-15

INSPECTION REQUIREMENTS	
QC REQUIRED	-0
DENOTES Q/C INSP. RECD.	Q

QTY REQD	LEVEL	PART OR IDENTIFYING NO.	NOMENCLATURE OR DESCRIPTION	MATERIAL/SPECIFICATION OR VENDOR NAME	ITEM NO.
1	3	-10	SHIELD PLATE	PLATE, 304 OR 304L SST ASTM A240	10
AR	3		WELD FILLER METAL	ER 308 OR 308L AWS 5.9	9
24	3		NUT, HEX 5/16-18 UNC	GRADE 8 SST ASTM A194	8
24	3		WASHER, FLAT 5/16 DIA	TYPE 3 ASTM F436	7
24	3		BOLT, HEX HD 5/16-18UNC X 1 LG.	GRADE B8 SST ASTM A193	6
6	3	4937T14	CASTER, HEAVY DUTY, LOW PROFILE 3" X 1 13/16" NYLON WHEEL WITH BRAKE 1000 LB CAP.	McMASTER-CAR	5
6	3	-4	GUSSET	PLATE, 304 OR 304L SST ASTM A 240	4
3	3	-3	LIFTING LUG	PLATE, 304 OR 304L SST ASTM A240	3
1	3	-2	BOTTOM PLATE	PLATE, 304 OR 304L SST ASTM A240	2
1	3	-1	OUTER SHIELDING BODY	PLATE, 304 OR 304L SST ASTM A240	1
	3	-0	ASSEMBLY		0

DIMENSIONING AND SYMBOLY PER		SIGNATURES/DATES APPLY TO CURRENT RELEASE ONLY	
ASME Y14.5-2009 AND STD-11		DESIGN:	Rodney C. Campbell HukanAscendant 2015.08.05 14:49:28 -0600
UNLESS OTHERWISE SPECIFIED		DRAFTER:	R. CAMPBELL
SURFACE ROUGHNESS 125/		TECHNICAL CHECK:	Troy P. Burnett Walsh Engineering 2015.08.05 15:14:54 -0600
DIMENSIONS AND TOLERANCES ARE IN INCHES		ENG GROUP SUPERVISOR:	T. BURNETT P.E.
TOLERANCES .X ± .1		DESIGN LEAD/AUTHORITY:	Randy Eastman CWI 2015.08.05 16:16:22 -0600
DECIMALS .XX ± .03		DRAFTING CHECK/EFFECTIVE DATE:	D. MORGAN CWI 2015.08.05 14:54:50 -0600
.XXX ± .010		PROJECT NUMBER:	31720
FRACTIONS ± 1/8		DRF NUMBER:	343891
ANGULAR ± 2'			
DO NOT SCALE DRAWING			

Idaho Cleanup Project

CPP-666
RH-TRU DISTILLATION SYSTEM
CONDENSER / COLLECTION VESSEL
OUTER SHELL ASSEMBLY

SIZE	INDEX	CODE	NUMBER
D	200	0666	53136

DWG- 786870

SCALE: NOTED

REV 1

SHEET 1 OF 3

D

C

B


A

D


C

B



A

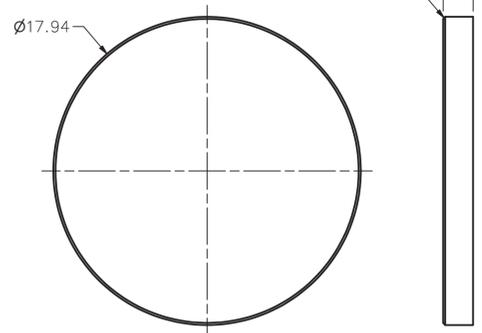





⑩ DETAIL
SCALE: 3/16

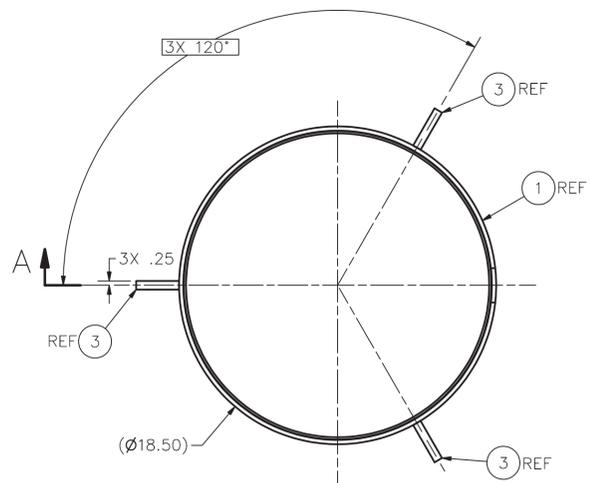

BOTTOM FLANGE, WHEELS
AND BOLTING NOT SHOWN
FOR CLARITY

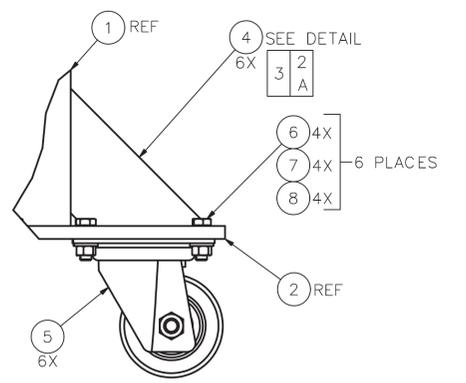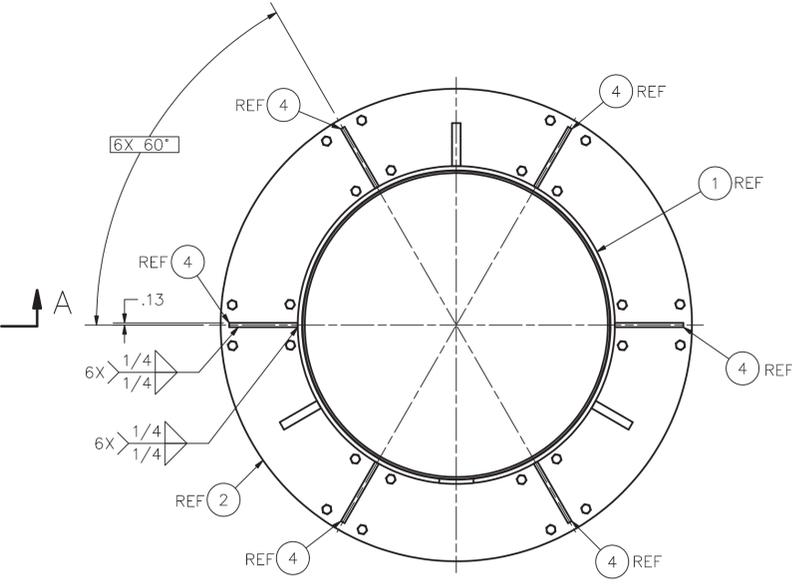

VIEW C
SCALE: 3/8

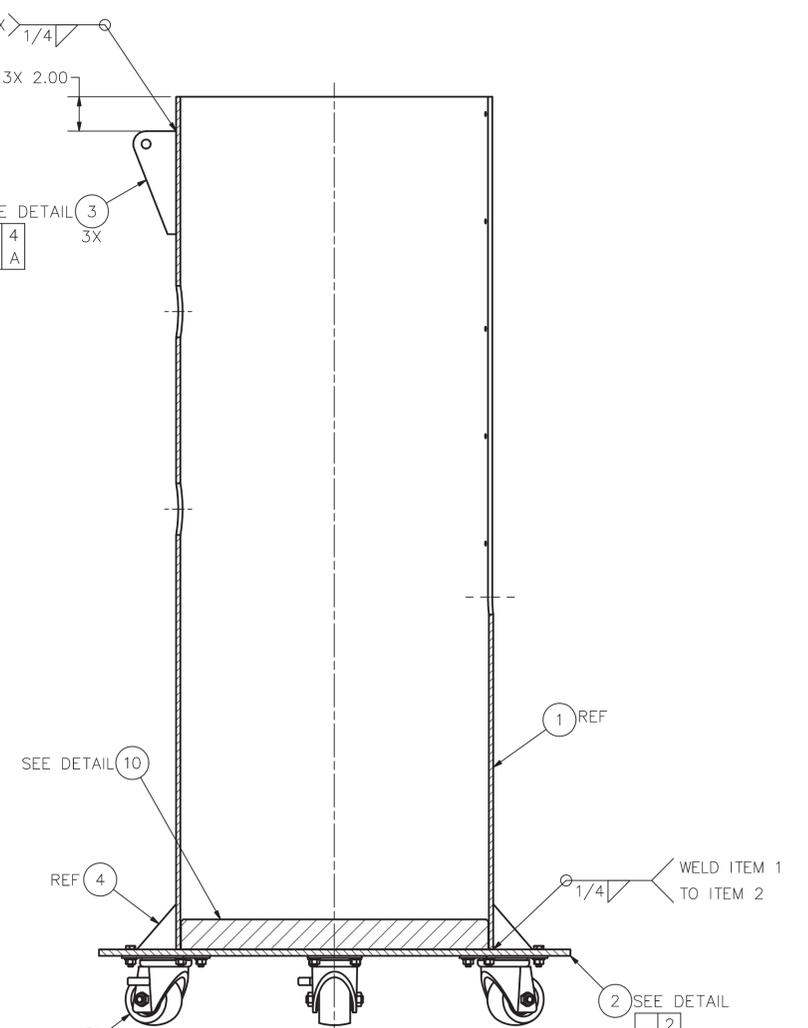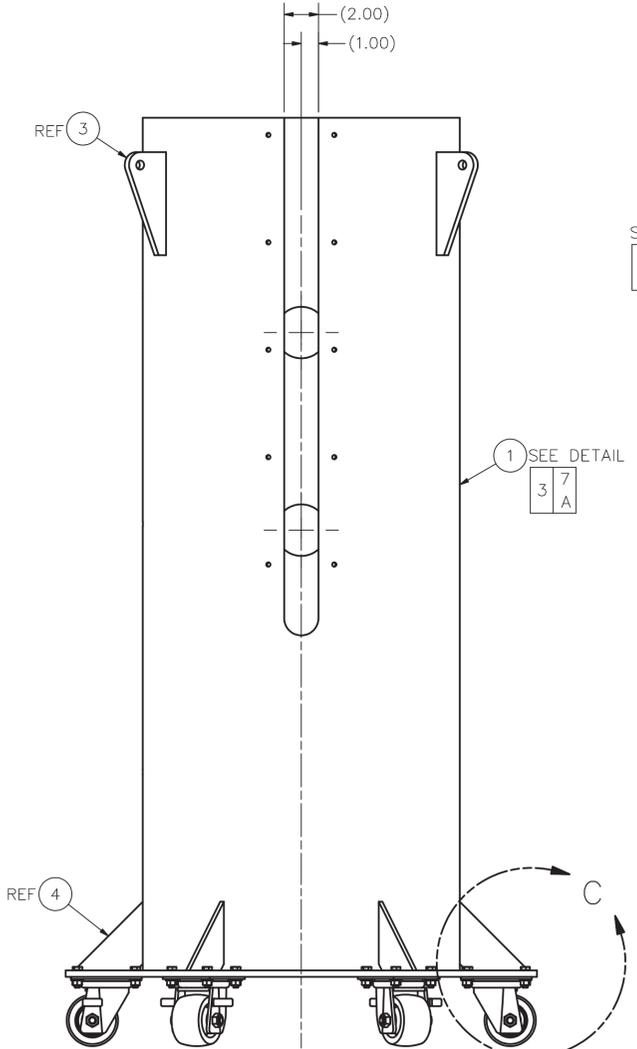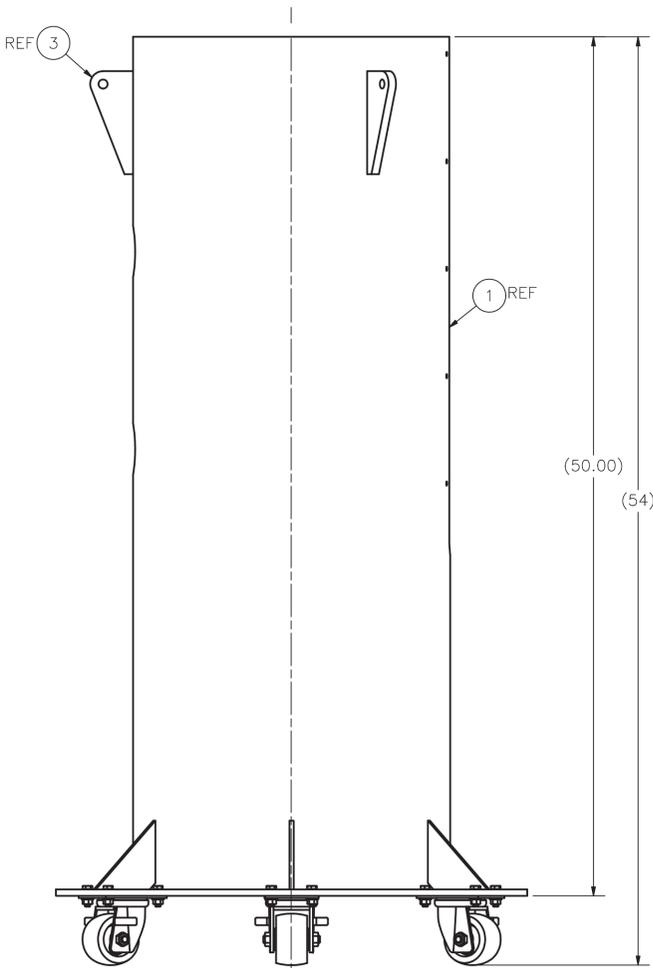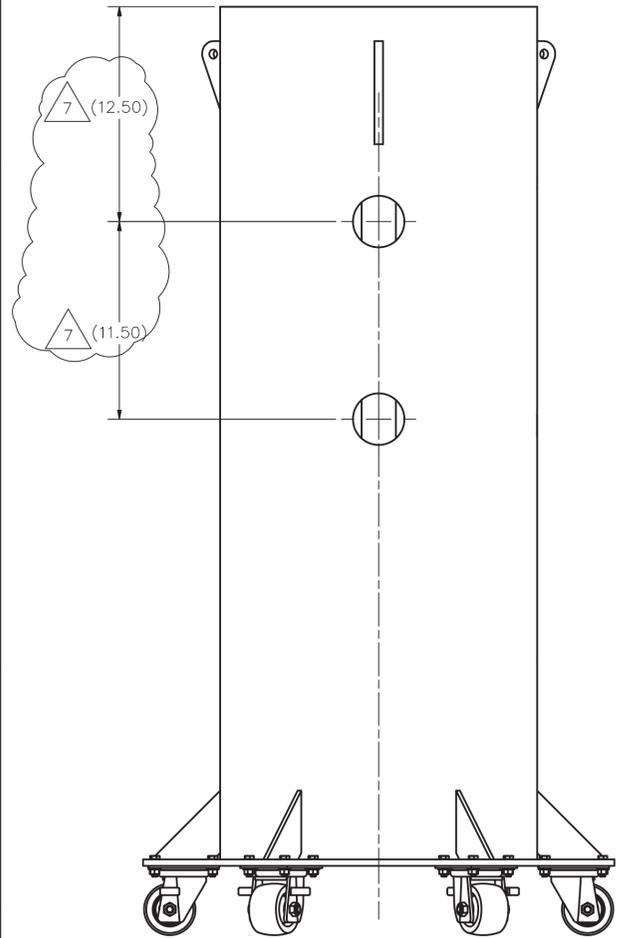



SECTION A-A

-0 ASSEMBLY
SCALE: 3/16




SCALE: 3/16

SIZE	INDEX	CODE	NUMBER	DWG-	786870	REV	1
D	AREA	TYPE	CL	ORIG			
	200	0666	53	136			
SCALE: NOTED				FS	SHEET	2	


8 7 6 5 4 3 2 1

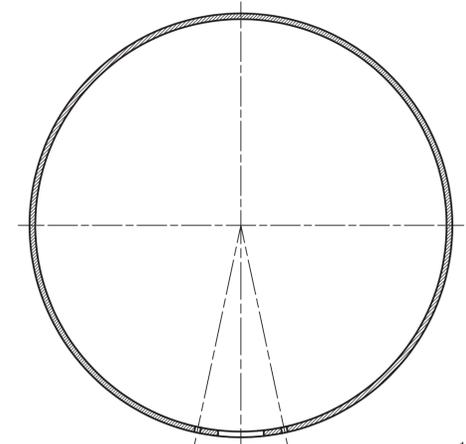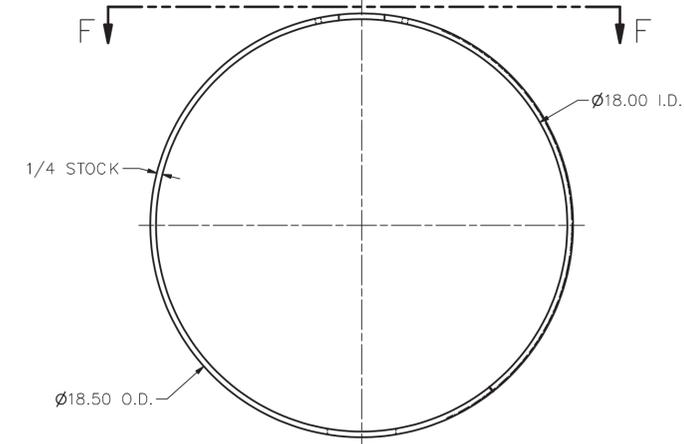


12" 12"
 10X 1/4-20UNC THRU
 MATCH LOCATE USING
 ITEM 17 DWG 786868
 AS A TEMPLATE
 SCALE: 1 / 4

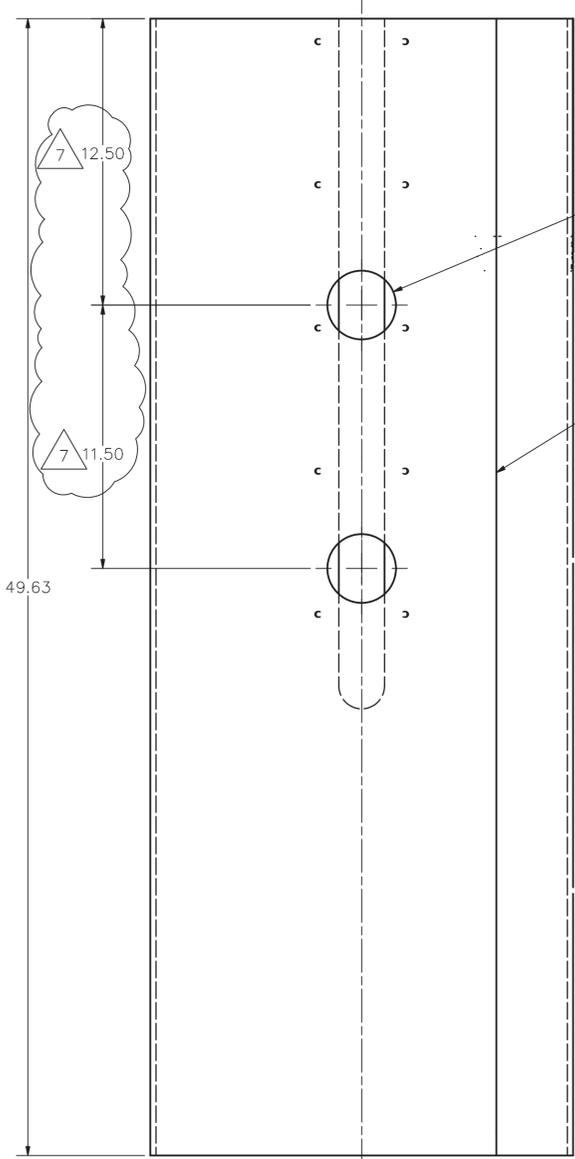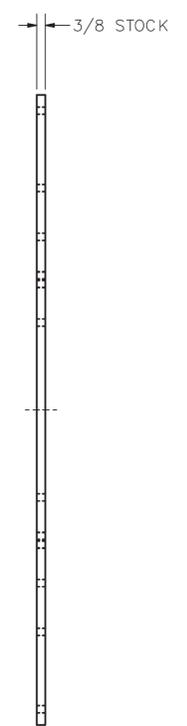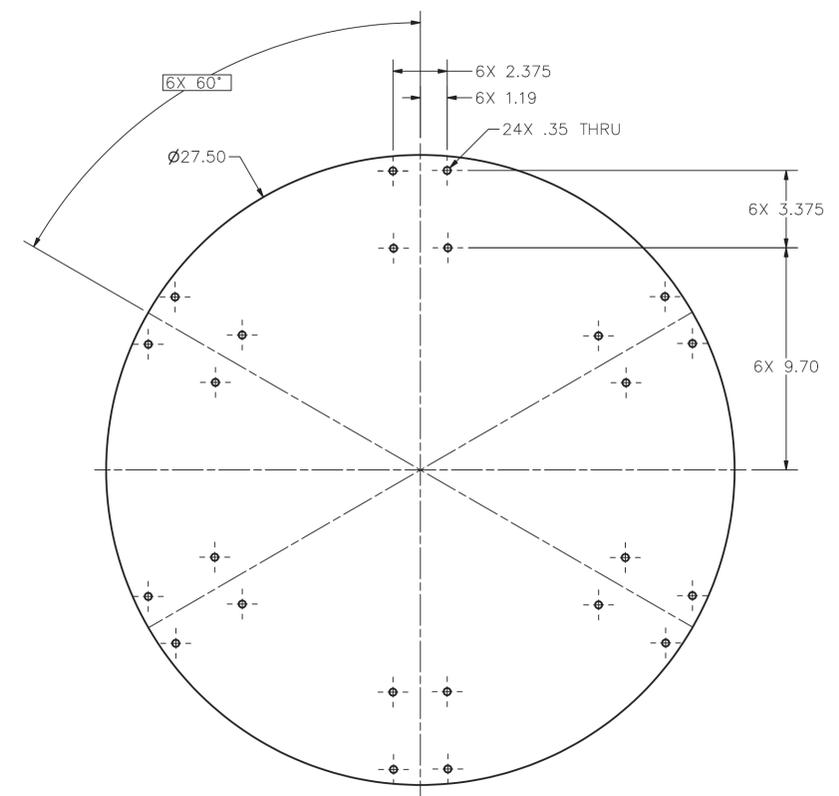



1 DETAIL
 SCALE: 1/4

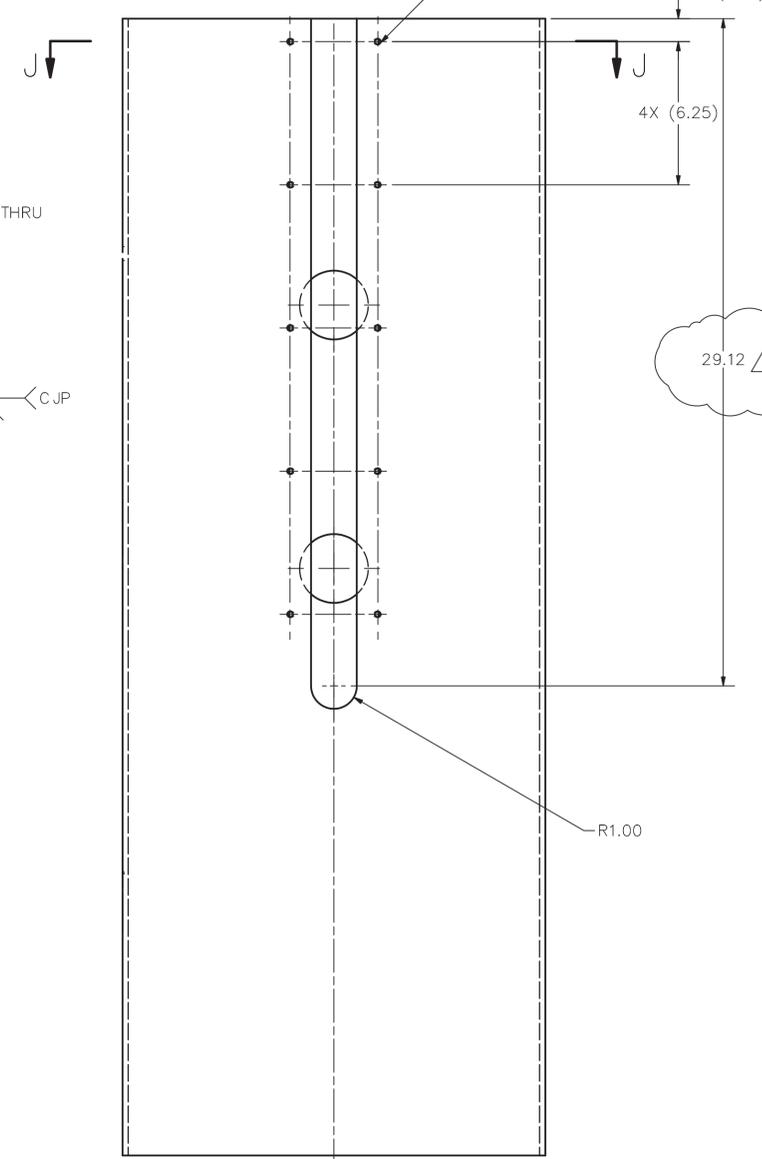


VIEW F
 SCALE: 1/4

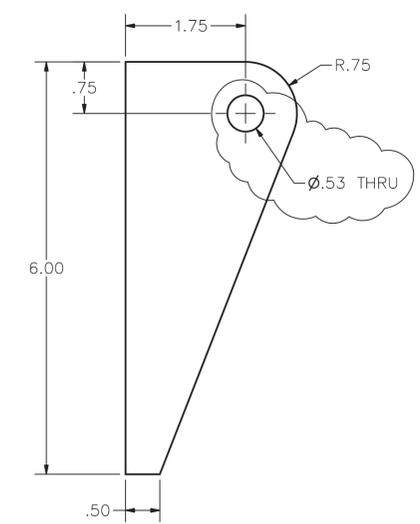

3 DETAIL
 SCALE: 3/4

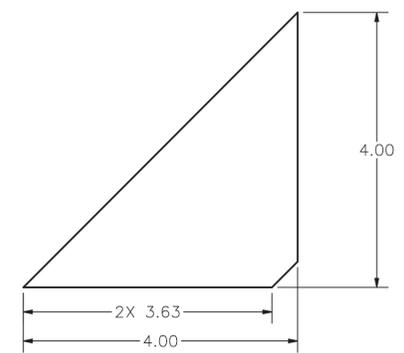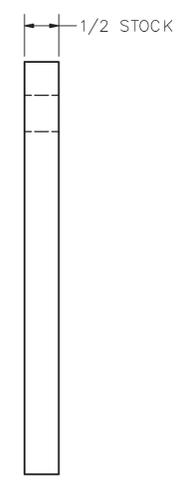

4 DETAIL
 SCALE: 3/4

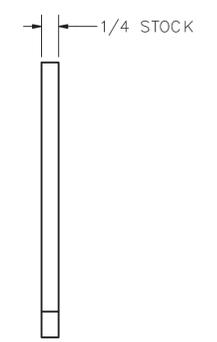

SIZE	INDEX	CODE	NUMBER	DWG-	786870	REV	1
D	AREA	TYPE	CL	ORIG			
	200	0666	53	136			
SCALE: NOTED				FS	SHEET	3	

8 7 6 5 4 3 2 1

REVISIONS	
REV	DESCRIPTION


NOTES:

- REMOVE ALL BURRS AND SHARP EDGES.
- ALL MACHINED FILLET RADII .030 MAXIMUM UNLESS OTHERWISE NOTED.
- FINAL ASSEMBLY SHALL BE FREE OF DIRT, CHIPS, WELDING FLUX, SLAG, SCALE OIL, GREASE, ETC. FOR OFF-SITE FABRICATION OR FINAL ASSEMBLY SHALL MEET CLEANLINESS REQUIREMENTS OF STD-7022, LEVEL C FOR ON-SITE FABRICATION.
- WELDING SHALL BE PERFORMED IN ACCORDANCE WITH ASME B & PV CODE, SECTION IX USING ITEM 4 FOR OFF-SITE FABRICATION OR WELD PER INL WELD PROCEDURE SPECIFICATION S2.0 USING ITEM 4 FOR ON-SITE FABRICATION.



- VISUALLY INSPECT ALL WELDS IN ACCORDANCE WITH ASME B&PV CODE, SECTION V, ARTICLE 9 FOR OFF-SITE FABRICATION OR VISUALLY INSPECT ALL WELDS IN ACCORDANCE WITH TPR-4981 "VISUAL EXAMINATION" FOR PRESSURE VESSELS. ACCEPTANCE CRITERIA SHALL BE PER APPENDIX B, "ACCEPTANCE CRITERIA FOR ASME CODE, SECTION VIII, DIVISION 1 WELDS, BASE MATERIALS AND BRAZING" FOR ON-SITE FABRICATION.
- LIQUID PENETRANT EXAMINATION FOR OFF-SITE FABRICATION SHALL BE PERFORMED IN ACCORDANCE WITH THE B&PV CODE SECTION VIII ARTICLE 6. ACCEPTANCE CRITERIA SHALL BE:
 - ALL SURFACES TO BE EXAMINED SHALL BE FREE OF:
 - RELEVANT LINEAR INDICATIONS
 - RELEVANT ROUNDED INDICATIONS GREATER THAN 5 MM (3/16")
 - FOUR OR MORE RELEVANT ROUNDED INDICATIONS IN A LINE SEPARATED BY 1.5 MM (1/16") OR LESS, EDGE-TO-EDGE.
 - CRACK LIKE INDICATIONS DETECTED, IRRESPECTIVE OF SURFACE CONDITIONS, ARE UNACCEPTABLE.

LIQUID PENETRANT EXAMINATION FOR ON-SITE FABRICATION SHALL BE PERFORMED ON ALL WELDS IN ACCORDANCE WITH TPR-4975 "LIQUID PENETRANT EXAMINATION," APPENDIX H, WITH ACCEPTANCE PER APPENDIX H, "ACCEPTANCE CRITERIA FOR ASME B31.3 POWER PIPING WELDS." USE LIQUID PENETRANT EXAMINATION OF ROOT AND FINAL PASS FOR BUTT WELDS AND FINAL PASS FOR FILLET WELDS .

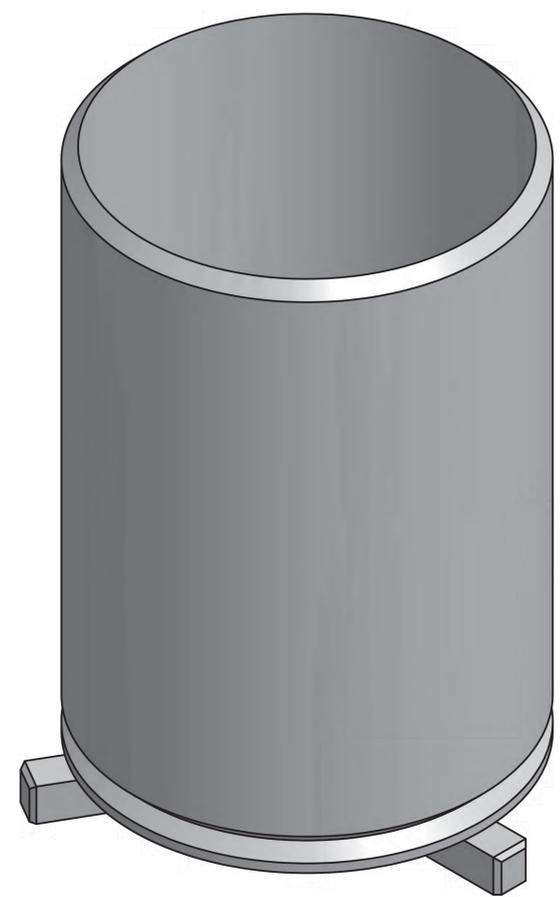

3D VIEW
(SHOWN FOR CLARITY)
SCALE: NONE

-0 ASSEMBLY

QTY REQD	QUAL LEVEL	PART OR IDENTIFYING NO.	NOMENCLATURE OR DESCRIPTION	MATERIAL/SPECIFICATION OR VENDOR NAME	ITEM NO.
		AR 3	WELD FILLER METAL	ER 308 OR 308L SST AWS A5.9	4
		3 3	FOOT	BAR OR PLATE, 304 OR 304L SST ASTM A276 OR A240	3
		1 3	BOTTOM HEAD	PLATE, 304 OR 304L SST ASTM A240	2
		1 3	COLLECTION TANK BODY	PIPE, 304 OR 304L SST ASTM A312	1
			ASSEMBLY		0

DIMENSIONING AND SYMBOLY PER ASME Y14.5-2009 AND STD-11 UNLESS OTHERWISE SPECIFIED SURFACE ROUGHNESS 125/ DIMENSIONS AND TOLERANCES ARE IN INCHES TOLERANCES .X ± .1 DECIMALS .XX ± .03 FRACTIONS ± 1/8 ANGULAR ± 2' DO NOT SCALE DRAWING		SIGNATURES/DATES APPLY TO CURRENT RELEASE ONLY DESIGN: R. CAMPBELL DRAFTER: O. MORGAN TECHNICAL CHECK: T. BURNETT P.E. ENG GROUP SUPERVISOR: R. EASTMAN P. E. DESIGN LEAD/AUTHORITY: D. MORGAN DRAFTING CHECK/EFFECTIVE DATE: S. BERTHELSON PROJECT NUMBER: 31720 DRF NUMBER: 343891		Idaho Cleanup Project CPP-666 RH-TRU DISTILLATION SYSTEM COLLECTION TANK ASSEMBLY VES-FC-85A	
INSPECTION REQUIREMENTS	-0 786869	DASH NO.	NEXT ASSY	SCALE: NOTED	DWG- 786871
QC REQUIRED					REV
Q DENOTES Q/C INSP. REQD.					200 0666 53 136
					FS SHEET 1 OF 2



INSPECTION REQUIREMENTS	-0 786869
DASH NO.	NEXT ASSY
QC REQUIRED	
Q DENOTES Q/C INSP. REQD.	

D

D

C

C

B

B

A

A

Layout Name: ID: penimr File: 789018.dwg Path: \\VA-Vault\Designs\MISC\MISC\CONDENSER_NEW\789018.dwg

D

C

B

A



D

C



B

A


8 7 6 5 4 3 2 1

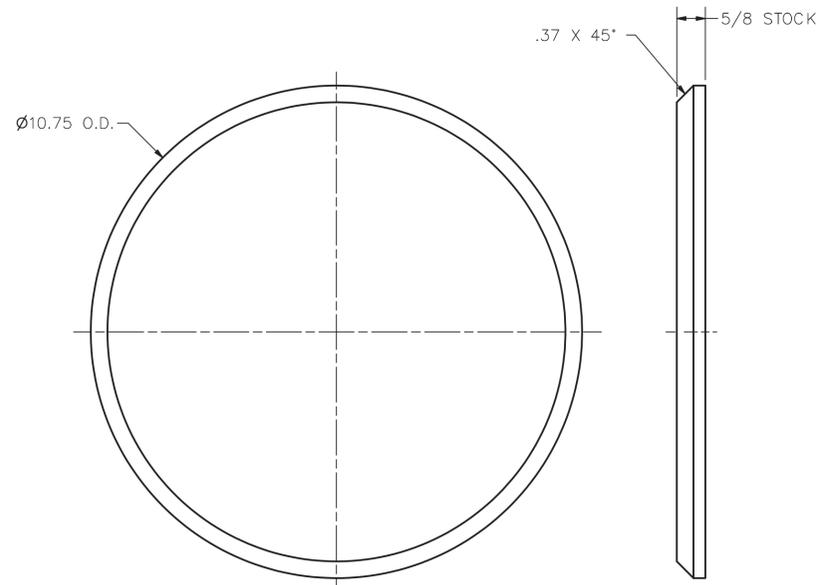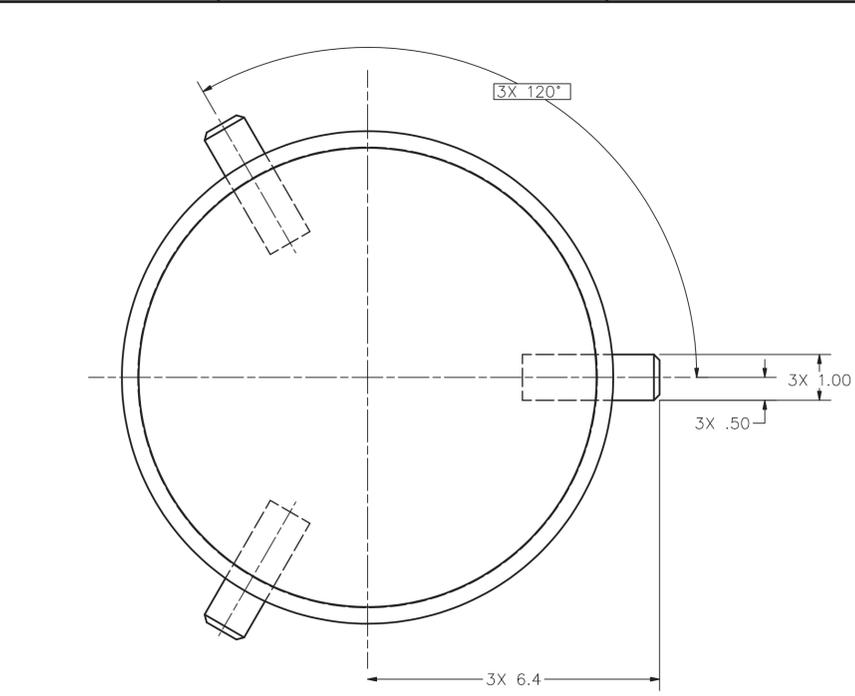



② DETAIL
SCALE: 1/2

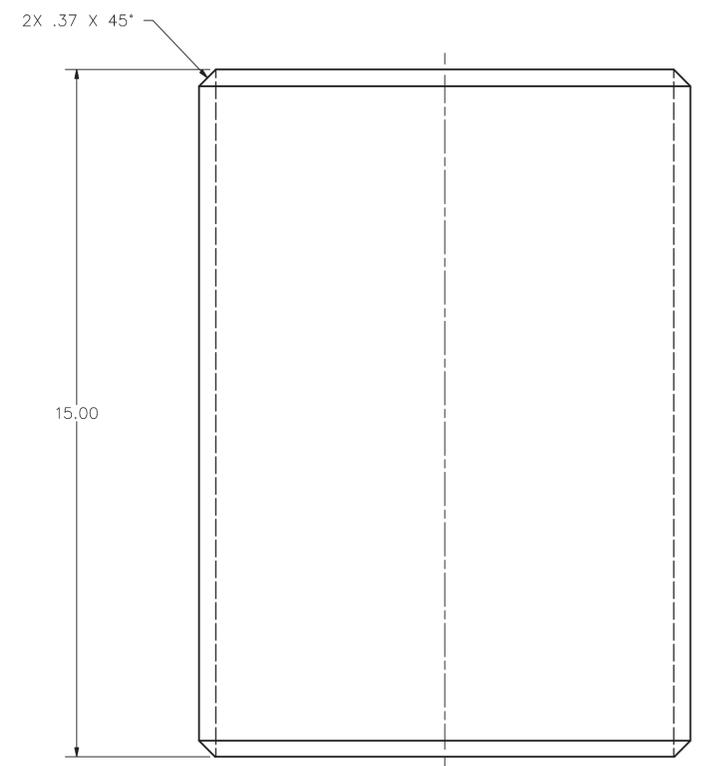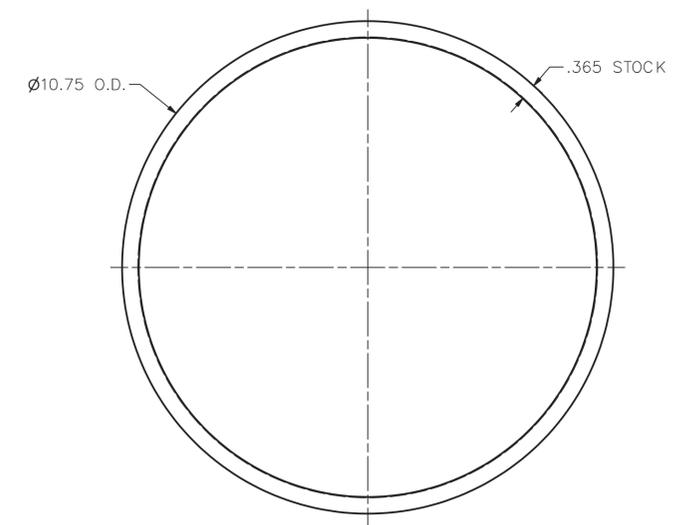

① DETAIL
SCALE: 1/2

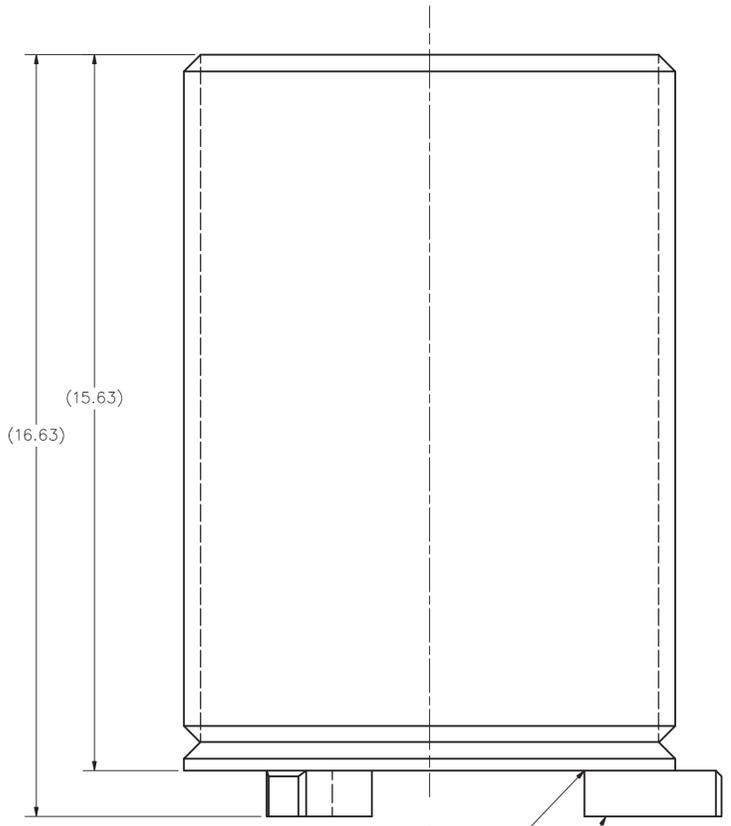

—0 ASSEMBLY
SCALE: 1/2

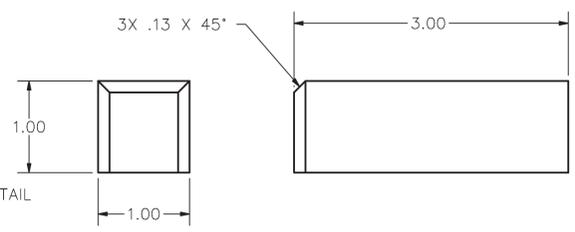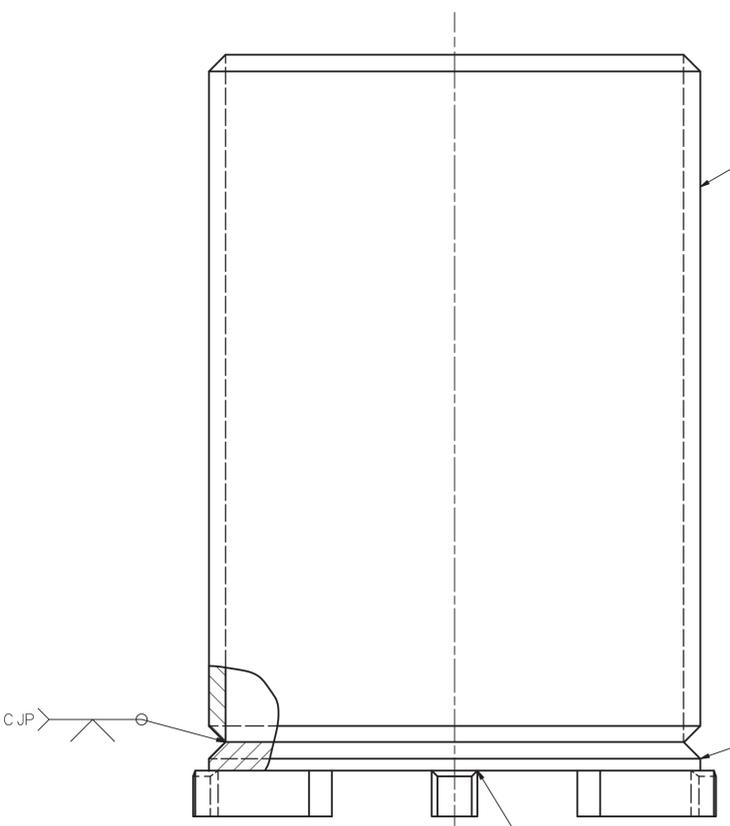

③ DETAIL
SCALE: 1/1

Layout Name: File: 789018.dwg Path: \\VA-Yout\Designs\MISC\MECA\CONDENSER_NEW\789018.dwg

SIZE	INDEX	CODE	NUMBER	DWG-	786871	REV
D	AREA	TYPE	CL	ORIG		
	200	0666	53	136		
SCALE: NOTED				FS	SHEET	2

8 7 6 5 4 3 2 1

REV	DESCRIPTION
1	SEE DRF-346066 INCORPORATED FDC-10336, FDC-10340

NOTES:

- REMOVE ALL BURRS AND SHARP EDGES.
- ALL MACHINED FILLET RADII .030 MAXIMUM UNLESS OTHERWISE NOTED.
- FINAL ASSEMBLY SHALL MEET CLEANLINESS REQUIREMENTS OF STD-7022, LEVEL C.
- MARK PER STD-7006-2A OR STD-7006-2D IN 1/2" HIGH CHARACTERS WITH INFORMATION AS SHOWN WHERE "XX" IS THE UNIQUE NUMBER ASSIGNED TO EACH ASSEMBLY BUILT AND "YY" IS THE MEASURED WEIGHT OF THE -0 ASSEMBLY TO THE NEAREST POUND. LOCATE APPROXIMATELY WHERE SHOWN. FILL CHARACTERS WITH SANFORD T.E.C. MARKER #13401 OR #13501, ITW DYMON FORMULA Q404 INK OR OTHER HIGH-PURITY LOW-CHLORIDE BLACK INK THAT COMPLIES WITH ASTM C1217-00 OR RDT F7-3T. DO NOT APPLY VARNISH OVER MARKING.
- VERIFY MARKINGS HAVE BEEN ACCURATELY APPLIED AND RECORD THE MEASURED WEIGHT.
- WELD STAINLESS TO STAINLESS PER INL WELD PROCEDURE SPECIFICATION S2.0 USING WELD FILLER METAL, ITEM 10.
- VISUALLY INSPECT ALL WELDS IN ACCORDANCE WITH ASME B & PV CODE, SECTION V, ARTICLE 9.
- LIQUID PENETRANT EXAMINATION SHALL BE PERFORMED ON ALL WELDS IN ACCORDANCE WITH ASME B & PV CODE, SECTION V, ARTICLE 6.
- COMPLETED ASSEMBLY SHALL UNDERGO A PNEUMATIC LEAK TEST IN ACCORDANCE WITH ASME B & PV CODE SECTION V, ARTICLE 10 AT A PRESSURE OF 16.5 TO 18.5 PSIG. "SNOOP" ALL CONNECTIONS AND WELD JOINTS FOR LEAKS. PRESSURE DROP SHALL NOT EXCEED 0.1 PSIG OVER A 10 MINUTE PERIOD.
- DESIGN TEMPERATURE: 300° F.
- DESIGN PRESSURE: FULL VACUUM TO 15 PSIG.
- COLD TRAP FILTER F-FC-221 DOES NOT FALL WITHIN ASME B & PV CODE, SECTION VIII REQUIREMENTS. HOWEVER, THE FILTER HAS BEEN DESIGNED IN ACCORDANCE WITH THE B & PV CODE AS BEST ENGINEERING PRACTICE. SEE EDF-10661 "RH-TRU DISTILLATION & FACILITY MODIFICATIONS SDS COLD TRAP FILTER DESIGN CALCULATIONS" FOR THE ANALYSIS.



-0 ASSEMBLY
SCALE: 3/4




I CERTIFY THAT THIS DRAWING REFLECTS THE CURRENT CONSTRUCTED CONDITION AS OF 7-15-15

INSPECTION REQUIREMENTS	
QC REQUIRED	-0 FINAL
Q DENOTES Q/C INSP. RECD.	DASH NO. NEXT ASSY
	APPLICATION



AR	AR	3		WELD FILLER METAL	ER308 OR 308L AWS/SFA 5.9	10
5		3	PALL PN: P-24-10-6-RR	METAL FILTER ELEMENT 1 1/2" NPT CONNECTION 10" LG., 2 1/2" OD	PALL CORP	9
1		3	-8	TUBE SHEET PLATE	PLATE 304 SST ASTM A240	8
1		3	-7	TOP HEAD	TUBE WELD CAP, 10" OD. X (10 GA) .134 WALL STOCK TP 316/316L ASTM A774	7
3		3	-6	BASE PLATE	PLATE OR BAR 304 OR 304L SST ASTM A240 OR A276	6
3		3	-5	LEG	ANGLE 304 OR 304L SST ASTM A276	5
1	1	3	QF 40-150-LFT	KF ADAPTER HALF NIPPLE KF40 FLANGE	KURT J. LESKER, CO.	4
1		3		BOTTOM HEAD	TUBE WELD CAP, 10" OD. X (10 GA) .134 WALL TP 316/316L ASTM A774	3
1		3	-2	BODY	TUBE SEAMLESS 304 OR 304L SST ASTM A213 OR A269	2
1		3	-1	HEAD ASSEMBLY		1
		3	-0	ASSEMBLY		0
-1	-0	QUAL	PART OR IDENTIFYING NO.	NOMENCLATURE OR DESCRIPTION	MATERIAL/SPECIFICATION OR VENDOR NAME	ITEM NO.
QTY	REQD	LEVEL				

DIMENSIONING AND SYMBOLS PER ASME Y14.5-2009 AND STD-11 UNLESS OTHERWISE SPECIFIED		SIGNATURES/DATES APPLY TO CURRENT RELEASE ONLY		Idaho Cleanup Project	
SURFACE ROUGHNESS 125/ ARE IN INCHES		DESIGN: R. CAMPBELL	RODNEY C. CAMPBELL HUKAR/ASST/DRFT 2015.08.05 14:48:14 -0600	CPP-666 RH-TRU DISTILLATION SYSTEM COLD TRAP FILTER ASSEMBLY F-FC-221	
TOLERANCES .X ± .1 DECIMALS .XX ± .03 .XXX ± .010		DRAFTER: O. MORGAN	ORIN MORGAN URS 2015.08.05 14:28:57 -0600	SCALE: NOTED	
FRACTIONS ± 1/8 ANGULAR ± 2'		TECHNICAL CHECK: N. SEAVER	Randy Eastman CWI 2015.08.05 15:24:04 -0600	DWG- 785276	
DO NOT SCALE DRAWING		ENG GROUP SUPERVISOR: R. EASTMAN, P.E.	Randy Eastman CWI 2015.08.05 15:23:55 -0600	REV 1	
		DESIGN LEAD/AUTHORITY: D. MORGAN	David Morgan CWI 2015.08.05 14:53:37 -0600	SHEET 1 OF 3	
		DRAFTING CHECK/EFFECTIVE DATE: S. BERTHELSON	Shawn Berthelson CWI 2015.08.05 17:21:38 -0600		
		PROJECT NUMBER: 31720			
		DRF NUMBER: 342479			


File: 785276-01.dwg
 Path: \\VA-Vault\Designs\MISC\MEC\Cold Trap\785276-01.dwg
 Layout Name:
 ID: OMORGAN
 B
 A

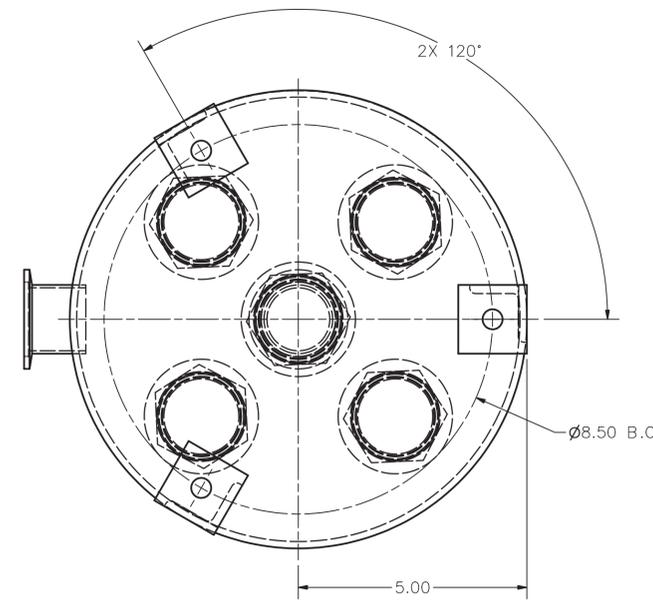



VIEW A-A
SCALE: 1/2

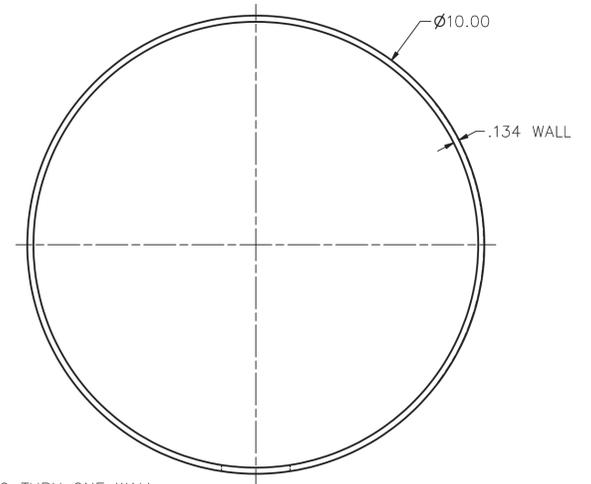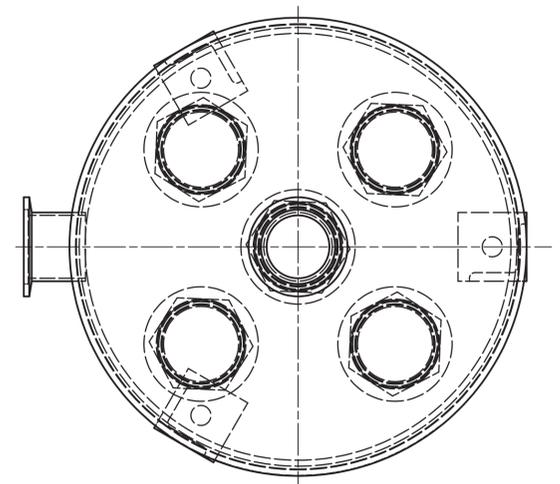


3D VIEW
(SHOWN FOR CLARITY)
SCALE: NONE

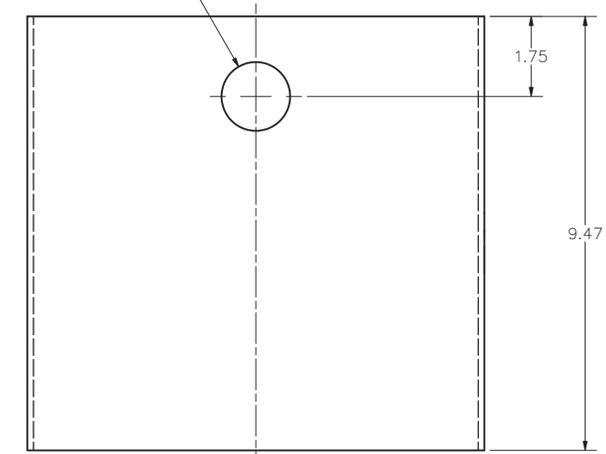


② DETAIL
SCALE: 1/2

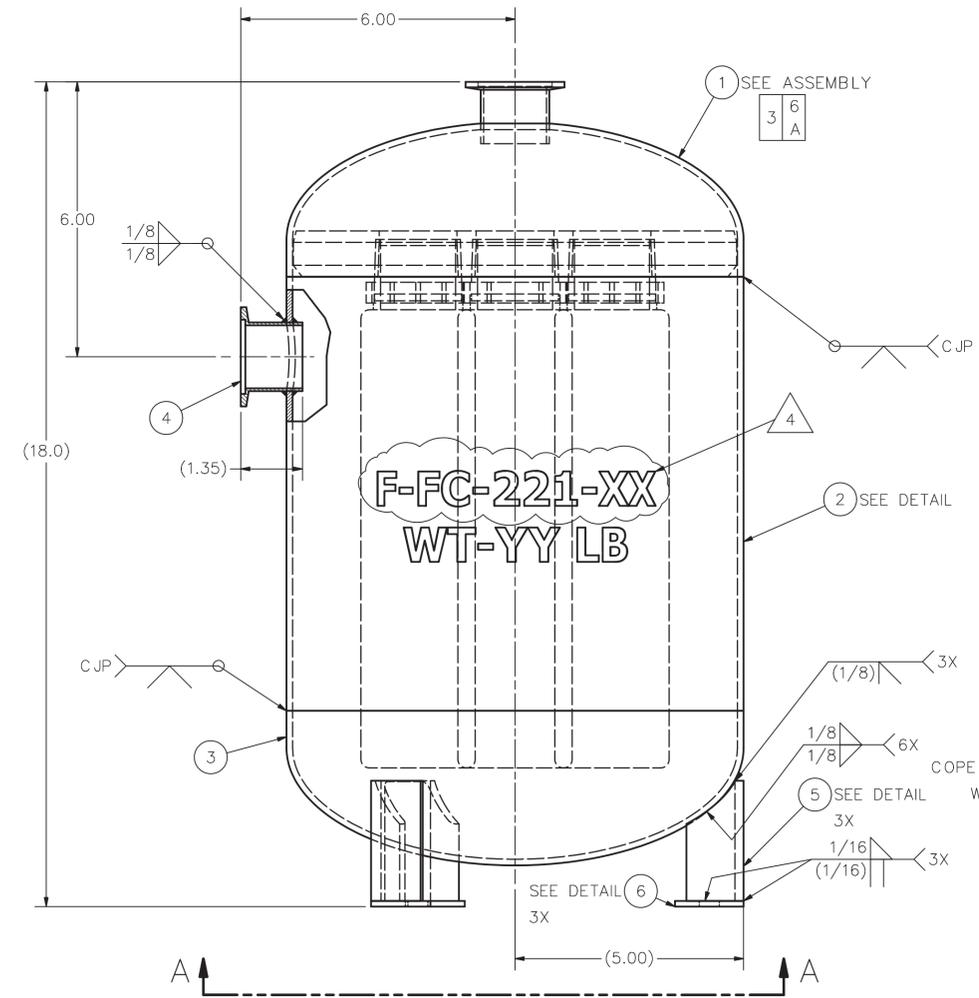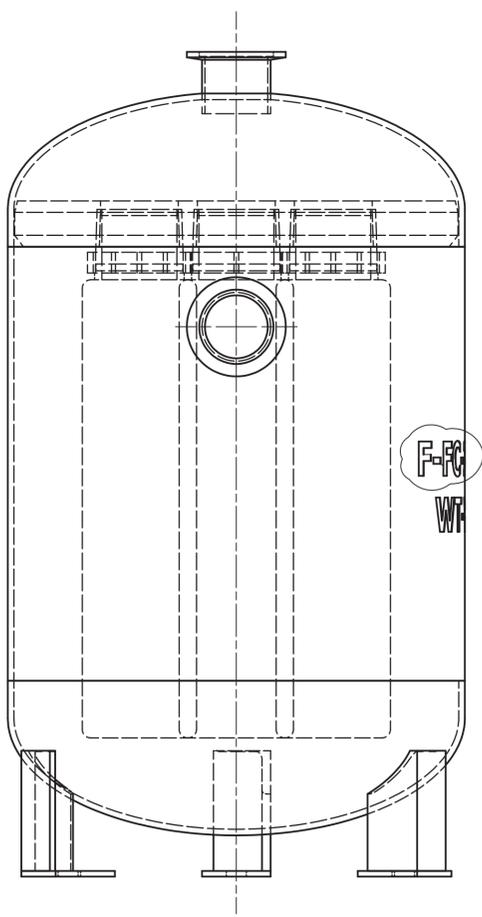

-0 ASSEMBLY
SCALE: 1/2

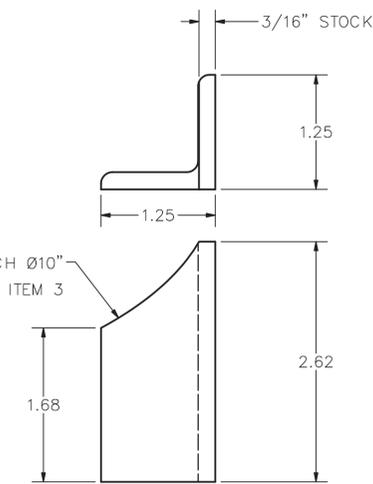



⑤ DETAIL
SCALE: 1/1

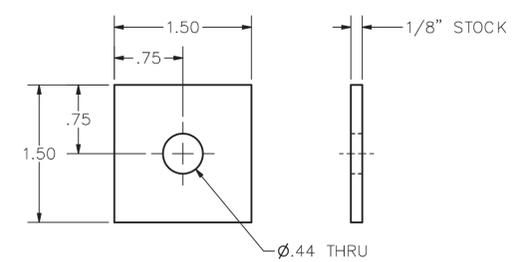


⑥ DETAIL
SCALE: 1/1

SIZE	INDEX CODE	NUMBER	DWG-	785276	REV	1
D	AREA	TYPE	CL	ORIG	FS	SHEET
	200	0666	51	136		2
SCALE: NOTED						


Layout Name: ID: OMORGAN
File: 785276-01.dwg
Path: \\VA-Yout\Designs\MISC\MISC\old_top\785276-01.dwg

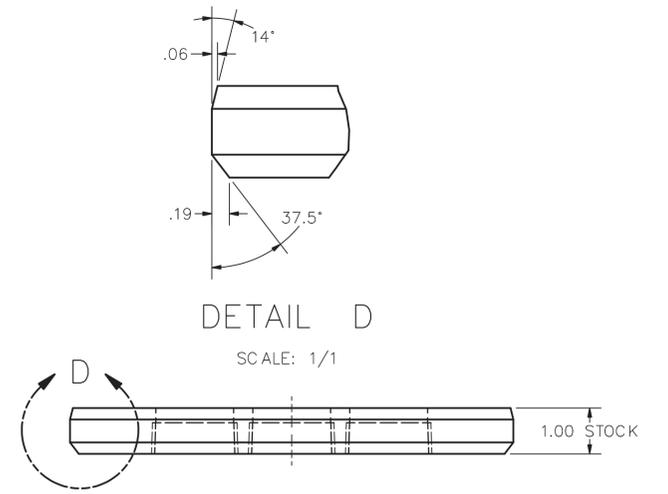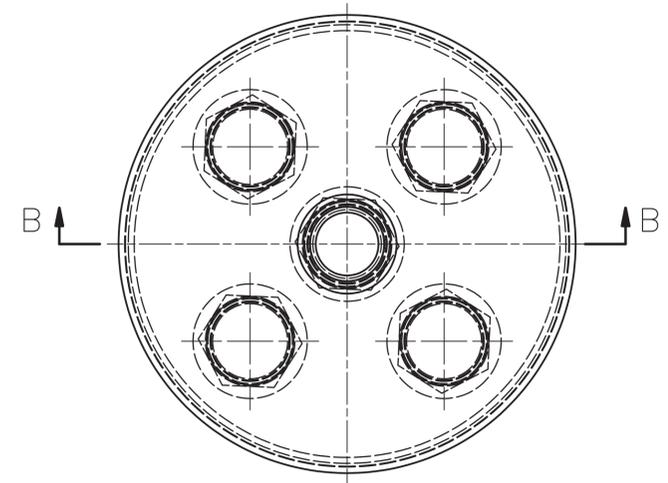

BEFORE WELDING
ITEM 8 TO ITEM 7

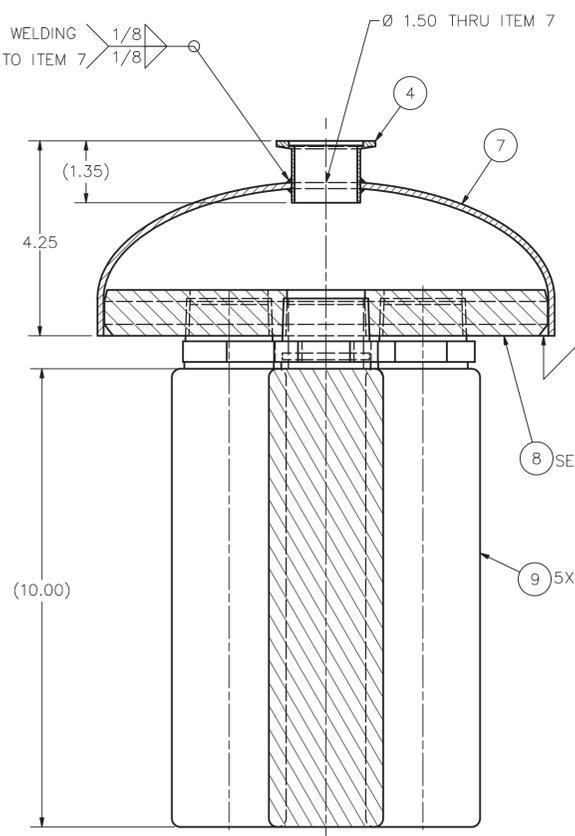


SECTION B-B
SCALE: 1/2

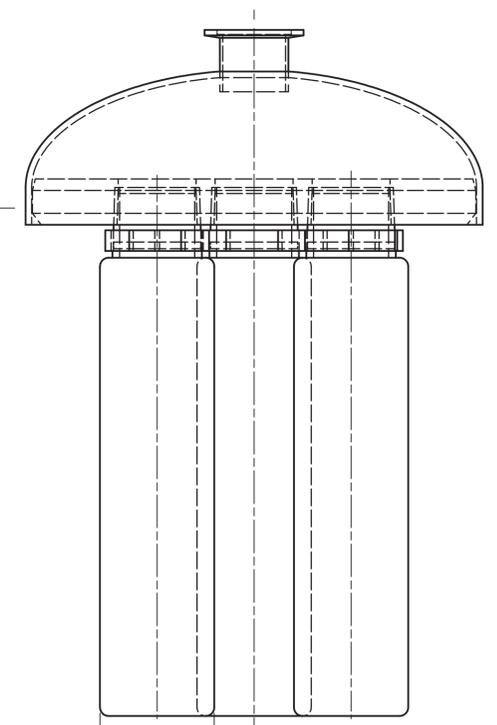


- 1 ASSEMBLY
SCALE: 1/2


3D VIEW
(SHOWN FOR CLARITY)
SCALE: NONE

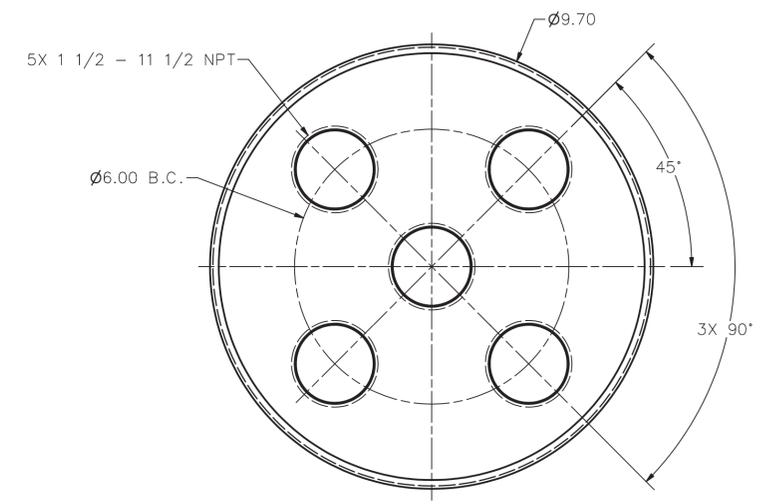

8 DETAIL
SCALE: 1/2

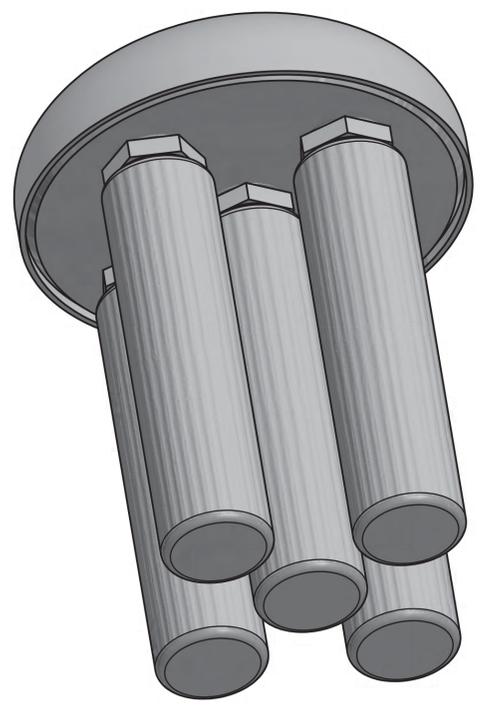

3D VIEW
(SHOWN FOR CLARITY)
SCALE: NONE

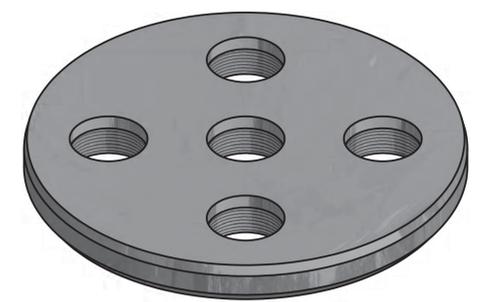


3D VIEW
(SHOWN FOR CLARITY)
SCALE: NONE


SIZE	INDEX CODE	NUMBER	DWG-	785276	REV	1
D	AREA	TYPE	CL	ORIG		
	200	0666	51	136		
SCALE: NOTED			FS	SHEET	3	

NOTES:

1. REMOVE ALL BURRS AND SHARP EDGES.
2. ALL MACHINED FILLET RADII .03 MAXIMUM UNLESS OTHERWISE NOTED.
3. FINAL ASSEMBLY SHALL BE FREE OF DIRT, CHIPS, WELDING FLUX, SLAG, SCALE OIL, GREASE, ETC. PERFORM A VISUAL INSPECTION OF THE FINAL ASSEMBLY PER ASTM A380, PARA 7.2.1.
4. WEDLING SHALL BE PERFORMED IN ACCORDANCE WITH ASME B&PV CODE, SECTION IX, USING ITEM 9. WELD PROCEDURE SPECIFICATION S2.0.
5. PERFORM VISUAL EXAMINATION OF THE FINAL PASS OF ALL WELDS IN ACCORDANCE WITH ASME B31.3, PARAGRAPH 344.2, WITH ACCEPTANCE CRITERIA IN ACCORDANCE WITH TABLE 341.3.2 FOR NORMAL FLUID SERVICE.
6. LIQUID PENETRANT EXAMINATION FOR THE ROOT AND FINAL PASS OF BUTT-WELDS AND FINAL PASS OF FILLET WELDS SHALL BE PERFORMED IN ACCORDANCE WITH ASME B31.3, PARAGRAPH 344.4 WITH ACCEPTANCE CRITERIA IN ACCORDANCE WITH TABLE 341.3.2 FOR NORMAL FLUID SERVICE.
7. COMPLETED ASSEMBLY SHALL UNDERGO A PNEUMATIC LEAK TEST IN ACCORDANCE WITH ASME B31.3 USING A DIRECT PRESSURE BUBBLE TEST AT A PRESSURE OF 15 PSIG (+0/-1 PSIG) "SNOOP" ALL CONNECTIONS AND WELD JOINTS FOR LEAKS.
8. BOLT TORQUES:
TORQUE 5/8-11 UNC BOLTS, ITEM 15 TO 50 (+5/0) FT-LBS
9. DESIGN TEMPERATURE = 1200° F.
10. DESIGN PRESSURE = FULL VACUUM TO 15 PSIG.
11. APPLY THREAD LUBRICANT, ITEM 18, YO ALL BOLT THREADS.
12. PERFORM IN-PROCESS INSPECTION OF WELDS WHERE SPECIFIED PER ASME B31.1, PARAGRAPH 344.7 USING LIQUID PENETRANT EXAMINATION OF THE ROOT AND FINAL PASS OF BUTT-WELDS AND FINAL PASS OF FILLET WELDS.

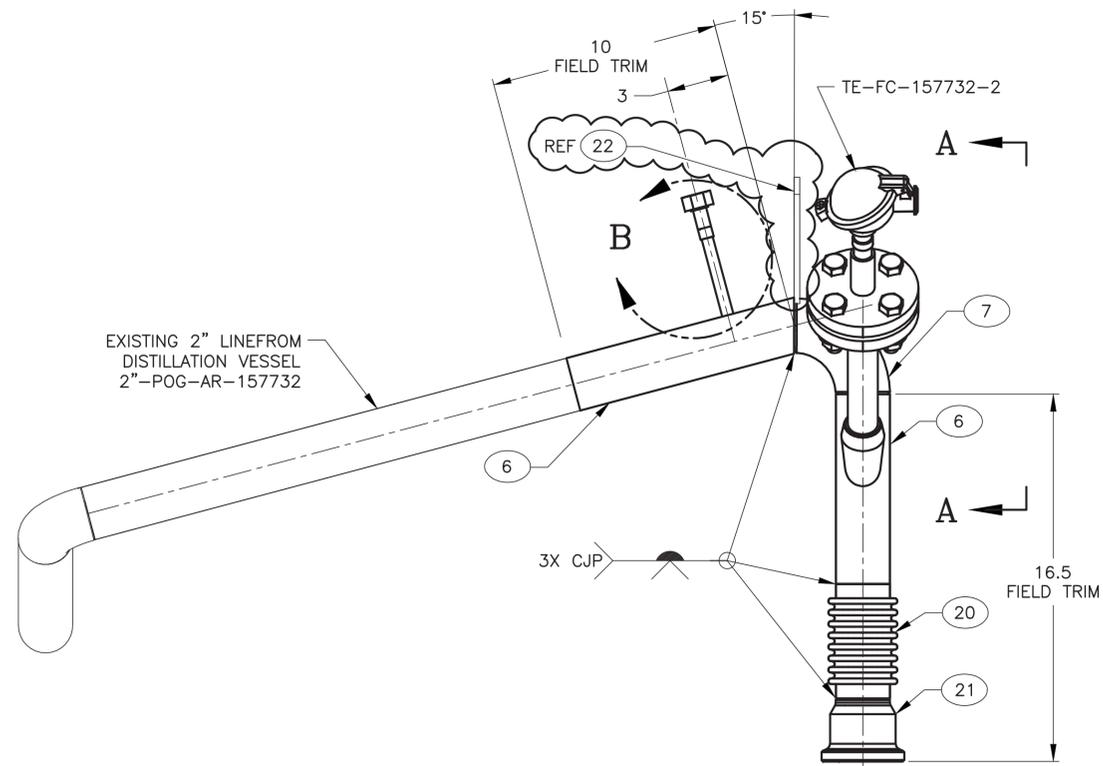


-0 ASSEMBLY
SCALE: 3/8

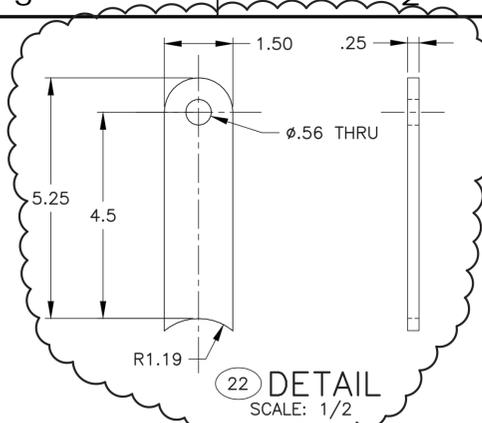


REVISIONS	
REV	DESCRIPTION
1	SEE DRF-344903
2	INCORP'D FDC-10452, 10457, 10515, 10530 AND 10551, SEE DRF-346066


QTY REQD	LEVEL	PART OR IDENTIFYING NO.	NOMENCLATURE OR DESCRIPTION	MATERIAL/SPECIFICATION OR VENDOR NAME	ITEM NO.
1	3	-22	LIFTING LUG	PLATE, 304 OR 340L SST ASTM A240	22
1	3	H90070-210	GRAYLOC HUB, BW,2 GR20, SCH 40 2.375 OD X 2.067 ID 304H SST	GRAYLOC PRODUCTS	21
1	3	US-2-8-85S	BELLOWS EXPANSION JOINT, 2" BW ENDS, 321 SST ASTM A240-T321	U. S. BELLOWS	20
1	3	007903252005	ROSEMONT CONNECTION HEAD	EMERSON	19
AR	3	77124	LOCTITE NICKEL ANTI-SEIZE THREAD LUBRICANT	LOCTITE	18
4	3		WASHER, FLAT, 5/8	TYPE 3, CIRCULAR ASTM F436	17
4	3		NUT, HEX, 5/8-11 UNC	GRADE 8 ASTM A194	16
4	3		BOLT, HEX HEAD 5/8-11 UNC X 2 1/2 LONG	GRADE 8B ASTM A193	15
1	3		LATROLET, 1", SOCKET WELD CLASS 3000, 2" PIPE RUN	304H ASTM A182	14
1	3	H-306901	DELTA HELICOFLEX SEAL W/LIMITER SEAL TYPE HN208A	TECHNETICS GRP	13
1	3		FLANGE, 1", 300LB RAISED FACE, SLIP-ON	304H, SST ASTM A182	12
AR	3		PIPE, 1", SCHED 40S, SEAMLESS	304H SST ASTM A312	11
AR	3		WELD FILLER METAL	ER 308H AWS A5.9	9
1	3	0183N21J2C30N110	TEMPERATURE SENSOR, 6" LEADS, SPRING LOADED, SINGLE ELEMENT, GROUNDED TYPE J, NIPPLE UNION, 3" EXTENSION, 11" INSERTION LENGTH	ROSEMONT	8
1	3		ELBOW, 2", 90°, SCHED 40 BUTT WELD, LONG RADIUS	304H SST ASTM A403	7
AR	3		PIPE, 2", SCHED 40, SEAMLESS	304H SST ASTM A312	6
AR	3		TUBE, 1/2" OD. X .065 WALL	316 OR 316L SST	5
1	3	0091A110F76T005P	THERMOWELL, 11" IMMERSION LENGTH, FLANGED CLASS 300 LBS, 0.5" LAGGING LENGTH	TYPE 316 SS, THERMOWELL ROSEMONT	4
1	3	SS-8-VCR-3	1/2" VCR SOCKET WELD GLAND TYPE 316 SST	SWAGELOK	3
1	3	SS-8-VCR-3	1/2" VCR FEMALE NUT TYPE 316 SST	SWAGELOK	2
					1
					0
-0	QUAL	PART OR IDENTIFYING NO.	NOMENCLATURE OR DESCRIPTION	MATERIAL/SPECIFICATION OR VENDOR NAME	ITEM NO.

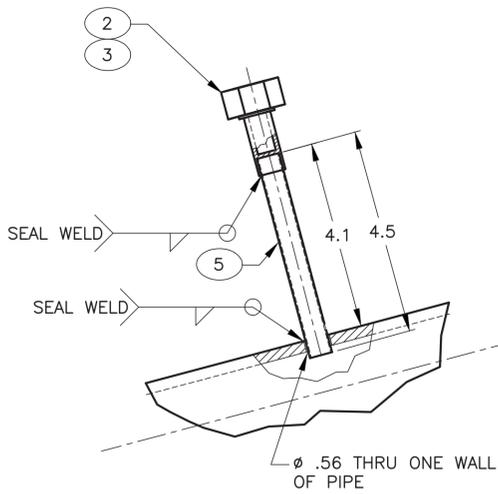

VIEW B
SCALE: 1/2

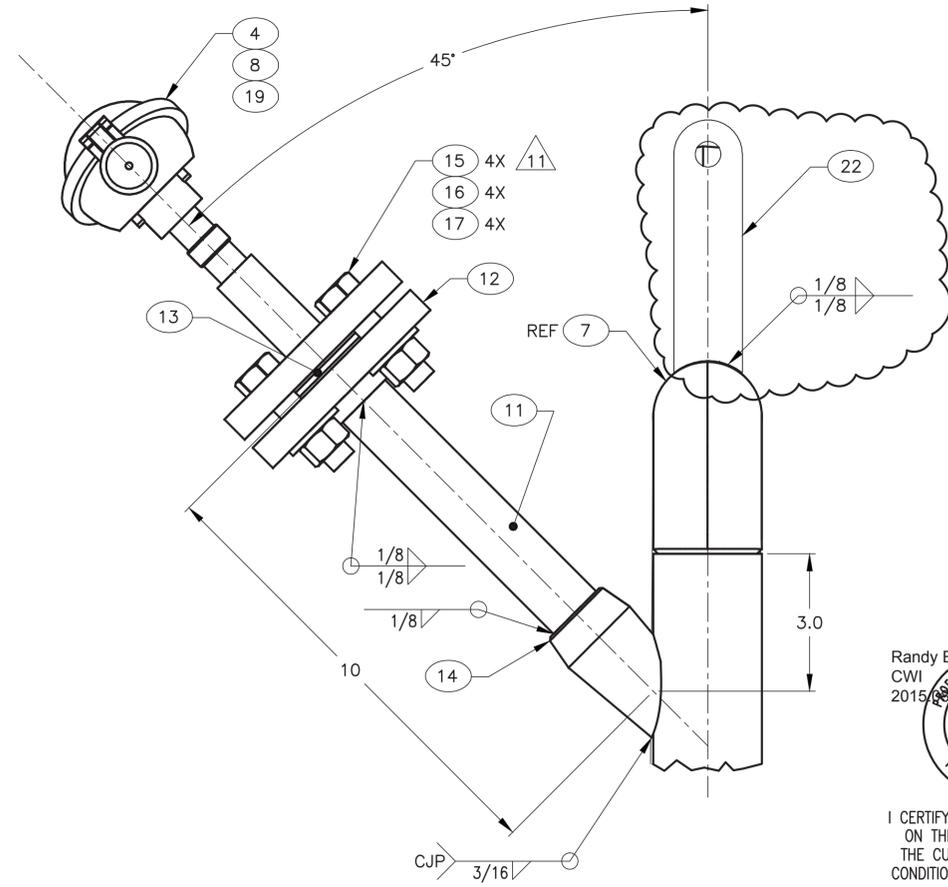

VIEW A-A
SCALE: 1/2

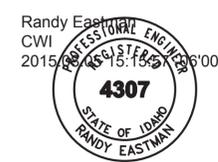

I CERTIFY THE CHANGES SHOWN ON THIS DRAWING REFLECT THE CURRENT CONSTRUCTED CONDITION AS OF 07/15/2015

INSPECTION REQUIREMENTS	571515
QC REQUIRED	
DASH NO.	NEXT ASSY
APPROVAL	

DATE	07/15/2015
TIME	15:15:00
PROJECT NUMBER	31720
DRF NUMBER	343941

DESIGNER	R. CAMPBELL
DRAFTER	A. KEY
TECHNICAL CHECK	T. BURNETT P.E.
ENG GROUP SUPERVISOR	R. EASTMAN, P.E.
DESIGN LEAD/AUTHORITY	D. MORGAN
DRAFTING CHECK/EFFECTIVE DATE	S. BERTHELSON


Idaho Cleanup Project CHEM-WG
 CPP-666
 RH-TRU DISTILLATION SYSTEM
 SPOOL PIECE 8
 DWG- 788579
 SHEET 1 OF 1

Date: 08/05/15 - 9:50 AM
 Layout Name: Layout1
 File: 788579-2.dwg
 Path: K:\RH-TRU Distillation\Drawings\DRF-346066

NOTES:

- 1. ARS-3 BOX CONSTRUCTION MATERIALS LEXAN MR10 OR GLASS, AND STAINLESS STEEL.
- 2. THE CONTAINMENT PAN IS PLUGGED WHEN THE ARS DRAIN BOTTLE IS NOT IN USE.
- 3. THE ARS DRAIN BOTTLE AND SECONDARY CONTAINMENT TRAY WILL BE INSTALLED FOR WASTE STREAMS HAVING CRITICALITY SAFETY CONTROLS.
- 4. DIMENSIONS OF THE ARS WILL BE DEPENDENT ON THE WASTE BEING TREATED. THE SECONDARY CONTAINMENT ASSOCIATED WITH THE TREATMENT BEING PERFORMED WILL MAINTAIN 100% OF THE WASTE GENERATED DURING TREATMENT.
- 5. WHEN THE DRAIN BOTTLE IS CONNECTED, THE TRAY THE BOTTLE SITS IN BECOMES THE SECONDARY CONTAINMENT SINCE THE ARS BOTTOM NO LONGER RETAIN ANY LIQUID. HOWEVER, WHEN THE DRAIN BOTTLE IS DISCONNECTED, THE DRAIN IS PLUGGED AND THE ARS BOTTOM PAN BECOMES THE SECONDARY CONTAINMENT.

REV	DESCRIPTION
1	REVISED TITLE BLOCK, ADDED INDEX CODE, AND ADDED DRAIN BOTTLE SEE DRF-347065
2	SEE DRF-351139
3	REMOVED WALL THICKNESS CALLOUT AND FIXED DRAFTING ERRORS SEE DRF-351354

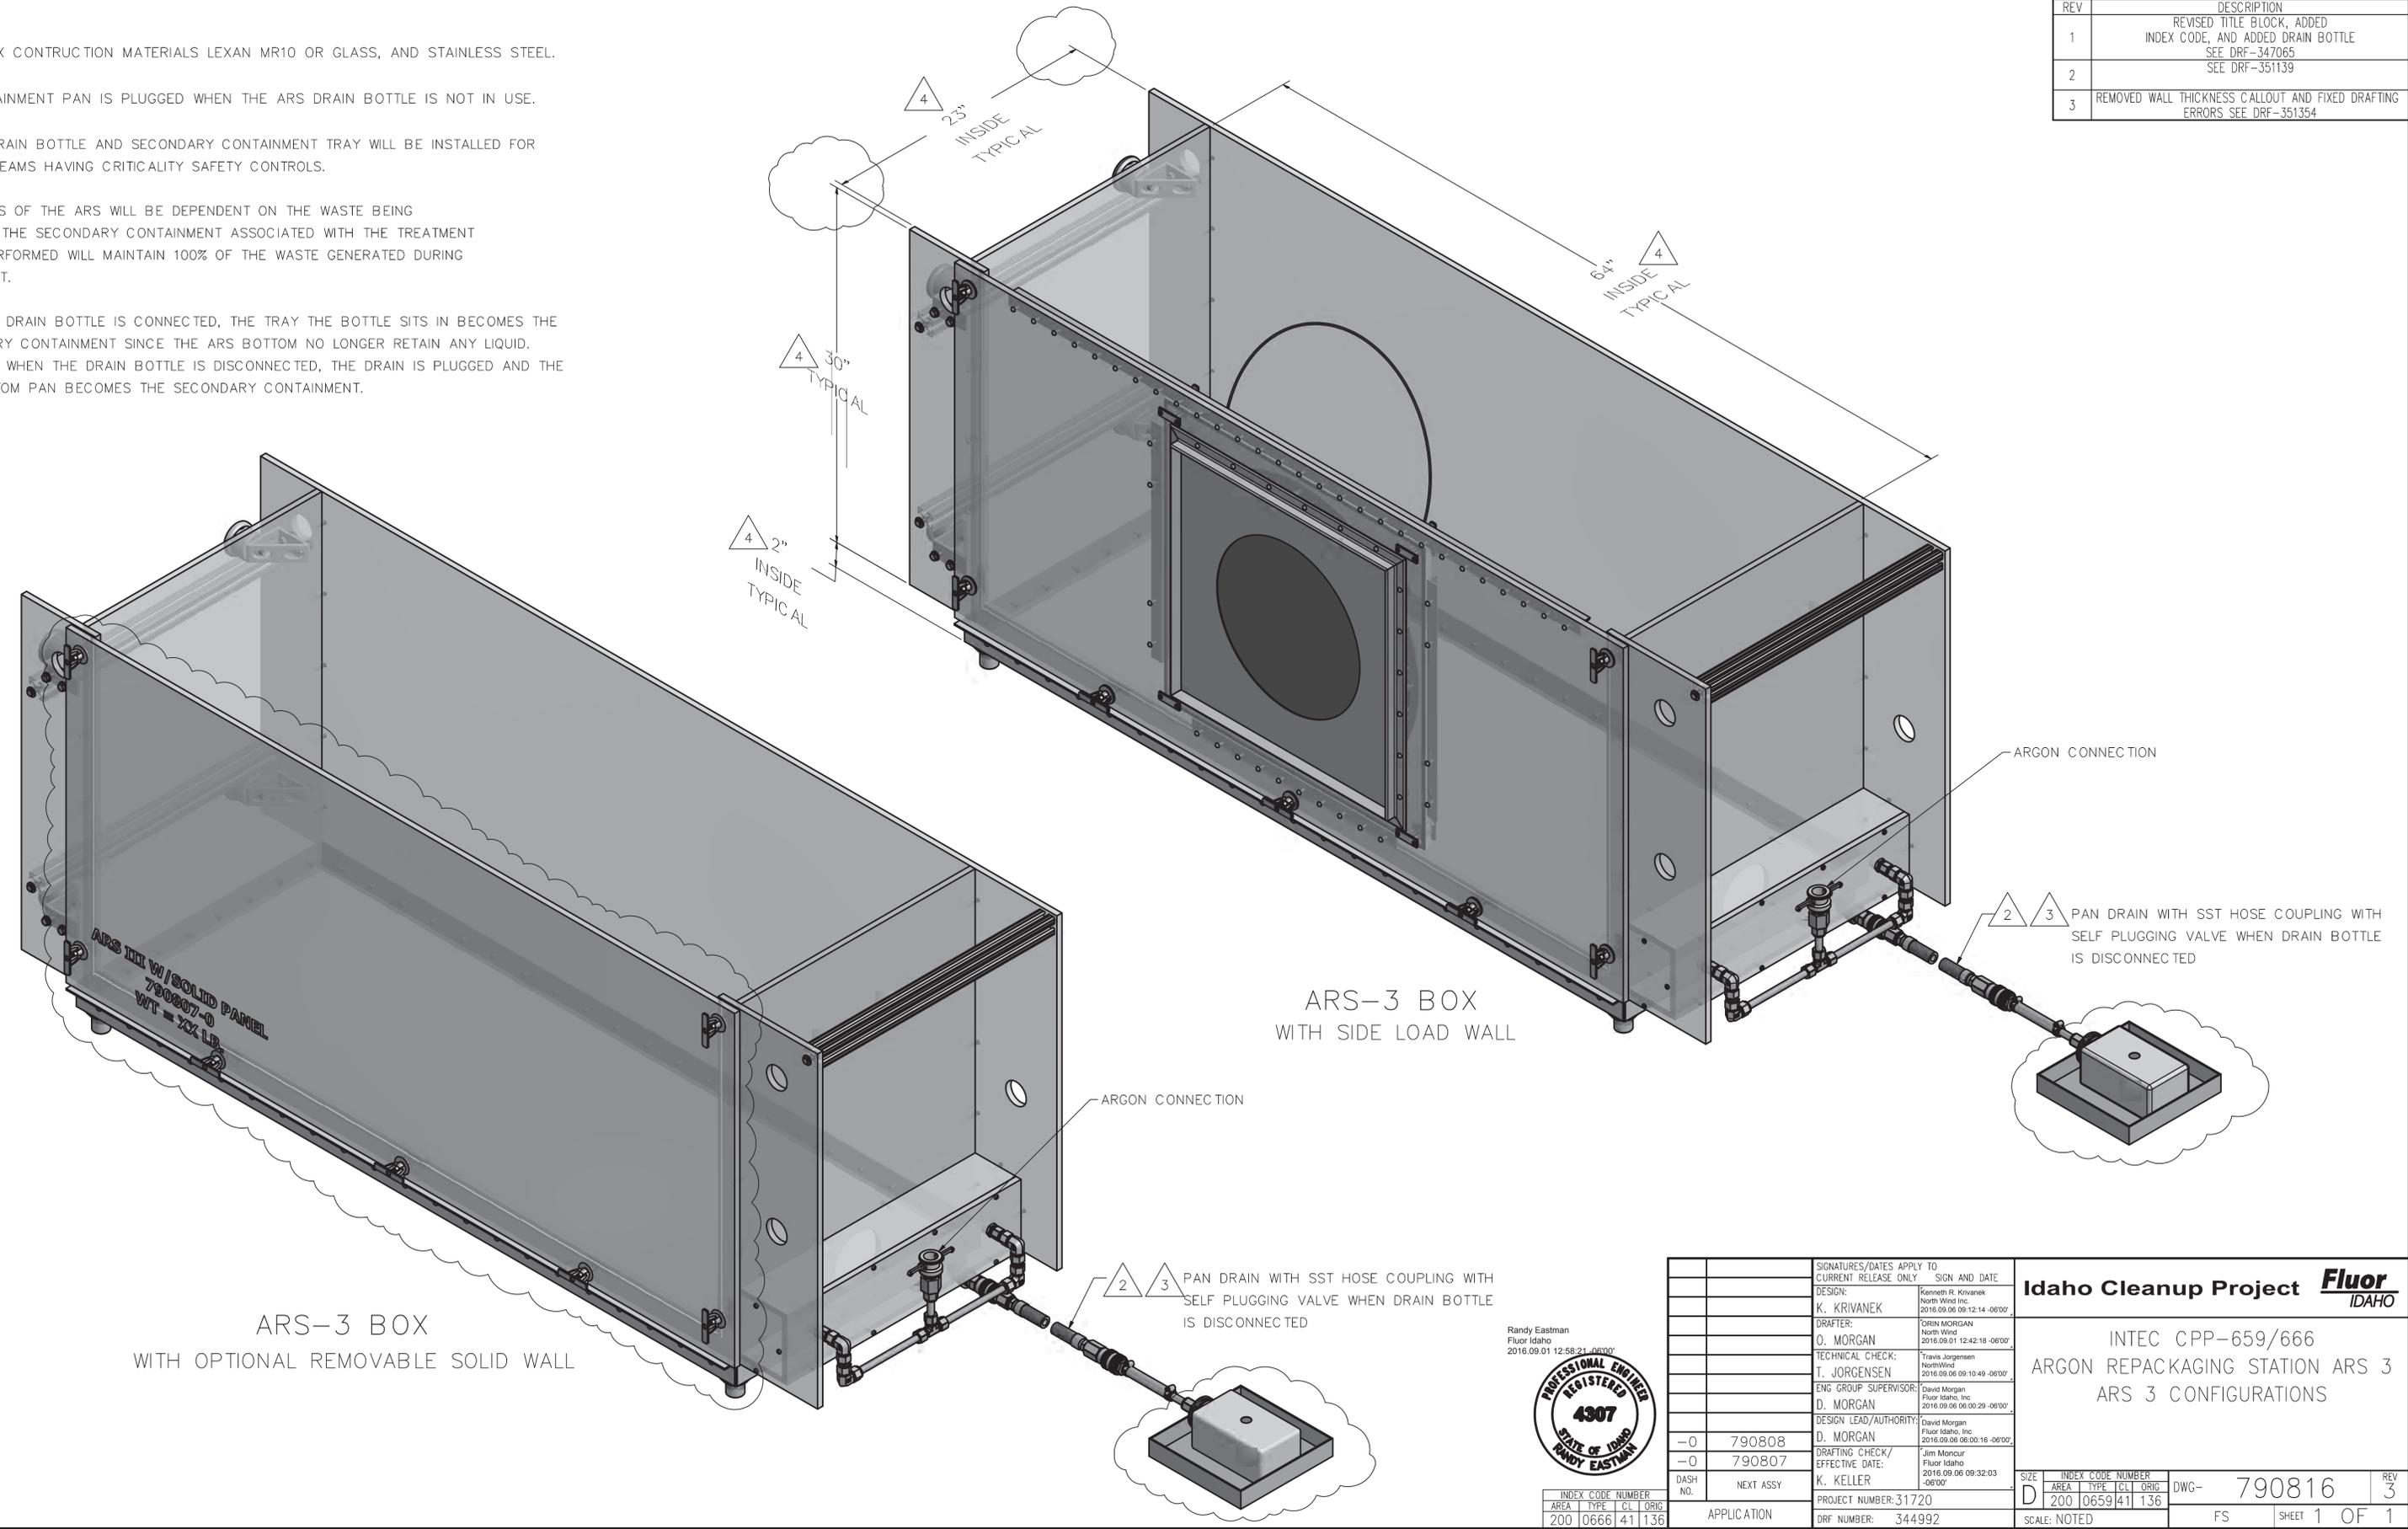

Layout Name: ID: penmmr
File: 790816.dwg
Path: \\VA-Yout\Designs\INTEC\Misc_Drafting\790816\790816.dwg



SIGNATURES/DATES APPLY TO CURRENT RELEASE ONLY		SIGN AND DATE
DESIGN:	K. KRIVANEK	Kenneth R. Krivanek North Wind Inc. 2016.09.08 09:12:14 -0600
DRAFTER:	O. MORGAN	Orin Morgan North Wind 2016.09.01 12:42:18 -0600
TECHNICAL CHECK:	T. JORGENSEN	Travis Jorgensen North Wind 2016.09.08 09:10:49 -0600
ENG GROUP SUPERVISOR:	D. MORGAN	David Morgan Fluor Idaho, Inc. 2016.09.06 06:00:29 -0600
DESIGN LEAD/AUTHORITY:	D. MORGAN	David Morgan Fluor Idaho, Inc. 2016.09.06 06:00:16 -0600
DRAFTING CHECK/EFFECTIVE DATE:	K. KELLER	Jim Monour Fluor Idaho 2016.09.06 09:32:03 -0600

Idaho Cleanup Project **Fluor IDAHO**


INTEC CPP-659/666
ARGON REPACKAGING STATION ARS 3
ARS 3 CONFIGURATIONS

INDEX CODE NUMBER	AREA	TYPE	CL	ORIG	DWG-	SCALE	NOTED	REV
200	0666	41	136		790816	FS		3

REVISIONS	
REV	DESCRIPTION
1	REVISED TITLE BLOCK AND ADDED INDEX CODE SEE DRF-347065
2	SEE DRF-351139

NOTES:

- 1. ARS BOX WALLS ARE CONSTRUCTED OF LEXAN MR10, OR GLASS, AND STAINLESS STEEL.
- 2. SPECIFIC DIMENSIONS OF THE ARS WILL BE DEPENDENT ON THE WASTE BEING TREATED. THE SECONDARY CONTAINMENT ASSOCIATED WITH THE TREATMENT BEING PERFORMED WILL MAINTAIN 100% OF THE WASTE GENERATED DURING TREATMENT.

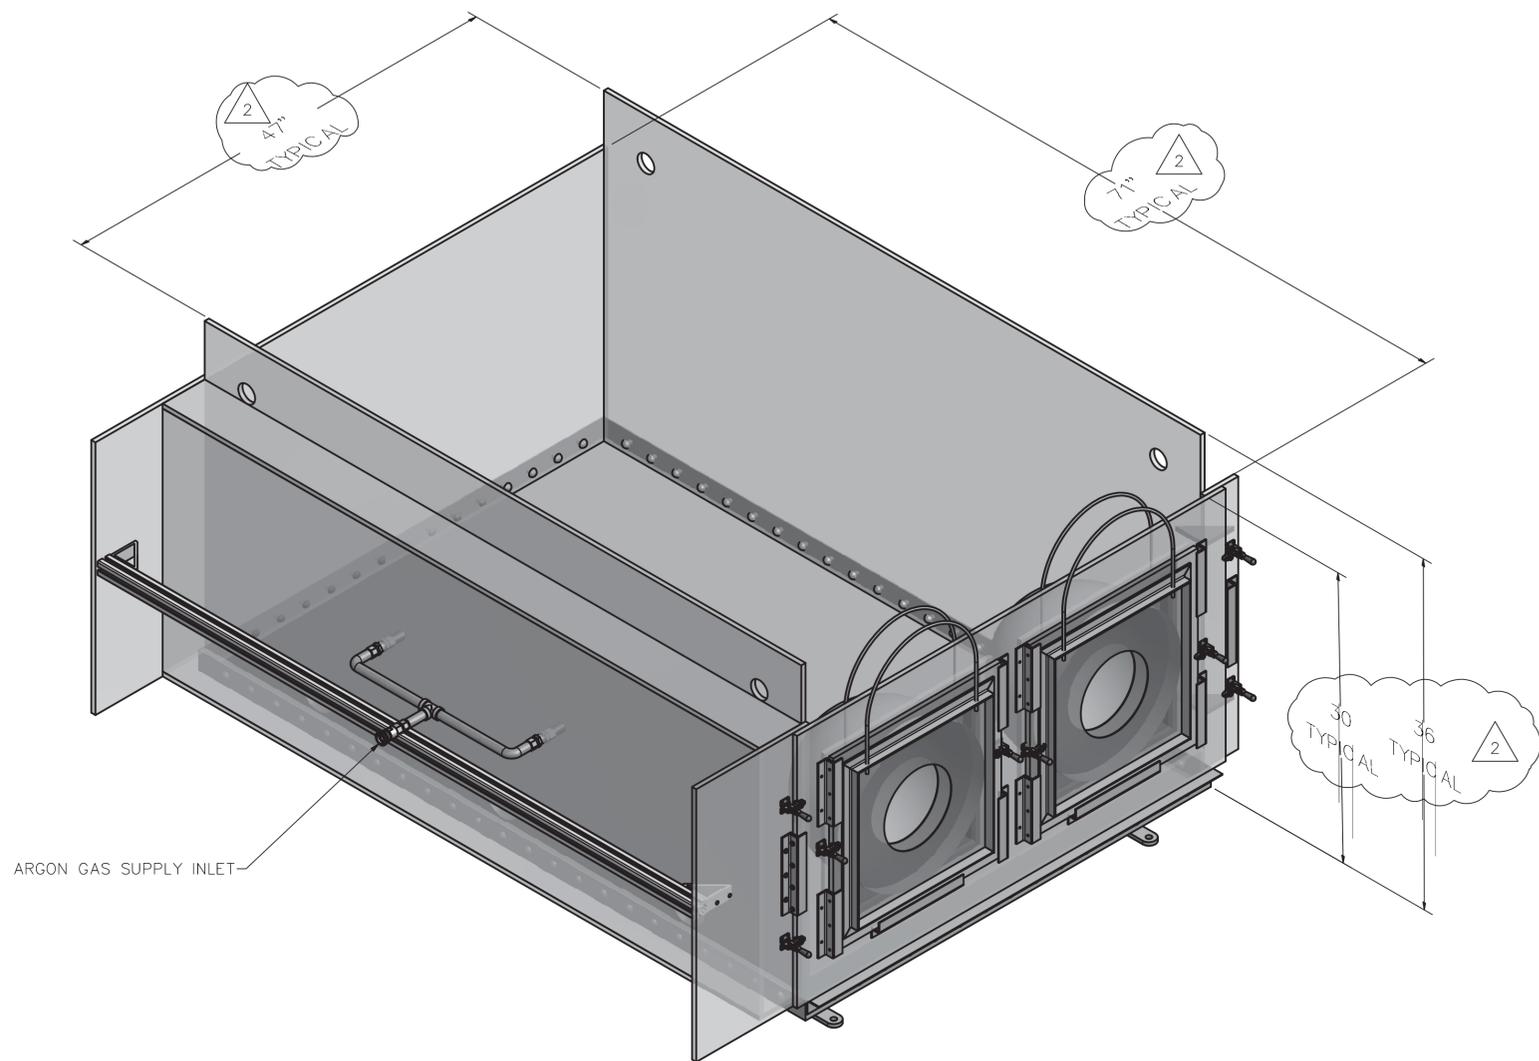

ARGON GAS SUPPLY INLET

3D VIEW
(SHOWN FOR CLARITY)
SCALE: NONE

Randy Eastman
Fluor Idaho
2016.08.31 13:04:07 -0600'



PAN	791843
-2	780900
-1	773983
DASH NO.	NEXT ASSY
APPLICATION	

DIMENSIONING AND SYMBOLS PER		SIGNATURES/DATES APPLY TO CURRENT RELEASE ONLY	
ASME Y14.5-2009 AND STD-11		DESIGN:	Kenneth R. Krivanek North Wind Inc. 2016.08.31 13:00:34 -0600'
UNLESS OTHERWISE SPECIFIED		DRAFTER:	Orin Morgan North Wind 2016.08.31 11:37:08 -0600'
SURFACE ROUGHNESS 125/		TECHNICAL CHECK:	Travis Jorgensen North Wind 2016.08.31 12:20:41 -0600'
DIMENSIONS AND TOLERANCES ARE IN INCHES		ENG GROUP SUPERVISOR:	David Morgan Fluor Idaho, Inc. 2016.08.31 13:09:32 -0600'
TOLERANCES	.X ± .1	DESIGN LEAD/AUTHORITY:	David Morgan Fluor Idaho, Inc. 2016.08.31 11:49:44 -0600'
DECIMALS	.XX ± .03	DRAFTING CHECK/EFFECTIVE DATE:	Shawn Berthelson Fluor Idaho 2016.08.31 13:13:03 -0600'
FRACTIONS	± 1/8	PROJECT NUMBER: 31720	
ANGULAR	± 2'	DRF NUMBER: 345285	
DO NOT SCALE DRAWING			


Idaho Cleanup Project		Fluor IDAHO	
INTEC CPP-659/666 ARGON REPACKAGING STATION 2.0 SHEQ-FC-920			
INDEX CODE NUMBER	AREA	TYPE	CL ORIG
200 0659 41 136	200	0666	41 136
DWG-	792396	REV	2
SCALE: NONE	FS	SHEET 1 OF 1	

Layout Name: ID: penimr
File: 792396.dwg
Path: \\VA-Vault\Designs\INTEC\Misc\Drafting\792396\792396.dwg


REV	DESCRIPTION

NOTES:


1. LARGE ARS BOX CONSTRUCTION MATERIALS LEXAN MR10 OR GLASS AND STAINLESS STEEL.
2. THE CONTAINMENT PAN IS PLUGGED WHEN THE ARS DRAIN BOTTLE IS NOT IN USE.
3. THE ARS DRAIN BOTTLE WILL BE INSTALLED FOR WASTE STREAMS HAVING CRITICALITY SAFETY CONTROLS.
4. DIMENSIONS OF THE ARS WILL BE DEPENDENT ON THE WASTE BEING TREATED, THE SECONDARY CONTAINMENT ASSOCIATED WITH THE TREATMENT BEING PERFORMED AND WILL MAINTAIN 100% OF THE WASTE GENERATED DURING TREATMENT.
5. WHEN THE DRAIN BOTTLE IS CONNECTED, THE TRAY THE BOTTLE SITS IN BECOMES THE SECONDARY CONTAINMENT SINCE THE ARS BOTTOM NO LONGER RETAIN ANY LIQUID. HOWEVER, WHEN THE DRAIN BOTTLE IS DISCONNECTED, THE DRAIN IS PLUGGED AND THE ARS BOTTOM PAN BECOMES THE SECONDARY CONTAINMENT.

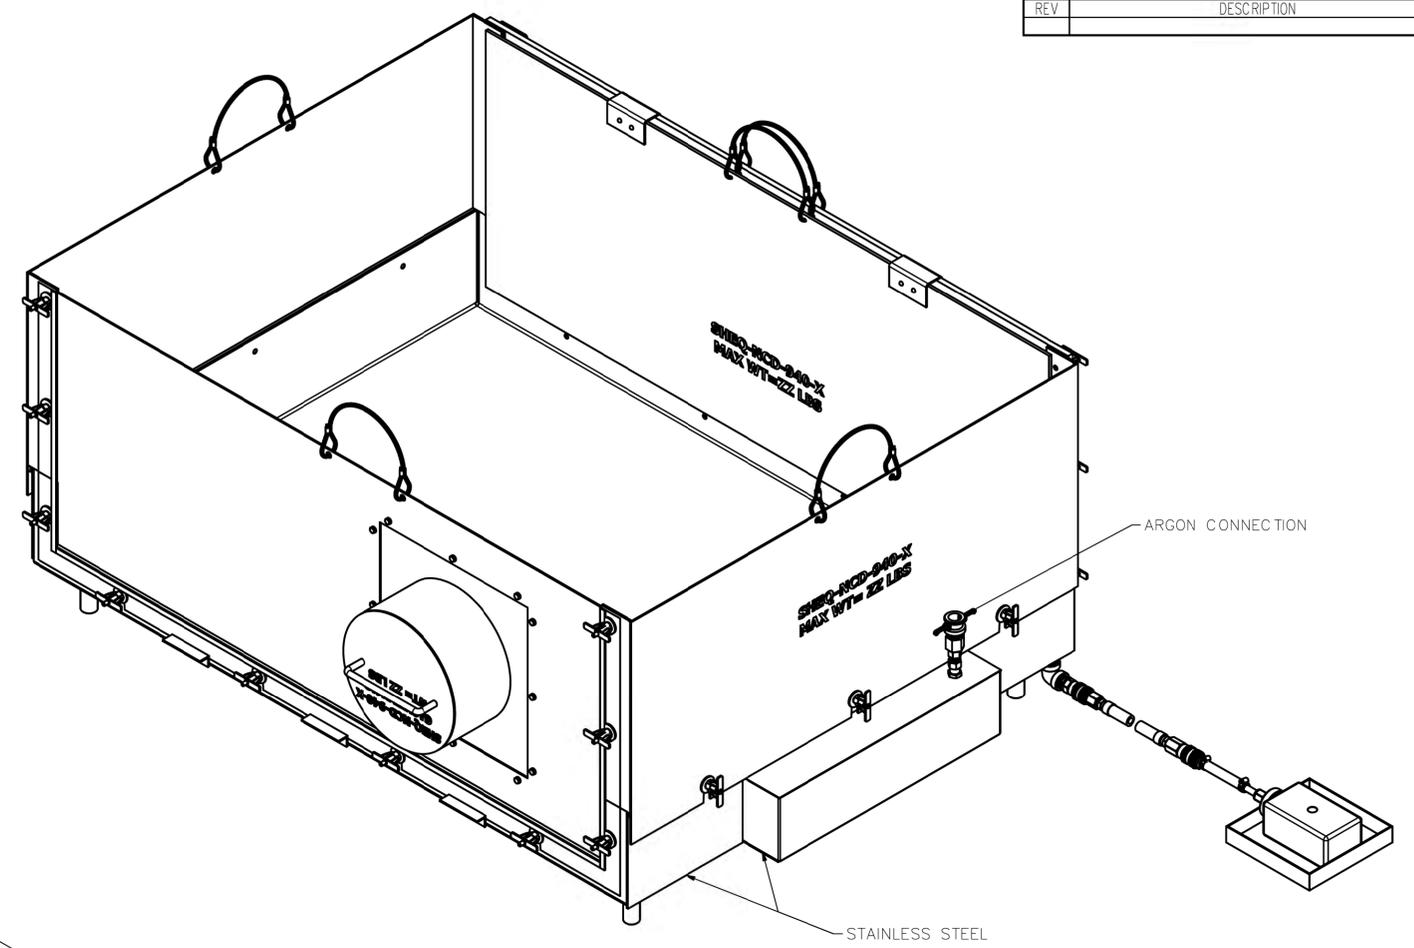

ASSEMBLY REAR VIEW
(SHOWN FOR CLARITY)
SCALE: NONE

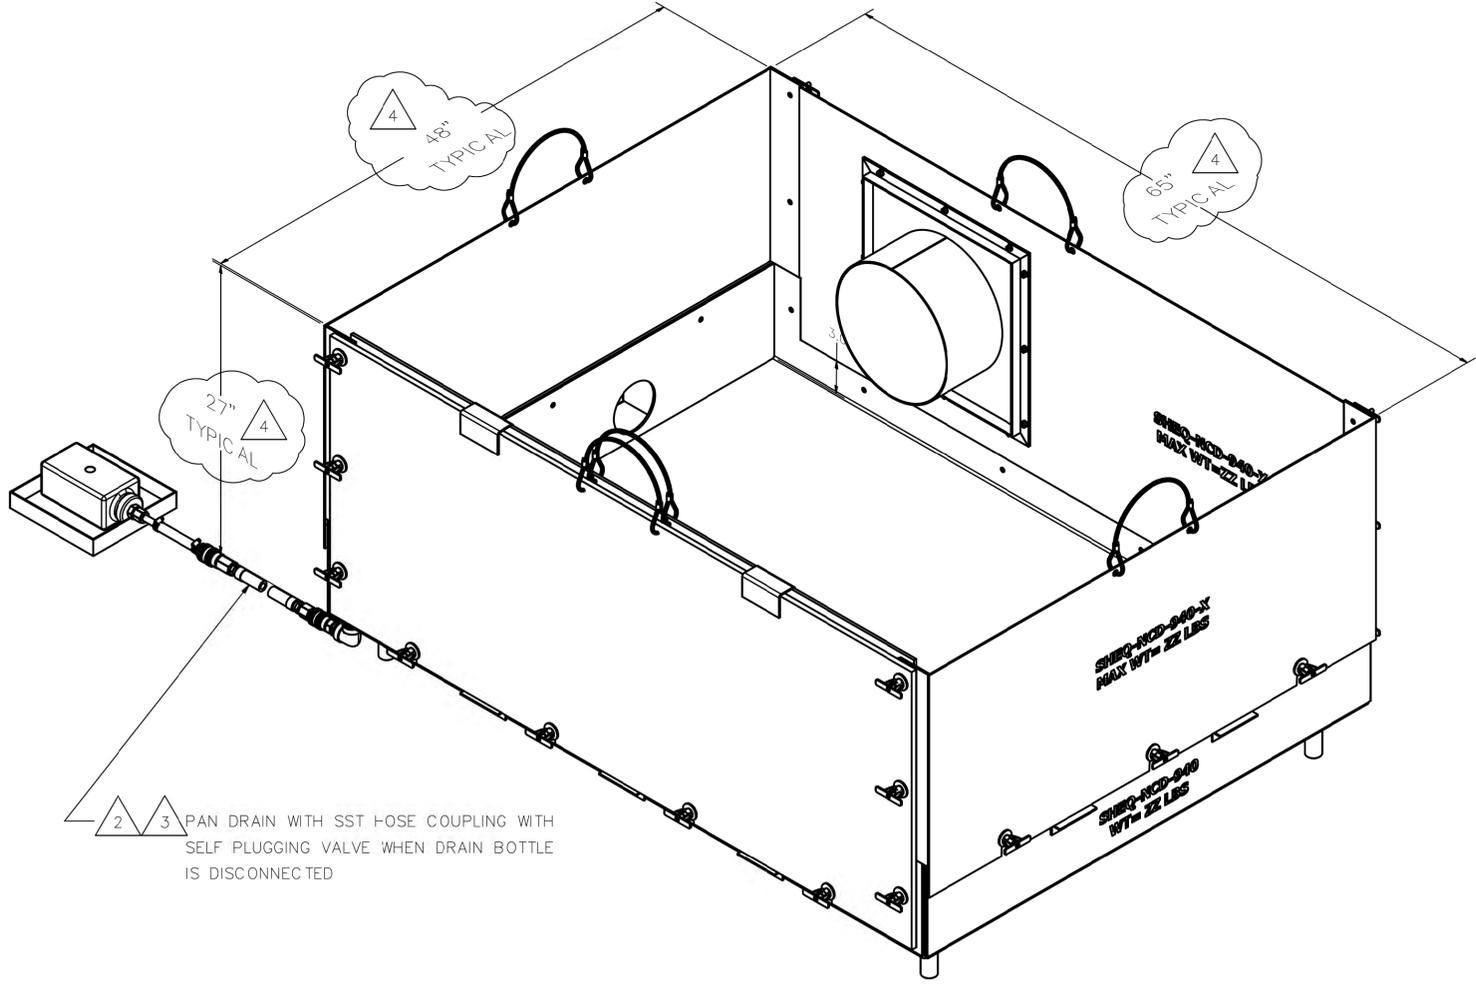

ASSEMBLY FRONT VIEW
(SHOWN FOR CLARITY)
SCALE: NONE

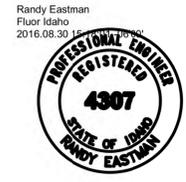

DIMENSIONING AND SYMBOLY PER		SIGNATURES/DATES APPLY TO CURRENT RELEASE ONLY	
DASH NO.	NEXT ASSY	DESIGN	SIGN AND DATE
		K. KRIVANEK	Kenneth R. Krivanek North Wind Inc. 2016.08.30 16:10:26 -0600
		T. ROMRIELL	ORIN MORGAN North Wind 2016.08.30 09:16:39 -0600
		J. ARVIZU	Jacob Arvizu Fluor Idaho, LLC 2016.08.31 12:01:47 -0600
		D. MORGAN	David Morgan Fluor Idaho, Inc 2016.09.01 05:57:05 -0600
		D. MORGAN	David Morgan Fluor Idaho, Inc 2016.09.01 05:57:15 -0600
		K. KELLER	Jim Moncur Fluor Idaho 2016.09.01 07:16:31 -0600
		PROJECT NUMBER:	32503
		DRF NUMBER:	350714

Idaho Cleanup Project **Fluor IDAHO**

INTEC CPP-659/666
ARGON REPACKAGING STATION
LARGE BOX ASSEMBLY
SHEQ-NCD-940

SIZE	INDEX CODE	NUMBER	DWG-	801880	REV
D	200	0659	41	286A	

SCALE: NOTED

FS SHEET 1 OF 1

File: 801880.dwg
 Path: \\VA-Vault\Designs\BHT\TR\1\Area_ABS_Box\801880.dwg
 Layout Name: ID: penmmr

HWMA/RCRA PART B PERMIT
FOR THE IDAHO NATIONAL LABORATORY

Volume 18 – Idaho Nuclear Technology and Engineering Center

APPENDIX 3

Debris Treatment Processes
Holdup and Collection Tanks
CPP-659/-1659 Storage
CPP-666 FDP Cell Container Storage and Slab Tank Storage
Other Miscellaneous Treatment Processes
RMWSF (CPP-1617) Container Storage Area

HIGH DENSITY CONCRETE
CONSTRUCTION SPECIFICATION

Effective Date: April 27, 2009

SPECIFICATION SP-453504- 10 - 2

HIGH DENSITY CONCRETE CONSTRUCTION

**APPROVED FOR
CONSTRUCTION**

REV.	DATE	DESCRIPTION	APPROVED BY	DATE
0	8/23/77	Approved For Construction	ORIG <u>M. Dorin / M. Dorin</u> FLUOR <u>James Johnson</u> FLUOR _____ FLUOR <u>Mike Weston</u> FLUOR <u>L. Stull</u> ACC <u>H. L. Johnson by dpm</u>	<u>8/23/77</u> <u>8/24/77</u> <u>8/25/77</u> <u>8/25/77</u> <u>8-31-77</u>
			ORIG _____ FLUOR _____ FLUOR _____ FLUOR _____ FLUOR _____ ACC _____	
			ORIG _____ FLUOR _____ FLUOR _____ FLUOR _____ FLUOR _____ ACC _____	
			ORIG _____ FLUOR _____ FLUOR _____ FLUOR _____ FLUOR _____ ACC _____	
			ORIG _____ FLUOR _____ FLUOR _____ FLUOR _____ FLUOR _____ ACC _____	

 **ALLIED CHEMICAL CORPORATION**
 IDAHO CHEMICAL PROGRAMS - OPERATIONS OFFICE
 IDAHO FALLS, IDAHO

THIS DOCUMENT IS RELEASED 8-31-77
 AND SUBSEQUENTLY CONTROLLED IN ACCORDANCE
 WITH ACC STANDARD PRACTICES.

SPECIFICATION SP-453504-10-2
HIGH DENSITY CONCRETE CONSTRUCTION

CONTENTS

<u>TITLE</u>	<u>PAGE</u>
SCOPE	1
REFERENCE SPECIFICATIONS, CODES AND STANDARDS	1
HIGH DENSITY CONCRETE MATERIALS	2
4.0 REINFORCEMENT	6
EMBEDDED ITEMS	6
PROPORTIONING	7
7.0 MIXING	8
8.0 PLACING HIGH DENSITY CONCRETE	8
9.0 FORMWORK	10
10.0 FINISHING	10
11.0 JOINTS	11
12.0 GROUT AND DRYPACKING	11
13.0 EPOXY GROUTING	11
COLD WEATHER CONCRETING	11
HOT WEATHER CONCRETING	11
INSPECTION AND TESTING	11
CURING AND PROTECTION	12
18.0 QUALITY CONTROL	12

SPECIFICATION SP-453504-10-2

HIGH DENSITY CONCRETE CONSTRUCTION

1.0 SCOPE

General

- 1.1.1 Except as otherwise noted herein, high density concrete shall meet all requirements of Specification SP-453504-10-1, Concrete Construction, pertaining to regular concrete. -
 - 1.1.2 High Density Concrete shall be placed only at the locations and to the extent shown or noted on the engineering drawings.
 - 1.1.3 The Contractor shall provide all labor, equipment, transportation, and materials required to perform all poured in-place high density concrete work for the New Waste Calcining Facility at the Idaho National Engineering Laboratory near Idaho Falls, Idaho.
- 1.2 The work shall include, but is not necessarily limited to, the following:
- (1) Placing of anchor bolts, support angles and other embedded items as shown on drawings.
 - (2) High density concrete grouting.

2.0 REFERENCE SPECIFICATIONS, CODES AND STANDARDS

The following publications of the issue shown form a part of this specification to the extent indicated by references thereto. Where no issue date is shown, the latest edition of the publication shall apply:

2.1 Fluor Engineers and Constructors, Inc., Specification

SP-453504-10-1 Concrete Construction

2.2 Codes and Standards

(1) American Concrete Institute (ACI)

ACI 211.1-74 Recommended practice for Selecting Proportions
for Normal and Heavyweight Concrete

ACI 309-72 Recommended Practice for Consolidation of
Concrete

2.2 (Continued)

(1) (Continued)

ACI 318-71 Building Code Requirements for Reinforced
Concrete

(2) American Society for Testing and Material (ASTM)

ASTM-C-127-73 Specific Gravity and Absorption of Coarse
Aggregate

ASTM-C-128-73 Specific Gravity and Absorption of Fine Aggregate

ASTM-C-150-76 Portland Cement

ASTM-C-494-71 Chemical Admixtures for Concrete

ASTM-C-637-73 Aggregate for Radiation - Shielding Concrete

2.3 In case of conflict, the following order of precedence shall apply:

(1) Drawings

(2) This Specification, SP-453504-10-2, High Density Concrete
Construction

Specification SP-453504-10-1, Concrete Construction

(4) Codes and Standards

2.4 Where reference is made, in the above reference specifications,
codes and standards, to "Building Official, Engineer or Responsible
Authority," these terms shall be considered as synonymous with the
ERDA Contracting Officer or his representative.

3.0 HIGH DENSITY CONCRETE MATERIALS

3.1 Cement

Cement shall be low alkali conforming to ASTM C-150, Type I-II. One
brand and type of cement shall be selected and used throughout the
NWCF project. All cement shall be a certified brand, and shall be
sampled, tested and approved by the Contracting Officer. Certified
mill test reports from the approved supplier may be accepted in lieu
of tests by the Contracting Officer at his option. Only tested and
approved cement shall be used.

3.2 Aggregate

- 3.2.1 The fine and coarse aggregate shall be crushed magnetite aggregates.
- 3.2.2 One source of aggregate shall be selected and used throughout the work, supported by test and investigation reports, and shall be approved by the Contracting Officer.
- 3.2.3 The bulk specific gravity of the aggregates shall be 4.5 minimum (saturated, surface dry). Specific gravities shall be determined as defined in ASTM designation C-127 for coarse aggregate and ASTM designation C-128 for fine aggregate. The specific gravity of any shipment shall not differ by more than 3 percent of the average bulk specific gravity of the aggregate supplied as samples and used for the concrete design mix.
- 3.2.4 Maximum absorption of the aggregate shall be 2 percent.
- 3.2.5 The aggregate shall conform to ASTM C-637, except for the following modifications:
- a. Paragraph 3.3 "Fixed Water Content of Hydrous Ores," not applicable.
 - b. Paragraph 5 and 6 test for "Deleterious Substances" and "Abrasion Resistance of Coarse Aggregate." These tests shall be performed only on the first aggregate test samples obtained for determining the aggregate suitability to be used for the high density concrete, see Paragraph 3.2.6 "Aggregate Certification" of this Specification. In successive samples and/or shipments of aggregates, the sample taken to the testing laboratory shall be inspected only to see if they comply with uniformity and quality, in respect to "Deleterious Substances" and "Abrasion Resistance," of the first aggregate test samples tested. In the event that it is apparent that there is no compliance, the shipment shall be tested as specified in Paragraphs 5 and 6 and/or rejected.
 - c. The aggregates shall be graded within the following limits:

3.2.5.1 Fine Aggregate

<u>Sieve Size</u>	<u>Percent Passing</u>
3/8 inch	100
No. 4	95 - 100
No. 8	70 - 100
No. 16	45 - 85
No. 30	25 - 60
No. 50	10 - 35
No. 100	2 - 20
No. 200	0 - 10

The fineness modulus shall not be less than 2.3 or more than 3.1. The grading of fine aggregate shall be controlled so that the fineness moduli of the test samples shall not vary more than 0.20 from the average fineness modulus of all samples previously taken. The fineness modulus shall be determined by dividing by 100 the sum of the cumulative percentages retained on sieves Numbers 4, 8, 16, 30, 50 and 100.

3.2.5.2 Coarse Aggregate shall be 3/4 inch maximum size.

<u>Sieve Size</u>	<u>Percent Passing</u>
1 inch	100
3/4 inch	90 - 100
1/2 inch	50 - 75
3/8 inch	20 - 55
No. 4	0 - 10

3.2.5.3 The above fine and coarse aggregate gradation represents the extreme limits which shall determine suitability of the aggregates to be used for the high density concrete. An acceptable degree of uniformity shall be maintenance of fineness modulus of successive samples and shipments with plus or minus 0.20 of the originally accepted sample.

3.2.6 Aggregates Certification

The Contractor shall obtain test samples of the fine and coarse aggregates for determining their suitability to be used for the high density concrete. The aggregates shall be tested in accordance with the requirements specified herein. The Contractor shall submit the test results to Contracting Officer and obtain his approval, in writing, prior to ordering

3.2.6 (Continued)

and shipment of the aggregate. All tests shall be conducted by the testing laboratory, approved by the Contracting Officer. The Contractor shall provide the tests in conformance with the Method of Sampling and Testing specified in and referred by ASTM C-637, except as otherwise provided within this specification.

3.2.7 Aggregates Testing

Any new shipment of samples or delivery of fine or coarse aggregates shall be retested in accordance with this specification for compliance with the requirements and uniformity of the shipments. Failure of the delivered aggregate to pass these tests or meet the requirements shall be a cause for rejection, unless suitable adjustments or recommendations are made in proportions of fine and coarse aggregate. These recommendations and adjustments shall be made by the testing laboratory and submitted in writing by the Contractor to the Contracting Officer for his approval.

Any new shipment of fine or coarse aggregate shall not be released for use, nor mixed with previous shipments until acceptable test results have been obtained.

3.2.8 Frequency of Aggregate Testing

- 3.2.8.1 A minimum of one set of tests for every new shipment of samples or delivery of aggregates.
- 3.2.8.2 A minimum of one set of tests for every 100 tons of fine or coarse aggregate delivered.
- 3.2.8.3 Additional tests may be required by the Contracting Officer or the testing laboratory, to insure aggregate shipment uniformity.
- 3.2.8.4 The Contractor shall inform the Contracting Officer, in writing, of any failure of the aggregate shipment, or fraction of a shipment, to meet the requirements of this specification. Any noncompliance with the requirements may be a cause for rejection of a specific shipment, unless the testing laboratory can recommend suitable adjustments in the design mix proportions, and those adjustments are approved in writing by the Contracting Officer.

3.2.9 Shipment and Storage of Aggregates

Aggregates should be shipped, handled, and stored in a manner which will assure little loss of fine aggregates, no contamination by foreign material, and no significant aggregate breakage or segregation.

Coarse and fine aggregate shall be shipped separately. Aggregates may be shipped in heavy wood boxes, watertight bags, steel containers, or in bulk by railroad cars or trucks. Storage should be as near the batch plant as possible. The size, coarse or fine, and weight of the aggregate in each container shall be plainly marked on the container.

Water

Mixing water shall be potable and free from injurious amounts of oils, acids, alkalis, salts, organic materials or other deleterious substances.

Admixtures

- 3.4.1 Water reducing admixtures shall conform to ASTM C-494, Type A or D.
- 3.4.2 Air-entraining admixture shall not be used in high density concrete without recommendation of the testing laboratory and written approval of the Contracting Officer. The use of air-entraining admixtures tends to decrease the density of the concrete.
- 3.4.3 Calcium chloride or admixtures containing chlorides shall not be used in concrete without approval of the Contracting Officer.

4.0 REINFORCEMENT

The Contractor shall conform to the requirements of Specification SP-453504-10-1, "Concrete Construction," Paragraph 4.0, "Reinforcement," except that in Subparagraph 4.4.2 the precast concrete blocks embedded in high density concrete shall be made of high density concrete. The bonding grout and patching mortar shall be made of magnetic aggregates, see Paragraph 10.0 of this specification.

5.0 EMBEDDED ITEMS

The Contractor shall conform to the requirements of Specification SP-453504-10-1, Paragraph 5.0, except that Subparagraph 5.3 shall be deleted.

6.0 PROPORTIONING

General

Concrete shall be proportioned as set forth in ACI-211.1 and shall meet the quality requirements as set forth in ACI 318, except as modified herein. The Contractor shall submit his concrete design mix for approval to the Contracting Officer prior to use.

Concrete Properties

- 6.2.1 The specified compressive strength of concrete, f'_c , shall be 4,000 psi based on 28-day tests.
- 6.2.2 The minimum unit weight of the high density concrete shall be 220.5 pounds per cubic foot.
- 6.2.3 Concrete with crushed magnetite aggregates, 3/4 inch maximum size, shall be used for all high density concrete work unless otherwise noted on the drawings or approved by the Contracting Officer. The concrete design mix shall contain the maximum quantity of coarse aggregate consistent with workability and method of placement.
- 6.2.4 High density concrete slump shall range within the following unit:

Reinforced slabs, precast hatch beams, columns and walls, 2 to 4 inches.

If concrete pumping is to be used, then slump may be increased up to 2 inches over the above limits, with specific prior approved by the Contracting Officer. The modified design mix for pumped concrete must be designed and tested by the testing laboratory and shall be approved by the Contracting Officer.

6.2.5 Concrete Air Content

Entrapped air shall be considered in the concrete mix; however, air-entraining admixture or air-entraining Portland cement shall not be used, see Paragraph 3.4.2.

- 6.2.6 The concrete mix shall contain a water-reducing admixture, added in the proportions recommended by the admixture manufacturer and the design mix testing laboratory, and as approved by the Contracting Officer.

6.3 Design Mix Based on Laboratory Trial Batches

- 6.3.1 The design mix shall be determined on the basis of testing laboratory trial batches test as outlined in Paragraph 4.2.3 of ACI 318 and ACI 211.1. The testing laboratory and the recommended design mix or mixes shall be approved in writing by the Contracting Officer.
- 6.3.2 The proposed design mix for placed concrete shall be noted, if it is suitable for pumping. If it is not suitable, then a modified special design mix for pumping shall be tested and approved by the Contracting Officer.

7.0 MIXING

General

The Contractor shall conform to the requirements of Specification SP-453504-10-1, Paragraph 7.0, except for the following additional considerations and requirements.

Concrete Mixing Equipment

Standard mixing equipment may be used to mix the high density concrete. Special care shall be taken not to overload the equipment. In general, the allowable volume of high density concrete mixed shall be equivalent to the mix weight of normal density concrete rather than the volume capacity of the mixing equipment. Transporting high density concrete without agitation tends to cause excessive consolidation or packing, and therefore shall be avoided.

8.0 PLACING HIGH DENSITY CONCRETE

General

Placement of the mixed high density concrete shall be subjected to the same considerations of quality control as for normal density concrete. The Contractor shall conform to the applicable requirements of Specification SP-453504-10-1, Concrete Construction, Paragraph 8.0, except for the following additional considerations and requirements.

The mixed high density concrete is far more susceptible to variations in quality due to improper handling. It is particularly subject to segregation during placement. Segregation of high density concrete results not only in variation of strength, but also in variations in density, as lighter materials such as cement, water, and air will displace heavier high density aggregates. This adversely affects shielding properties.

- 8.3 The placement of high density concrete is frequently required in areas which are congested with reinforcing steel, penetrations, and blockout.

Placement conditions dictate the strictest observance of good placement practice. Because of the complexity of forms and embedments, it is usually necessary to avoid pump or "drop-pipe" placement techniques in areas which are inaccessible to direct observation by workmen at all times. However, in other accessible areas, if the mixes are proportioned properly, they are pumpable and will pump better at a lower slump than normal weight concrete.

Placing the high density concrete by pumping is not recommended because of the tendency of the aggregates to segregate. However, if the Contractor chose to use pumping for specific areas, he should use only the mix design that was approved for pumping, see Subparagraphs 6.2.4 and 6.3.2. The pumping operation shall be done only by experienced workmen. The flow of the concrete shall be observed at all times to notice and immediately correct any tendency of the aggregate to segregate.

Use of long, rigid chutes or drop pipes shall be avoided. Where concrete must be placed in narrow forms or through restricted areas, a short flexible type drop chute which tends to collapse and restrain the fall of high density concrete should be employed.

- 8.6 The entire Subparagraph 8.5 of Specification SP-453504-10-1 shall be substituted by the following requirements:

In placing the high density concrete the height of the force-fall drop of the concrete shall be no more than 4 feet, as measured from the end of the chute, trunk, bucket, etc., to the top surface of the existing or previously poured concrete. This can be accomplished by the use of pour holes in the forms, chutes, buckets, trunks, or any other acceptable method. The stream of concrete should not separate by permitting it to fall freely over rods, spacers, reinforcement, or other embedded material.

- 8.7 High density concrete usually will not "flow" in a form and must be placed in each discrete area and compacted in place with a minimum of vibration. Under no circumstances should an attempt be made to move high density concrete with vibration equipment.

Layers of placed high density concrete shall be limited to a maximum 12 inches.

High-Density Concrete Consolidation

- 8.9.1 Consolidation shall conform to ACI 309, "Recommended Practice for Consolidation of Concrete," Chapter 14.

SP-453504-10-2
Rev. 0 8-23-77

- 8.9.2 Internal vibrators shall be used to achieve uniform and optimum density. Vibrator frequencies used for normal concrete are usually satisfactory for heavy concrete. However, somewhat higher frequencies, about 11,000 vibrations per minute (180 Hz), together with shorter vibration periods have sometimes been found to reduce the tendency for segregation. Over vibration shall be avoided, since this causes settlement of the heavy particles.
- 8.9.3 In high density concrete, vibrators have a smaller effective area, or radius of action than in normal concrete; therefore, greater care must be exercised to insure that the concrete is properly consolidated. Vibrators shall be inserted at closer spaced intervals than for normal concrete and only to a depth sufficient to cause complete intermixing of adjacent layers.
- 8.9.4 Vibration and revibration to remove entrapped air and to establish aggregate-to-aggregate contact may cause an excess amount of grout to collect on the top of the placed lift surfaces. If this occurs, the lower density grout should be removed from the upper surface at the completion of each placement while the concrete is still in a plastic state.

9.0 FORMWORK

9.1 General

The Contractor shall conform to the requirements of Specification SP-453504-10-1, Paragraph 9.0, except for the following additional considerations and requirements.

The form designer shall be aware that formwork for conventionally placed high density concrete must necessarily be stronger than comparable formwork for ordinary concrete simply by reason of increased concrete density.

- 9.3 The form designer shall also be aware that all sleeves, penetrations and blockouts and their related strutting and bracing systems must be carefully designed for the increased concrete density, to insure their integrity and alignment.

10.0 FINISHING

The Contractor shall conform to the requirements of Specification SP-453504-10-1 "Concrete Construction," Paragraph 10.0 "Finishing," except that in Subparagraph 10.1.2, the fine sand for the bonding grout and the fine aggregate for the patching mortar shall be magnetite aggregate.

11.0 JOINTS

The Contractor shall conform to the requirements of Specification SP-453504-10-1 "Concrete Construction," Paragraph 11.0 "Joints."

12.0 GROUT AND DRYPACKING

12.1 General

The Contractor shall conform to the requirements of Specification SP-453504-10-1, Paragraph 12.0, except for the following additional considerations and requirements.

12.2 Normal Weight Nonshrink Grout

The nonshrink grout as specified in Specification SP-453504-10-1, Subparagraph 12.1, may be used for bedplates, equipment bases and similar uses where this grout is not an integrated part of the thickness required for shielding, or in no way will effect shielding properties requirements.

12.3 Normal Weight-Drypacking

Drypacking as specified in Specification SP-453504-10-1, Subparagraph 12.2, with normal weight sand shall be used only where called for on the drawings. This grout may be used only where it is not an integrated part of the thickness required for shielding, or in no way will affect the shielding properties requirement.

EPOXY GROUTING

The Contractor shall conform to the same requirements as specified in Specification SP-453504-10-1, Paragraph 13.0.

COLD WEATHER CONCRETING

The Contractor shall conform to the requirements as specified in Specification SP-453504-10-1, Paragraph 14.0.

HOT WEATHER CONCRETING

The Contractor shall conform to the requirements as specified in Specification SP-453504-10-1, Paragraph 15.0

INSPECTION AND TESTING

The Contractor shall conform to the requirements as specified in Specification SP-453504-10-1, Paragraph 16.0.

17.0 CURING AND PROTECTION

The Contractor shall conform to the same requirements as specified in Specification SP-453504-10-1, Paragraph 17.0.

18.0 QUALITY CONTROL

General

The Contractor and the Contracting Officer shall be aware of the utmost importance that a thorough quality control program shall be maintained prior to the start of construction and throughout the duration of construction. This specification shall be strictly enforced and any deviation or noncompliance shall be immediately reported in writing to the Contracting Officer.

18.2 A sensitive balance exists between the three major requirements:

- a. Specified strength of the concrete.
- b. Specified high unit weight of the concrete for shielding.
- c. A limit on excessive unit weight of the concrete because of the weight limitation for lifting the hatches.

Any noncompliance with any item of this specification or any unauthorized "field adjustment" in the design mix, placement, etc., may result in disturbing this balance.

Any attempt to increase strength by adding cement, will displace the heavier aggregate, and adversely affect shielding properties.

18.4 Any attempt to increase the unit weight of the concrete by increasing the percent of heavy magnetite aggregate in the mix and decreasing the lighter materials such as water, cement and entrapped air, may result in reduced strength and cause the hatches to become overweight for lifting.

Any noncompliance with the mixing and/or placing requirement may result in reduction of the concrete strength and may create areas of defective shielding properties.

HWMA/RCRA PART B PERMIT
FOR THE IDAHO NATIONAL LABORATORY

Volume 18 – Idaho Nuclear Technology and Engineering Center

APPENDIX 4

Debris Treatment Processes
Holdup and Collection Tanks
CPP-659/-1659 Storage
CPP-666 FDP Cell Container Storage and Slab Tank Storage
Other Miscellaneous Treatment Processes
RMWSF (CPP-1617) Container Storage Area

STRUCTURAL STEEL SPECIFICATION

Effective Date: April 27, 2009

SPECIFICATION SP-453504-20 - 1

STRUCTURAL STEEL

REVISED
APPROVED FOR
CONSTRUCTION
FLUOR ENGINEERS AND CONSTRUCTORS INC.

REV.	DATE	DESCRIPTION	APPROVED BY	DATE
0	11-24-76	Issued "Approved for Construction"	ORIG _____ FLUOR See attached FLUOR Rev. 0 coversheet FLUOR _____ FLUOR _____ ACC _____	
1	3-25-77	Revised and reissued "Approved for Construction" per DCN No. 58-1	ORIG <i>M. Dorrin</i> FLUOR <i>T. Anderson</i> FLUOR _____ FLUOR <i>C. K. ...</i> FLUOR <i>...</i> ACC <i>A. U. Johnson by GPM</i>	<i>3/25/77</i> <i>3/25/77</i> <i>3-30-77</i> <i>3-30-77</i> <i>3-30-77</i>
2	6-16-77	Revised and reissued "Approved for Construction" per DCN No. 100-1	ORIG <i>John G. Shipp</i> FLUOR <i>T. Anderson</i> FLUOR _____ FLUOR <i>M. J. ...</i> FLUOR <i>R. ...</i> ACC <i>A. U. Johnson by GPM</i>	<i>6-20-77</i> <i>6-20-77</i> <i>6-20-77</i> <i>6-20-77</i> <i>6-24-77</i>
3	10-20-77	Revised and reissued "Approved for Construction" per DCN No. 190-1	ORIG <i>J. H. ...</i> FLUOR <i>John G. Shipp</i> FLUOR _____ FLUOR <i>M. J. ...</i> FLUOR <i>R. ...</i> ACC <i>A. U. Johnson by GPM</i>	<i>10/21/77</i> <i>10/21/77</i> <i>10/21/77</i> <i>10/24/77</i> <i>10-25-77</i>
			ORIG _____ FLUOR _____ FLUOR _____ FLUOR _____ FLUOR _____ ACC _____	

 **ALLIED CHEMICAL CORPORATION**
IDAHO CHEMICAL PROGRAMS - OPERATIONS OFFICE
IDAHO FALLS, IDAHO

THIS DOCUMENT IS RELEASED 12-1-76
AND SUBSEQUENTLY CONTROLLED IN ACCORDANCE
WITH ACC STANDARD PRACTICES.

38181

SPECIFICATION SP-453504-20-1

STRUCTURAL STEEL

**APPROVED FOR
CONSTRUCTION**

The attached specification, revised as indicated below
is issued herewith. If this is a later revision than
now in your possession, please destroy previous issue.

Revision No.	<u>0</u>	Date	<u>11-24-76</u>	Pages	<u>All</u>
Revision No.		Date		Pages	
Revision No.		Date		Pages	
Revision No.		Date		Pages	
Revision No.		Date		Pages	

NOTE: New Issue _____
Revised sheets only attached _____
Entire specification reissued X

Originated	<u>Ramzi G. Saaty</u>	Date	<u>11-24-76</u>
Approved by	<u>[Signature]</u>	Date	<u>11-24-76</u>
Approved by	<u>[Signature]</u>	Date	<u>11-24-76</u>
Approved by	<u>[Signature]</u>	Date	<u>11-24-76</u>
ACC Approved by	<u>H. E. Johnson</u>	Date	<u>12-1-76</u>

 **ALLIED CHEMICAL CORPORATION**
IDAHO CHEMICAL PROGRAMS - OPERATIONS OFFICE
IDAHO FALLS, IDAHO

THIS DOCUMENT IS RELEASED 12-1-76
AND SUBSEQUENTLY CONTROLLED IN ACCORDANCE
WITH ACC STANDARD PRACTICES.

Rev. 3 10/20/77

SPECIFICATION SP-453504-20-1

STRUCTURAL STEEL

CONTENTS

<u>TITLE</u>	<u>PAGE</u>
1.0 SCOPE	1
2.0 REFERENCE SPECIFICATIONS, CODES AND STANDARDS	2
3.0 MATERIALS	3
DETAILS AND FABRICATION	4
INSTALLATION OF HIGH STRENGTH BOLTS	6
STEEL DECKING	8
7.0 METAL GRATING AND TREADS	9
8.0 MISCELLANEOUS METAL	10
STAINLESS STEEL	11
DISSIMILAR MATERIALS	11
11.0 PREFORMED METAL SIDING	12
12.0 SUBSTITUTIONS	12
13.0 INSPECTION	12

SPECIFICATION SP-453504-20-1

STRUCTURAL STEEL

1.0

General

The Contractor shall provide all labor and material to fabricate and erect structural steel in accordance with design drawings and this specification for the proposed New Waste Calcining Facility at the Idaho National Engineering Laboratory near Idaho Falls, Idaho.

The work shall also include, but not be limited to, the following:

- (1) Structural steel.
- (2) Steel decking.
- (3) Bridge crane steel supports, rails and stops.
- (4) Ladders, handrails and guardrails.
- (5) All metal grating and treads, including banding and fasteners.
- (6) Embedded steel ladder rungs.
- (7) Complete shop detail drawings with bills of material.
- (8) Erection drawings with field welds indicated.
- (9) Structural steel surface cleaning and priming.
- (10) Common and high-strength bolts.
- (11) Welded stud bolts.
- (12) Grout plates, slide plates, anchor bolts and other items to be embedded in concrete.
- (13) Miscellaneous metal
- (14) Stainless steel.
- (15) Stairs

2.0 REFERENCE SPECIFICATIONS, CODES AND STANDARDS

The following publications of the issue shown form a part of this specification to the extent indicated by the reference thereto. Where no issue date is shown, the latest edition of the publication in effect on the Purchase Order shall apply:

2.1 Fluor Engineers and Constructors Specifications

SP-453504-20-2	Stainless Steel
SP-453504-30-1	Painting and Protective Coating
SP-453504-90-13	Structural Welding Shop and/or Field

2.2 Codes and Standards

(1) American Institute of Steel Construction (AISC)

AISC Specification for the Design, Fabrication and Erection of Structural Steel for Buildings, dated February, 1969, including Supplement No. 3, dated June, 1974.

AISC Code of Standard Practice for Steel Buildings and Bridges, dated October, 1972.

(2) American Society for Testing and Materials (ASTM)

ASTM-A36	Standard Specification for Structural Steel, dated 1975.
ASTM-A53	Welded and Seamless Steel Pipe, dated 1972.
ASTM-A307	Carbon Steel Externally and Internally Threaded Standard Fasteners, dated 1974.
ASTM-A325	Specification for Structural Steel Joints Using ASTM-A325 Bolts, dated May, 1974.
ASTM-A501	Hot-Formed Welded and Seamless Carbon Structural Steel Tubing, dated 1974.
ASTM-A446	Steel Sheet, Zinc-Coated by Hot-Dip Process, Physical Quality, dated 1972
ASTM-A525-73	Standard Specification for Steel Sheet, Zinc-Coated (Galvanized) by the Hot-Dip Process, General Requirement, dated 1973

38181

(Continued)

(3) Steel Structures Painting Council (SSPC)

SSPC-SP-3 Power Tool Cleaning

(4) Federal Specification

TT-P-636d Primer Coating, Alkyd, Wood and Ferrous
Metal.

TT-V-51e Varnish, Asphalt.

TT-P-645 Primer, Paint Zinc Chromite, Alkyd Type

(5) Military Specification

MIL-C-18480A Coating Compound, Bituminous Solvent,
Coal Tar Base.

(6) American Welding Society (AWS)

A5.1 Specification for Mild Steel Covered Arc-
Welding Electrodes, dated 1969.

Whenever a difference exists between the design drawings and this specification, the drawing shall govern.

3.0 MATERIALS

Structural Steel, Structural Tubing, and Steel Pipe

3.1.1 Structural steel, structural tubing, and steel pipe shall conform to the following ASTM Specifications:

(1) Structural Steel: ASTM A36

(2) Structural Tubing: ASTM A501

(3) Steel Pipe: ASTM A53, Type E or S, Grade B

3.1.2 Welding electrodes with a minimum tensile strength of 70 ksi shall be used. Electrodes shall be compatible with welding process selected, conforming to Fluor Specification SP-453504-90-13.

3.2 Bolts

- 3.2.1 Common (machine) bolts shall be 5/8 inch diameter and shall conform to ASTM A307 specifications. Nuts shall be American National Standard, hexagonal heavy.
- 3.2.2 High-strength bolts shall be 3/4 inch diameter unless otherwise noted, and shall conform to ASTM Specification A325. One high-strength bolt assembly shall consist of a heavy semifinished hex head structural bolt and a heavy semifinished hex nut.
- 3.2.3 All bolts required for erection shall be included with the first shipment of fabricated steel for each unit or structure in clearly marked containers.
- 3.2.4 Quantities of both common and high-strength bolts shall include 5 percent extra per size and length, to cover requirements for fit-up and erection.
- 3.2.5 Nelson welded threaded stud bolts shall be of size as noted on the drawings.
- 3.2.6 Nelson welded studs are an acceptable substitute for the welded mild steel concrete anchors indicated on the drawings.
- 3.2.7 All bolt threads shall extend a minimum of three (3) thread lengths beyond the outer nut surface after bolts have been tightened.

4.0 DETAILS AND FABRICATION

- 4.1 Contractor shall conform to the following shop detailing and fabricating requirements unless shown otherwise on the design drawings.
 - 4.1.1 Connections which are not detailed or otherwise noted on the design drawings shall be shop-welded and field-bolted according to the AISC Manual of Steel Construction, Framed Beam Connections, Tables III and I. Use the maximum number of rows of field bolts shown in Table I for each beam depth. Use a 1/4 inch shop weld "A" shown in Table III for the required number of field bolts. Shop connections having unprimed contact surfaces shall be seal welded to prevent corrosion except when physically impossible.
 - 4.1.2 Field connections shall be made using high strength bolts in bearing connections unless noted otherwise on the design

4.1.2 (Continued)

drawings. Do not omit paint or galvanizing from the contact surfaces within the joints. Bolt threads need not be excluded from the shear planes.

4.1.3 End distances shall conform to AISC, "Structural Steel for Buildings", Section 1.16.6, without reduction for low stress unless noted on the design drawings. When more than two fasteners are provided in the line of stress, the provisions of Section 1.16.5 of AISC, "Structural Steel for Buildings", shall govern.

4.1.4 The Fabricating Contractor shall furnish and install erection clips for fit-up of welded connections.

Clearance shall be provided for field erection in accordance with AISC Manual of Steel Construction, Part 4, pages 114 and 115.

Gusset plates shall be 5/16 inch thick minimum

4.1.7 Columns shall have full bearing at splices and at end plates.

4.1.8 Sharp corners and burrs shall be removed before shop priming.

4.1.9 Structural steel welding shall be in accordance with requirements outlined in Fluor Specification SP-453504-90-13.

4.1.10 Double angle members when used, shall have welded fillers spaced in accordance with Section 1.18.2.4 of the AISC, "Structural Steel for Buildings."

4.1.11 Shop Painting

4.1.11.1 Steel items shown on the drawings and/or specified herein this division of the specification (except stainless steel items and steel decking) shall be given a shop coat of Alkyd Zinc Chromate Primer, conforming with Federal Specification TT-P-645.

4.1.11.2 Cleaning and shop priming shall be in accordance with Section 1.24 entitled "Shop Painting" of A.I.S.C. Specification for the Design, Fabrication and Erection of Structural Steel for Building, and in accordance with the Steel Structures Painting Council (SSPC) Specification SSPC-SP-3 Power Tool Cleaning.

- 4.1.11.3 Steel work specified to have no shop painting shall be cleaned of loose mill scale or rust by wire brushing or other methods elected by the fabricator.
- 4.1.11.4 Faulty applied primer shall be removed and re-primed after proper surface preparation.
- 4.1.11.5 After erection, structural steel field connections and abraded surfaces shall be touched up with the same paint used for shop painting. See Architectural Specification SP-453504-30-1 entitled "Painting and Protective Coating."
- 4.1.11.6 Steel embedded in concrete or masonry shall not be painted but shall be clean and free of rust, oil, and dirt.

4.1.12 Finish Painting

For finish painting see Architectural Specification SP-453504-30-1 entitled "Painting and Protective Coating."

4.2 Shop Drawings

- 4.2.1 The Fabricating Contractor shall submit a transparency of shop drawings, bills of material, including field bolt lists, and erection drawings to the Contracting Officer for approval before starting fabrication. Only checked drawings will be accepted for approval. Approval of shop drawings by the Contracting Officer shall be interpreted as approval of general methods and arrangements only, and shall not constitute verification of dimensions or quantities. The Fabricating Contractor shall be responsible for the accuracy of fabrication and erection fit-up.
- 4.2.2 Shop drawings shall include all structural steel, steel decking, grating and all miscellaneous metal covered by this specification.

5.0 INSTALLATION OF HIGH STRENGTH BOLTS

- 5.1 High Strength bolts shall be tightened by the turn-of-nut method.

Tightening may also be accomplished by turning the bolt head while holding the nut if required by clearances.

38181

Washers are not required, except for tapered washers used to bolt to the flanges of American Standard I beams or channels.

Prior to tightening any bolts, there shall first be enough bolts brought to a snug-tight condition to insure that the joint surfaces are in good contact. Snug-tight is defined as the tightness attained by a few impacts of an impact wrench or the full effort of a man using an ordinary spud wrench.

Following this initial operation, bolts shall be placed in any remaining holes in the connection and brought to snug-tightness.

- 5.6 Bolts shall then be tensioned by the applicable amount of nut rotation given in the table below. The tensioning shall progress systematically from the most rigid part of the joint to its free edges. During this operation there shall be no rotation of the part not turned by the wrench.

NUT ROTATION FROM SNUG-TIGHT CONDITION

Disposition of Outer Faces of Bolted Parts		
Both faces normal to bolt axis, or one face normal to axis and other face sloped not more than 1:20 (bevel washers not used)	Both faces sloped not more than 1:20 from normal to bolt axis (bevel washers not used)	
Bolt length not exceeding 8 diameters or 8 inches	Bolt length exceeding 8 diameters or 8 inches	For all length of bolts
1/2 turn	2/3 turn	3/4 turn

Nut rotation is rotation relative to bolt regardless of the element (nut or bolt) being turned.

Tolerance on rotation: 30 degrees over or under. For course thread heavy hex structural bolts of all sizes and length and heavy hex semifinished nuts.

Bolt length is measured from underside of head to extreme end of point.

The sides of either bolt heads or nuts tightened with an impact wrench will appear slightly peened, and thus indicate that the wrench has been applied to the fastener. It will not be necessary to use other means to assure satisfactory installation.

6.0 STEEL DECKING

General

- 6.1.1 Physical properties of the steel decking (gage, moment of inertia and section modulus) shall not be less than that specified on the drawings. The depth of steel decking shall be as indicated on the drawings. End and side closures and other required accessories shall be provided.
- 6.1.2 Deck material and design shall conform to the "Basic Design Specification" as adopted by Steel Deck Institute.
- 6.1.3 See the drawings for the type of deck to be used, and welding instructions.
- 6.1.4 Where the steel decking is used as bonded unit with concrete floor, deformations shall be provided in all vertical webs of the steel decking to structurally bond the overlying structural concrete fill.
- 6.1.5 The following items shall be included but not limited to same: Provide ridge and valley plates, welding, and other required fasteners and accessories. Where so indicated on the drawing, provide galvanized sheet metal closures at the top of the metal stud partitions and the underside of the steel decking.

Materials

- 6.2.1 The steel floor units and all flashings shall be formed from steel sheets conforming to ASTM-A446-72 with a minimum yield strength of 33,000 psi. The steel shall have a metal protective coating of zinc, conforming to ASTM-A525-73 with minimum weight of coating designation G60 light commercial.

Installation

- 6.3.1 Installation shall be in strict accordance with the engineering drawings and the manufacturer's erection drawings.

- 6.3.2 Verify alignment and level of structural steel work, and advise the Contracting Officer of inaccuracies or improper conditions so corrections can be made before decking work has commenced.
- 6.3.3 Six-inch and smaller openings, measured at right angles to the deck span, shall be cut in the field.
- 6.3.4 Openings over six inches and up to 30 inches in width shall be cut in the field and reinforced as shown on the drawings.
- 6.3.5 Openings larger than 30 inches in width shall be supported on structural steel, with deck openings cut in the shop.
- 6.3.6 Installation and welding of side and end closures shall be in accordance with the manufacturer's recommendations.
- 6.3.7 Where the steel decking is used as bonded unit with concrete floor, the finished deck shall be so constructed and erected as to prevent the flow of concret through the joints.
- 6.3.8 After erection, galvanized surface damaged with scratches, welds, cuts or threads, shall be touched-up with cold galvanizing coating. Surfaces shall be cleaned of grease, oil or paint. Weld scale or rust shall be cleaned by wire brushing, or sandblasted. Surface preparation and application shall be in accordance with the recommendations of the compound manufacturer.
- 6.3.9 Decking shall be fastened to the supporting steel framework as indicated on the drawings. E60 electrodes shall be used on metal decking. E60 electrodes shall conform to American Welding Society (AWS) A5.1 specification for Mild Steel Covered Arc-Welding Electrodes.

7.0 METAL GRATING AND TREADS

7.1 Grating Type

Grating shall be serrated welded with 1-1/4" X 3/16" bearing bars at 1-3/16 inch centers and crossbars at 4 inch centers unless called otherwise on the drawings. Grating shall be shop coated and painted in accordance with Section 4.1.11.

7.2 Stair Treads

Stair treads shall be metal grating with perforated or checker plate standard nosings. The treads shall be fabricated from serrated welded grating having 1" x 1/8" bearing bars at 1-3/16 inch centers.

A standard nosing shall be provided on the grating at the head of stairs.

Banding

Banding bars shall be of the same thickness as the bearing bars to which they are welded. The following locations shall be trim banded, except 7.3.4 which shall be load-carrying banded.

7.3.1 Open ends of grating at head of ladder approach to platform.

7.3.2 Dimensioned openings in grating.

7.3.3 Grating panels with four (4) or less crossbars

7.3.4 Cutouts having unsupported bearing bars.

7.4 Openings

Openings dimensioned on the design drawings shall be provided by the Fabricating Contractor. Undimensioned openings shall be cut in the field.

Fasteners

7.5.1 Grating shall be removable unless otherwise specified on the drawings.

7.5.2 Grating fasteners shall be saddle clip anchors secured to the supporting steel by gun-welded studs. Two fasteners per panel shall be used at each support with a minimum of four per panel.

8.0 MISCELLANEOUS METAL

Ferrous and nonferrous metal items, shapes and work not specified in other divisions, include, but are not limited to, the following:

8.1.1 Miscellaneous angles, brackets, bracing, bolts, fastenings, and expansion anchor bolts and grouted plates.

38181

- 8.1.2 Embedded: Anchor bolts for equipment and machinery, sleeves and other embedded items.
- 8.1.3 Supports and backing plates (fastened to metal studs, steel framing, etc.) for: toilet compartment partitions (channel supports), urinal screens, plumbing fixtures, toilet room accessories, mirrors, wall hooks, cabinets, clocks, alarms, fire extinguishers, bulletin boards, equipment and other wall mounted items.

Miscellaneous steel items (except galvanized items) shall be given a shop coat primer complying with Section 4.1.11, unless otherwise noted on drawings.

After erection damaged galvanized surface from scratches, welds, cuts or threads, shall be touched up with cold galvanizing coating. Surfaces shall be cleaned of grease, oil or paint. Weld scale (Slag) or rust shall be cleaned by wire brushing. Surface preparation and application shall be in accordance with the recommendations of the compound manufacturer.

9.0 STAINLESS STEEL

For stainless steel requirements see Specification SP-453504-20-2, "Stainless Steel."

10.0 DISSIMILAR MATERIALS

- 10.1 Where dissimilar metal surfaces come in contact with metals other than stainless steel, or zinc, isolate the contact surfaces from direct contact with each other to prevent electrolytic corrosive action. One of the following methods shall be used for isolation:
 - 10.1.1 Dissimilar metals at contact surfaces shall be painted with prime coat of zinc-chromate primer, and two coats of protective coating paint (other than paint with lead pigment) which conforms to Federal Specification TT-V-51e (Varnish, Asphalt) or Military Specification MIL-C-18480A (Coating Compound, Bituminous Solvent, Coal Tar Base).
 - 10.1.2 Dissimilar metals shall be painted with heavy coat alkali-resistant bituminous paint in concealed areas.
 - 10.1.3 Dissimilar metals surfaces shall be separated by nonabsorptive tape or gasket.

Fasteners between dissimilar metals shall be hot dipped galvanized, zinc plated, or stainless steel.

11.0 PREFORMED METAL SIDING

For preformed metal siding see Architectural Specification SP-453504-30-7 entitled "Preformed Metal Siding."

12.0 SUBSTITUTIONS

Proposals, in writing, for substitution of steel members in place of those specified, may be submitted for consideration only in the event specified members are not available. No substitutions of member sizes or changes in details or dimensions shall be permitted without the written approval of the Contracting Officer.

The Contracting Officer reserves the right to reject any unsatisfactory materials and misfit members resulting from errors in shop detailing or fabrication, or to make corrections on the job.

13.0 INSPECTION

13.1 The inspectors representing the Contracting Officer shall have access entry at all times to the fabricator's plants for shop inspection and to the construction site where work is being performed.

All welding inspection and examination shall be in accordance with Fluor Specification SP-453504-90-13.



13.3 Twenty percent radiographic examination is required for the full penetration welds in maintenance area superstructure and Decon Area superstructure as shown on the design drawings. The location of such examination will be determined by the contracting officer's inspectors. Ultrasonic examination can be used as a substitution for the radiographic examination.

HWMA/RCRA PART B PERMIT
FOR THE IDAHO NATIONAL LABORATORY

Volume 18 – Idaho Nuclear Technology and Engineering Center

APPENDIX 5

Debris Treatment Processes
Holdup and Collection Tanks
CPP-659/-1659 Storage
CPP-666 FDP Cell Container Storage and Slab Tank Storage
Other Miscellaneous Treatment Processes
RMWSF (CPP-1617) Container Storage Area

PHYSICAL PROPERTIES AND CHEMICAL RESISTANCE
FOR SERIES 300 STAINLESS STEEL

Effective Date: April 27, 2009

TABLE 23-3 General Corrosion Properties of Some Metals and Alloys* (Continued)

Rating:

0: Unavailable. Not available in form required or not suitable for fabrication requirements or not suitable for corrosion conditions.

1: Poor to fair.

2: Fair. For mild conditions or when periodic replacement is possible. Restricted use.

3: Fair to good.

4: Good. Suitable when superior alternatives are uneconomic.

5: Good to excellent.

6: Normally excellent.

Small variations in service conditions may appreciably affect corrosion resistance. Choice of materials is therefore guided wherever possible by a combination of experience and laboratory and site tests.

Material	Nonoxidizing or reducing media				Liquids								Gases			
	Acid solutions, including hydrochloric, e.g., phosphoric, sulfuric, most conditions, many organic	Neutral solutions, e.g., many nonoxidizing salt solutions, chlorides, sulfates	Alkaline solutions, e.g.		Oxidizing media			Natural waters				Common industrial media				
			Caustic and mild alkalies, excluding ammonium hydroxide	Ammonium hydroxide and amines	Acid solutions, e.g., nitric	Neutral or alkaline solutions, e.g., persulfates, chromates	Fitting media, i.e., acid ferric chloride solutions	Fresh-water supplies		Sea-water		Steam		Furnace gases with incidental sulfur content		Ambient air, city or industrial
								Static or slow-moving	Turbulent	Static or slow-moving	Turbulent	Wet, recondensate	Dry at high temperatures, promoting slight chlorination	Reducing, e.g., heat-treatment furnace gases	Oxidizing, e.g., flue gases	
Cast iron, lake graphite, plain or low-alloy	1	3	4	3	0	4	0	4	3	4	2	4	4	1	1	3
Ductile iron (higher strength and hardness may be attained by composition and heat treatment or both)	1	3	4	3	0	4	0	4	4	4	3	4	4	1	1	3
Ni-Resist corrosion-resistant cast iron	4	3	3	3	0	3	0	3	3	3	3	3	3	3	2	4
14% nickel iron	6	6	2	3	6	6	3	3	3	3	3	6	4	4	3	6
Mild steel, also low-alloy steels and alloys	1	3	4	3	0	4	0	4	3	4	2	4	4	1	1	3
Stainless steel, ferritic 17% Cr type	2	4	4	6	5	6	0	4	6	1	4	5	6	3	2	4
Stainless steel, austenitic 18 Cr, 8 Ni type	3	4	5	6	6	6	0	6	6	2	5	6	6	2	3	5
Stainless steel, austenitic 18 Cr, 12 Ni, 2.5 Mo type	4	5	5	6	5	6	1	6	6	3	5	6	6	2	4	6
Stainless steel, austenitic 20 Cr, 20 Ni, 2.5 Mo, 3.5 Cu type	5	6	5	6	5	6	2	6	6	4	5	6	6	2	4	6
Inconel 625 nickel-niobium alloy (60 Ni, 21 Cr, 3 Mo, 1.5 Cu, balance Fe)	6	6	3	4	5	6	2	6	6	4	6	6	6	2	5	6
Hastelloy alloy C-276 (53 Ni, 17 Mo, 16 Cr, 6 Fe, 4 W)	5	6	3	6	4	6	3	6	6	6	6	6	6	3	4	6
Hastelloy alloy B-2 (61 Ni, 28 Mo, 6 Fe)	6	3	4	4	0	3	0	6	6	4	4	6	5	3	2	3
Inconel 600 (78 Ni, 15 Cr, 7 Fe)	3	4	6	6	3	6	1	6	6	4	6	6	6	2	4	6

Material	Gases (continued)				Available forms	Cold formability in wrought and clad form	Weldability	Maximum strength assumed (million X 1000 lb/in ²)	Coefficient of thermal expansion, millionths per °F, TD-212 °F	Remarks
	Halogens and derivatives									
	Halogens		Halide acids, aq., e.g., hydrochloric acid and products of organic halides	Hydrogen halides, dry, e.g., dry hydrogen chloride, °F						
	Absent, e.g., chlorine below dew point	Present, e.g., fluorine above dew point								
Cast iron, B&G graphite, plain or low alloy	0	1	0	5 < 400 1 < 750	Cast	No	Fair	45	6.7	
Ductile iron (higher strength and hardness may be obtained by composition and heat treatment as both)	0	1	0	2 < 400 1 < 750	Cast	No	Good	67	7.5	
Ni-Resist corrosion-resistant cast iron	0	1	3	3 < 400 2 < 750	Cast	No	Good	22-31	10.3	
Duriron—14% silicon low	0	0	4	1 < 400	Cast	No	No	—	7.4	Very little susceptible to cracking by mechanical and thermal shock
Mild steel, also low-alloy low and steel	0	1	0	1 < 400 1 < 750	Wrought, cast	Good	Good	67	6.7	High strength obtainable by alloying, also improved atmospheric corrosion resistance. See ASTM specifications for particular grade
Stainless steel, ferritic 17% Cr type	0	1	0	1 < 400	Wrought, cast, clad	Good	Good	78	6.0	ASTM corrosion- and heat-resisting steel
Stainless steel, austenitic 18 Cr; 8 Ni type	0	1	0	3 < 400	Wrought, cast, clad	Good	Good	90	9.6	ASTM corrosion- and heat-resisting steel stabilized or LC types used for welding
Stainless steel, austenitic 18 Cr; 12 Ni 2.5 Mo type	0	1	1	4 < 400 3 < 750	Wrought, cast, clad	Good	Good	90	8.9	ASTM corrosion- and heat-resisting steel LC type used for welding
Stainless steel, austenitic 20 Cr; 28 Ni 2.5 Mo; 2.5 Cu type	1	1	1	4 < 400 3 < 750	Wrought, cast	Good	Good	90	8.4	ACI CH-7M; good resistance to sulfuric, phosphoric, and fatty acids at elevated temperatures
Inconel 625 nickel-iron-chromium alloy (40 Ni; 21 Cr; 3 Mo; 1.5 Cu, bal. Fe)	1	1	1	4 < 400 3 < 750	Wrought, cast, clad	Good	Good	100	7.3	Special alloy with good resistance to sulfuric, phosphoric, and fatty acids; resistant to chlorides in some environments
Hastelloy alloy C-276 (53 Ni; 17 Mo; 18 Cr; 6 Fe; 4 W)	1	1	1	4 < 750 3 < 900	Wrought, cast, clad	Fair	Good	145	6.3	Excellent resistance to wet chlorine gas and sodium hypochlorite solutions
Hastelloy alloy B-2 (61 Ni; 23 Mo; 6 Fe)	1	1	1	4 < 750 3 < 900	Wrought, cast, clad	Fair	Good	133	5.8	Resistant to solutions of hydrochloric and sulfuric acids
Inconel 600 (78 Ni; 15 Cr; 7 Fe)	1	1	1	3 < 400 4 < 900	Wrought, cast, clad	Good	Good	90	8.9	Wide application in food and pharmaceutical industries

TABLE 23-5 Coefficient of Thermal Expansion of Common Alloys*

	UNS	10^{-6} in./in.-°F	10^{-5} mm/ (mm· °C)	Temperature range, °C
Aluminum alloy AA1100	A91100	13.1	24	20-100
Aluminum alloy AA5052	A95052	13.2	24	20-100
Aluminum cast alloy 43	A24430	12.3	22	20-100
Copper	C11000	9.4	16.9	20-100
Red brass	C23000	10.4	18.7	20-300
Admiralty brass	C44300	11.2	20	20-300
Muntz Metal	C28000	11.6	21	20-300
Aluminum bronze D	C61400	9.0	16.2	20-300
Ounce metal	C33600	10.2	18.4	0-100
90-10 copper nickel	C70600	9.5	17.1	20-300
70-30 copper nickel	C71500	9.0	16.2	20-300
Carbon steel, AISI 1020	G10200	6.7	12.1	0-100
Gray cast iron	F10006	6.7	12.1	0-100
4-6 Cr, ½ Mo steel	S30100	7.3	13.1	20-540
Stainless steel, AISI 410	S41000	6.1	11.0	0-100
Stainless steel, AISI 446	S44600	5.8	10.4	0-100
Stainless steel, AISI 304	S30400	9.6	17.3	0-100
Stainless steel, AISI 316	S31600	8.0	14.4	0-100
Stainless steel, ACl HK	J94224	9.4	16.9	20-540
Nickel alloy 200	N02200	7.4	13.3	20-90
Nickel alloy 400	N04400	7.7	13.9	20-90
Nickel alloy 600	N06600	7.4	13.3	20-90
Nickel-molybdenum alloy B-2	N10663	3.6	10.1	20-90
Nickel-molybdenum alloy C-276	N10276	6.3	11.3	20-90
Titanium, commercially pure	R50250	4.8	8.6	0-100
Titanium alloy Ti- 6Al-4V	R56400	4.9	8.8	0-100
Magnesium alloy AZ31B	M11311	14.5	26	20-100
Magnesium alloy AZ91C	M11914	14.5	26	20-100
Chemical lead	16.4	30	0-100
50-50 solder	L05300	13.1	24	0-100
Zinc	Z13001	18	32	0-100
Tin	L13002	12.8	23	0-100
Zirconium	R60702	2.9	5.2	0-100
Molybdenum	R03600	2.7	4.9	20-100
Tantalum	R03200	3.6	6.3	20-100

*Courtesy of National Association of Corrosion Engineers.

TABLE 23-6 Melting Temperatures of Common Alloys*

	UNS	Melting range	
		°F	°C
Aluminum alloy AA1100	A91100	1190-1213	640-660
Aluminum alloy AA5052	A95052	1125-1200	610-650
Aluminum cast alloy 43	A24430	1065-1170	570-630
Copper	C11000	1980	1083
Red brass	C23000	1810-1850	990-1025
Admiralty brass	C44300	1650-1720	900-935
Muntz Metal	C28000	1650-1660	900-905
Aluminum bronze D	C61400	1910-1940	1045-1060
Ounce metal	C33600	1510-1640	554-1010
Manganese bronze	C36300	1583-1616	562-380
90-10 copper nickel	C70600	2010-2100	1100-1150
70-30 copper nickel	C71500	2140-2250	1170-1240
Carbon steel, AISI 1020	G10200	2780	1530
Gray cast iron	F10006	2100-2200	1150-1200
4-6 Cr, ½ Mo Steel	S30100	2700-2500	1450-1540
Stainless steel, AISI 410	S41000	2700-2790	1480-1530
Stainless steel, AISI 446	S44600	2600-2750	1430-1510
Stainless steel, AISI 304	S30400	2550-2650	1400-1450
Stainless steel, AISI 316	S31600	2500-2650	1400-1450
Stainless steel, ACl HK	J94224	2550	1400
Nickel alloy 200	N02200	2615-2635	1440-1450
Nickel alloy 400	N04400	2770-2460	1500-1350
Nickel alloy 600	N06600	2470-2573	1350-1410
Nickel-molybdenum alloy B-2	N10663	2375-2495	1300-1370
Nickel-molybdenum alloy C-276	N10276	2420-2500	1320-1370
Titanium, commercially pure	R50250	3100	1705
Titanium alloy Ti-6Al-4V	R56400	2920-3020	1600-1660
Magnesium alloy AZ 31B	M11311	1120-1170	605-632
Magnesium alloy HK 31A	M12310	1092-1204	588-651
Chemical lead	613	326
50-50 solder	L05300	361-421	185-216
Zinc	Z13001	737	420
Tin	L13002	450	232
Zirconium	R60702	3350	1860
Molybdenum	R03600	4730	2510
Tantalum	R03200	5425	2996

*Courtesy of National Association of Corrosion Engineers.

TABLE 23-12 Standard Wrought Austenitic Stainless Steels*

AISI type	UNS	Composition, %†							Mechanical properties‡			
		Cr	Ni	Mo	C	Si	Mn	Other	Yield strength, kip/in ² (MPa)	Tensile strength, kip/in ² (MPa)	Elongation, %	Hardness, HB
201	S20100	16-18	3.5-5.5	...	0.15	1.0	5.5-7.5	0.25 N	55 (379)	115 (793)	53	155
202	S20200	17-19	4-6	...	0.15	1.0	7.5-10	0.25 N	53 (379)	105 (724)	53	183
301	S30100	16-18	6-8	...	0.15	1.0	2.0	...	40 (276)	105 (724)	53	165
302	S30200	17-19	8-10	...	0.15	1.0	2.0	...	35 (241)	90 (621)	60	150
302B	S30215	17-19	8-10	...	0.15	2.0-3.0	2.0	...	40 (276)	90 (621)	50	163
303	S30300	17-19	8-10	0.6	0.15	1.0	2.0	0.15 S, 0.2 P	35 (241)	90 (621)	50	160
303Se	S30323	17-19	8-10	...	0.15	1.0	2.0	0.15 Se, 0.2 P	35 (241)	90 (621)	50	160
304	S30400	18-20	8-10.5	...	0.08	1.0	2.0	...	35 (241)	82 (565)	60	149
304L	S30403	18-20	8-12	...	0.03	1.0	2.0	...	33 (228)	79 (545)	60	145
304N	S30451	18-20	8-10.5	...	0.08	1.0	2.0	0.10-0.16 N	48 (331)	90 (621)	50	180
308	S30800	19-21	10-12	...	0.08	1.0	2.0	...	30 (207)	85 (586)	55	150
309	S30900	22-24	12-15	...	0.20	1.0	2.0	...	40 (276)	95 (655)	45	170
309S	S30908	22-24	12-15	...	0.08	1.0	2.0	...	40 (276)	95 (655)	45	170
310	S31000	24-26	19-22	...	0.25	1.5	2.0	...	45 (310)	95 (655)	50	170
310S	S31008	24-26	19-22	...	0.08	1.5	2.0	...	45 (310)	95 (655)	50	170
314	S31400	23-26	19-22	...	0.23	1.5-3.0	2.0	...	50 (345)	100 (690)	45	180
316	S31600	16-18	10-14	2.0-3.0	0.08	1.0	2.0	...	36 (248)	82 (565)	55	149
316L	S31603	16-18	10-14	2.0-3.0	0.03	1.0	2.0	...	34 (234)	81 (558)	55	145
316N	S31631	16-18	10-14	2.0-3.0	0.08	1.0	2.0	0.10-0.16 N	42 (290)	90 (621)	55	150
317	S31700	18-20	11-15	3.0-4.0	0.08	1.0	2.0	...	40 (276)	85 (586)	50	160
317L	S31703	18-20	11-15	3.0-4.0	0.03	1.0	2.0	...	35 (241)	85 (586)	55	150
321	S32100	17-19	9-12	...	0.08	1.0	2.0	(5 × C) Ti‡	30 (207)	85 (586)	55	160
329	S32900	23-30	3-6	1.0-2.0	0.10	1.0	2.0	...	80 (532)	105 (724)	25	230
347	S34700	17-19	9-13	...	0.08	1.0	2.0	(10 × C) Nb + Ta‡	35 (241)	90 (621)	50	160
348	S34800	17-19	9-13	...	0.08	1.0	2.0	(10 × C) Nb + Ta‡ 0.20 Cu	35 (241)	90 (621)	50	160

*Courtesy of National Association of Corrosion Engineers. To convert megapascals to pounds-force per square inch, multiply by 145.04.

†Single values are maximum values unless otherwise noted.

‡Typical room-temperature properties of solution-annealed plates.

§Minimum.

¶Minimum except Ta = 0.1 maximum.

TABLE 23-15 Standard Cast Corrosion-Resistant Stainless Steels*

AISI	Equivalent AISI	UNS	Composition, %†							Mechanical properties‡			
			Cr	Ni	Mo	C	Mn	Si	Other	Yield strength, kip/in ² (MPa)	Tensile strength, kip/in ² (MPa)	Elongation, %	Hardness, HB
CA-15	410	J91150	11.5-14	1.0	0.5	0.15	1.00	1.50	150 (1034) [§]	200 (1379) [§]	7 [¶]	390 [¶]
CA-15M	...	J91151	11.5-14	1.0	0.15-1.0	0.15	1.00	1.50	150 (1034) [§]	200 (1379) [§]	7 [¶]	390 [¶]
CA-6NM	...	J91540	11.5-14	3.5-4.5	0.4-1.0	0.06	1.00	1.00	100 (690) [§]	120 (827) [§]	4 [¶]	269 [¶]
CA-40	420	J91153	11.5-14	1.0	0.5	0.20-0.40	1.00	1.50	165 (1138) [§]	220 (1517) [§]	1 [¶]	470 [¶]
CB-30	431	J91803	18-21	2.0	0.30	1.00	1.50	60 (414) [§]	95 (635) [§]	15 [¶]	195 [¶]
CC-30	446	J92615	26-30	4.0	0.50	1.00	1.50	65 (448) [§]	97 (669) [§]	18 [¶]	210 [¶]
CE-30	312	J93423	26-30	8-11	0.30	1.50	2.00	63 (434) [§]	97 (669) [§]	18	190
CB-7Cu	(17-4PH)	(16)	(4)	0.07	(3) Cu	165 (1138)	5	415
CD-4MCu	25-28.5	4.75-6.0	1.75-2.25	0.04	1.00	1.00	2.75-4.25 Cu	81 (565)	108 (745)	25	233
CF-3	304L	J92500	17-21	8-12	0.03	1.50	2.00	38 (248)	77 (531)	60	140
CF-8	304	J92600	18-21	8-11	0.08	1.50	2.00	37 (255)	77 (531)	55	140
CF-20	302	J92602	18-21	8-11	0.20	1.50	2.00	38 (248)	77 (531)	50	163
CF-3M	316L	J92500	17-21	9-13	2.0-3.0	0.03	1.50	1.50	38 (262)	80 (532)	55	150
CF-8M	316	J92900	18-21	9-12	2.0-3.0	0.08	1.50	2.00	42 (290)	80 (532)	50	160
CF-12M	16-21	9-12	2.0-3.0	0.12	1.50	2.00	42 (290)	80 (532)	50	160
CG-12	317	J93000	18-21	9-13	3.0-4.0	0.08	1.50	1.50	44 (303)	83 (572)	45	170
CF-8C	347	J92710	15-21	9-12	0.05	1.50	2.00	(5 × C) Nb [¶]	38 (262)	77 (531)	39	149
CF-16F	303	J92701	15-21	9-12	1.50	0.16	1.50	2.00	40 (276)	77 (531)	52	150
CG-12	...	J93001	20-23	10-13	0.12	1.50	2.00	28 (183)	35	...
CH-20	509	J93402	25-26	12-15	0.20	1.50	2.00	50 (345)	88 (607)	55	190
CK-20	310	J94202	23-27	19-22	0.20	1.50	2.00	38 (262)	75 (524)	37	144
CN-7M	...	J95150	19-22	27.5-30.3	2.0-3.0	0.07	1.50	1.50	3-4 Cu	32 (221)	69 (476)	45	150

*Courtesy of National Association of Corrosion Engineers. To convert megapascals to pounds-force per square inch, multiply by 145.04.

†Single values are maximum values except those in parentheses, which are minimum values. P and S values are 0.04 maximum.

‡Typical room-temperature properties for solution-annealed material unless otherwise noted.

§For material air-cooled from 1500°F and tempered at 600°F.

¶For material air-cooled from 1750°F and tempered at 1100 to 1150°F.

§For material annealed at 1450°F, furnace-cooled to 1000°F, then air-cooled.

¶Air-cooled from 1900°F.

§1.0 maximum.



Nitric acid

Corrosion mediums

Test conditions

Average corrosion rates (ipy)

	INDUSTRY (PROCESS)	TYPE OF TEST	AVERAGE TEMPERATURE (F)	DURATION (DAYS)	AERATION	AGITATION	Average corrosion rates (ipy)					
							TYPE 304	TYPE 316	TYPE 317	"20"	NI-O-NEL	
50%	Research	L	98	6	xx	—	...	<0.0001
42%	Research	L	200	0.0033	0.0042
40%	Research	L	98	6	xx	—	...	<0.0001
38%	Research	L	98	6	xx	—	...	<0.0001
25%	Research	L	130	...	—	—	0.0002	0.0001
20%	Research	L	98	6	xx	—	...	<0.0001
10%	Research	L	98	6	xx	—	...	<0.0001
10%	Research	L	212	6	xx	—	...	0.0002
10%	Chemical	L	B.P.	30	0.0003
10%	Research	L	75	1	<0.0001
10%	Research	L	150	1	<0.0001
10%	Mining	F	120	70	xx	—	<0.0001	<0.0001
6%	Research	L	210	2	nil
5%	Research	L	98	6	xx	—	...	<0.0001
5%	Research	L	212	6	xx	—	...	0.0002
5%	Metal	L	86	14	xx	xx	<0.0001 L<0.0001
5%	Metal	L	140	14	xx	xx	<0.0001 L<0.0001
5%	Metal	L	195	14	xx	xx	<0.0001 L<0.0001

HWMA/RCRA PART B PERMIT
FOR THE IDAHO NATIONAL LABORATORY

Volume 18 – Idaho Nuclear Technology and Engineering Center

APPENDIX 6

Debris Treatment Processes
Holdup and Collection Tanks
CPP-659/-1659 Storage
CPP-666 FDP Cell Container Storage and Slab Tank Storage
Other Miscellaneous Treatment Processes
RMWSF (CPP-1617) Container Storage Area

PE CERTIFICATION OF SINKS, ULTRASONIC CLEARNER,
AND HOLDUP/COLLECTION TANKS

Effective Date: April 27, 2009

**NEW WASTE CALCINING
FACILITY (CPP-659)
TANK SYSTEMS
P.E. CERTIFICATION
REPORT
for the
RCRA PART B PERMIT
APPLICATION for
the INEL (Vol. 18)**

**Prepared By: Keith D. Hendrickson, P.E.
Idaho Registration Number 7765
Science Applications International Corp.**

I certify that the design of the identified hazardous waste liquid tank systems in the New Waste Calcining Facility (CPP-659) at the Idaho Chemical Processing Plant (ICPP) at the Idaho National Engineering Laboratory (INEL) comply with the requirements of 40 CFR-264.190 Subpart J - Tank Systems for the storage and treatment of hazardous wastes in tank systems.

The following tank systems are certified for the storage and treatment of hazardous wastes:

- Sink (SH-NCD-933) in CPP-659 room 415.
- Sink (SH-NCD-934) in CPP-659 room 415.
- Ultrasonic Cleaner (UC-NCD-921) in CPP-659 room 415.
- Decon Hold-up Tank (VES-NCD-123) in CPP-659 room 219.
- Decon Collection Tank (VES-NCD-129) in CPP-659 room 203.

The underground portions of the Decon Hold-up Tank and the Decon Collection Tank ancillary piping to the tank farm (1 1/2"-PLAD-2628) and to the PEW evaporator (1 1/2"-PLAD-2629) are not covered by the Vol. 18 Part B RCRA permit application, and were therefore not assessed.

Sink (SH-NCD-933)

Description:

Sink (SH-NCD-933) is a 16 gauge series 300 stainless steel sink, 9'-11" x 2'-0" x 1'-6" deep. The sink is recessed in the counter of a hood that protects the room from spills and fumes from the sink. The sink is provided with a 1/4" drain line that drains to the Decon Hold-up Tank (VES-NCD-123). Air emissions from the hood are vented to the vent air scrubber system. Decon solutions and water are provided inside the hood for use in the sink.

ASSESSMENT OF EXISTING TANK SYSTEM (40 CFR-264.191):

Design Standards:

The standard used for the series 300 stainless steel material to construct the sink is:

American Society for Testing and Materials (ASTM)
ASTM A 167 Stainless and Heat Resisting Chromium-Nickel Steel Plate, Sheet, and Strip

The codes and standards used for the design and construction of the sink are unknown.

Hazardous Characteristics of Waste:

Table 1 lists all treatment processes, the treatment solutions, the hazardous characteristics of the solutions, and the solution's corrosivity to series 300 stainless steel.

Corrosion Protection Measures:

Corrosion protection for the sink is provided by materials of construction and corrosion allowances. Materials of construction were selected based on suitability for process service and compatibility with the treatment solutions. Series 300 stainless steel was selected for use in the sink. The corrosivity of the treatment solutions to stainless steel is listed in Table 1.

Age:

Sink (SH-NCD-933) was placed into service in 1982.

Integrity Examinations:

When in use, the sink is examined daily for signs of cracks, leaks, and corrosion. All signs of integrity deterioration are reviewed and corrective action taken.

Ancillary Equipment:

Ancillary equipment for the sink includes lines 1 1/2"-PLAD-2640, 1 1/2"-PLAD-4206, 3"-PLAD-4206, and 3"-PLAD-4211 which drain the sink to the Decon Hold-up Tank (VES-NCD-123).

CONTAINMENT AND DETECTION OF RELEASES (40 CFR-264.193):

Secondary Containment:

The secondary containment for sink (SH-NCD-933) is a 12'-0" x 31'-6" area in the Low Level Decon Room on the first level of CPP-659. The secondary containment area is separated from the rest of the room by a 10 GA stainless steel wall that forms part of the containment. The rest of the containment is provided by a 10 GA stainless steel floor liner and 6" curb on the outer wall.

The capacity of the sink is 237 gallons (31.7 ft³).

The capacity of the curbed area is 1,337 gallons (178.8 ft³), see Calculation #1.

Ancillary Equipment:

The sink drainage piping that is outside the curbed area in Low Level Decon Room is doubly encased until it reaches the decon hold-up tank cell. Here, the pipe encasement is diverted to the cell's collection trench and the piping continues into the hold-up tank. The cell provides the secondary containment for the piping while in the cell. The cell trench drains to the Hot Sump Tank (VES-NCC-122) through 3"-PLAD-4215. The trench drain is provided with a level sensor (LE-219) that will activate alarm L-NC-219C in the NWCF control room if the sink drain pipe leaks. The cell and trench liner, the sink drain pipe encasement, the trench drain pipe, and the hot sump tank are all constructed of stainless steel.

Sink (SH-NCD-934)

Description:

Sink (SH-NCD-934) is a 16 gauge series 300 stainless steel sink, 18" x 20" x 18" deep. The sink is recessed in the counter of a hood that protects the room from spills and fumes from the sink. The sink is provided with a 1 1/2" drain line that drains to the Decon Hold-up Tank (VES-NCD-123). Air emissions from the hood are vented to the vent air scrubber system. Decon solutions and water are provided inside the hood for use in the sink.

ASSESSMENT OF EXISTING TANK SYSTEM (40 CFR-264.191):

Design Standards:

The standard used for the series 300 stainless steel material to construct the sink is:

American Society for Testing and Materials (ASTM)
ASTM A 167 Stainless and Heat Resisting Chromium-Nickel Steel Plate, Sheet, and Strip

The codes and standards used for the design and construction of the sink are unknown.

Hazardous Characteristics of Waste:

Table 1 lists all treatment processes, the treatment solutions, the hazardous characteristics of the solutions, and the solution's corrosivity to series 300 stainless steel.

Corrosion Protection Measures:

Corrosion protection for the sink is provided by materials of construction and corrosion allowances. Materials of construction were selected based on suitability for process service and compatibility with the treatment solutions. Series 300 stainless steel was selected for use in the sink. The corrosivity of the treatment solutions to stainless steel is listed in Table 1.

Age:

Sink (SH-NCD-934) was placed into service in 1982.

Integrity Examinations:

When in use, the sink is examined daily for signs of cracks, leaks, and corrosion. All signs of integrity deterioration are reviewed and corrective action taken.

Ancillary Equipment:

Ancillary equipment for the sink includes lines 1 1/2"-PLAD-2641, 1 1/2"-PLAD-4206, 3"-PLAD-4206, and 3"-PLAD-4211 which drain the sink to the Decon Hold-up Tank (VES-NCD-123).

CONTAINMENT AND DETECTION OF RELEASES (40 CFR-264.193):

Secondary Containment:

The secondary containment for sink (SH-NCD-934) is a 12'-0" x 31'-6" area in the Low Level Decon Room on the first level of CPP-659. The secondary containment area is separated from the rest of the room by a 10 GA stainless steel wall that forms part of the containment. The rest of the containment is provided by a 10 GA stainless steel floor liner and 6" curb on the outer wall.

The capacity of the sink is 28 gallons (3.7 ft³).

The capacity of the curbed area is 1,337 gallons (178.8 ft³), see Calculation#1.

Ancillary Equipment:

The sink drainage piping that is outside the curbed area in Low Level Decon Room is doubly encased until it reaches the decon hold-up tank cell. Here, the pipe encasement is diverted to the cell's collection trench and the piping continues into the hold-up tank. The cell provides the secondary containment for the piping while in the cell. The cell trench drains to the Hot Sump Tank (VES-NCC-122) through 3"-PLAD-4215. The trench drain is provided with a level sensor (LE-219) that will activate alarm L-NC-219C in the NWCF control room if the sink drain pipe leaks. The cell and trench liner, the sink drain pipe encasement, the trench drain pipe, and the hot sump tank are all constructed of stainless steel.

Ultrasonic Cleaner (UC-NCD-921)

Description:

Ultrasonic Cleaner (UC-NCD-921) is a 16 gauge series 300 stainless steel sink, 2'-2" x 2'-2" x 2'-3" deep. The sink is built into a protective box with a hood that protects the room from spills and fumes from the cleaner. The cleaner is provided with a 1 1/2" drain line that drains to the Decon Hold-up Tank (VES-NCD-123). Air emissions from the hood are vented to the vent air scrubber system.

ASSESSMENT OF EXISTING TANK SYSTEM (40 CFR-264.191):

Design Standards:

The standard used for the series 300 stainless steel material to construct the ultrasonic cleaner is:

American Society for Testing and Materials (ASTM)
ASTM A167 Stainless and Heat Resisting Chromium-Nickel Steel Plate, Sheet, and Strip

The codes and standards used for the design and construction of the ultrasonic cleaner are unknown.

Hazardous Characteristics of Waste:

Table 1 lists all treatment processes, the treatment solutions, the hazardous characteristics of the solutions, and the solution's corrosivity to series 300 stainless steel.

Corrosion Protection Measures:

Corrosion protection for the ultrasonic cleaner is provided by materials of construction and corrosion allowances. Materials of construction were selected based on suitability for process service and compatibility with the treatment solutions. Series 300 stainless steel was selected for use in the ultrasonic cleaner. The corrosivity of the treatment solutions to stainless steel is listed in Table 1.

Age:

Ultrasonic Cleaner (UC-NCD-921) was placed into service in 1982.

Integrity Examinations:

When in use, the ultrasonic cleaner is examined daily for signs of cracks, leaks, and corrosion. All signs of integrity deterioration are reviewed and corrective action taken.

Ancillary Equipment:

Ancillary equipment for the ultrasonic cleaner includes lines 1 1/2"-PLAD-2643, 3"-PLAD-4206, and 3"-PLAD-4211 which drain the cleaner to the Decon Hold-up Tank (VES-NCD-123).

CONTAINMENT AND DETECTION OF RELEASES (40 CFR-264.193):

Secondary Containment:

The secondary containment for the ultrasonic cleaner (UC-NCD-921) is a 12'-0" x 31'-6" area in the Low Level Decon Room on the first level of CPP-659. The secondary containment area is separated from the rest of the room by a 10 GA stainless steel wall that forms part of the containment. The rest of the containment is provided by a 10 GA stainless steel floor liner and 6" curb on the outer wall.

The capacity of the ultrasonic cleaner is 79 gallons (10.6 ft³).

The capacity of the curbed area is 1.337 gallons (178.8 ft³), see Calculation#1.

Ancillary Equipment:

The cleaner drainage piping that is outside the curbed area in Low Level Decon Room is doubly encased until it reaches the decon hold-up tank cell (room 219). Here, the pipe encasement is diverted to the cell's collection trench and the piping continues into the hold-up tank. The cell provides the secondary containment for the piping while in the cell. The cell trench drains to the Hot Sump Tank (VES-NCC-122) through 3"-PLAD-4215. The trench drain is provided with a level sensor (LE-219) that will activate alarm L-NC-219C in the NWCF control room if the cleaner drain pipe leaks. The cell and trench liner, the sink drain pipe encasement, the trench drain pipe, and the hot sump tank are all constructed of stainless steel.

Decon Hold-up Tank (VES-NCD-123)

Description:

Decon Hold-up Tank (VES-NCD-123) is a 304L stainless steel tank, 7'-0" diameter by 9'-0" long tangent to tangent, with a capacity of 3,800 gallons (508 ft³). The tank is horizontally mounted with a support saddle at both ends. The tank is provided with a 2" drain line that goes to Decon Hold-up Tank Pump (P-NCD-223).

ASSESSMENT OF EXISTING TANK SYSTEM (40 CFR-264.191):

Design Standards:

The standard used for the series 300 stainless steel material to construct the tank is:

American Society for Testing and Materials (ASTM)
ASTM A167 Stainless and Heat Resisting Chromium-Nickel Steel Plate, Sheet, and Strip

The code used for the design and construction of the tank is:

American Society of Mechanical Engineers (ASME)
ASME Boiler and Pressure Vessel Code, Section VIII, Div. 1, Pressure Vessels

Hazardous Characteristics of Waste:

Table 1 lists all treatment processes, the treatment solutions, the hazardous characteristics of the solutions, and the solution's corrosivity to series 300 stainless steel.

Corrosion Protection Measures:

Corrosion protection for the tank is provided by materials of construction and a 0.135" corrosion and cleaning allowance. Materials of construction were selected based on suitability for process service and compatibility with the treatment solutions. Series 300 stainless steel was selected for use in the tank. The corrosivity of the treatment solutions to stainless steel is listed in Table 1.

Age:

Decon Hold-up Tank (VES-NCD-123) was placed into service in 1982.

Integrity Examinations:

The tank is continuously monitored for leaks by the drain line 3"-PLAD-4215 level sensor (LE-219) which will activate alarm L-NC-219C in the NWCF control room if the tank leaks. The tank is examined during each cell entry for signs of cracks, leaks, and corrosion. All signs of integrity deterioration are reviewed and corrective action taken.

Ancillary Equipment:

Ancillary equipment for the Decon Hold-up Tank includes the tank drain line (2"-PLAD-2631) which runs to the Decon Hold-up Tank Pump (P-NCD-223), and the following lines which run from the pump to the listed designations:

1 1/2"-PLAD-2632	to	1 1/2"-PLAD-2628	to the Tank Farm
1 1/2"-PLAD-2634	to	1 1/2"-PLAD-2629	to the PEW Evaporator
1 1/2"-SWAD-2633	to	4"-SWNB-4157	to the Service Waste System *

* This line has a blind flange between lines 1 1/2"-SWAD-2633 and 4"-SWNB-4157 to prevent transfers to the service waste system.

CONTAINMENT AND DETECTION OF RELEASES (40 CFR-264.193):

Secondary Containment:

The secondary containment for Decon Hold-up Tank (VES-NCD-123) is the Decon Hold-up Tank Cell (Room 219), the Manipulator Parking and Maintenance Area (Room 218), and the Filter Cell and Lower Valve Cubicle (Room 216) on the third level of CPP-659. The Hold-up Tank Cell is 14'-4" x 14'-9", the Manipulator Parking and Maintenance Area is 12'-8" x 16'-2", the Filter Cell is 22'-6" x 13'-2", and the Lower Valve Cubicle is 27'-8" x 9'-9". All four areas have a stainless steel floor liner, and a curb that is 6" above the high point of the floor.

The capacity of the hold-up tank cell is 3,800 gallons (508 ft³).

The capacity of the hold-up tank secondary containment is 4,685 gallons (626.4 ft³), see Calculation #2.

The hold-up tank cell's trench drains to the Hot Sump Tank (VES-NCC-122) through 3"-PLAD-4215. The drain is provided with a level sensor (LE-219) that will activate alarm L-NC-219C in the NWCF control room if the tank leaks. The manipulator parking and maintenance area's trench drains to the hot sump tank through 2"-PLAD-4213 and 3"-PLAD-4212. The filter cell's trench drains to the hot sump tank through 3"-PLAD-4212. The lower valve cubicle's trench drains to the hot sump tank (VES-NCC-119) through 3"-PLAD-4220. The cell and trench liners, the trench drain pipes, and the hot sump tanks are all constructed of stainless steel.

Ancillary Equipment:

The tank ancillary equipment secondary containment is provided by the Decon Hold-up Tank Cell, the Decon Collection Tank & Pump Cell, and the Lube Oil Console Room.

At the point where lines 1 1/2"-PLAD-2629 to the PEW Evaporator, and 1 1/2"-PLAD-2628 to the Tank Farm leave the pump cell, they are no longer covered by the Vol. 18 Part B permit application.

Line 1 1/2"-SWAD-2633 to the service waste system (4"-SWNB-4157) is blind flanged in the Lube Oil Console Room to prevent transfers to the service waste system. After the blind flange, the line is considered part of the service waste system and not covered by this application.

The cell trenches drain to the Hot Sump Tank (VES-NCC-122) through 3"-PLAD-4215. The trench drain is provided with a level sensor (LE-219) that will activate alarm L-NC-219C in the NWCF control room if the ancillary equipment leaks. The cell and trench liner, the trench drain pipe, and the hot sump tank are all constructed of stainless steel.

Decon Collection Tank (VES-NCD-129)

Description:

Decon Collection Tank (VES-NCD-129) is a 304L stainless steel tank, 4'-0" diameter by 5'-6" tall tangent to tangent, with a capacity of 530 gallons (71 ft³). The tank is vertically mounted with four support legs. The tank is provided with a 2" drain line that goes to Decon Collection Tank Pump (P-NCD-229).

ASSESSMENT OF EXISTING TANK SYSTEM (40 CFR-264.191):

Design Standards:

The standard used for the series 300 stainless steel material to construct the tank is:

American Society for Testing and Materials (ASTM)

ASTM A167 Stainless and Heat Resisting Chromium-Nickel Steel Plate, Sheet, and Strip

The code used for the design and construction of the tank is:

American Society of Mechanical Engineers (ASME)

ASME Boiler and Pressure Vessel Code, Section VIII, Div. 1, Pressure Vessels

Hazardous Characteristics of Waste:

Table 1 lists all treatment processes, the treatment solutions, the hazardous characteristics of the solutions, and the solution's corrosivity to series 300 stainless steel.

Corrosion Protection Measures:

Corrosion protection for the tank is provided by materials of construction and a 0.135" corrosion and cleaning allowance. Materials of construction were selected based on suitability for process service and compatibility with the treatment solutions. Series 300 stainless steel was selected for use in the tank. The corrosivity of the treatment solutions to stainless steel is listed in Table 1.

Age:

Decon Collection Tank (VES-NCD-129) was placed into service in 1982.

Integrity Examinations:

The tank is continuously monitored for leaks by the drain line 3"-PLAD-4215 level sensor (LE-219) which will activate alarm L-NC-219C in the NWCF control room if the tank leaks. The tank is examined during each cell entry for signs of cracks, leaks, and corrosion. All signs of integrity deterioration are reviewed and corrective action taken.

Ancillary Equipment:

Ancillary equipment for the Decon Collection Tank includes the tank drain line (2"-PLAD-2627) which runs to the Decon Collection Tank Pump (P-NCD-229), and the following lines which run from the pump to the listed designations:

1 1/2"-PLAD-2628	to the Tank Farm
1 1/2"-PLAD-2629	to the PEW Evaporator
1 1/2"-PLAD-2630	to the Decon Hold-up Tank
1 1/2"-DCAF-2635	to the Decon Cell (abandoned in place)

CONTAINMENT AND DETECTION OF RELEASES (40 CFR-264.193):

Secondary Containment:

The secondary containment for Decon Collection Tank (VES-NCD-129) is the Decon Collection Tank and Pump Cell on the third level of CPP-659. The collection tank area is approximately 7'-10" x 10'-0", and the pump area is approximately 5'-0" x 10'-0". Both areas are provided with a 10 GA stainless steel floor liner, and a curb that is 6" above the high point of the floor.

The capacity of the Decon Collection Tank is 530 gallons (71 ft³).

The capacity of the collection tank secondary containment is 593 gallons (79.3 ft³), see Calculation #3.

The decon collection tank and pump cell trenches drain to the Hot Sump Tank (VES-NCC-122) through 3"-PLAD-4215. The drain is provided with a level sensor (LE-219) that will activate alarm L-NC-219C in the NWCF control room if the tank leaks. The cell and trench liners, the trench drain pipes, and the hot sump tank are all constructed of stainless steel.

Ancillary Equipment:

The tank ancillary equipment secondary containment is provided by the Decon Collection Tank & Pump Cell, and the Decon Hold-up Tank Cell.

At the point where lines 1 1/2"-PLAD-2629 to the PEW Evaporator, and 1 1/2"-PLAD-2628 to the Tank Farm leave the pump cell, they are no longer covered by the Vol. 18 Part B permit application.

Line 1 1/2"-DCAF-2635 from the decon collection tank pump (P-NCD-229) to the Decon Cell is abandoned in place and is no longer used.

The trenches in the collection tank and pump areas drain to the Hot Sump Tank (VES-NCC-122) through 3"-PLAD-4215. The trench drains are provided with a level sensor (LE-219) that will activate alarm L-NC-219C in the NWCF control room if the ancillary equipment leaks. The cell and trench liner, the trench drain pipe, and the hot sump tank are all constructed of stainless steel.

Calculation #1

Sinks and Ultrasonic Cleaner Secondary Containment

Description:

The secondary containment for the sinks (SH-NCD-933 & SH-NCD-934) and the ultrasonic cleaner (UC-NCD-921) is a curbed area in the Low Level Decon Room on the first level of CPP-659. The curbed area has two sections which are approximately 12'-0" x 16'-0" and 10'-6" x 16'-0". The curbed area is constructed of stainless steel, and the curb is 6" above the high point of the floor. The curbed area is not sloped, and does not have a floor drain.

Sink (SH-NCD-933) has a capacity of 237 gal. (31.7 ft³).

Sink (SH-NCD-934) has a capacity of 28 gal. (3.7 ft³).

Ultrasonic Cleaner (UC-NCD-921) has a capacity of 79 gal. (10.6 ft³).

Elevations:

Top of curb	-	4917'-6"
Top of floor	-	4917'-0"

Volume:

Volume from floor to top of curb

$$V_{s1} = 12'-0" \times 16'-0" \times 0'-6" = 96.0 \text{ ft}^3$$

$$V_{s2} = 10'-6" \times 16'-0" \times 0'-6" = 84.0 \text{ ft}^3$$

Volume removed due to wall footings

$$V_{f1} = 1'-6" \times 0'-6" \times 0'-6" = 0.375 \text{ ft}^3$$

$$V_{f2} = 1'-6" \times 0'-6" \times 0'-6" = 0.375 \text{ ft}^3$$

$$V_{f3} = 1'-0" \times 1'-0" \times 0'-6" = 0.500 \text{ ft}^3$$

Total volume available for secondary containment for the Sinks and Ultrasonic Cleaner

$$\text{Vol} = 178.8 \text{ ft}^3 (1,337 \text{ gal.})$$

Calculation #2

Decon Hold-up Tank (VES-NCD-123) Secondary Containment

The Decon Hold-up Tank is a 304L stainless steel tank, 7'-0" diameter by 9'-0" long tangent to tangent, with a capacity of 3,800 gallons (508 ft³). The secondary containment for this tank is the Decon Hold-up Tank Cell, the Manipulator Parking and Maintenance Area, the Filter Cell, and the Lower Valve Cubicle on the third level of CPP-659. After a tank rupture, the hold-up tank cell will fill up to the bottom of the door to the manipulator room. The manipulator room will then fill up to the bottom of the door to the filter cell. The filter cell and valve cubicle will then fill until the total volume in the tank is contained.

Decon Hold-up Tank Cell

Description:

The decon hold-up tank cell is 14'-9" x 14'-4", lined with 10 GA stainless steel, and sloped from the north wall to a 1' wide trench along the south wall of the cell. The cell has a curb that is 6" above the floor, two 1'-0" x 7'-8" pedestals for the hold-up tank, and a door in the north wall to the manipulator parking room.

Elevations:

Bottom of door to manipulator room	-	4882'-3"
Bottom of curb & top of sloped floor	-	4881'-6"
Bottom of sloped floor	-	4881'-4"
Bottom of trench	-	4880'-9" (average)

Volume:

Volume above floor to bottom of curb			
V_n	=	$\frac{1}{2} \times 13'-9" \times 14'-4" \times 0'-2"$	= 16.4 ft ³
Volume in and above trench to bottom of curb			
V_{tt}	=	$1'-0" \times 14'-4" \times 0'-9"$	= 10.7 ft ³
Volume from bottom of curb to the bottom of the door			
V_{ot}	=	$14'-9" \times 14'-4" \times 0'-9"$	= 158.6 ft ³
Volume removed due to pedestals			
V_{pt}	=	$2 \times 1'-0" \times 7'-8" \times 0'-11"$	= 14.0 ft ³

Total Volume available in the Decon Hold-up Tank Cell

$$V_t = 171.7 \text{ ft}^3 \text{ (1,284 gallons)}$$

Manipulator Parking and Maintenance Area

Description:

The manipulator parking and maintenance area is 12'-8" x 16'-2". The room is lined with 10 GA stainless steel, and sloped from the west wall to a 1' wide trench near the east wall of the cell. The cell floor is at four different elevations, the west section is level with the door from the hold-up tank cell, the middle section is 8" below the west section, the trench is east of the middle section, and the along the east wall is a 1'-0" wide

section that is the same height as the door to the filter cell. The cell has a curb that is 6" above the level of the door to the filter cell. A 1'-6" thick shielding wall separates the western section into two areas. Because the average elevation of the western section is only 1/4" below the elevation of the exit door to the filter cell, no credit will be taken for the volume of liquid in this area. Also, because the eastern section is at the same elevation as the bottom of the door to the filter cell, no credit will be taken for the volume of liquid that will be in this area.

Elevations:

Bottom of door to filter cell	-	4882'-2 3/4"
Average elevation of western section	-	4882'-2 1/2"
Average elevation of middle section	-	4881'-5 1/2"
Top of eastern section	-	4882'-2 3/4"
Bottom of trench	-	4880'-7" (average)

Volume:

Volume above middle section of floor to bottom of door			
V_n	=	$4'-8" \times 16'-2" \times 0'-9 \frac{1}{4}"$	= 58.2 ft ³
Volume in and above trench to bottom of door			
V_{ii}	=	$1'-0" \times 12'-2" \times 1'-7 \frac{3}{4}"$	= 20.0 ft ³

Total Volume available in the Manipulator Parking and Maintenance Area

$$V_1 = 78.2 \text{ ft}^3 \text{ (585 gal.)}$$

Filter Cell

Description:

The filter cell is 22'-6" x 13'-2", and is lined with 10 GA stainless steel, and sloped from the north wall to a 1' wide trench along the southern wall of the cell. The cell also has a curb that is 6" above the high point of the floor.

Elevations:

Top of curb	-	4882'-0"
Top of sloped floor	-	4881'-6"
Bottom of sloped floor	-	4881'-3 1/4"
Bottom of trench	-	4880'-8" (average)

Volume

Volume above floor to bottom of curb			
V_n	=	$\frac{1}{2} \times 22'-6" \times 12'-2" \times 0'-2 \frac{3}{4}"$	= 31.4 ft ³
Volume in and above trench to bottom of curb			
V_{ii}	=	$1'-0" \times 22'-6" \times 0'-10"$	= 18.8 ft ³
Volume from bottom to top of curb			
V_{ii}	=	$22'-6" \times 13'-2" \times 0'-6"$	= 148.1 ft ³

Total Volume available in the Filter Cell

$$V_1 = 198.3 \text{ ft}^3 \text{ (1,483 gal.)}$$

Lower Valve Cubicle

Description:

The lower valve cubicle is 27'-8" x 9'-9", and is lined with 10 GA stainless steel, and sloped from the north wall to a 1' wide trench along the southern wall of the cell. The cell also has a curb that is 6" above the high point of the floor.

Elevations:

Top of curb	-	4882'-0"
Top of sloped floor	-	4881'-6"
Bottom of sloped floor	-	4881'-4"
Bottom of trench	-	4880'-8" (average)

Volume:

Volume above floor to bottom of curb			
V_n	=	$\frac{1}{2} \times 27'-8" \times 8'-9" \times 0'-2"$	= 20.2 ft ³
Volume in and above trench to bottom of curb			
V_{11}	=	$1'-0" \times 27'-8" \times 0'-10"$	= 23.1 ft ³
Volume from bottom to top of curb			
V_{11}	=	$27'-8" \times 9'-9" \times 0'-6"$	= 134.9 ft ³

Total Volume available in the Lower Valve Cubicle

$$V_t = 178.2 \text{ ft}^3 (1,333 \text{ gal.})$$

Total volume available for secondary containment for the Decon Hold-up Tank

$$\text{Vol.} = 626.4 \text{ ft}^3 (4,685 \text{ gal.})$$

Calculation #3

Decon Collection Tank (VES-NCD-129) Secondary Containment

Description:

The Decon Collection Tank is a 304L stainless steel tank, 4'-0" diameter by 5'-6" tall tangent to tangent, with a capacity of 530 gallons (71 ft³). The secondary containment for this tank is the curbed area in the Decon Collection Tank & Pump Cell on the third level of CPP-659. The cell is divided into two separate areas; the decon collection tank area and the decon pump area. The decon collection tank area is a 10'-0" x 7'-10", and the decon pump area is a 10'-0" x 5'-0". The whole cell is lined with 10 GA stainless steel and sloped from the southern wall to 1' wide trenches along the north wall of both areas. The cell also has a curb that is 6" above the high point of the floor.

Elevations:

Top of curb	-	4883'-6"
Top of sloped floor	-	4883'-0"
Bottom of sloped floor	-	4882'-10"
Bottom of trench	-	4882'-7" (highest)

Volumes:

Decon Collection Tank Area

Volume above floor to bottom of curb			
V_n	=	$\frac{1}{2} \times 9'-0" \times 7'-10" \times 0'-2"$	= 5.9 ft ³
Volume in and above trench to bottom of curb			
V_{t1}	=	$1'-0" \times 7'-10" \times 0'-5"$	= 3.3 ft ³
Volume from bottom to top of curb			
V_{c1}	=	$10'-0" \times 7'-10" \times 0'-6"$	= 39.2 ft ³

Total Volume available in the Decon Collection Tank Area

$$V_1 = 48.4 \text{ ft}^3$$

Decon Hold-up and Collection Tank Pump Area

Volume above floor to bottom of curb			
V_n	=	$\frac{1}{2} \times 9'-0" \times 5'-0" \times 0'-2"$	= 3.8 ft ³
Volume in and above trench to bottom of curb			
V_{t2}	=	$1'-0" \times 5'-0" \times 0'-5"$	= 2.1 ft ³
Volume from bottom to top of curb			
V_{c2}	=	$10'-0" \times 5'-0" \times 0'-6"$	= 25.0 ft ³

Total Volume available in the Decon Pump Area

$$V_2 = 30.9 \text{ ft}^3$$

Total volume available for secondary containment for the Decon Collection Tank

$$Vol = 79.3 \text{ ft}^3 \text{ (593 gal.)}$$

TABLE 1

Cleaning Solutions Used In CPP-559 Waste Treatments # See NOD under D-2a(2)
(Source: ICPP Technical Information Manual)

Treatment Number	Treatment (Solutions)	Hazardous Characteristic	Corrosivity to Stainless Steel
1	Vacuum	n/a	n/a
2	L.P. Steam	n/a	none
3	M.P. Steam	n/a	none
4	H.P. Water	n/a	none
5	Detergent (Turco 4324)	acidic	none
6	Radiacwash	caustic	none
7	Ajax	caustic	n/a
8	Citric Acid	acidic	none
9	Tartanic Acid 0.7M	acidic	none
10	El-Bo-Grez	caustic	none
11	Methyl-chloroform	caustic	n/a
12	Oxalic Acid 5%	acidic	none
13	Oxalic Acid 0.9M	acidic	slight
14	Ultrasonic	n/a	Used with solutions from treatment #s 5, 6, 15, & 23.
15	Turco 4521	acidic	none
16	Turco 4308-D	acidic	none
17	Nitric Acid 1M	acidic	none
18	Nitric Acid 6M	acidic	none
19	Nitric Acid 6M Aluminum Nitrate 0.3M	acidic	none
20	Turco XO-132-W	acidic	high
21	Phosphoric Acid 50%	acidic	low
22	Phosphoric Acid 60% Sulfuric Acid 15% H ₂ CrO ₄ 5%	acidic	low
23	Turco 4512-A or Phosphoric Acid 2M	acidic	low
24	Nitric Acid 2M Potassium Permanganate 0.05M Turco 4521	acidic	none
25	Ammonium Oxalate 0.4M Citric Acid 0.16M Hydrogen Peroxide 0.34M	acidic	none
26	Sulfuric Acid 4M	acidic	moderate
27	Turco Rust Remover	caustic	none
28	Sodium Hydroxide 1.5M EDTA 0.05M	caustic	none
29	Turco 4502 10%	acidic	none
30	Turco 4502 6% Oxalic Acid 0.9M or Turco 4521 Nitric Acid 3M	acidic	low
31	Turco 4502 8% Turco 4521	acidic	none
32	Sodium Hydroxide 10% Tartanic Acid 2%	acidic	none
33	Nitric Acid 1M Sulfuric Acid 6M	acidic	low
34	Hydrofluoric 0.05M Sulfuric Acid 1M	acidic	low
35	Hydrofluoric 0.5M Nitric Acid 3M	acidic	high
36	Hydrofluoric 2M Nitric Acid 8M	acidic	moderate
37	Oxalic Acid 0.4M Hydrofluoric 0.1M Hydrogen Peroxide 0.05M	acidic	moderate
38	Grinding	n/a	n/a

HWMA/RCRA PART B PERMIT
FOR THE IDAHO NATIONAL LABORATORY

Volume 18 – Idaho Nuclear Technology and Engineering Center

APPENDIX 7

Debris Treatment Processes
Holdup and Collection Tanks
CPP-659/-1659 Storage
CPP-666 FDP Cell Container Storage and Slab Tank Storage
Other Miscellaneous Treatment Processes
RMWSF (CPP-1617) Container Storage Area

PE ASSESSMENT OF HFLS TANK DESIGN

Effective Date: April 27, 2009

**PRJ-WNCO.218
RPT-CERT.218**

**Certification Document for the Design of the
NWCF HEPA FILTER LEACHING SYSTEM
MODIFICATIONS PROJECT**

**Idaho Chemical Processing Plant
Idaho National Engineering Laboratory
Idaho Falls, Idaho**

Submitted To:

Westinghouse Idaho Nuclear Company, Inc.

August 16, 1993

**ETAS Corporation
8828 North Stemmons Freeway, Suite 413
Dallas, Texas 75247-3726
Tel (214) 630-6610 Fax (214) 630-7494**

CERTIFICATION DOCUMENT
FOR THE DESIGN OF THE
NWCF HEPA FILTER LEACHING SYSTEM MODIFICATIONS PROJECT

Idaho Chemical Processing Plant
Idaho National Engineering Laboratory
Idaho Falls, Idaho

Prepared for:

Westinghouse Idaho Nuclear Company, Inc.
Idaho Chemical Processing Plant
Idaho National Engineering Laboratory
Idaho Falls, Idaho

August 16, 1993

ETAS Corporation

DESIGN CERTIFICATION OF
 NWCF HEPA FILTER LEACHING SYSTEM
 MODIFICATIONS PROJECT
 Idaho Chemical Processing Plant
 Idaho National Engineering Laboratory
 Idaho Falls, Idaho

The attached report entitled "Certification Document for the Design of the NWCF HEPA Filter Leaching System Modifications Project, Idaho Chemical Processing Plant, Idaho National Engineering Laboratory, Idaho Falls, Idaho", dated August 16, 1993, serves as the basis for this certification which is required under both the Federal regulation 40 CFR 265.192, and the Idaho rules, regulations and standards for hazardous waste.

This certification is limited to the HEPA Filter Leaching System as set forth in the attached document. Further, this certification is limited to the design only, and does not include installation of the system.

We certify under penalty of law that this document and all attachments were prepared under our direction or supervision in accordance with a system designed to assure that qualified personnel properly gather and evaluate the information submitted. Based on our inquiry of the person or persons who manage the system, or those persons directly responsible for gathering the information, the information submitted is, to be the best of our knowledge and belief, true, accurate, and complete. We are aware that there are significant penalties for submitting false information, including the possibility of fine and imprisonment for knowing violations.

Stanley A. Heath 8-20-93
 Stanley A. Heath, Ph.D., Project/QA Manager Date
 ETAS Corporation

[Signature]
 T. Y. Richard Lo, P.E., Ph.D., Lead Engineer Date
 ETAS Corporation

James S. Kilburn, P.E. 8-23-93
 James S. Kilburn, P.E., Idaho Professional Engineer Date
 ETAS Corporation



ETAS

TABLE OF CONTENTS

	<u>Page</u>
CERTIFICATION	i
1.0 INTRODUCTION	1
2.0 CERTIFICATION TEAM	2
3.0 DESIGN ASSESSMENT	3
3.1 Description	3
3.1.1 Filter Handling Cell	3
3.1.2 Leaching Vessel	4
3.1.3 Drying Vessel	4
3.1.4 Filter Handling Table	4
3.1.5 Piping	5
3.2 Design	6
3.2.1 Regulatory Requirements	6
3.2.2 Structural Integrity Assessment	7
3.2.3 Secondary Containment Assessment	8
3.2.4 Summary of Assessment	10
4.0 CONDITIONS OF ATTESTATION	11
REFERENCES	
APPENDICES	
Appendix A: Pertinent Environmental Regulations	

1.0 INTRODUCTION

High efficiency particulate air (HEPA) filters used at the Idaho Chemical Processing Plant (ICPP) are stored after use in the cells where they are used. The HEPA Filter Leaching System located in the New Waste Calcining Facility (NWCF) (building CPP-659) at the ICPP was designed to leach transuranic elements, heavy metals, or both from the filters so that they can be disposed of at the Radioactive Waste Management Complex (RWMC) (Reference 1b). The filters are leached several times with heated nitric acid, followed by water washes and hot air drying. This project modifies the existing system to better meet the disposal criteria for the filters. System components include a leaching vessel, a drying vessel, associated piping and instrumentation, and the Filter Handling Cell (FHC) containing the system. Waste liquids from this system drain into vessels in a cell below the FHC.

The certification provided herein by ETAS is limited to the design of vessels and ancillary equipment being installed in the FHC, and the existing FHC stainless steel liner and drain line. The design of these components is assessed to ensure that the applicable standards and requirements of 40 CFR 265.192 and 40 CFR 265.193 are met. No certification of the adequacy of the design to meet the operating criteria is provided by ETAS. As the basis of this certification, this certification document provides signatures and statements of those persons providing the certification as specified in the applicable sections of the 40 CFR 265.192 and 40 CFR 270.11 (d).

2.0 CERTIFICATION TEAM

The ETAS certification team was composed of three qualified professionals. The Lead Engineer, Dr. T. Y. Richard Lo, is a registered professional engineer with 16 years of experience in hazardous waste and environmental engineering. He is responsible for the overall certification and attestation that under the conditions specified in this certification document the new piping system meets the requirements of 40 CFR 265. The Project Manager, Dr. Stanley A. Heath, has had 14 years experience in chemical plant operations and environmental compliance. He audited the pertinent documents to ensure veracity, for accurate and complete documentation, and for field checking that the work was well documented. Mr. James S. Kilburn is a registered Idaho professional engineer with over 40 years of engineering experience, much of it related to tank and piping systems. He reviewed the engineering design, provided other document and construction checking, and provided certification as per 40 CFR 265 and Idaho hazardous waste regulations.

3.0 DESIGN ASSESSMENT

3.1 Description

This project provides for improvements in the filter handling capabilities, more complete leaching of HEPA filter contaminants, improved filter drying, and adequate secondary containment. Operational aspects of the system are discussed in the project feasibility study (Reference 1a). Included in the modifications are a new filter leaching vessel, a new filter drying vessel, modifications to the filter handling table, and associated process, drain, and sample lines. All stainless steel materials used in this system are AISI Type 304L.

3.1.1 Filter Handling Cell

The Filter Handling Cell (FHC) houses the HEPA Filter Leaching System. The FHC is located in the Decontamination Area of the NWCF within the ICPP. The Decontamination Area consists of two adjoining cells, the Decontamination Cell and the Filter Handling Cell. The FHC is 16 by 20 feet by 19 feet high, with walls and ceiling of three foot thick reinforced concrete. The walls and floor are lined with stainless steel. A shielded window provides a view of the interior of the cell from the operating corridor (Reference 3).

Hatches located in the ceiling of the filter cell provide overhead access. Transfer of HEPA filters into the cell is done remotely using a crane to handle the filters and/or filter containers. Once in the cell, handling of the filters is done remotely using a pair of master/slave manipulators on the left and right sides of the window, an electro-mechanical PaR, and an overhead crane in the cell (Reference 3). The cell floor slopes toward a trench located on the east side of the cell and the trench slopes to the south to a drain.

The drain, where it penetrates the floor, is a double-walled pipe. The drain is routed to the decontamination hold-up tank, VES-NCD-123, or the decontamination collection tank, VES-NCD-129, located in a cell below the FHC.

3.1.2 Leaching Vessel

The leaching vessel, VES-NCD-141, is constructed of 3/8" thick 304L stainless steel, and is approximately 2'11" by 2'5" by 2'2" high, with a bottom sloping to a 1" drain line and a flat lid. Drawings 444397 and 444398 (Reference 2) show construction and design details, including the various nozzles for acid, water, and steam/air supply lines, instrument lines, and sample lines. The capacity is about 120 gallons. The vessel is equipped with a sparger in the bottom to improve leaching efficiency.

3.1.3 Drying Vessel

The drying vessel, VES-NCD-142, is constructed of 3/8" 304L stainless steel, and is approximately 2'11" by 2'5" by 1'4" high with a flat lid. The capacity is about 70 gallons. Drawings 444397 and 444399 (Reference 2) show internal and nozzle details.

3.1.4 Filter Handling Table

The filter handling table is used to hold the filters when they are not in the leaching or drying vessels. The filters are also placed on the table following leaching to allow excess liquid to drain from the filters prior to placement in the drying vessel. The existing table is constructed entirely of stainless steel with an open grating surface (Reference 1a). The table will be modified to include a drip pan of 14 gauge stainless steel under the open grating to provide collection of liquid draining from the filters. The drip pan is sloped to

a drain line at the low point. A splash guard between the leaching vessel and the filter handling table prevents spills during transfer of filters from vessel to table. Details are shown in drawings 444404 and 444405 (Reference 2).

3.1.5 Piping

Hazardous waste piping being installed includes vessel drain lines, sample lines, and an overflow line. Various other lines not carrying hazardous waste include air, nitric acid, steam, and water supply lines and vent lines from the two vessels. All lines in the FHC are constructed of stainless steel.

The drain line from the leaching vessel, 1 1/2" PL-AR-109033, is welded stainless steel, and is routed directly to the floor drain. The overflow line, 1" PL-AR-109010, also ties into the drain line, as does the 1" drain from the filter handling table drip pan. The drain line from the drying vessel, 1/2" PL-AR-155099 is also stainless steel and is routed directly to the floor drain.

Sample lines are 1/4" SST tubing and pipe. As shown in drawings 444390, 444391, 444392, and 444393, these lines are encased in stainless steel pipe when they exit the Filter Handling Cell.

Pipe supports in the FHC are constructed of stainless steel. The new supports, shown in drawing 444390, consist of SST channel welded to the floor, with pipes attached to welded supports by SST "U" bolts.

3.2 Design

The NWCF HEPA Filter Leaching System Modifications were designed by EG&G Idaho, Inc.. ETAS reviewed and evaluated the various design documents: Design criteria (Reference 1b), Feasibility Study (Reference 1a), A-E Performance Specification (Reference 1c), Stress Analysis (Reference 1e), Vessel Specification (Reference 1d), and the RCRA Part B Permit Application relevant to the existing building structure and cell lining (Reference 3). Based on the requirements and the guidelines set forth in 40 CFR 265.192 and 40 CFR 265.193, ETAS assessed the adequacy of the design of the NWCF Filter Leaching Modifications Project.

3.2.1 Regulatory Requirements

The regulatory requirements to ensure adequate design of tanks and components of hazardous waste tank systems are cited in environmental regulations 40 CFR 265.192 and 40 CFR 265.193. In general, the regulations set forth two sets of design requirements: one set pertains to the integrity of the primary systems and the other set pertains to secondary containment and leak detection. ETAS summarizes the pertinent requirements below. The regulations are included as Appendix A.

- A) Information that must be considered in the design assessment of system structural integrity and acceptability for storing or treating of hazardous waste:
 - a) Consideration of the design standards utilized;
 - b) Hazardous characteristics of the waste;
 - c) Adequacy of the tank foundations;
 - d) Ancillary equipment support.

Because no part of this system is located in the ground, requirements for consideration of corrosion protection, backfill, frost heave, or vehicular traffic are not relevant.

- B) Design requirements for secondary containment and detection of potential leaks:
- a) Satisfactory materials of construction must be used;
 - b) Secondary containment must be structurally sound, have an adequate foundation, have at least 100% of the capacity of the largest tank, and prevent infiltration;
 - c) A leak detection system to detect leaks within 24 hours;
 - d) A liquid removal system and/or an adequate slope in the system to remove liquid.

2.2 Structural Integrity Assessment

Design Standards: The general design standards are set forth in the design documents (Reference 1). These include various ASME, ANSI, ASTM, ASNT, and AWS standards. These standards ensure that the construction meets the requirements of ASME/ANSI B31.3 and NQA-1 for nuclear facilities as required by the DOE Idaho under DOE-ID Order 4700.1 and DOE-ID Order 5700.6c. ETAS also reviewed the extensive requirements set forth in the A-E Performance Specification (Reference 1c).

Hazardous Waste Characteristics: Compatibility of the materials of construction (304L stainless steel) and the waste solutions (nitric acid) have been considered in the RCRA Part B permit application (Reference 3), and more extensively in "Liner Compatibility Paper," by C.L. Porter of WINCO (Reference 4). These documents and the extensive experience at the ICPP with these materials provide assurance of material compatibility.

Adequacy of Tank Foundations:

The tank foundation design was checked for adequacy by P.J. Matonis (Reference 1e). This stress analysis included the tank supports, the piping and tubing installation, and piping supports. Based on the Natural Phenomena Classification (NPC) 4D, the static analyses were performed with earthquake coefficients developed from UBC-91.

Ancillary Equipment Support: As stated above, these stainless steel supports were included in the stress analysis performed by P.J. Matonis.

Other Considerations: The vessels in this system are designed for 0.5 psig maximum. Both vessels have a substantial flow of air or steam into the vessel at times. Adequate venting of these gases is provided via pipes 2" VG-AR-1009009 and 2" VG-AR-155100. The vessel lids are not secured to the vessels, and thus provide emergency pressure relief.

3.2.3 Secondary Containment Assessment

Materials of Construction: All secondary containment is constructed of 304L stainless steel. As noted above, this material is compatible with the waste solutions in the system.

Secondary Containment: The FHC stainless steel liner has a capacity of approximately 600 gallons, much greater than the capacity of the largest tank (120 gallons). This liner was installed when the facility was constructed. Documents indicate that the liner was installed in accordance to specification SP-453504-20-2, and that the welds were nondestructively examined for leakage by vacuum box and liquid penetrant techniques in 3/79 (Reference 3).

The cell is located in building CPP-659. The foundation for the liner is the floor of the cell. The floors of the building are of reinforced concrete and were designed to handle much larger tanks than are used in the filter leaching system. Groundwater infiltration into the building is prevented by coating below grade concrete surfaces with a waterproof bitumen, asphalt, or coal tar pitch. Construction joints in external walls and floor slabs have waterstops of continuous carbon steel strip with butt welded ends and corners (Reference 3).

The ancillary piping is also contained within the Filter Handling Cell, and is therefore secondarily contained by the cell liner. Where the sample lines exit the cell, they are encased in stainless steel pipes. This double-walled pipe containment extends through the Cell Entry and into the Valve Vault. This secondary containment piping is sloped to drain to the FHC for leak detection and removal. The other two new wall penetrations for the sample piping, from the Valve Vault to the Decon Pump Cell and from the Decon Pump Cell to the Decon Holding Tank Cell, are also sleeved by stainless steel pipe. They drain into these pre-existing cells, which have secondary containment, and leak detection and removal systems (Reference 3).

Leak Detection: Primary leak detection is by surveillance of the system during periods of operation. In addition, a level measuring device monitors the level within the leaching vessel to prevent overfilling. This level device would also detect any unplanned loss of fluid. Any spill within the cell drains to vessels in a lower cell. These vessels also have level measuring devices which would show an unplanned increase in the event of a significant loss in the filter handling cell. These vessels, VES-NCD-123, and VES-NCD-129, are much larger than the filter leaching vessel.

Leak Removal: The floor cell slopes to a trench on the east wall, and the trench slopes south to the drain. This double-walled pipe drains to large tanks in a lower cell. This lower cell also has a stainless steel liner (Reference 3).

3.2.4 Summary of Assessment

Based on the assessment described in 3.2.2, it is ETAS's opinion that the HEPA Filter Leaching System Modifications Project is designed to provide adequate structural integrity and is acceptable for the storing and treating of hazardous waste. According to Section 3.2.3, ETAS concludes that the design for handling potential leaks in the HEPA Filter Leaching System is satisfactory.

4.0 Conditions of Attestation

ETAS reviewed the documents listed in the References Section which pertain to the design of the NWCF HEPA Filter Leaching System Modifications Project and provided assessments as detailed in Section 3.0. These assessments are the basis for this certification. Excluded from this certification are pre-existing systems not specifically included in this report.

This certification includes only the design of the system, and not the installation. A second certification document will be provided for installation after all installation activities are complete.

ETAS's interpretation of the adequacy of the design is strictly based on environmental regulatory requirements, and this certification should not be construed as a warranty of the HEPA Filter Leaching System.

REFERENCES

1. Design and Specification Documents

- a) "Feasibility Study for Modifications to the NWCF Filter Leaching System," by Walter D. Willis, EG&G Idaho, Inc., March 1992.
- b) "Design Criteria for the Filter Leaching System Modifications Project," by T.H. Waite, April 1992.
- c) "A-E Performance Specification, Modifications to the HEPA Filter Leaching System at NWCF," by W.D. Willis, EG&G Idaho, Inc., January 29, 1993.
- d) "Specification for HEPA Filter Leaching and Drying Vessels VES-NCD-141 & VES-NDC-142," by W.D. Willis, EG&G Idaho, Inc., January 1993.
- e) "Stress Analysis for Modifications to CPP NWCF HEPA Filters Leach System-PJM-64-92," by P.J. Matonis, November 23, 1992.

2. Drawings

<u>Drawing No.</u>	<u>Drawing Description</u>
444385	Cover Sheet, Area Map and Site Map
444386	Drawing Index and Legends
444389	Process and Instrument Diagram
444390	Piping Plan
444391	Sample Lines Plan, Section and Details
444392	Piping Sections and Details
444393	Piping Sections
444394	Piping Details and Views

<u>Drawing No.</u>	<u>Drawing Description</u>
444397	VES-NCD-141 and VES-NCD-0142 Installation
444398	VES-NCD-141 Assembly
444399	VES-NCD-142 Assembly.
444400	VES-NCD-141 Details
444401	Spacer Block Details
444402	VES-NCD-141 Lid Cover
444403	VES-NCD-142 Lid Cover
444404	Filter Handling Table Drip Pan
444405	Filter Handling Table Drip Pan Installation
444406	Work Table Lid Stand and Drain Screen
444407	Valve Station Details
444411	Filter Handling Cell Plan - Installation

3. "RCRA Part B Permit Application for the Idaho National Engineering Laboratory, Volume 10, New Waste Calcining Facility HEPA Filter Leaching System, Section D, Process Information," July 1993.
4. "Liner Compatibility Paper," by C.L. Porter of WINCO.

APPENDIX A

PERTINENT ENVIRONMENTAL REGULATIONS

§ 265.192 Design and installation of new tank systems or components.

(a) Owners or operators of new tank systems or components must ensure that the foundation, structural support, seams, connections, and pressure controls (if applicable) are adequately designed and that the tank system has sufficient structural strength, compatibility with the waste(s) to be stored or treated, and corrosion protection so that it will not collapse, rupture, or fail. The owner or operator must obtain a written assessment, reviewed and certified by an independent, qualified, registered professional engineer, in accordance with Section 270.11(d) attesting that the system has sufficient structural integrity and is acceptable for the storing and treating of hazardous waste. The assessment must include, at a minimum, the following information:

- (1) Design standard(s) according to which the tank(s) and ancillary equipment is or will be constructed.
- (2) Hazardous characteristics of the waste(s) to be handled.
- (3) For new tank systems or components in which the external shell of a metal tank or any external metal component of the tank system is or will be in contact with the soil or with water, a determination by a corrosion expert of:

(i) Factors affecting the potential for corrosion, including but not limited to:

- (A) Soil moisture content;
- (B) Soil pH;
- (C) Soil sulfides level;
- (D) Soil resistivity;
- (E) Structure to soil potential;
- (F) Influence of nearby underground metal structures (e.g., piping);
- (G) Stray electric current; and
- (H) Existing corrosion-protection measures (e.g., coating, cathodic protection), and

(ii) The type and degree of external corrosion protection that are needed to ensure the integrity of the tank system during the use of the tank system or component, consisting of one or more of the following:

- (A) Corrosion-resistant materials of construction such as special alloys, fiberglass reinforced plastic;
- (B) Corrosion-resistant coating (such as epoxy, fiberglass) with cathodic protection (e.g., impressed current or sacrificial anodes); and
- (C) Electrical isolation devices such as insulating joints and flanges.

[Note: The practices described in the National Association of Corrosion Engineers (NACE) standard, "Recommended Practice (RP-02-85) - Control of External Corrosion on Metallic Buried, Partially Buried, or Submerged Liquid Storage Systems," and the American Petroleum Institute (API) Publication 1632, "Cathodic Protection of Underground Petroleum Storage Tanks and Piping Systems," may be used, where applicable, as guidelines in providing corrosion protection for tank systems.]

(4) For underground tank system components that are likely to be affected by vehicular traffic, a determination of design or operational measures that will protect the tank system against potential damage; and

(5) Design considerations to ensure that:

- (i) Tank foundations will maintain the load of a full tank;
- (ii) Tank systems will be anchored to prevent flotation or dislodgment where the tank system is placed in a saturated zone, or is located within a seismic fault zone; and
- (iii) Tank systems will withstand the effects of frost heave.

(b) The owner or operator of a new tank system must ensure that proper handling procedures are adhered to in order to prevent damage to the system during installation. Prior to covering, enclosing, or placing a new tank system or component in use, an independent, qualified installation inspector or an independent, qualified, registered professional engineer, either of whom is trained and experienced in the proper installation of tank systems, must inspect the system or component for the presence of any of the following items:

- (1) Weld breaks;
- (2) Punctures;
- (3) Scrapes of protective coatings;
- (4) Cracks;

(5) Corrosion;

(6) Other structural damage or inadequate construction or installation.

All discrepancies must be remedied before the tank system is covered, enclosed, or placed in use.

(c) New tank systems or components and piping that are placed underground and that are backfilled must be provided with a backfill material that is a noncorrosive, porous, homogeneous substance and that is carefully installed so that the backfill is placed completely around the tank and compacted to ensure that the tank and piping are fully and uniformly supported.

(d) All new tanks and ancillary equipment must be tested for tightness prior to being covered, enclosed or placed in use. If a tank system is found not to be tight, all repairs necessary to remedy the leak(s) in the system must be performed prior to the tank system being covered, enclosed, or placed in use.

(e) Ancillary equipment must be supported and protected against physical damage and excessive stress due to settlement, vibration, expansion or contraction.

[Note: The piping system installation procedures described in American Petroleum Institute (API) Publication 1615 (November 1979), "Installation of Underground Petroleum Storage Systems," or ANSI Standard B31.3, "Petroleum Refinery System," and ANSI Standard B31.4 "Liquid Petroleum Transportation Piping System," may be used, where applicable, as guidelines for proper installation of piping systems.]

(f) The owner or operator must provide the type and degree of corrosion protection necessary, based on the information provided under paragraph (2)(3) of this section, to ensure the integrity of the tank system during use of the tank system. The installation of a corrosion protection system that is field fabricated must be supervised by an independent corrosion expert to ensure proper installation.

(g) The owner or operator must obtain and keep on file at the facility written statements by those persons required to certify the design of the tank system and supervise the installation of the tank system in accordance with the requirements of paragraphs (b) through (f) of this section to attest that the tank system was properly designed and installed and that repairs, pursuant to paragraphs (b) and (d) of this section, were performed. These written statements must also include the certification statement as required in Section 270.11(d) of this chapter.

(Information collection requirements contained in paragraphs (a) and (g) were approved by the Office of Management and Budget under control number 2050-0050.)

[51 FR 25479, July 14, 1986, as amended at 51 FR 29430, August 15, 1986]

§ 265.193 Containment and detection of releases.

(a) In order to prevent the release of hazardous waste or hazardous constituents to the environment, secondary containment that meets the requirements of this section must be provided (except as provided in paragraphs (f) and (g) of this section):

- (1) For all new tank systems or components, prior to their being put into service;
- (2) For all existing tanks used to store or treat EPA Hazardous Waste Nos. F020, F021, F022, F023, F026, and F027, within two years after January 12, 1987;
- (3) For those existing tank systems of known and documentable age, within two years after January 12, 1987, or when the tank systems have reached 15 years of age, whichever comes later;
- (4) For those existing tank systems for which the age cannot be documented, within eight years of January 12, 1987; but if the age of the facility is greater than seven years, secondary containment must be provided by the time the facility reaches 15 years of age, or within two years of January 12, 1987, whichever comes later; and
- (5) For tank systems that store or treat materials that become hazardous wastes subsequent to January 12, 1987, within the time intervals required in paragraphs (a)(1) through (a)(4) of this section, except that the date that a material becomes a hazardous waste must be used in place of January 12, 1987.

(b) Secondary containment systems must be:

- (1) Designed, installed, and operated to prevent any migration of wastes or accumulated liquid out of the system to the soil, ground water, or surface water at any time during the use of the tank system; and
- (2) Capable of detecting and collecting releases and accumulated liquids until the collected material is removed.

(c) To meet the requirements of paragraph (b) of this section, secondary containment systems must be at a minimum:

- (1) Constructed of or lined with materials that are compatible with the waste(s) to be placed in the tank system and must have sufficient strength and thickness to prevent failure due to pressure gradients (including static head and external hydrological forces), physical contact with the waste to which they are exposed, climatic conditions, the stress of installation, and the stress of daily operation (including stresses from nearby vehicular traffic);
- (2) Placed on a foundation or base capable of providing support to the secondary containment system and resistance to pressure gradients above and below the system and capable of preventing failure due to settlement, compression, or uplift;
- (3) Provided with a leak-detection system that is designed and operated so that it will detect the failure of either the primary and secondary containment structure or any release of hazardous waste or accumulated liquid in the secondary containment system within 24 hours, or at the earliest practicable time if the existing detection technology or site conditions will not allow detection of a release within 24 hours;
- (4) Sloped or otherwise designed or operated to drain and remove liquids resulting from leaks, spills, or precipitation. Spilled or leaked waste and accumulated precipitation must be removed from the secondary containment system within 24 hours, or in as timely a manner as is possible to prevent harm to human health or the environment, if removal of the released waste or accumulated precipitation cannot be accomplished within 24 hours.

[Note: If the collected material is a hazardous waste under Part 261 of this chapter, it is subject to management as a hazardous waste in accordance with all applicable requirements of Parts 262 through 265 of this chapter. If the collected material is discharged through a point source to waters of the United States, it is subject to the requirements of sections 301, 304, and 402 of the Clean Water Act, as amended. If discharged to a Publicly Owned Treatment Works (POTWs), it is subject to the requirements of section 307 of the Clean Water Act, as amended. If the collected material is released to the environment, it may be subject to the reporting requirements of 40 CFR Part 302.]

(d) Secondary containment for tanks must include one or more of the following devices:

- (1) A liner (external to the tank);
- (2) A vault;
- (3) A double-walled tank; or
- (4) An equivalent device as approved by the Regional Administrator.

(e) In addition to the requirements of paragraphs (b), (c), and (d) of this section, secondary containment systems must satisfy the following requirements:

(1) External liner systems must be:

- (i) Designed or operated to contain 100 percent of the capacity of the largest tank within its boundary;
- (ii) Designed or operated to prevent run-on or infiltration of precipitation into the secondary containment system unless the collection system has sufficient excess capacity to contain run-on or infiltration. Such additional capacity must be sufficient excess capacity to contain precipitation from a 25-year, 24-hour rainfall event.
- (iii) Free of cracks or gaps; and
- (iv) Designed and installed to completely surround the tank and to cover all surrounding earth likely to come into contact with the waste if released from the tank(s) (i.e., capable of preventing lateral as well as vertical migration of the waste).

(2) Vault systems must be:

- (i) Designed or operated to contain 100 percent of the capacity of the largest tank within its boundary;
- (ii) Designed or operated to prevent run-on or infiltration of precipitation into the secondary containment system unless the collection system has sufficient excess capacity to contain run-on or infiltration. Such additional capacity must be sufficient to contain precipitation from a 25-year, 24-hour rainfall event;
- (iii) Constructed with chemical-resistant water stops in place at all joints (if any);
- (iv) Provided with an impermeable interior coating or lining that is compatible with the stored waste and that will prevent migration of waste into the concrete;
- (v) Provided with a means to protect against the formation of and ignition of vapors within the vault, if the waste being stored or treated:
 - (A) Meets the definition of ignitable waste under Section 262.21 of this chapter; or
 - (B) Meets the definition of reactive waste under Section 262.21 of this chapter and may form an ignitable or explosive vapor; and
- (vi) Provided with an exterior moisture barrier or be otherwise designed or operated to prevent migration of moisture into the vault if the vault is subject to hydraulic pressure.

(3) Double-walled tanks must be:

- (i) Designed as an integral structure (i.e., an inner tank within an outer shell) so that any release from the inner tank is contained by the outer shell;
- (ii) Protected, if constructed of metal, from both corrosion of the primary tank interior and the external surface of the outer shell; and
- (iii) Provided with a built-in, continuous leak detection system capable of detecting a release within 24 hours or at the earliest practicable time, if the owner or operator can demonstrate to the Regional Administrator, and the Regional Administrator concurs, that the existing leak detection technology or site conditions will not allow detection of a release within 24 hours.

[Note: The provisions outlined in the Steel Tank Institute's (STI) "Standard for Dual Wall Underground Steel Storage Tanks" may be used as guidelines for aspects of the design of underground steel double-walled tanks.]

(f) Ancillary equipment must be provided with full secondary containment (e.g., trench, jacketing, double-walled piping) that meets the requirements of paragraphs (b) and (c) of this section except for:

- (1) Aboveground piping (exclusive of flanges, joints, valves, and connections) that are visually inspected for leaks on a daily basis;
- (2) Welded flanges, welded joints, and welded connections that are visually inspected for leaks on a daily basis;
- (3) Sealless or magnetic coupling pumps and sealless valves, that are visually inspected for leaks on a daily basis; and
- (4) Pressurized aboveground piping systems with automatic shut-off devices (e.g., excess flow check valves, flow metering shutdown devices, loss of pressure actuated shut-off devices) that are visually inspected for leaks on a daily basis.

(g) The owner or operator may obtain a variance from the requirements of this Section if the Regional Administrator finds, as a result of a demonstration by the owner or operator, either: that alternative design and operating practices, together with location characteristics, will prevent the migration of hazardous waste or hazardous constituents into the ground water or surface water at least as effectively as secondary containment during the active life of the tank system or that in the event of a release that does migrate to ground water or surface water, no substantial present or potential hazard will be posed to human health or the environment. New underground tank systems may not, per a demonstration in accordance with paragraph (g)(2) of this section, be exempted from the secondary containment requirements of this section. Application for a variance as allowed in paragraph (g) of this section does not waive compliance with the requirements of this Subpart for new tank systems.

(1) In deciding whether to grant a variance based on a demonstration of equivalent protection of ground water and surface water, the Regional Administrator will consider:

- (i) The nature and quantity of the waste;
- (ii) The proposed alternate design and operation;
- (iii) The hydrogeologic setting of the facility, including the thickness of soils between the tank system and ground water; and
- (iv) All other factors that would influence the quality and mobility of the hazardous constituents and the potential for them to migrate to ground water or surface water.

(2) In deciding whether to grant a variance based on a demonstration of no substantial present or potential hazard, the Regional Administrator will consider:

- (i) The potential adverse effects on ground water, surface water, and land quality taking into account:
 - (A) The physical and chemical characteristics of the waste in the tank system, including its potential for migration,
 - (B) The hydrogeological characteristics of the facility and surrounding land,
 - (C) The potential for health risks caused by human exposure to waste constituents,
 - (D) The potential for damage to wildlife, crops, vegetation, and physical structures caused by exposure to waste constituents, and
 - (E) The persistence and permanence of the potential adverse effects;
- (ii) The potential adverse effects of a release on ground-water quality, taking into account:
 - (A) The quantity and quality of ground water and the direction of ground-water flow,
 - (B) The proximity and withdrawal rates of water in the area,
 - (C) The current and future uses of ground water in the area, and
 - (D) The existing quality of ground water, including other sources of contamination and their cumulative impact on the ground-water quality;
- (iii) The potential adverse effects of a release on surface water quality, taking into account:
 - (A) The quantity and quality of ground water and the direction of ground-water flow,
 - (B) The patterns of rainfall in the region,
 - (C) The proximity of the tank system to surface waters,
 - (D) The current and future uses of surface waters in the area and any water quality standards established for those surface waters, and
 - (E) The existing quality of surface water, including other sources of contamination and the cumulative impact on surface-water quality; and
- (iv) The potential adverse effects of a release on the land surrounding the tank system, taking into account:
 - (A) The patterns of rainfall in the region, and
 - (B) The current and future uses of the surrounding land.

(3) The owner or operator of a tank system, for which a variance from secondary containment had been granted in accordance with the requirements of paragraph (g)(1) of this section, at which a release of hazardous waste has occurred from the primary tank system but has not migrated beyond the zone of engineering control (as established in the variance), must:

(i) Comply with the requirements of Section 265.196, except paragraph (d), and

(ii) Decontaminate or remove contaminated soil to the extent necessary to:

(A) Enable the tank system, for which the variance was granted, to resume operation with the capability for the detection of and response to releases at least equivalent to the capability it had prior to the release, and

(B) Prevent the migration of hazardous waste or hazardous constituents to ground water or surface water, and

(iii) If contaminated soil cannot be removed or decontaminated in accordance with paragraph (g)(3)(ii) of this section, comply with the requirements of § 265.197(b).

(4) The owner or operator of a tank system, for which a variance from secondary containment had been granted in accordance with the requirements of paragraph (g)(1) of this section, at which a release of hazardous waste has occurred from the primary tank system and has migrated beyond the zone of engineering control (as established in the variance), must:

(i) Comply with the requirements of Section 265.196(a), (b), (c), and (d); and

(ii) Prevent the migration of hazardous waste or hazardous constituents to ground water or surface water, if possible, and decontaminate or remove contaminated soil. If contaminated soil cannot be decontaminated or removed, or if ground water has been contaminated, the owner or operator must comply with the requirements of Section 265.197(b);

(iii) If repairing, replacing, or reinstalling the tank system, provide secondary containment in accordance with the requirements of paragraphs (a) through (f) of this section or reapply for a variance from secondary containment and meet the requirements for new tank systems in Section 265.192 if the tank system is replaced. The owner or operator must comply with these requirements even if contaminated soil can be decontaminated or removed, and ground water or surface water has not been contaminated.

(b) The following procedures must be followed in order to request a variance from secondary containment:

(1) The Regional Administrator must be notified in writing by the owner or operator that he intends to conduct and submit a demonstration for a variance from secondary containment as allowed in paragraph (g) of this section according to the following schedule:

(i) For existing tank systems, at least 24 months prior to the date that secondary containment must be provided in accordance with paragraph (a) of this section; and

(ii) For new tank systems, at least 30 days prior to entering into a contract for installation of the tank system.

(2) As part of the notification, the owner or operator must also submit to the Regional Administrator a description of the steps necessary to conduct the demonstration and a timetable for completing each of the steps. The demonstration must address each of the factors listed in paragraph (g)(1) or paragraph (g)(2) of this section.

(3) The demonstration for a variance must be completed and submitted to the Regional Administrator within 180 days after notifying the Regional Administrator of intent to conduct the demonstration.

(4) The Regional Administrator will inform the public, through a newspaper notice, of the availability of the demonstration for a variance. The notice shall be placed in a daily or weekly major local newspaper of general circulation and shall provide at least 30 days from the date of the notice for the public to review and comment on the demonstration for a variance. The Regional Administrator also will hold a public hearing, in response to a request or at his own discretion, whenever such a hearing might clarify one or more issues concerning the demonstration for a variance. Public notice of the hearing will be given at least 30 days prior to the date of the hearing and may be given at the same time as notice of the opportunity for the public to review and comment on the demonstration. These two notices may be combined.

**HWMA/RCRA PART B PERMIT
FOR THE IDAHO NATIONAL LABORATORY**

Volume 18 – Idaho Nuclear Technology and Engineering Center

APPENDIX 8

**Debris Treatment Processes
Holdup and Collection Tanks
CPP-659/-1659 Storage
CPP-666 FDP Cell Container Storage and Slab Tank Storage
Other Miscellaneous Treatment Processes
RMWSF (CPP-1617) Container Storage Area**

PE ASSESSMENT OF INSTALLATION OF HFLS

Effective Date: April 27, 2009

**PRJ-LTCO.218
RPT-CERT.218**

**Certification Document for the
NWCF HEPA Filter Leaching System
Modifications Project**

**Idaho Chemical Processing Plant
Idaho National Engineering Laboratory
Idaho Falls, Idaho**

Submitted To:

Lockheed Idaho Technologies Company

April 28, 1995

**ETAS Corporation
8828 North Stemmons Freeway, Suite 413
Dallas, Texas 75247-3726
Tel (214) 630-6610 Fax (214) 630-7494**

CERTIFICATION DOCUMENT
FOR THE
NWCF HEPA FILTER LEACHING SYSTEM MODIFICATIONS PROJECT

Idaho Chemical Processing Plant
Idaho National Engineering Laboratory
Idaho Falls, Idaho

Prepared for:

Lockheed Idaho Technologies Company
Idaho Chemical Processing Plant
Idaho National Engineering Laboratory
Idaho Falls, Idaho

April 28, 1995

ETAS Corporation

CERTIFICATION FOR THE
NWCF HEPA FILTER LEACHING SYSTEM
MODIFICATIONS PROJECT
Idaho Chemical Processing Plant
Idaho National Engineering Laboratory
Idaho Falls, Idaho


The attached report entitled "Certification Document for the NWCF HEPA Filter Leaching System Modifications Project, Idaho Chemical Processing Plant, Idaho National Engineering Laboratory, Idaho Falls, Idaho", dated April 28, 1995, serves as the basis for this certification, which follows the guidance provided under both the Federal regulation 40 CFR 264.192, 264.193, 265.192 and 265.193, and the Idaho rules, regulations and standards for hazardous waste. We attest that the system has sufficient structural integrity and is acceptable for the storing and treating of hazardous waste. The certification provided herein by ETAS Corporation is limited to the work set forth in the certification document.

We certify under penalty of law that this document and all attachments were prepared under our direction or supervision in accordance with a system designed to assure that qualified personnel properly gather and evaluate the information submitted. Based on our inquiry of the person or persons who manage the system, or those persons directly responsible for gathering the information, the information submitted is, to be the best of our knowledge and belief, true, accurate, and complete. We are aware that there are significant penalties for submitting false information, including the possibility of fine and imprisonment for knowing violations.

Stanley A. Heath 4-28-95
Stanley A. Heath, Ph.D., Project/QA Manager Date
ETAS Corporation

T. Y. Richard Lo 4-28-95
T. Y. Richard Lo, P.E., Ph.D., Lead Engineer Date
ETAS Corporation

James S. Kilburn 5/1/95
James S. Kilburn, P.E., Idaho Professional Engineer Date
ETAS Corporation

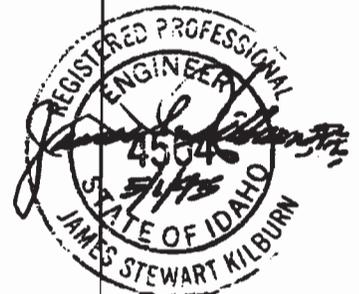

ETAS

TABLE OF CONTENTS

	<u>Page</u>
CERTIFICATION	i
1.0 Introduction	1
2.0 Certification Team	2
3.0 Design Assessment	3
3.1 Description	3
3.1.1 Filter Handling Cell	3
3.1.2 Leaching Vessel	4
3.1.3 Drying Vessel	4
3.1.4 Filter Handling Table	4
3.1.5 Piping	5
3.2 Design	6
3.2.1 Regulatory Requirements	6
3.2.2 Structural Integrity Assessment	7
3.2.3 Secondary Containment Assessment	8
3.2.4 Summary of Assessment	10
3.3 Installation and Inspection	
3.3.1 Regulatory Requirement	
3.3.2 Inspection and Inspection Protocols	
3.3.3 Qualifications of the Contractors	
3.3.4 Independent Inspection	
3.3.5 Inspection Surveillance	
3.3.6 Summary of Assessment	
4.0 Conditions of Attestation	11

REFERENCES

APPENDICES

- Appendix A: Pertinent Environmental Regulations
- Appendix B: Qualification of Contractors
- Appendix C: Certification Records of Welders and Inspectors

1.0 INTRODUCTION

High efficiency particulate air (HEPA) filters used at the Idaho Chemical Processing Plant (ICPP) are stored after use in the cells where they are used. The HEPA Filter Leaching System located in the New Waste Calcining Facility (NWCF) (building CPP-659) at the ICPP was designed to leach transuranic elements and/or heavy metals from the filters so that the filters can be disposed of at the Radioactive Waste Management Complex (RWMC) (Reference 1b). The filters are leached several times with heated nitric acid, followed by water washes and hot air drying. This project modifies the existing system to better meet the disposal criteria for the filters and improve system operability. System components include a leaching vessel, a drying vessel, associated piping and instrumentation, and the Filter Handling Cell (FHC) containing the system. Waste liquids from this system drain into vessels in another cell.

The certification provided herein by ETAS is limited to the design of vessels and ancillary equipment being installed in the FHC, and the existing FHC stainless steel liner and drain line. The design of these components is assessed to ensure that the applicable standards and requirements of 40 CFR 264.192 and 265.192 and 40 CFR 264.193 and 265.193 are met. No certification of the adequacy of the design to meet the operating criteria is provided by ETAS. As the basis of this certification, this certification document provides signatures and statements of those persons providing the certification as specified in the applicable sections of the 40 CFR 264.192 and 265.192 and 40 CFR 270.11 (d).

2.0 CERTIFICATION TEAM

The ETAS certification team was composed of three qualified professionals. The Lead Engineer, Dr. T. Y. Richard Lo, is a registered professional engineer with 16 years of experience in hazardous waste and environmental engineering. He is responsible for the overall certification and attestation that under the conditions specified in this certification document the new piping system meets the requirements of 40 CFR 264 and 265. The Project Manager, Dr. Stanley A. Heath, has had 14 years experience in chemical plant operations and environmental compliance. He audited the pertinent documents to ensure veracity, for accurate and complete documentation, and for field checking that the work was well documented. Mr. James S. Kilburn is a registered Idaho professional engineer with over 40 years of engineering experience, much of it related to tank and piping systems. He reviewed the engineering design, provided other document and construction checking, and provided certification as per 40 CFR 264 and 265 and Idaho hazardous waste regulations.

3.0 DESIGN ASSESSMENT

3.1 Description

This project provides for improvements in the filter handling capabilities, more complete leaching of HEPA filter contaminants, improved filter drying, and adequate secondary containment. Operational aspects of the system are discussed in the project feasibility study (Reference 1a). Included in the modifications are a new filter leaching vessel, a new filter drying vessel, modifications to the filter handling table, and associated process, drain, and sample lines. All stainless steel materials used in this system are type 304L.

3.1.1 Filter Handling Cell

The Filter Handling Cell (FHC) houses the HEPA Filter Leaching System. The FHC is located in the Decontamination Area of the NWCF within the ICPP. The Decontamination Area consists of two adjoining cells, the Decontamination Cell and the Filter Handling Cell. The FHC is 16 by 20 feet by 19 feet high, with walls and ceiling of three foot thick reinforced concrete. The walls and floor are lined with stainless steel. A shielded window provides a view of the interior of the cell from the operating corridor (Reference 3).

Hatches located in the ceiling of the filter cell provide overhead access. Transfer of HEPA filters into the cell is done remotely using a crane to handle the filters and/or filter containers. Once in the cell, handling of the filters is done remotely using a pair of master/slave manipulators on the left and right sides of the window, an electro-mechanical PaR, and an overhead crane in the cell (Reference 3). The cell floor slopes toward a trench located on the east side of the cell and the trench slopes to the south to a drain.

The drain, where it penetrates the floor, is a double-walled pipe. The drain is routed to the decontamination hold-up tank, VES-NCD-123, or the decontamination collection tank, VES-NCD-129, located in a cell below the FHC.

3.1.2 Leaching Vessel

The leaching vessel, VES-NCD-141, is constructed of 3/8" thick 304L stainless steel, and is approximately 2'11" by 2'5" by 2'2" high, with a bottom sloping to a 1" drain line and a flat lid. Drawings 444397 and 444398 (Reference 2) show construction and design details, including the various nozzles for acid, water, and steam/air supply lines, instrument lines, and sample lines. The capacity is about 120 gallons. The vessel is equipped with a sparger in the bottom to improve leaching efficiency.

3.1.3 Drying Vessel

The drying vessel, VES-NCD-142, is constructed of 3/8" 304L stainless steel, and is approximately 2'11" by 2'5" by 1'4" high with a flat lid. The capacity is about 70 gallons. Drawings 444397 and 444399 (Reference 2) show internal and nozzle details.

3.1.4 Filter Handling Table

The filter handling table is used to hold the filters when they are not in the leaching or drying vessels. The filters are also placed on the table following leaching to allow excess liquid to drain from the filters prior to placement in the drying vessel. The existing table is constructed entirely of stainless steel with an open grating surface (Reference 1a). The table was modified to include a drip pan of 14 gauge stainless steel under the open grating to provide collection of liquid draining from the filters. The drip pan is sloped to a drain

line at the low point. A splash guard between the leaching vessel and the filter handling table prevents spills during transfer of filters from vessel to table. Details are shown in drawings 444404 and 444405 (Reference 2).

3.1.5 Piping

Hazardous waste piping being installed includes vessel drain lines, sample lines, and an overflow line. Various other lines not carrying hazardous waste include air, nitric acid, steam, and water supply lines and vent lines from the two vessels. All lines in the FHC are constructed of stainless steel.

The drain line from the leaching vessel, 1 1/2" PL-AR-109033, is welded stainless steel, and is routed directly to the floor drain. The overflow line, 1" PL-AR-109010, also ties into the drain line, as does the 1" drain from the filter handling table drip pan. The drain line from the drying vessel, 1/2" PL-AR-155099, is also stainless steel and is routed directly to the floor drain.

Sample lines are 1/4" SST tubing and pipe. As shown in drawings 444390, 444391, 444392, and 444393, these lines are encased in stainless steel pipe where they exit the Filter Handling Cell.

Pipe supports in the FHC are constructed of stainless steel. The new supports, shown in drawing 444390, consist of SST channel welded to the floor, with pipes attached to welded supports by SST "U" bolts.

3.2 Design

The NWCF HEPA Filter Leaching System Modifications were designed by EG&G Idaho, Inc.. ETAS reviewed and evaluated the various design documents: Design criteria (Reference 1b), Feasibility Study (Reference 1a), A-E Performance Specification (Reference 1c), Stress Analysis (Reference 1e), Vessel Specification (Reference 1d), and the RCRA Part B Permit Application relevant to the existing building structure and cell lining (Reference 3). Based on the requirements and the guidelines set forth in 40 CFR 264.192 and 265.192 and 40 CFR 264.193 and 265.193, ETAS assessed the adequacy of the design of the NWCF Filter Leaching Modifications Project.

3.2.1 Regulatory Requirements

The regulatory requirements to ensure adequate design of tanks and components of hazardous waste tank systems are cited in environmental regulations 40 CFR 264.192 and 265.192 and 40 CFR 264.193 and 265.193. In general, the regulations set forth two sets of design requirements: one set pertains to the integrity of the primary systems and the other set pertains to secondary containment and leak detection. ETAS summarizes the pertinent requirements below. The regulations are included as Appendix A.

- A) Information that must be considered in the design assessment of system structural integrity and acceptability for storing or treating of hazardous waste:
 - a) Consideration of the design standards utilized;
 - b) Hazardous characteristics of the waste;
 - c) Adequacy of the tank foundations;
 - d) Ancillary equipment support.

Because no part of this system is located in the ground, requirements for consideration of corrosion protection, backfill, frost heave, or vehicular traffic are not relevant.

- B) Design requirements for secondary containment and detection of potential leaks:
- a) Satisfactory materials of construction must be used;
 - b) Secondary containment must be structurally sound, have an adequate foundation, have at least 100% of the capacity of the largest tank, and prevent infiltration;
 - c) A leak detection system to detect leaks within 24 hours;
 - d) A liquid removal system and/or an adequate slope in the system to remove liquid.

3.2.2 Structural Integrity Assessment

Design Standards: The general design standards are set forth in the design documents (Reference 1). These include various ASME, ANSI, ASTM, ASNT, and AWS standards. These standards ensure that the construction meets the requirements of ASME/ANSI B31.3 and NQA-1 for nuclear facilities as required by the DOE Idaho under DOE-ID Order 4700.1 and DOE-ID Order 5700.6c. ETAS also reviewed the extensive requirements set forth in the A-E Performance Specification (Reference 1c).

Hazardous Waste Characteristics: Compatibility of the materials of construction (304L stainless steel) and the waste solutions (nitric acid) have been considered in the RCRA Part B permit application (Reference 3), and more extensively in "Liner Compatibility Paper," by C.L. Porter of WINCO (Reference 4). These documents and the extensive experience at the ICPP with these materials provide assurance of material compatibility.

Adequacy of Tank Foundations:

The tank foundation design was checked for adequacy by P.J. Matonis (Reference 1e). This stress analysis included the tank supports, the piping and tubing installation, and piping supports. Based on the Natural Phenomena Classification (NPC) 4D, the static analyses were performed with earthquake coefficients developed from UBC-91.

Ancillary Equipment Support: As stated above, these stainless steel supports were included in the stress analysis performed by P.J. Matonis.

Other Considerations: The vessels in this system are designed for 0.5 psig maximum. Both vessels have a substantial flow of air or steam into the vessel at times. Adequate venting of these gases is provided via pipes 2" VG-AR-1009009 and 2" VG-AR-155100. The vessel lids are not secured to the vessels, and thus provide emergency pressure relief.

3.2.3 Secondary Containment Assessment

Materials of Construction: All secondary containment is constructed of 304L stainless steel. As noted above, this material is compatible with the waste solutions in the system.

Secondary Containment: The FHC stainless steel liner has a capacity of approximately 600 gallons, much greater than the capacity of the largest tank (120 gallons). This liner was installed when the facility was constructed. Documents indicate that the liner was installed in accordance to specification SP-453504-20-2, and that the welds were nondestructively examined for leakage by vacuum box and liquid penetrant techniques in 3/79 (Reference 3). These welds were also inspected by LITCO in 1995 according to Quality Inspection Plan No. 9425-S-4 (Reference 5b) and found to be sound.

The cell is located in building CPP-659. The foundation for the liner is the floor of the cell. The floors of the building are of reinforced concrete and were designed to handle much larger tanks than are used in the filter leaching system. Groundwater infiltration into the building is prevented by coating below grade concrete surfaces with a waterproof bitumen, asphalt, or coal tar pitch. Construction joints in external walls and floor slabs have waterstops of continuous carbon steel strip with butt welded ends and corners (Reference 3).

The ancillary piping is also contained within the Filter Handling Cell, and is therefore secondarily contained by the cell liner. Where the sample lines exit the cell, they are encased in stainless steel pipes. This double-walled pipe containment extends through the Cell Entry and into the Valve Vault. This secondary containment piping is sloped to drain to the FHC for leak detection and removal. The other two new wall penetrations for the sample piping, from the Valve Vault to the Decon Pump Cell and from the Decon Pump Cell to the Decon Holding Tank Cell, are also sleeved by stainless steel pipe. They drain into these pre-existing cells, which have secondary containment, and leak detection and removal systems (Reference 3).

Leak Detection: Primary leak detection is by surveillance of the system during periods of operation. In addition, a level measuring device monitors the level within the leaching vessel to prevent overfilling. This level device would also detect any unplanned loss of fluid. Any spill within the cell drains to vessels in a lower cell. These vessels also have level measuring devices which would show an unplanned increase in the event of a significant loss in the filter handling cell. These vessels, VES-NCD-123, and VES-NCD-129, are much larger than the filter leaching vessel.

Leak Removal: The floor cell slopes to a trench on the east wall, and the trench slopes south to the drain. This double-walled pipe drains to large tanks in a lower cell. This lower cell also has a stainless steel liner (Reference 3).

3.2.4 Summary of Assessment

Based on the assessment described in 3.2.2, it is ETAS's opinion that the HEPA Filter Leaching System Modifications Project is designed to provide adequate structural integrity and is acceptable for the storing and treating of hazardous waste.. According to Section 3.2.3, ETAS concludes that the design for handling potential leaks in the HEPA Filter Leaching System is satisfactory.

3.3 Installation and Inspection

To ensure proper installation of the system, ETAS:

- 1) Evaluated the adequacy of the installation and inspection protocols,
- 2) Reviewed the qualifications of the constructors,
- 3) Examined installation and inspection records, and
- 4) Provided surveillance of inspection and installation activities, and witnessed the results of S.O. testing.

Based on the regulatory requirements and guidelines set forth in regulation 40 CFR 264.192 and 265.192, ETAS assessed the adequacy of the installation of the HEPA Filter Leaching System Modification Project.

3.3.1 Regulatory Requirements

The applicable regulatory requirements to ensure proper installation of new tank system components are cited in 40 CFR 264.192(b) – (f) (Appendix A) and 265.192(b) – (f).

These regulations require that systems be inspected to detect:

- 1) weld breaks;
- 2) punctures;
- 3) cracks;
- 4) corrosion;
- 5) other structural damage or inadequate construction of installation;
- 6) tightness testing prior to service;
- 7) protection against physical damage.

Sections of the regulation concerning underground installations do not apply to this project.

3.3.2 Installation and Inspection Protocols

LITCO's installation and inspection protocols are defined in various Quality Engineering Inspection Plans (Reference 5b). These protocols incorporate the quality assurance standards set forth in Quality Program Plan, QPP 332 (Reference 5a), which were developed to meet the National Quality Assurance Standards NQA-1 as required by the

DOE Idaho under DOE-ID Order 4700.1 and DOE-ID Order 5700.6c. Although the U.S. Environmental Protection Agency (USEPA) does not set any specific assurance standards for the installation and inspection of tanks and piping system, it is ETAS's professional judgment that the NQA-1 standard will ensure that the designs discussed in Sections 3.2.2 and 3.2.3 are properly installed and meet the requirements of 40 CFR 264.192 and 265.192.

ETAS assessed LITCO's installation and inspection protocols (Reference 5b), which include vessel construction, installation of piping and vessels, receipt of materials, and welding. These plans were reviewed and approved by LITCO's Project Engineer, Mr. T.H. Waite. Based on this assessment, ETAS concludes that LITCO's installation and inspection protocols are adequate.

3.3.3 Qualifications of the Contractors

Construction management of all installations was provided by Lockheed Idaho Technologies Company, a construction management company approved by the Department of Energy (DOE). Dynamics Incorporated was the general and mechanical contractor, and was responsible for proper completion of all work. Based on the qualifications of this company (Appendix B) and a review of the certification records of the welders (Appendix C), ETAS concludes that the installation was performed by a qualified contractor.

3.3.4 Independent Inspection

To ensure that the installation was implemented in accordance with the installation and inspection protocols set forth in section 3.3.2, LITCO assigned their own Quality Control Engineers and Inspectors overall responsibility for inspection. ETAS's Quality Assurance Manager, Stanley Heath, examined LITCO's inspection records (Reference 5b), LITCO's inspector qualifications (Appendix C), observed various inspection activities (see section 3.3.5), and concluded that the inspections were done in accordance with the inspection plans.

3.3.5 Inspection Surveillance

Dr. Stanley A. Heath, ETAS's Quality Assurance Manager, observed various aspects of the construction and quality assurance inspection of the "NWCF HEPA Filter Leaching System Modifications Project". On January 10, 1995, he reviewed weld records for off-site piping at Dynamics Inc. shop, on-site weld records, and observed construction in progress in the cell. On March 28, 1995, he observed the S.O. test, including the transfer of a filter from the leaching vessel to the filter handling table.

3.3.6 Summary of Assessment

ETAS reviewed the installation and inspection protocols; reviewed the qualifications of contractors, welders and inspectors; examined pertinent inspection records; witnessed various construction and quality assurance activities; reviewed the S.O. test plan; and witnessed the S.O. test. ETAS concludes that the installation and inspection protocols were adequate and were implemented satisfactorily. Based on this assessment, ETAS concludes that the "NWCF HEPA Filter Leaching System Modifications Project" was installed properly and meets the regulatory requirements of 40 CFR 264.192, 264.193, 265.192 and 265.193.

4.0 Conditions of Attestation

ETAS reviewed the documents listed in the References Section which pertain to the design and installation of the NWCF HEPA Filter Leaching System Modifications Project and provided assessments as detailed in Section 3.0. These assessments are the basis for this certification. Excluded from this certification are pre-existing systems not specifically included in this report.

ETAS's interpretation of the adequacy of the design and installation is strictly based on environmental regulatory requirements, and this certification should not be construed as a warranty of the HEPA Filter Leaching System.

REFERENCES

1. Design and Specification Documents

- a) "Feasibility Study for Modifications to the NWCF Filter Leaching System," by Walter D. Willis, EG&G Idaho, Inc., March 1992.
- b) "Design Criteria for the Filter Leaching System Modifications Project," by T.H. Waite, April 1992.
- c) "A-E Performance Specification, Modifications to the HEPA Filter Leaching System at NWCF," by W.D. Willis, EG&G Idaho, Inc., January 29, 1993.
- d) "Specification for HEPA Filter Leaching and Drying Vessels VES-NCD-141 & VES-NDC-142," by W.D. Willis, EG&G Idaho, Inc., January 1993.
- e) "Stress Analysis for Modifications to CPP NWCF HEPA Filters Leach System-PJM-64-92," by P.J. Matonis, November 23, 1992.
- f) "HEPA Filter Leach Vessel - Design Calculations", by Richard K. Shogren & Associates, February 22, 1994.
- g) "CID Number 10 - Filter Leach System Mods", by T. Waite, October 18, 1994.

2. Drawings

<u>Drawing No.</u>	<u>Drawing Description</u>
444385	Cover Sheet, Area Map and Site Map
444386	Drawing Index and Legends
444389	Process and Instrument Diagram
444390	Piping Plan
444391	Sample Lines Plan, Section and Details
444392	Piping Sections and Details
444393	Piping Sections
444394	Piping Details and Views

<u>Drawing No.</u>	<u>Drawing Description</u>
444397	VES-NCD-141 and VES-NCD-0142 Installation
444398	VES-NCD-141 Assembly
444399	VES-NCD-142 Assembly.
444400	VES-NCD-141 Details
444401	Spacer Block Details
444402	VES-NCD-141 Lid Cover
444403	VES-NCD-142 Lid Cover
444404	Filter Handling Table Drip Pan
444405	Filter Handling Table Drip Pan Installation
444406	Work Table Lid Stand and Drain Screen
444407	Valve Station Details
444411	Filter Handling Cell Plan - Installation

3. "RCRA Part B Permit Application for the Idaho National Engineering Laboratory, Volume 10, New Waste Calcining Facility HEPA Filter Leaching System, Section D, Process Information, " July 1993.
4. "Liner Compatibility Paper," by C.L. Porter of WINCO.
5. Quality Assurance Documents
 - a) "QPP 332, Quality Program Plan for the Spent Filter Handling Project", by W.A. Waterson, March 9, 1992.

b) Quality Inspection Plans

<u>Plan No.</u>	<u>Description</u>
9425-P-1	Piping Inspection - Normal/Basic Service
9425-P-4	Drip Pan
9425-P-5	Piping Inspection - Normal/Basic Service - Off-site
9425-P-6	Vessel Inspection - (141) Piping
9425-P-7	Vessel (141)
9425-S-1	Structural Weld Inspection
9425-S-2	Drip Plan (off-site)
9425-S-3	Structural Weld Inspection (off-site)
9425-S-4	Weld Inspection in the Filter Handling Cell - Floor Liner
9425-R-2	Receipt Inspection - Off-site

- c) "SO and Integrated Test Procedure No. NWCF-NCD-SO-FL1, Filter Leaching System in NWCF", by C.A. Sanchez, November 10, 1994.

Appendix A
Pertinent Environmental Regulations

RCRA
77, 117**§ 264.191 Assessment of existing tank system's integrity.**

(a) For each existing tank system that does not have secondary containment meeting the requirements of § 264.193, the owner or operator must determine that the tank system is not leaking or is unfit for use. Except as provided in paragraph (c) of this section, the owner or operator must obtain and keep on file at the facility a written assessment reviewed and certified by an independent, qualified registered professional engineer, in accordance with § 270.11(d), that attests to the tank system's integrity by January 12, 1988.

(b) This assessment must determine that the tank system is adequately designed and has sufficient structural strength and compatibility with the waste(s) to be stored or treated, to ensure that it will not collapse, rupture, or fail. At a minimum, this assessment must consider the following:

- (1) Design standard(s), if available, according to which the tank and ancillary equipment were constructed;
- (2) Hazardous characteristics of the waste(s) that have been and will be handled;
- (3) Existing corrosion protection measures;
- (4) Documented age of the tank system, if available (otherwise, an estimate of the age); and
- (5) Results of a leak test, internal inspection, or other tank integrity examination such that:
 - (i) For non-enterable underground tanks, the assessment must include a leak test that is capable of taking into account the effects of temperature variations, tank end deflection, vapor pockets, and high water table effects, and
 - (ii) For other than non-enterable underground tanks and for ancillary equipment, this assessment must include either a leak test, as described above, or other integrity examination, that is certified by an independent, qualified, registered professional engineer in accordance with § 270.11(d), that addresses cracks, leaks, corrosion, and erosion.

[Note: The practices described in the American Petroleum Institute (API) Publication, Guide for Inspection of Refinery Equipment, Chapter XIII, "Atmospheric and Low-Pressure Storage Tanks," 4th edition, 1981, may be used, where applicable, as guidelines in conducting other than a leak test.]

(c) Tank systems that store or treat materials that become hazardous wastes subsequent to July 14, 1986, must conduct this assessment within 12 months after the date that the waste becomes a hazardous waste.

(d) If, as a result of the assessment conducted in accordance with paragraph (a), a tank system is found to be leaking or unfit for use, the owner or operator must comply with the requirements of § 264.196.

[51 FR 25472, July 14, 1986, as amended at 51 FR 29430, Aug. 15, 1986]

RCRA
167**§ 264.192 Design and installation of new tank systems or components.**

(a) Owners or operators of new tank systems or components must obtain and submit to the Regional Administrator, at time of submittal of Part B information, a written assessment, reviewed and certified by an independent, qualified registered professional engineer, in accordance with § 270.11(d), attesting that the tank system has sufficient structural integrity and is acceptable for the storing and treating of hazardous waste. The assessment must show that the foundation, structural support, seams, connections, and pressure controls (if applicable) are adequately designed and that the tank system has sufficient structural strength, compatibility with the waste(s) to be stored or treated, and corrosion protection to ensure that it will not collapse, rupture, or fail. This assessment, which will be used by the Regional Administrator to review and approve or disapprove the acceptability of the tank system design, must include, at a minimum, the following information:

- (1) Design standard(s) according to which tank(s) and/or the ancillary equipment are constructed;
- (2) Hazardous characteristics of the waste(s) to be handled;
- (3) For new tank systems or components in which the external shell of a metal tank or any external metal component of the tank system will be in contact with the soil or with water, a determination by a corrosion expert of:
 - (i) Factors affecting the potential for corrosion, including but not limited to:
 - (A) Soil moisture content;
 - (B) Soil pH;
 - (C) Soil sulfides level;
 - (D) Soil resistivity;
 - (E) Structure to soil potential;

- (F) Influence of nearby underground metal structures (e.g., piping);
- (G) Existence of stray electric current;
- (H) Existing corrosion-protection measures (e.g., coating, cathodic protection), and
- (ii) The type and degree of external corrosion protection that are needed to ensure the integrity of the tank system during the use of the tank system or component, consisting of one or more of the following:
 - (A) Corrosion-resistant materials of construction such as special alloys, fiberglass reinforced plastic, etc.;
 - (B) Corrosion-resistant coating (such as epoxy, fiberglass, etc.) with cathodic protection (e.g., impressed current or sacrificial anodes); and
 - (C) Electrical isolation devices such as insulating joints, flanges, etc.

[Note: The practices described in the National Association of Corrosion Engineers (NACE) standard, "Recommended Practice (RP-02-85)—Control of External Corrosion on Metallic Buried, Partially Buried, or Submerged Liquid Storage Systems," and the American Petroleum Institute (API) Publication 1632, "Cathodic Protection of Underground Petroleum Storage Tanks and Piping Systems," may be used, where applicable, as guidelines in providing corrosion protection for tank systems.]

(4) For underground tank system components that are likely to be adversely affected by vehicular traffic, a determination of design or operational measures that will protect the tank system against potential damage; and

(5) Design considerations to ensure that:

- (i) Tank foundations will maintain the load of a full tank;
- (ii) Tank systems will be anchored to prevent flotation or dislodgment where the tank system is placed in a saturated zone, or is located within a seismic fault zone subject to the standards of § 264.18(a); and
- (iii) Tank systems will withstand the effects of frost heave.

(b) The owner or operator of a new tank system must ensure that proper handling procedures are adhered to in order to prevent damage to the system during installation. Prior to covering, enclosing, or placing a new tank system or component in use, an independent, qualified installation inspector or an independent, qualified, registered professional engineer, either of whom is trained and experienced in the proper installation of tank systems or components, must inspect the system for the presence of the following items:

- (1) Weld breaks;
- (2) Punctures;
- (3) Scrapes of protective coatings;
- (4) Cracks;
- (5) Corrosion;
- (6) Other structural damage or inadequate construction/installation.

All discrepancies must be remedied before the tank system is covered, enclosed, or placed in use.

(c) New tank systems or components that are placed underground and that are backfilled must be provided with a backfill material that is a noncorrosive, porous, homogeneous substance and that is installed so that the backfill is placed completely around the tank and compacted to ensure that the tank and piping are fully and uniformly supported.

(d) All new tanks and ancillary equipment must be tested for tightness prior to being covered, enclosed, or placed in use. If a tank system is found not to be tight, all repairs necessary to remedy the leak(s) in the system must be performed prior to the tank system being covered, enclosed, or placed into use.

(e) Ancillary equipment must be supported and protected against physical damage and excessive stress due to settlement, vibration, expansion, or contraction.

[Note: The piping system installation procedures described in American Petroleum Institute (API) Publication 1615 (November 1979), "Installation of Underground Petroleum Storage Systems," or ANSI Standard B31.3, "Petroleum Refinery Piping," and ANSI Standard B31.4 "Liquid Petroleum Transportation Piping System," may be used, where applicable, as guidelines for proper installation of piping systems.]

(f) The owner or operator must provide the type and degree of corrosion protection recommended by an independent corrosion expert, based on the information provided under paragraph (a)(3) of this section, or other corrosion protection if the Regional Administrator believes other corrosion protection is necessary to ensure the integrity of the tank system during use of the tank system. The installation of a corrosion protection system that is field fabricated must be supervised by an independent corrosion expert to ensure proper installation.

(g) The owner or operator must obtain and keep on file at the facility written statements by those persons required to certify the design of the tank system and supervise the installation of the tank system in accordance with the requirements of paragraphs (b) through (f) of this section, that attest that the tank system was properly designed and installed and that repairs, pursuant to paragraphs (b) and (d) of this section, were performed. These written statements must also include the certification statement as required in § 270.11(d) of this Chapter.

[51 FR 25472, July 14, 1986, as amended at 51 FR 29430, Aug. 15, 1986]

§ 264.193 Containment and detection of releases.

(a) In order to prevent the release of hazardous waste or hazardous constituents to the environment, secondary containment that meets the requirements of this section must be provided (except as provided in paragraphs (f) and (g) of this section):

- (1) For all new tank systems or components, prior to their being put into service;
- (2) For all existing tank systems used to store or treat EPA Hazardous Waste Nos. F020, F021, F022, F023, F026, and F027, within two years after January 12, 1987;
- (3) For those existing tank systems of known and documented age, within two years after January 12, 1987 or when the tank system has reached 15 years of age, whichever comes later;
- (4) For those existing tank systems for which the age cannot be documented, within eight years of January 12, 1987; but if the age of the facility is greater than seven years, secondary containment must be provided by the time the facility reaches 15 years of age, or within two years of January 12, 1987, whichever comes later; and
- (5) For tank systems that store or treat materials that become hazardous wastes subsequent to January 12, 1987, within the time intervals required in paragraphs (a)(1) through (a)(4) of this section, except that the date that a material becomes a hazardous waste must be used in place of January 12, 1987.

(b) Secondary containment systems must be:

- (1) Designed, installed, and operated to prevent any migration of wastes or accumulated liquid out of the system to the soil, ground water, or surface water at any time during the use of the tank system; and
- (2) Capable of detecting and collecting releases and accumulated liquids until the collected material is removed.

(c) To meet the requirements of paragraph (b) of this section, secondary containment systems must be at a minimum:

- (1) Constructed of or lined with materials that are compatible with the waste(s) to be placed in the tank system and must have sufficient strength and thickness to prevent failure owing to pressure gradients (including static head and external hydrological forces), physical contact with the waste to which it is exposed, climatic conditions, and the stress of daily operation (including stresses from nearby vehicular traffic).
- (2) Placed on a foundation or base capable of providing support to the secondary containment system, resistance to pressure gradients above and below the system, and capable of preventing failure due to settlement, compression, or uplift;
- (3) Provided with a leak-detection system that is designed and operated so that it will detect the failure of either the primary or secondary containment structure or the presence of any release of hazardous waste or accumulated liquid in the secondary containment system within 24 hours, or at the earliest practicable time if the owner or operator can demonstrate to the Regional Administrator that existing detection technologies or site conditions will not allow detection of a release within 24 hours; and
- (4) Sloped or otherwise designed or operated to drain and remove liquids resulting from leaks, spills, or precipitation. Spilled or leaked waste and accumulated precipitation must be removed from the secondary containment system within 24 hours, or in as timely a manner as is possible to prevent harm to human health and the environment, if the owner or operator can demonstrate to the Regional Administrator that removal of the released waste or accumulated precipitation cannot be accomplished within 24 hours.

[Note: If the collected material is a hazardous waste under Part 261 of this chapter, it is subject to management as a hazardous waste in accordance with all applicable requirements of Parts 262 through 265 of this chapter. If the collected material is discharged through a point source to waters of the United States, it is subject to the requirements of sections 301, 304, and 402 of the Clean Water Act, as amended. If discharged to a Publicly Owned Treatment Works (POTW), it is subject to the requirements of section 307 of the Clean Water Act, as amended. If the collected material is released to the environment, it may be subject to the reporting requirements of 40 CFR Part 302.]

(d) Secondary containment for tanks must include one or more of the following devices:

- A liner (external to the tank);
- A vault;
- (3) A double-walled tank; or
- (4) An equivalent device as approved by the Regional Administrator.

(e) In addition to the requirements of paragraphs (b), (c), and (d) of this section, secondary containment systems must satisfy the following requirements:

RCRA
229

(1) External liner systems must be:

- (i) Designed or operated to contain 100 percent of the capacity of the largest tank within its boundary;
- (ii) Designed or operated to prevent run-on or infiltration of precipitation into the secondary containment system unless the collection system has sufficient excess capacity to contain run-on or infiltration. Such additional capacity must be sufficient to contain precipitation from a 25-year, 24-hour rainfall event.
- (iii) Free of cracks or gaps; and
- (iv) Designed and installed to surround the tank completely and to cover all surrounding earth likely to come into contact with the waste if the waste is released from the tank(s) (i.e., capable of preventing lateral as well as vertical migration of the waste).

(2) Vault systems must be:

RCRA
88, 172

- (i) Designed or operated to contain 100 percent of the capacity of the largest tank within its boundary;
- (ii) Designed or operated to prevent run-on or infiltration of precipitation into the secondary containment system unless the collection system has sufficient excess capacity to contain run-on or infiltration. Such additional capacity must be sufficient to contain precipitation from a 25-year, 24-hour rainfall event;
- (iii) Constructed with chemical-resistant water stops in place at all joints (if any);
- (iv) Provided with an impermeable interior coating or lining that is compatible with the stored waste and that will prevent migration of waste into the concrete;
- (v) Provided with a means to protect against the formation of and ignition of vapors within the vault, if the waste being stored or treated:
 - (A) Meets the definition of ignitable waste under § 262.21 of this chapter; or
 - (B) Meets the definition of reactive waste under § 262.21 of this chapter, and may form an ignitable or explosive vapor.
- (vi) Provided with an exterior moisture barrier or be otherwise designed or operated to prevent migration of moisture into the vault if the vault is subject to hydraulic pressure.

(3) Double-walled tanks must be:

- (i) Designed as an integral structure (i.e., an inner tank completely enveloped within an outer shell) so that any release from the inner tank is contained by the outer shell.
- (ii) Protected, if constructed of metal, from both corrosion of the primary tank interior and of the external surface of the outer shell; and
- (iii) Provided with a built-in continuous leak detection system capable of detecting a release within 24 hours, or at the earliest practicable time, if the owner or operator can demonstrate to the Regional Administrator, and the Regional Administrator concludes, that the existing detection technology or site conditions would not allow detection of a release within 24 hours.

RCRA
155

RCRA
58

[Note: The provisions outlined in the Steel Tank Institute's (STI) "Standard for Dual Wall Underground Steel Storage Tanks" may be used as guidelines for aspects of the design of underground steel double-walled tanks.]

(f) Ancillary equipment must be provided with secondary containment (e.g., trench, jacketing, double-walled piping) that meets the requirements of paragraphs (b) and (c) of this section except for:

- (1) Aboveground piping (exclusive of flanges, joints, valves, and other connections) that are visually inspected for leaks on a daily basis;
- Welded flanges, welded joints, and welded connections, that are visually inspected for leaks on a daily basis;
- Sealless or magnetic coupling pumps and sealless valves, that are visually inspected for leaks on a daily basis; and

(4) Pressurized aboveground piping systems with automatic shut-off devices (e.g., excess flow check valves, flow metering shutdown devices, loss of pressure actuated shut-off devices) that are visually inspected for leaks on a daily basis.

(g) The owner or operator may obtain a variance from the requirements of this section if the Regional Administrator finds, as a result of a demonstration by the owner or operator that alternative design and operating practices, together with location characteristics, will prevent the migration of any hazardous waste or hazardous constituents into the ground water; or surface water at least as effectively as secondary containment during the active life of the tank system or that in the event of a release that does migrate to ground water or surface water, no substantial present or potential hazard will be posed to human health or the environment. New underground tank systems may not, per a demonstration in accordance with paragraph (g)(2) of this section, be exempted from the secondary containment requirements of this section.

(1) In deciding whether to grant a variance based on a demonstration of equivalent protection of ground water and surface water, the Regional Administrator will consider:

- (i) The nature and quantity of the wastes;
- (ii) The proposed alternate design and operation;
- (iii) The hydrogeologic setting of the facility, including the thickness of soils present between the tank system and ground water, and
- (iv) All other factors that would influence the quality and mobility of the hazardous constituents and the potential for them to migrate to ground water or surface water.

(2) In deciding whether to grant a variance based on a demonstration of no substantial present or potential hazard, the Regional Administrator will consider:

- (i) The potential adverse effects on ground water, surface water, and land quality taking into account:
 - (A) The physical and chemical characteristics of the waste in the tank system, including its potential for migration,
 - (B) The hydrogeological characteristics of the facility and surrounding land,
 - (C) The potential for health risks caused by human exposure to waste constituents,
 - (D) The potential for damage to wildlife, crops, vegetation, and physical structures caused by exposure to waste constituents, and
 - (E) The persistence and permanence of the potential adverse effects;
- (ii) The potential adverse effects of a release on ground-water quality, taking into account:
 - (A) The quantity and quality of ground water and the direction of ground-water flow,
 - (B) The proximity and withdrawal rates of ground-water users,
 - (C) The current and future uses of ground water in the area, and
 - (D) The existing quality of ground water, including other sources of contamination and their cumulative impact on the ground-water quality;
- (iii) The potential adverse effects of a release on surface water quality, taking into account:
 - (A) The quantity and quality of ground water and the direction of ground-water flow,
 - (B) The patterns of rainfall in the region,
 - (C) The proximity of the tank system to surface waters,
 - (D) The current and future uses of surface waters in the area and any water quality standards established for those surface waters, and
 - (E) The existing quality of surface water, including other sources of contamination and the cumulative impact on surface-water quality; and
- (iv) The potential adverse effects of a release on the land surrounding the tank system, taking into account:
 - (A) The patterns of rainfall in the region, and
 - (B) The current and future uses of the surrounding land.

(3) The owner or operator of a tank system, for which a variance from secondary containment had been granted in accordance with the requirements of paragraph (g)(1) of this section, at which a release of hazardous waste has occurred from the primary tank system but has not migrated beyond the zone of engineering control (as established in the variance), must

- (i) Comply with the requirements of § 264.196, except paragraph (d), and

(ii) Decontaminate or remove contaminated soil to the extent necessary to:

(A) Enable the tank system for which the variance was granted to resume operation with the capability for the detection of releases at least equivalent to the capability it had prior to the release; and

(B) Prevent the migration of hazardous waste or hazardous constituents to ground water or surface water; and

(iii) If contaminated soil cannot be removed or decontaminated in accordance with paragraph (g)(3)(ii) of this section, comply with the requirement of § 264.197(b).

(4) The owner or operator of a tank system, for which a variance from secondary containment had been granted in accordance with the requirements of paragraph (g)(1) of this section, at which a release of hazardous waste has occurred from the primary tank system and has migrated beyond the zone of engineering control (as established in the variance), must:

(i) Comply with the requirements of § 264.196(a), (b), (c), and (d); and

(ii) Prevent the migration of hazardous waste or hazardous constituents to ground water or surface water, if possible, and decontaminate or remove contaminated soil. If contaminated soil cannot be decontaminated or removed or if ground water has been contaminated, the owner or operator must comply with the requirements of § 264.197(b); and

(iii) If repairing, replacing, or reinstalling the tank system, provide secondary containment in accordance with the requirements of paragraphs (a) through (f) of this section or reapply for a variance from secondary containment and meet the requirements for new tank systems in § 264.192 if the tank system is replaced. The owner or operator must comply with these requirements even if contaminated soil can be decontaminated or removed and ground water or surface water has not been contaminated.

(h) The following procedures must be followed in order to request a variance from secondary containment:

(1) The Regional Administrator must be notified in writing by the owner or operator that he intends to conduct and submit a demonstration for a variance from secondary containment as allowed in paragraph (g) according to the following schedule:

(i) For existing tank systems, at least 24 months prior to the date that secondary containment must be provided in accordance with paragraph (a) of this section.

(ii) For new tank systems, at least 30 days prior to entering into a contract for installation.

(2) As part of the notification, the owner or operator must also submit to the Regional Administrator a description of the steps necessary to conduct the demonstration and a timetable for completing each of the steps. The demonstration must address each of the factors listed in paragraph (g)(1) or paragraph (g)(2) of this section;

(3) The demonstration for a variance must be completed within 180 days after notifying the Regional Administrator of an intent to conduct the demonstration; and

(4) If a variance is granted under this paragraph, the Regional Administrator will require the permittee to construct and operate the tank system in the manner that was demonstrated to meet the requirements for the variance.

(i) All tank systems, until such time as secondary containment that meets the requirements of this section is provided, must comply with the following:

(1) For non-enterable underground tanks, a leak test that meets the requirements of § 264.191(b)(5) or other tank integrity method, as approved or required by the Regional Administrator, must be conducted at least annually.

(2) For other than non-enterable underground tanks, the owner or operator must either conduct a leak test as in paragraph (i)(1) of this section or develop a schedule and procedure for an assessment of the overall condition of the tank system by an independent, qualified registered professional engineer. The schedule and procedure must be adequate to detect obvious cracks, leaks, and corrosion or erosion that may lead to cracks and leaks. The owner or operator must remove the stored waste from the tank, if necessary, to allow the condition of all internal tank surfaces to be assessed. The frequency of these assessments must be based on the material of construction of the tank and its ancillary equipment, the age of the system, the type of corrosion or erosion protection used, the rate of corrosion or erosion observed during the previous inspection, and the characteristics of the waste being stored or treated.

(3) For ancillary equipment, a leak test or other integrity assessment as approved by the Regional Administrator must be conducted at least annually.

[Note: The practices described in the American Petroleum Institute (API) Publication Guide for Inspection of Refinery Equipment, Chapter XIII, "Atmospheric and Low-Pressure Storage Tanks," 4th edition, 1981, may be used, where applicable, as guidelines for assessing the overall condition of the tank system.]

RCRA
77

(4) The owner or operator must maintain on file at the facility a record of the results of the assessments conducted in accordance with paragraphs (i)(1) through (i)(3) of this section.

(5) If a tank system or component is found to be leaking or unfit for use as a result of the leak test or assessment in paragraphs (i)(1) through (i)(3) of this section, the owner or operator must comply with the requirements of § 264.196.

[51 FR 25472, July 14, 1986, as amended at 51 FR 29430, Aug. 15, 1986; 53 FR 34086, Sept. 2, 1988]

§ 264.194 General operating requirements.

(a) Hazardous wastes or treatment reagents must not be placed in a tank system if they could cause the tank, its ancillary equipment, or the containment system to rupture, leak, corrode, or otherwise fail.

(b) The owner or operator must use appropriate controls and practices to prevent spills and overflows from tank or containment systems. These include at a minimum:

(1) Spill prevention controls (e.g., check valves, dry disconnect couplings);

(2) Overfill prevention controls (e.g., level sensing devices, high level alarms, automatic feed cutoff, or bypass to a standby tank); and

(3) Maintenance of sufficient freeboard in uncovered tanks to prevent overtopping by wave or wind action or by precipitation.

(c) The owner or operator must comply with the requirements of § 264.196 if a leak or spill occurs in the tank system.

RCRA
74

§ 264.195 Inspections.

(a) The owner or operator must develop and follow a schedule and procedure for inspecting overfill controls.

(b) The owner or operator must inspect at least once each operating day:

(1) Aboveground portions of the tank system, if any, to detect corrosion or releases of waste;

(2) Data gathered from monitoring and leak detection equipment (e.g., pressure or temperature gauges, monitoring wells) to ensure that the tank system is being operated according to its design; and

(3) The construction materials and the area immediately surrounding the externally accessible portion of the tank system, including the secondary containment system (e.g., dikes) to detect erosion or signs of releases of hazardous waste (e.g., wet spots, dead vegetation).

[Note: Section 264.15(c) requires the owner or operator to remedy any deterioration or malfunction he finds. Section 264.196 requires the owner or operator to notify the Regional Administrator within 24 hours of confirming a leak. Also, 40 CFR Part 302 may require the owner or operator to notify the National Response Center of a release.]

(c) The owner or operator must inspect cathodic protection systems, if present, according to, at a minimum, the following schedule to ensure that they are functioning properly:

(1) The proper operation of the cathodic protection system must be confirmed within six months after initial installation and annually thereafter; and

(2) All sources of impressed current must be inspected and/or tested, as appropriate, at least bimonthly (i.e., every other month).

[Note: The practices described in the National Association of Corrosion Engineers (NACE) standard, "Recommended Practice (RP-02-85)—Control of External Corrosion on Metallic Buried, Partially Buried, or Submerged Liquid Storage Systems," and the American Petroleum Institute (API) Publication 1632, "Cathodic Protection of Underground Petroleum Storage Tanks and Piping Systems," may be used where applicable, as guidelines in maintaining and inspecting cathodic protection systems.]

(d) The owner or operator must document in the operating record of the facility an inspection of those items in paragraphs (a) through (c) of this section.

RCRA

§ 265.192 Design and installation of new tank systems or components.

(a) Owners or operators of new tank systems or components must ensure that the foundation, structural support, seams, connections, and pressure controls (if applicable) are adequately designed and that the tank system has sufficient structural strength, compatibility with the waste(s) to be stored or treated, and corrosion protection so that it will not collapse, rupture, or fail. The owner or operator must obtain a written assessment, reviewed and certified by an independent, qualified, registered professional engineer, in accordance with § 270.11(d) attesting that the system has sufficient structural integrity and is acceptable for the storing and treating of hazardous waste. The assessment must include, at a minimum, the following information:

- (1) Design standard(s) according to which the tank(s) and ancillary equipment is or will be constructed.
- (2) Hazardous characteristics of the waste(s) to be handled.
- (3) For new tank systems or components in which the external shell of a metal tank or any external metal component of the tank system is or will be in contact with the soil or with water, a determination by a corrosion expert of:
 - (i) Factors affecting the potential for corrosion, including but not limited to:
 - (A) Soil moisture content;
 - (B) Soil pH;
 - (C) Soil sulfides level;
 - (D) Soil resistivity;
 - (E) Structure to soil potential;
 - (F) Influence of nearby underground metal structures (e.g., piping);
 - (G) Stray electric current; and
 - (H) Existing corrosion-protection measures (e.g., coating, cathodic protection), and
 - (ii) The type and degree of external corrosion protection that are needed to ensure the integrity of the tank system during the use of the tank system or component, consisting of one or more of the following:
 - (A) Corrosion-resistant materials of construction such as special alloys, fiberglass reinforced plastic;
 - (B) Corrosion-resistant coating (such as epoxy, fiberglass) with cathodic protection (e.g., impressed current or sacrificial anodes); and
 - (C) Electrical isolation devices such as insulating joints and flanges.

[Note: The practices described in the National Association of Corrosion Engineers (NACE) standard, "Recommended Practice (RP-02-85)—Control of External Corrosion on Metallic Buried, Partially Buried, or Submerged Liquid Storage Systems," and the American Petroleum Institute (API) Publication 1632, "Cathodic Protection of Underground Petroleum Storage Tanks and Piping Systems," may be used, where applicable, as guidelines in providing corrosion protection for tank systems.]

(4) For underground tank system components that are likely to be affected by vehicular traffic, a determination of design or operational measures that will protect the tank system against potential damage; and

(5) Design considerations to ensure that:

- (i) Tank foundations will maintain the load of a full tank;
- (ii) Tank systems will be anchored to prevent flotation or dislodgment where the tank system is placed in a saturated zone, or is located within a seismic fault zone; and
- (iii) Tank systems will withstand the effects of frost heave.

(b) The owner or operator of a new tank system must ensure that proper handling procedures are adhered to in order to prevent damage to the system during installation. Prior to covering, enclosing, or placing a new tank system or component in use, an independent, qualified installation inspector or an independent, qualified, registered professional engineer, either of whom is trained and experienced in the proper installation of tank systems, must inspect the system or component for the presence of any of the following items:

- (1) Weld breaks;
- (2) Punctures;
- (3) Scrapes of protective coatings;
- (4) Cracks;

(5) Corrosion;

(6) Other structural damage or inadequate construction or installation.

Discrepancies must be remedied before the tank system is covered, enclosed, or placed in use.

For new tank systems or components and piping that are placed underground and that are backfilled must be provided with a backfill material that is a noncorrosive, porous, homogeneous substance and that is carefully installed so that the backfill is placed completely around the tank and compacted to ensure that the tank and piping are fully and uniformly supported.

(d) All new tanks and ancillary equipment must be tested for tightness prior to being covered, enclosed or placed in use. If a tank system is found not to be tight, all repairs necessary to remedy the leak(s) in the system must be performed prior to the tank system being covered, enclosed, or placed in use.

(e) Ancillary equipment must be supported and protected against physical damage and excessive stress due to settlement, vibration, expansion or contraction.

[Note: The piping system installation procedures described in American Petroleum Institute (API) Publication 1615 (November 1979), "Installation of Underground Petroleum Storage Systems," or ANSI Standard B31.3, "Petroleum Refinery System," and ANSI Standard B31.4 "Liquid Petroleum Transportation Piping System," may be used, where applicable, as guidelines for proper installation of piping systems.]

(f) The owner or operator must provide the type and degree of corrosion protection necessary, based on the information provided under paragraph (a)(3) of this section, to ensure the integrity of the tank system during use of the tank system. The installation of a corrosion protection system that is field fabricated must be supervised by an independent corrosion expert to ensure proper installation.

(g) The owner or operator must obtain and keep on file at the facility written statements by those persons required to certify the design of the tank system and supervise the installation of the tank system in accordance with the requirements of paragraphs (b) through (f) of this section to attest that the tank system was properly designed and installed and that repairs, pursuant to paragraphs (b) and (d) of this section, were performed. These written statements must also include the certification statement as required in § 270.11(d) of this chapter.

RCRA
171

[51 FR 25479, July 14, 1986, as amended at 51 FR 29430, August 15, 1986]

§ 265.193 Containment and detection of releases.

RCRA
74, 116, 117

Order to prevent the release of hazardous waste or hazardous constituents to the environment, secondary containment must meet the requirements of this section must be provided (except as provided in paragraphs (f) and (g) of this section):

RCRA
84, 167, 176

(1) For all new tank systems or components, prior to their being put into service;

(2) For all existing tanks used to store or treat EPA Hazardous Waste Nos. F020, F021, F022, F023, F026, and F027, within two years after January 12, 1987;

(3) For those existing tank systems of known and documentable age, within two years after January 12, 1987, or when the tank systems have reached 15 years of age, whichever comes later;

RCRA
168

(4) For those existing tank systems for which the age cannot be documented, within eight years of January 12, 1987; but if the age of the facility is greater than seven years, secondary containment must be provided by the time the facility reaches 15 years of age, or within two years of January 12, 1987, whichever comes later; and

(5) For tank systems that store or treat materials that become hazardous wastes subsequent to January 12, 1987, within the time intervals required in paragraphs (a)(1) through (a)(4) of this section, except that the date that a material becomes a hazardous waste must be used in place of January 12, 1987.

(b) Secondary containment systems must be:

RCRA
228

(1) Designed, installed, and operated to prevent any migration of wastes or accumulated liquid out of the system to the soil, ground water, or surface water at any time during the use of the tank system; and

(2) Capable of detecting and collecting releases and accumulated liquids until the collected material is removed.

(c) To meet the requirements of paragraph (b) of this section, secondary containment systems must be at a minimum:

(1) Constructed of or lined with materials that are compatible with the waste(s) to be placed in the tank system and must have sufficient strength and thickness to prevent failure due to pressure gradients (including static head and external hydrological forces), physical contact with the waste to which they are exposed, climatic conditions, the stress of installation, and the stress of daily operation (including stresses from nearby vehicular traffic);

(2) Placed on a foundation or base capable of providing support to the secondary containment system and resistance to pressure gradients above and below the system and capable of preventing failure due to settlement, compression, or uplift;

(3) Provided with a leak-detection system that is designed and operated so that it will detect the failure of either the primary and secondary containment structure or any release of hazardous waste or accumulated liquid in the secondary containment system within 24 hours, or at the earliest practicable time if the existing detection technology or site conditions will not allow detection of a release within 24 hours;

(4) Sloped or otherwise designed or operated to drain and remove liquids resulting from leaks, spills, or precipitation. Spilled or leaked waste and accumulated precipitation must be removed from the secondary containment system within 24 hours, or in as timely a manner as is possible to prevent harm to human health or the environment, if removal of the released waste or accumulated precipitation cannot be accomplished within 24 hours.

[Note: If the collected material is a hazardous waste under Part 261 of this chapter, it is subject to management as a hazardous waste in accordance with all applicable requirements of Parts 262 through 265 of this chapter. If the collected material is discharged through a point source to waters of the United States, it is subject to the requirements of sections 301, 304, and 402 of the Clean Water Act, as amended. If discharged to a Publicly Owned Treatment Works (POTWs), it is subject to the requirements of section 307 of the Clean Water Act, as amended. If the collected material is released to the environment, it may be subject to the reporting requirements of 40 CFR Part 302.]

(d) Secondary containment for tanks must include one or more of the following devices:

- (1) A liner (external to the tank);
- (2) A vault;
- (3) A double-walled tank; or
- (4) An equivalent device as approved by the Regional Administrator.

(e) In addition to the requirements of paragraphs (b), (c), and (d) of this section, secondary containment systems must satisfy the following requirements:

(1) External liner systems must be:

- (i) Designed or operated to contain 100 percent of the capacity of the largest tank within its boundary;
- (ii) Designed or operated to prevent run-on or infiltration of precipitation into the secondary containment system unless the collection system has sufficient excess capacity to contain run-on or infiltration. Such additional capacity must be sufficient excess capacity to contain precipitation from a 25-year, 24-hour rainfall event.
- (iii) Free of cracks or gaps; and
- (iv) Designed and installed to completely surround the tank and to cover all surrounding earth likely to come into contact with the waste if released from the tank(s) (i.e., capable of preventing lateral as well as vertical migration of the waste).

(2) Vault systems must be:

- (i) Designed or operated to contain 100 percent of the capacity of the largest tank within its boundary;
- (ii) Designed or operated to prevent run-on or infiltration of precipitation into the secondary containment system unless the collection system has sufficient excess capacity to contain run-on or infiltration. Such additional capacity must be sufficient to contain precipitation from a 25-year, 24-hour rainfall event;
- (iii) Constructed with chemical-resistant water stops in place at all joints (if any);
- (iv) Provided with an impermeable interior coating or lining that is compatible with the stored waste and that will prevent migration of waste into the concrete;
- (v) Provided with a means to protect against the formation of and ignition of vapors within the vault, if the waste being stored or treated:
 - (A) Meets the definition of ignitable waste under § 262.21 of this chapter; or
 - (B) Meets the definition of reactive waste under § 262.21 of this chapter and may form an ignitable or explosive vapor; and

(vi) Provided with an exterior moisture barrier or be otherwise designed or operated to prevent migration of moisture into the vault if the vault is subject to hydraulic pressure.

(3) Double-walled tanks must be:

RCRA
166

RCRA
229

RCRA
66, 172

- (i) Designed as an integral structure (i.e., an inner tank within an outer shell) so that any release from the inner tank is contained by the outer shell;
- (ii) Protected, if constructed of metal, from both corrosion of the primary tank interior and the external surface of the outer shell; and
- (iii) Provided with a built-in, continuous leak detection system capable of detecting a release within 24 hours or at the earliest practicable time, if the owner or operator can demonstrate to the Regional Administrator, and the Regional Administrator concurs, that the existing leak detection technology or site conditions will not allow detection of a release within 24 hours.

RCRA
156

[Note: The provisions outlined in the Steel Tank Institute's (STI) "Standard for Dual Wall Underground Steel Storage Tanks" may be used as guidelines for aspects of the design of underground steel double-walled tanks.]

(f) Ancillary equipment must be provided with full secondary containment (e.g., trench, jacketing, double-walled piping) that meets the requirements of paragraphs (b) and (c) of this section except for:

- (1) Aboveground piping (exclusive of flanges, joints, valves, and connections) that are visually inspected for leaks on a daily basis;
- (2) Welded flanges, welded joints, and welded connections that are visually inspected for leaks on a daily basis;
- (3) Sealless or magnetic coupling pumps and sealless valves, that are visually inspected for leaks on a daily basis; and
- (4) Pressurized aboveground piping systems with automatic shut-off devices (e.g., excess flow check valves, flow metering shutdown devices, loss of pressure actuated shut-off devices) that are visually inspected for leaks on a daily basis.

(g) The owner or operator may obtain a variance from the requirements of this Section if the Regional Administrator finds, as a result of a demonstration by the owner or operator, either: that alternative design and operating practices, together with location characteristics, will prevent the migration of hazardous waste or hazardous constituents into the ground water *or* surface water at least as effectively as secondary containment during the active life of the tank system *or* that in the event of a release that does migrate to ground water or surface water, no substantial present or potential hazard will be posed to human health or the environment. New underground tank systems may not, per a demonstration in accordance with paragraph (g)(2) of this section, be exempted from the secondary containment requirements of this section. Application for a variance as allowed in paragraph (g) of this section does not waive compliance with the requirements of this Subpart for new tank systems.

RCRA
68

(1) In deciding whether to grant a variance based on a demonstration of equivalent protection of ground water and surface water, the Regional Administrator will consider:

- (i) The nature and quantity of the waste;
- (ii) The proposed alternate design and operation;
- (iii) The hydrogeologic setting of the facility, including the thickness of soils between the tank system and ground water; and
- (iv) All other factors that would influence the quality and mobility of the hazardous constituents and the potential for them to migrate to ground water or surface water.

(2) In deciding whether to grant a variance based on a demonstration of no substantial present or potential hazard, the Regional Administrator will consider:

- (i) The potential adverse effects on ground water, surface water, and land quality taking into account:
 - (A) The physical and chemical characteristics of the waste in the tank system, including its potential for migration,
 - (B) The hydrogeological characteristics of the facility and surrounding land,
 - (C) The potential for health risks caused by human exposure to waste constituents,
 - (D) The potential for damage to wildlife, crops, vegetation, and physical structures caused by exposure to waste constituents, and
 - (E) The persistence and permanence of the potential adverse effects;
- (ii) The potential adverse effects of a release on ground-water quality, taking into account:
 - (A) The quantity and quality of ground water and the direction of ground-water flow,
 - (B) The proximity and withdrawal rates of water in the area,
 - (C) The current and future uses of ground water in the area, and

- (D) The existing quality of ground water, including other sources of contamination and their cumulative impact on the ground-water quality;
- (iii) The potential adverse effects of a release on surface water quality, taking into account:
- (A) The quantity and quality of ground water and the direction of ground-water flow,
 - (B) The patterns of rainfall in the region,
 - (C) The proximity of the tank system to surface waters,
 - (D) The current and future uses of surface waters in the area and any water quality standards established for those surface waters, and
 - (E) The existing quality of surface water, including other sources of contamination and the cumulative impact on surface-water quality; and
- (iv) The potential adverse effects of a release on the land surrounding the tank system, taking into account:
- (A) The patterns of rainfall in the region, and
 - (B) The current and future uses of the surrounding land.
- (3) The owner or operator of a tank system, for which a variance from secondary containment had been granted in accordance with the requirements of paragraph (g)(1) of this section, at which a release of hazardous waste has occurred from the primary tank system but has not migrated beyond the zone of engineering control (as established in the variance), must:
- (i) Comply with the requirements of § 265.196, except paragraph (d), and
 - (ii) Decontaminate or remove contaminated soil to the extent necessary to:
 - (A) Enable the tank system, for which the variance was granted, to resume operation with the capability for the detection of and response to releases at least equivalent to the capability it had prior to the release, and
 - (B) Prevent the migration of hazardous waste or hazardous constituents to ground water or surface water; and
 - (iii) If contaminated soil cannot be removed or decontaminated in accordance with paragraph (g)(3)(ii) of this section, comply with the requirements of § 265.197(b).
- (4) The owner or operator of a tank system, for which a variance from secondary containment had been granted in accordance with the requirements of paragraph (g)(1) of this section, at which a release of hazardous waste has occurred from the primary tank system and has migrated beyond the zone of engineering control (as established in the variance), must:
- (i) Comply with the requirements of § 265.196(a), (b), (c), and (d); and
 - (ii) Prevent the migration of hazardous waste or hazardous constituents to ground water or surface water, if possible, and decontaminate or remove contaminated soil. If contaminated soil cannot be decontaminated or removed, or if ground water has been contaminated, the owner or operator must comply with the requirements of § 265.197(b);
 - (iii) If repairing, replacing, or reinstalling the tank system, provide secondary containment in accordance with the requirements of paragraphs (a) through (f) of this section or reapply for a variance from secondary containment and meet the requirements for new tank systems in § 265.192 if the tank system is replaced. The owner or operator must comply with these requirements even if contaminated soil can be decontaminated or removed, and ground water or surface water has not been contaminated.
- (h) The following procedures must be followed in order to request a variance from secondary containment:
- (1) The Regional Administrator must be notified in writing by the owner or operator that he intends to conduct and submit a demonstration for a variance from secondary containment as allowed in paragraph (g) of this section according to the following schedule:
 - (i) For existing tank systems, at least 24 months prior to the date that secondary containment must be provided in accordance with paragraph (a) of this section; and
 - (ii) For new tank systems, at least 30 days prior to entering into a contract for installation of the tank system.
 - (2) As part of the notification, the owner or operator must also submit to the Regional Administrator a description of the steps necessary to conduct the demonstration and a timetable for completing each of the steps. The demonstration must address each of the factors listed in paragraph (g)(1) or paragraph (g)(2) of this section.
 - (3) The demonstration for a variance must be completed and submitted to the Regional Administrator within 180 days after notifying the Regional Administrator of intent to conduct the demonstration.

The Regional Administrator will inform the public, through a newspaper notice, of the availability of the demonstration for a variance. The notice shall be placed in a daily or weekly major local newspaper of general circulation and shall provide at least 30 days from the date of the notice for the public to review and comment on the demonstration for a variance. The Regional Administrator also will hold a public hearing, in response to a request or at his own discretion, whenever such a hearing might clarify one or more issues concerning the demonstration for a variance. Public notice of the hearing will be given at least 30 days prior to the date of the hearing and may be given at the same time as notice of the opportunity for the public to review and comment on the demonstration. These two notices may be combined.

(5) The Regional Administrator will approve or disapprove the request for a variance within 90 days of receipt of the demonstration from the owner or operator and will notify in writing the owner or operator and each person who submitted written comments or requested notice of the variance decision. If the demonstration for a variance is incomplete or does not include sufficient information, the 90-day time period will begin when the Regional Administrator receives a complete demonstration, including all information necessary to make a final determination. If the public comment period in paragraph (h)(4) of this section is extended, the 90-day time period will be similarly extended.

All tank systems, until such time as secondary containment meeting the requirements of this section is provided, must comply with the following:

RCRA
77

- (1) For non-enterable underground tanks, a leak test that meets the requirements of § 265.191(b)(5) must be conducted at least annually;
- (2) For other than non-enterable underground tanks and for all ancillary equipment, an annual leak test, as described in paragraph (i)(1) of this section, or an internal inspection or other tank integrity examination by an independent, qualified, registered professional engineer that addresses cracks, leaks, corrosion, and erosion must be conducted at least annually. The owner or operator must remove the stored waste from the tank, if necessary, to allow the condition of all internal tank surfaces to be assessed.

(Note: The practices described in the American Petroleum Institute (API) Publication Guide for Inspection of Refinery Equipment, Chapter XIII, "Atmospheric and Low-Pressure Storage Tanks," 4th edition, 1981, may be used, where applicable, as guidelines for assessing the overall condition of the tank system.)

The owner or operator must maintain on file at the facility a record of the results of the assessments conducted in accordance with paragraphs (i)(1) through (i)(3) of this section.

If a tank system or component is found to be leaking or unfit-for-use as a result of the leak test or assessment in paragraphs (i)(1) through (i)(3) of this section, the owner or operator must comply with the requirements of § 265.196.

[51 FR 25479, July 14, 1986, as amended at 51 FR 29430, Aug. 15, 1986; 53 FR 34087, Sept. 2, 1988]

265.194 General operating requirements.

-) Hazardous wastes or treatment reagents must not be placed in a tank system if they could cause the tank, its ancillary equipment, or the containment system to rupture, leak, corrode, or otherwise fail.
-) The owner or operator must use appropriate controls and practices to prevent spills and overflows from tank or containment systems. These include at a minimum:
 - (1) Spill prevention controls (e.g., check valves, dry discount couplings);
 - (2) Overfill prevention controls (e.g., level sensing devices, high level alarms, automatic feed cutoff, or bypass to a standby tank); and
 - (3) Maintenance of sufficient freeboard in uncovered tanks to prevent overtopping by wave or wind action or by precipitation.
-) The owner or operator must comply with the requirements of § 265.196 if a leak or spill occurs in the tank system.

265.195 Inspections.

RCRA
74

-) The owner or operator must inspect, where present, at least once each operating day:
 - (1) Overfill/spill control equipment (e.g., waste-feed cutoff systems, bypass systems, and drainage systems) to ensure that it is in good working order;

Appendix B
Qualification of Contractors

SUBCONTRACTOR QUALIFICATION STATEMENT

Lockheed Idaho Technologies Company (LITCO) is the Construction Manager under contract with DOE-ID for supporting and overseeing construction activities at the INEL. The construction for the Filter Leach Modifications Project was performed in the Filter Handling Cell of the Decontamination Facility at the New Waste Calcining Facility (NWCF). Work was performed both inside the Filter Handling Cell, in the clean operating corridor, and in adjacent cells. All of the cells are radioactively contaminated. The areas of work requiring access into radiation areas was performed by personnel from both Wheeler and Dynamics.

Dynamics, Incorporated was selected as the Subcontractor, and performed the mechanical installation inside and outside of the cell. Wheeler, Electric, was selected to perform the electrical work. Both Dynamics and Wheeler have previously qualified to perform construction work at the INEL. They have both had many years of successful construction project completion at the INEL.

Dynamics performed the installation of the piping and equipment. Wheeler Electric installed all of the necessary electrical equipment. All of the work was completed as specified, and all inspection requirements were successfully met.



Thornton H. Waite
Filter Leach Modifications Project
March 17, 1995

Appendix C
Certification Records of Welders and Inspectors

Construction Vendor Data Submittal and Disposition Form

To: **MK-Ferguson of Idaho Company**
P.O. Box 1745
Idaho Falls, ID 83403-1745
ATTN: Document Control MS-5300

(1) Submittal (Project) Number: 299425-32 (2) Rev. 0 (3) Date of Submittal 11/16/94
 (4) Project Title MODS TO THE HIEPA FILTER LEACH SYSTEM (5) Subcontract Number S -299425
 (6) Subcontractor DYNAMICS INCORPORATED (7) Subcontractor Code 9410-34

Disposition Legend: (A) Work may proceed subject to incorporation of any comments noted. (B) Revise and resubmit. Work may proceed subject to incorporation of comments noted. (C) Revise and resubmit. Work may NOT proceed. (D) Information only. Work may proceed.

(8) Line No.	(9) VHS Item No.	(10) Spec/Dwg Reference	(11) Qty Excl	(12) Submittal Status					(13) Submittal Data				(14) Disp Status			
				Recub	Mand Appl	Or-Eq Appl	Info Only	Addl Info	Manufacturer's Name	Model / Serial No.	Mat. No.	Description		Document No.	Rev	
A	18	15024-3	B										WELDER QUALIFICATIONS (OFF-SITE)			A
													G.D. PARRISH			

(15) Remarks: Shirley Cholecy 11-16-94
 (16) Subcontractor Signature: Shirley Cholecy Date: 11-16-94

(17) C/M Review / Approval Required Yes No (18) Recommended Disposition A

(19) Date Received	Date Forwarded	Forwarded To	Qty End	Initials
<u>11-17</u>	<u>11-17</u>	<u>Rex Duke</u>	<u>7</u>	<u>CB</u>
<u>11-17</u>	<u>11-17</u>	<u>K. Orr</u>	<u>7</u>	<u>Ch</u>
<u>11-17</u>	<u>11-17</u>	<u>L. Hays</u>	<u>7</u>	<u>CB</u>
<u>11-18</u>	<u>11/22</u>	<u>CB</u>	<u>2</u>	<u>RM</u>

(21) O/C Review / Approval Required Yes No (20) Additional Comments Attached (23) Additional Comments Attached

File
 TH Waite
 RM Barker

TH Waite 11/22/94
 (22) O/C Reviewing Agency Signature / Date

(24) I Acknowledge receipt of the data indicated and (agree disagree) to incorporate any comments.

Subcontractor Signature: _____

(26) Distribution	Cvr	Sets	Distribution	Cvr	Sets
Document Control			Subcontractor		
ES&H Department			Operating Contractor		
Quality Assurance					

INEL WELDER CERTIFICATION STATUS REPORT / CONST ACTIVE WELDERS

G = Grooves
F = Fillets

Positions: (1) - Flat (2) - Horizontal (3) - Vertical (4) - Overhead (5) - Pipe Horizontal (6) - 45 deg. Inclined
 Brazing - (1) - Lap joint (2) - Down Hill W/O/F = With/Without Fillet Material Plug = Plug Weld * = Backing Strip
 * = Less Than or Equal To
 Example: Welding - 12G = Flat, Horizontal Position, Groove and Fillets

Date: 09/01/94

PAGE 13

Name	S No.	WELDER Code	Company	WPS Qualified	ASME Positions Qualified	AWS D1.1 Positions Qualified	AWS D1.2 Positions Qualified	AWS D1.3 Positions Qualified	AWS D9.1 Positions Qualified	AWS D16.1 Positions Qualified	Max. Thick	Min. Thick	Min. Dia.	Re-tested or Renewal	Exp. Date	Orig. Test		
Mission, K. F.	46213	ALQ	CONST	S2.0	12 G/F						0.436	0.062	1.000	06/22/94	12/22/94	06/22/94		
				S2.24		ALL F					0.294	0.125	0.500	06/22/94	12/22/94	12/10/93		
				S3.06		123 F					0.500	0.125	24.000	06/22/94	12/22/94	06/22/94		
Herman, H. P.	38385	ASU	CONST	A2.10				123 G/F			0.129	0.062	0.000	04/27/94	10/27/94	09/20/93		
				C2.11	ALL G/F *			ALL G/F			0.500	0.125	24.000	04/27/94	10/27/94	09/20/93		
Ornelo, G. F.	46509	AKU	CONST	C2.2							0.229	0.062	0.000	04/27/94	10/27/94	09/20/93		
				C3.5	ALL G/F *						0.500	0.125	24.000	04/27/94	10/27/94	06/22/94		
				CS2.4					ALL G/F				0.229	0.062	0.000	07/26/94	07/26/94	07/26/94
				S2.11					ALL G/F				0.229	0.062	0.000	04/27/94	10/27/94	11/30/92
				C2.11	ALL F						0.294	0.125	0.500	04/06/94	10/06/94	06/06/94		
Parrish, G. D.	23181	MT	CONST	C3.5	ALL G/F						0.294	0.062	0.500	06/23/94	12/23/94	12/01/89		
				CS2.0	ALL G/F						0.294	0.062	0.500	06/23/94	12/23/94			
				S2.0	ALL G/F						0.294	0.062	0.500	06/23/94	12/23/94			
				S2.0	ALL G/F						0.294	0.062	0.500	06/23/94	12/23/94			
Quinton, B. D.	71186	ASR	CONST	C3.5		123 G/F *					0.750	0.125	24.000	07/27/94	07/27/94	07/27/94		
				C2.0	ALL G/F						0.750	0.062	0.500	05/03/94	11/03/94	05/03/94		
Ray, K. D.	58142	AJV	CONST	CS2.0	ALL G/F						0.750	0.062	0.500	05/03/94	11/03/94	05/03/94		
				S2.0	ALL G/F						0.750	0.062	0.500	05/03/94	11/03/94	06/25/90		
				S3.0	ALL G/F						0.750	0.062	2.075	05/03/94	11/03/94	05/03/94		
				S6.0	ALL G/F *						1.000	0.107	2.075	05/03/94	11/03/94	05/03/94		
				C2.0	ALL G/F						0.294	0.062	0.500	06/23/94	12/23/94	06/23/94		
Reid, G. S.	65412	ALL	CONST	CS2.0	ALL G/F						0.294	0.062	0.500	06/23/94	12/23/94	06/23/94		
				S2.0	ALL G/F						0.294	0.062	0.500	06/23/94	12/23/94	06/23/94		
				S2.0	ALL G/F						0.294	0.062	0.500	06/23/94	12/23/94	06/23/94		
Remer, B. J.	39786	RU	CONST	C2.11		ALL G/F *					0.500	0.125	24.000	05/03/94	11/03/94	05/20/92		
				C3.5	ALL G/F *						0.500	0.125	0.000	05/03/94	11/03/94	12/19/89		
				CS2.4	ALL G/F *						0.500	0.125	24.000	05/03/94	11/03/94	05/20/92		
				CS2.7	ALL G/F *						0.500	0.125	24.000	05/03/94	11/03/94	11/20/92		
				S2.24	ALL G/F *						0.500	0.125	24.000	05/03/94	11/03/94	05/20/92		
				S6.10	ALL F *						0.000	0.125	24.000	05/03/94	11/03/94	12/21/92		
				S6.3	ALL F *						0.000	0.125	24.000	05/03/94	11/03/94	12/21/92		
				S6.3	ALL F *						0.000	0.125	24.000	05/03/94	11/03/94	12/21/92		

WORK MAY PROCEED.

TO INCORPORATE ANY CHANGES AND RESUME WORK MAY PROCEED.

PREVIEW NOT REQUIRED. WORK MAY PROCEED.

KEEP TO ONE SIDE OF THE CONTRACT.

CONTRACT NO. 299425-32

TW/LM

11-22-94

Construction Vendor Data Transmittal and Disposition Form

To: **MK-Ferguson of Idaho Company**
 P.O. Box 1745
 Idaho Falls, ID 83403-1745
 ATTN: Document Control MS-5300

(1) Submittal (Project) Number: 299425- 31 (2) Rev. 0 (3) Date of Submittal 11/16/94
 (4) Project Title MODS TO THE HEPA FILTER LEACH SYSTEM (5) Subcontract Number S-299425
 (6) Subcontractor DYNAMICS INCORPORATED (7) Subcontractor Code 9410-33

Disposition Legend: (A) Work may proceed subject to incorporation of any comments noted. (B) Revise and resubmit. Work may proceed subject to incorporation of comments noted. (C) Revise and resubmit. Work may NOT proceed. (D) Information only. Work may proceed.

(8) Line No.	(9) VDS Item No.	(10) Spec/Dwg Reference	(11) Qty Encl	(12) Submittal Status					(13) Submittal Data				(14) Disposition	
				Revis	Manu Appl	Or-Eq Appl	Info Only	Addnl Info	Manufacturer's Name	Model / Serial No.	Heat No.	Description		Document No.
A	16	15024-3	1						N/A	N/A	N/A	WELDER QUALIFICATIONS (ON-SITE) (G.D. PARRISH)		A

(15) Remarks: Jimmy A. Wesley 11-16-94
 (16) Subcontractor Signature Date

(17) C/M Review / Approval Required Yes No (18) Recommended Disposition A

(19) MK-FIC Reviewing Agency Signature / Date: R. Duke 11/17/94

(20) Additional Comments Attached

(21) O/C Review / Approval Required Yes No

File T/Waile, R.M. Barker

(22) O/C Reviewing Agency Signature / Date: T.H. Waile 11/23/94

(23) Additional Comments Attached

(24) I Ack: receipt of the data indicated and (agree disagree) to incorporate comments.

(25) Date Received	Date Forwarded	Forwarded To	Qty Encl	Initials
11-17	11-17	Rex Duke	7	RD
11-17	11-17	K. Orr	7	CO
11-17	11-17	L. Hays	7	CH
11-18	1/22	CB	2	AM

(26) Distribution	Cvr	Sets	Distribution	Cvr	Sets
Document Control			Subcontractor		
ES&I Department			Operating Contr.		
Quality Assurance					

INEL WELDER CERTIFICATION STATUS REPORT / CONST ACTIVE WELDERS

G = Grooves
F = Fillets

Positions: 111 - Flat (12) - Horizontal (13) - Vertical (14) - Overhead (15) - Pipe Horizontal (16) - 45 deg. Incline
 Brazing - Lj = Lap Joint D1 = Down Hill W/W F = With/without Filler Material Plug = Plug Weld * = Backing Strip
 * = less than or Equal to
 (Example: Welding - 12CF = Flat, Horizontal Position, Groove and Fillets)

Date: 09/01/94

PAGE 15

Name	S No.	WELDER Code	Company	WPS Qualified	ASME Positions Qualified	AWS D1.1 Positions Qualified	AWS D1.2 Positions Qualified	AWS D1.3 Positions Qualified	AWS D9.1 Positions Qualified	AWS D14.1 Positions Qualified	Max. Thick	Min. Thick	Min. Dia.	Retested or Renewal	Exp. Date	Orig. Test
				\$2.0	12 G/F						0.438	0.062	1.000	06/23/94	12/23/94	06/23/94
				\$2.24		ALL F					0.294	0.125	0.500	06/23/94	12/23/94	12/10/93
				\$3.16		123 F					0.500	0.125	24.000	06/23/94	12/23/94	06/23/94
Nilsson, K. J.	46213	ALQ	CONET	C3.5		ALL G/F *					0.750	0.125	24.000	04/21/94	10/21/94	10/23/93
Harman, H. P.	58365	ASU	CONET	A2.10					123 G/F		0.125	0.062	0.000	04/27/94	10/27/94	09/20/93
				C2.11		ALL G/F *					0.500	0.125	24.000	04/27/94	10/27/94	09/20/93
				C2.2					ALL G/F		0.250	0.062	0.000	04/27/94	10/27/94	09/20/93
				C3.5		ALL G/F *					0.500	0.125	24.000	04/27/94	10/27/94	04/27/94
				CS2.4					ALL G/F		0.250	0.062	0.000	07/26/94	07/26/94	07/26/94
				\$2.11					ALL G/F		0.250	0.062	0.000	04/27/94	10/27/94	11/30/92
Onaida, C. F.	46584	AKU	CONET	C2.11		ALL F					0.294	0.125	0.500	04/06/94	10/06/94	04/06/94
				C3.5		ALL G/F					0.500	0.125	24.000	04/06/94	10/06/94	10/30/89
				CS2.7		ALL F					0.294	0.125	0.500	04/06/94	10/06/94	06/16/93
				\$2.24		ALL F					0.294	0.125	0.500	04/06/94	10/06/94	06/23/91
Parrish, G. D.	23181	MI	CONET	C2.0	ALL G/F						0.294	0.062	0.500	04/23/94	12/23/94	12/01/80
				CS2.0	ALL G/F						0.294	0.062	0.500	04/23/94	12/23/94	
				\$2.0	ALL G/F						0.294	0.062	0.500	04/23/94	12/23/94	
Quinton, R. D.	71186	ASB	CONET	C3.5			123 G/F *				0.750	0.125	24.000	07/27/94	01/27/95	07/27/94
Ray, K. D.	50142	AJV	CONET	C2.0	ALL G/F						0.750	0.062	0.500	05/03/94	11/03/94	05/03/94
				CS2.0	ALL G/F						0.750	0.062	0.500	05/03/94	11/03/94	05/03/94
				\$2.0	ALL G/F						0.750	0.062	0.500	05/03/94	11/03/94	05/03/94
				\$3.0	ALL G/F						0.750	0.062	2.875	05/03/94	11/03/94	05/03/94
				\$6.0	ALL G/F *						1.000	0.107	2.875	05/03/94	11/03/94	05/03/94
Reid, G. S.	65432	ALL	CONET	C2.0	ALL G/F						0.294	0.062	0.500	06/23/94	12/23/94	06/23/94
				CS2.0	ALL G/F						0.294	0.062	0.500	06/23/94	12/23/94	06/23/94
				\$2.0	ALL G/F						0.294	0.062	0.500	06/23/94	12/23/94	06/23/94
Remer, B. J.	39786	RU	CONET	C2.11	ALL G/F *						0.500	0.125	24.000	03/03/94	11/03/94	05/20/92
				C2.5	ALL G/F *						0.500	0.125	0.000	05/03/94	11/03/94	12/10/89
				CS2.4	ALL G/F *						0.500	0.125	24.000	05/03/94	11/03/94	05/20/92
				CS2.7	ALL G/F *						0.500	0.125	24.000	05/03/94	11/03/94	05/20/92
				\$2.24	ALL G/F *						0.500	0.125	24.000	05/03/94	11/03/94	05/20/92
				\$6.00	ALL F *						0.000	0.125	24.000	05/03/94	11/03/94	05/20/92
				\$6.3	ALL F *						0.000	0.125	24.000	05/03/94	11/03/94	12/21/92

A WORK MAY PROCEED.

REVISE AND RESUBMIT.
 WORK MAY PROCEED SUBJECT
 TO INCORPORATION OF
 CHANGES INDICATED.

REVISE AND RESUBMIT.
 WORK MAY NOT PROCEED.

REVISION NOT REQUIRED.
 WORK MAY PROCEED.

PROJECT NO 299425-31
 TW/LM
 11-22-94

Construction Vendor Data Transmittal and Disposition Form

McFerguson of Idaho Company
 P. Box 1745
 Boise Falls, ID 83403-1745
 TN: Document Control MS-5300

(1) Submittal (Project) Number: 299425-14 (2) Rev. 0 (3) Date of Submittal 10/19/94
 (4) Project Title MODS TO THE HEPA FILTER LEACHING SYSTEM (5) Subcontract Number S-299425
 (6) Subcontractor DYNAMICS INCORPORATED (7) Subcontractor Code 9410-19

- Disposition and (A) Work may proceed subject to incorporation of any comments noted. (B) Revise and resubmit. Work may proceed subject to incorporation of comments noted.
 (C) Revise and resubmit. Work may NOT proceed. (D) Information only. Work may proceed.

(8) C No. Rev.	(9) VDS Item No.	(10) Spec/Dwg Reference	(11) Qty Encl	(12) Submittal Status					(13) Submittal Data					(14) Map Status		
				Resub	Modd Apvl	Or-Eq Apvl	Info Only	Adtdl Info	Manufacturer's Name	Model / Serial No.	Heat No.	Description	Document No.		Rev	
-	18	15024-3	8										WELDER QUALIFICATIONS (OFF-SITE) (D. MUNN)			A

Remarks

Dynamics 10/19/94
 (16) Subcontractor Signature Date

C/M Review / Approval Required Yes No (18) Recommended Disposition A

B. Duke 10/20/94
 (19) AIC-FIC Reviewing Agency Signature / Date

(20) Additional Comments Attached

O/C Review / Approval Required Yes No

*File
Waite
BARKER*

(25) Date Received	Date Forwarded	Forwarded To	Qty Encl	Initials
10-20	10-20	REX DUBE	7	CB
10-20	10-20	F. ORR	7	CB
10-21	10-21	L. MURPHY	1	CB
10-24	10-25	C. BRISCOE	2	MM

J. A. Waite 10-25-94
 (22) O/C Reviewing Agency Signature / Date

(23) Additional Comments Attached

I Acknowledge receipt of the data indicated and (agree disagree) to incorporate any comments.

Contractor Signature

Date

(26) Distribution	Cvr	Sets	Distribution	Cvr	Sets
Document Control			Subcontractor		
ES&H Department			Operating Contractor		
Quality Assurance					
Construction Supervisor					

Construction Vendor Data and Disposition Form

Ferguson of Idaho Company
 P. Box 1745
 Boise Falls, ID 83403-1745
 T/N: Document Control MS-5300

(1) Submittal (Project) Number: 299425-18 (2) Rev. 0 (3) Date of Submittal 10/19/94
 (4) Project Title MODS TO THE HEPA FILTER LEACHING SYSTEM (5) Subcontract Number S-299425
 (6) Subcontractor DYNAMICS INCORPORATED (7) Subcontractor Code 9410-18

Condition (A) Work may proceed subject to incorporation of any comments noted. (B) Revise and resubmit. Work may proceed subject to incorporation of comments noted.
 (C) Revise and resubmit. Work may NOT proceed. (D) Information only. Work may proceed.

Item No. Rev.	(9) V/S Item No.	(10) Spec/Tag Reference	(11) Qty Each	(12) Submittal Status						(13) Submittal Data					(14) Disp Status	
				Resub	Mod Appl	Or-Eq Appl	Info Only	Ad-Inf Info	Manufacturer's Name	Model/ Serial No.	Mat No.	Description	Document No.	Rev		
-	16	15024-	8										WELDER QUALIFICATIONS (ON-SITE) (D. MUNN)			A

Remarks

[Signature] (16) Subcontractor Signature 10-19-94 Date

C/M Review / Approval Required Yes No

(18) Recommended Disposition A

[Signature] 10/20/94
 (19) MK-FIE Reviewing Agency Signature / Date

(20) Additional Comments Attached

O/C Review / Approval Required Yes No

File write BARKER

[Signature] 10-25-94
 (22) O/C Reviewing Agency Signature / Date

(23) Additional Comments Attached

(14) I Acknowledge receipt of the data indicated and (agree disagree) to incorporate any comments.

Subcontractor Signature _____ Date _____

(25) Date Received	Date Forwarded	Forwarded To	Qty End	Initials
10-20	10-20	Red Data	7	CB
10-20	10-20	[Signature]	7	CA
10-21	10-21	L. Hays	7	CS
10-24	10-25	C. BRISCOE	2	XM

(26) Distribution	Cvr	Sets	Distribution	Cvr	Sets
Document Control			Subcontractor		
ES&H Department			Operating Contractor		
Quality Assurance					
Construction Supervisor					

See instructions on reverse side

Form 1111 Rev. 7/88 **Construction Vendor Transmittal and Disposition Form** 1 of 1

To: **MK-Ferguson of Idaho Company**
P.O. Box 1745
Idaho Falls, ID 83403-1745
ATTN: Document Control MS-5300

(1) Submittal (Project) Number: 299425-16 (2) Rev. 0 (3) Date of Submittal 10/03/94
 (4) Project Title MODS TO THE HEPA FILTER LEACHING SYSTEM (5) Subcontract Number S-299425
 (6) Subcontractor DYNAMICS INCORPORATED (7) Subcontractor Code 9410-11

Disposition Legend (A) Work may proceed subject to incorporation of any comments noted. (B) Revise and resubmit. Work may proceed subject to incorporation of comments noted.
 (C) Revise and resubmit. Work may NOT proceed. (D) Information only. Work may proceed.

(8) Line No.	(9) V/D S Item No.	(10) Spec/Dwg Reference	(11) Qty Encl	(12) Submittal Status						(13) Submittal Data					
				Re-sub	Modif. Appl	Or-Eq. Appl	Info Only	Add'l Info	Manufacturer's Name	Model / Serial No.	Heat No.	Description	Document No.	Rev	
A	-	16	15024-3	8						N/A	N/A	N/A	WELDER QUALIFICATION (ON-SITE)		
													R.H. JAMES		

(15) Remarks _____

 (16) Subcontractor Signature _____ Date 10-3-94

(17) C/M Review / Approval Required Yes No (18) Recommended Disposition A

 (19) MK-FIC Reviewing Agency Signature / Date R. Duke 10/12/94
Luck Heese (20) Additional Comments Attached

(25) Date Received	Date Forwarded	Forwarded To	Qty Encl	Int
10-12	10-12	REX DUKE	7	CB
10-12	10-12	K. Orr	7	C
10-12	10-12	L. Mays	7	CE
10/13	10/24	C. BRISCOE	2	CA

(21) O/C Review / Approval Required Yes No
 File
 TH Waite
 RM Barker

 (22) O/C Reviewing Agency Signature / Date TH Waite 10-24-94 (23) Additional Comments Attached

(26) Distribution	Cvr	Set	Distribution	Cvr
Document Control			Subcontractor	
ES&H Department			Operating Contractor	
Quality Assurance				

(24) I Acknowledge receipt of the data indicated and (agree disagree) to incorporate any comments.

 Subcontractor Signature

INEL WELDER CERTIFICATION STATUS REPORT / CONST ACTIVE WELDERS

G = Grooves
F = Fillets

Positions: 11) - Flat 12) - Horizontal 13) - Vertical 14) - Overhead 15) - Pipe Horizontal 16) - 45 deg. Incline
 Beveling - Lj = Lap Joint DH = Down Hill W/W/F = With/Without Filler Material Plug = Plug Weld * = Backing Strip
 * = Less Than or Equal to
 (Example: Welding - 12CF = Flat, Horizontal Position, Groove and Fillets)

Date: 06/01/94

PAGE 12

Name	S No.	WELDER Code	Company	WPS Qualified	ASME Positions Qualified	AWS D1.1 Positions Qualified	AWS D1.2 Positions Qualified	AWS D1.3 Positions Qualified	AWS D9.1 Positions Qualified	AWS D14.1 Positions Qualified	Max. Thick	Min. Thick	Min. Dia.	Re-tested or Renewal	Exp. Date	Orig. Test
Imff, W. B.	4962	SQ	CONST	S2.24		ALL F					0.500	0.125	24.000	06/19/94	02/19/95	06/19/94
Immlund, B. V.	64933	ASW	CONST	C3.0	12 G/F						0.474	0.062	2.675	06/12/94	02/12/95	06/02/92
Imover, M. K.	30990	LK	CONST	C2.0 C3.0 C8.0 CS2.0 S2.0	ALL G/F ALL G/F ALL G/F ALL G/F ALL G/F						0.436 0.436 0.436 0.436 0.436	0.062 0.062 0.062 0.062 0.062	1.000 1.000 1.000 1.000 1.000	07/07/94 07/07/94 07/07/94 07/07/94 07/07/94	01/07/95 01/07/95 01/07/95 01/07/95 01/07/95	02/13/87 06/19/91 12/19/91 09/16/90
Imwell, D. C.	14714	Bn	CONST	C2.0 CS2.0 S2.0	ALL G/F ALL G/F ALL G/F						0.436 0.436 0.436	0.062 0.062 0.062	1.000 1.000 1.000	07/05/94 07/05/94 07/05/94	01/05/95 01/05/95 01/05/95	10/25/93 06/25/93 10/25/93
Imwell, J. L.	44865	Cv	CONST	A2.0 A2.5 C2.0 C2.11 C2.7 C3.0 C3.5 C6.11 C6.14 C6.8 C8.0 CS2.0 S2.0 S2.11 S2.24	ALL F ALL G/F ALL G/F		ALL F	ALL F			0.250 0.500 0.436 0.436 0.480 0.436 0.790 0.750 0.480 0.790 0.436 0.436 0.230 0.436	0.062 0.125 0.062 0.125 0.059 0.062 0.125 0.125 0.059 0.062 0.062 0.062 0.062 0.125	24.000 24.000 1.000 104.500 0.000 1.000 24.000 24.000 0.000 24.000 1.000 1.000 0.250 0.000 104.500	06/15/94 06/15/94 06/15/94 06/15/94 06/15/94 06/15/94 06/15/94 06/15/94 06/15/94 06/15/94 06/15/94 06/15/94 07/13/94 06/15/94	12/15/94 12/15/94 12/15/94 12/15/94 12/15/94 12/15/94 12/15/94 12/15/94 12/15/94 12/15/94 12/15/94 12/15/94 01/13/95 12/15/94	07/02/93 07/02/93 07/06/93 07/02/93 07/01/93 01/04/93 07/01/93 07/02/93 07/02/93 07/02/93 07/02/93 07/02/93 04/06/93 07/02/93
James, B. H.	46449	ACS	CONST	C2.0 C3.5 CS2.0 H2.3 H2.13 S3.0	ALL G/F ALL G/F ALL G/F ALL G/F ALL G/F	ALL G/F					0.294 0.750 0.294 0.436 0.432 0.294	0.062 0.125 0.062 0.062 0.062 0.062	0.250 24.000 0.500 1.000 1.000 0.250	06/06/94 06/06/94 06/06/94 06/06/94 06/06/94 06/06/94	12/06/94 12/06/94 12/06/94 12/06/94 12/06/94 12/06/94	01/21/87 06/06/93 06/20/91 06/20/91 06/20/91
Jones, B. S.	47807	ADJ	CONST	C3.5 S2.24		123 G/F ALL F					0.750 0.500	0.125 0.125	24.000 24.000	04/16/94 06/19/94	10/19/94 02/19/95	06/20/89 06/19/94
Jones, T. L.	47796	BS	CONST	C2.0 C3.0	ALL G/F ALL G/F						0.436 0.436	0.062 0.062	1.000 1.000	06/23/94 06/23/94	12/23/94 12/23/94	07/06/94 03/06/90

X

299425-16
 THW/LM
 10-11-91

Ferguson of Idaho
 Box 1745
 Co Falls, ID 83403-1745
 FN: Document Control MS-5300

(1) Submittal (Project) Number: 299425-14 (2) Rev. 0 (3) Date of Submittal 10/3/94
 (4) Project Title MODS TO THE HEPA FILTER LEACHING SYSTEM (5) Subcontract Number S-299425
 (6) Subcontractor DYNAMICS INCORPORATED (7) Subcontractor Code 9410-13

(A) Work may proceed subject to incorporation of any comments noted. (B) Revise and resubmit. Work may proceed subject to incorporation of comments noted.
 (C) Revise and resubmit. Work may NOT proceed. (D) Information only. Work may proceed.

(9) No. Rev.	(9) VDS Item No.	(10) Spec/Dwg Reference	(11) Qty Encl	(12) Submittal Status					(13) Submittal Data					(14) Disp Status	
				Rev'd	Modd Appl	Or-Eq Appl	Info Only	Addtl Info	Manufacturer's Name	Modd / Serial No.	Heat No.	Description	Document No.		Rev
-	18	15024-3	8						N/A	N/A	N/A	WELDER QUALIFICATIONS (OFF-SITE)			A
												R. H. JAMES			

Remarks

Jerry A. Kelsey (16) Subcontractor Signature 10-3-94 Date

C/M Review / Approval Required Yes No (18) Recommended Disposition A
 (19) M/R Reviewing Agency Signature / Date R. Duke 10/12/94
 (20) Additional Comments Attached

O/C Review / Approval Required Yes No
 File TH White R.M. Barker
 (21) O/C Reviewing Agency Signature / Date T.H. White 10-24-94
 (22) Additional Comments Attached

I acknowledge receipt of the data indicated and (agree disagree) to incorporate any comments.

Subcontractor Signature _____ Date _____

(25) Date Received	Date Forwarded	Forwarded To	Qty Encl	Initials
10-12	10-12	KEX DUKE	7	CB
10-12	10-12	K. ORR	7	CB
10-12	10-12	L. Mays	7	CB
10/13	10/24	C. KRISCOE	2	EM

(26) Distribution		Cvr	Sets	Distribution		Cvr	Sets
Document Control				Subcontractor			
ES&H Department				Operating Contractor			
Quality Assurance							
Construction Supervisor							

27

37

HWMA/RCRA PART B PERMIT
FOR THE IDAHO NATIONAL LABORATORY

Volume 18 – Idaho Nuclear Technology and Engineering Center

APPENDIX 9

Debris Treatment Processes
Holdup and Collection Tanks
CPP-659/-1659 Storage
CPP-666 FDP Cell Container Storage and Slab Tank Storage
Other Miscellaneous Treatment Processes
RMWSF (CPP-1617) Container Storage Area

FDP CELL SLAB TANK CERTIFICATIONS

Effective Date: April 27, 2009

Westinghouse Idaho
Nuclear Company, Inc.

WINCO QUALITY ASSURANCE

1. Report No. P-027

Page 1 of 2

PROCUREMENT ACTIVITIES REPORT

2. Report Period From <u>2/7</u> Thru <u>2/24/</u> 19 <u>86</u>		3. P.O./Subcontract No. 207254	<i>SHOWN, PLEASE FILE WITH Vendor data for PO 207254</i>
4. Supplier: Silver Engineering Works		5. Address Aurora, Colorado	
6. Item Description Slab Tank, VES-FC-184			
8. Specification 20000-M1, 30000-W3	Rev. 0	9. Drawing S.E.W. DB20204 Sh. 1 and 2 ^{Rev.} DB20205 Sh. 1 of 1	
10. Supplier Personnel Contacted Mr. Tom Theil		11. Quality Engineer/QFR J. M. Adam	
12. Problem Areas, Tentative or Accomplished Solutions, Results — Surveillance/Inspection/Evaluation Activities: A visit was made to Silver Engineering Works of Aurora, Colorado, to perform in-process and final inspections of one slab tank, VES-FC-184, per the specifications listed above and quality assurance planning 51299, and the quality assurance marked drawings. My contact at Silver Engineering Works (S.E.W.) was Mr. Tom Theil, Quality Manager. 1. A dimensional inspection was performed per "Q.A." marked drawings; all dimensions are acceptable except through hole for nozzle N-L, see SDR #4. 2. A visual inspection was performed on all accessible welds. They are acceptable. 3.a Ultrasonic examination of nozzle welds was not performed by virtue of SDR #3 eliminating ultrasonic examination of the nozzle welds. 3.b A review of S.E.W. test reports was made to verify that the root and final weld passes were liquid penetrant examined. This review disclosed that the root weld pass of shell plate 2R had not been liquid penetrant examined. S.E.W. issued a Suppliers Disposition Request (SDR) #002, recommending liquid penetrant examination of the 2nd pass and cover pass on the other side of the shell plate. Joe Pruitt, Project Engineer and Dan Schell, Quality Engineer were contacted per telephone and concurred with S.E.W.'s recommendation and directed this QFR to sign the SDR indicating approval. This was adhered to by this QFR. All liquid penetrant examinations are acceptable.			
13. Distribution: J. Pruitt E. Trenchak J. Boyington J. M. Adam File		14. QE/QFR Signature: <i>J. M. Adam</i> QP Supervisor Signature: <i>Dr. J. Pruitt</i>	Date: 3-11-86 Date: 3/11/86 Extension 6:35 ^{PM}



WINCO QUALITY ASSURANCE

Report No. P-027

Page 2 of 2

PROCUREMENT ACTIVITIES REPORT (Con't. Sheet)

- 3.c Radiographic film of pressure boundary welds was interpreted and the welds and radiographs are acceptable.
4. Critically Prevention Limit (C.P.L.) was measured prior to and after the stiffner plates were installed to verify C.P.L. This was accomplished by the ultrasonic method. All readings, before and after the stiffners were installed, are within drawing tolerances and are acceptable.
5. A hydrostatic pressure test, with the slab tank in a vertical position, was performed by S.E.W. per the specifications and the drawing. No leaks or deformation were detected. The hydrostatic pressure test is acceptable.
6. Prior to final closure of the slab tank, a free iron test was performed per ASTM A380, Section 7.2.5.1, "Water-Wetting and Drying" on the internals of the tank. The test is acceptable.
7. Final cleaning was performed by S.E.W. per the requirements of Specification 30000-M1 3.06; final cleaning is acceptable.
8. A visual inspection was performed on the name plate to verify compliance with Specification 30000-M1 2.03; the name plate is acceptable.
9. Preparation for shipment was witnessed by this QFR and is acceptable.
10. A Suppliers Quality Assurance Release, Form WINCO 7022, was issued with the following conditions: pending formal approval of SDR's 3 and 4.



Westinghouse Idaho
Nuclear Company, Inc.

No. 207254-5

FORM WINCO-8157 (6-85)

SUPPLIER DATA TRANSMITTAL AND DISPOSITION

Contract No. <u>207254</u>	For: Approval <input checked="" type="checkbox"/> Information Only <input type="checkbox"/>
To: WESTINGHOUSE IDAHO NUCLEAR CO. INC. 1955 FREMONT AVE. BOX 4000 IDAHO FALLS, IDAHO 83403	From: SILVER ENGINEERING WORKS. 14800 E. MONCRIEFF PL. AURORA, CO. 80011

Document No. <u>VES-FC-184</u>	Revision No. <u>0</u>	Title or Description <u>HYDRO STATIC TEST PROCEDURE</u>
Contract Reference: <u>DOCUMENT SUBMITTAL SCHEDULE FORM 5730</u>		

Supplier Signature	Date	Title
<i>[Signature]</i>	<u>1/7/86</u>	<u>MANAGER QUALITY ASSURANCE</u>

Received at WINCO 1 / 1 by _____ Signature

Disposition:

Approved Approved W/Comment Disapproved Receipt Acknowledged

Comments: Attached Sheet(s)

No Comment

Action taken herein does not relieve Seller of his responsibility to meet contractual requirements, nor does it authorize any increase in price or delay in delivery.

WINCO Procurement Signature	Date	WINCO Requester Signature
		<i>[Signature]</i> <u>1-10-86</u>

WINCO Reviewers		Signature
Rec'd. <u>1/18/86</u>	Ret'd. <u>1/18/86</u>	<i>[Signature]</i>
Rec'd. <u>1/18/86</u>	Ret'd. <u>1/18/86</u>	<i>[Signature]</i>
Rec'd. <u>1/18/86</u>	Ret'd. <u>1/18/86</u>	<i>[Signature]</i>
Rec'd. <u>1/1</u>	Ret'd. <u>1/1</u>	
Rec'd. <u>1/1</u>	Ret'd. <u>1/1</u>	

If Seller considers that disposition herein justifies a price increase or delivery delay, no compliance with the disposition shall be initiated.

SUBCONTRACT #207254

HYDROSTATIC TEST PROCEDURE

1. Hydro Static Testing will be accomplished in accordance with ASME Boiler and Pressure Vessel Code Section VIII Division 1, UG99.
2. Test media shall be water having a chloride content of not more than 35 PPM.
3. Nozzles are to be restored to drawing condition at the completion of the test.
4. Vessel to be pumped up to 190 psig (new condition) for a minimum of 1 hour with no detectable loss. Calibrated and certified gauges will be used to monitor any pressure drop.
5. Any detectable leaks shall be repaired, the areas cleaned and the hydrotest reformed.

Westinghouse Idaho Nuclear Co., Inc.

Permission to proceed does not constitute acceptance or approval of design details, calculations, analyses, test methods or materials developed or selected by the supplier and does not relieve supplier from full compliance with contractual obligations.

Work may proceed.
 Revise and Resubmit. Work may proceed subject to incorporation of changes noted.
 Work may not proceed. Revise and Resubmit.
 Review not required. Work may proceed.

Contract No. 207254-5 Date 1-10-86
By Bob Delamont

INSPECTION RECORD COPY

SILVER ENGINEERING WORKS, INC.

Certification of Hydro-Static Test

Name of Part SHAB TANK

S/N of Vessel 6-10-001

Date of Test 2/22/86

Test Pressure 150 PSIG

Test Held For 1 Hour

Temperature of Water AMBIENT °F.

S/N of Test Gauge SG101

Witness Howard J. Kelly S.E.W. Inspector

Witness [Signature] Authorized Inspector



SILVER ENGINEERING WORKS, INC.

157V

AURORA, COLORADO

12" ± 1/8

LOCATION OF U STAMP



CERTIFIED BY
SILVER ENGINEERING WORKS INC.
AURORA, COLORADO

MAX. ALLOW. WORKING PRESSURE 100 PSIG
AT TEMPERATURE 104°F

SERIAL NO. 86-10-001 YEAR BUILT 1986

SLAB TANK. EQUIPMENT NO. VES-FC-184

SHELL MATERIAL SA 240 GR. 304L

DESIGN PRESSURE 100 PSI AT 104°F

TEST PRESSURE 150 PSIG

WEIGHT 6700 LB.

PURCHASE ORDER NO. 207254

5/4"

Westinghouse Idaho Nuclear Co., Inc.

Permission to proceed does not constitute acceptance or approval of design details, calculations, analyses, test methods or materials developed or prepared by the supplier and does not relieve supplier from full compliance with contractual obligations.

- Work may proceed.
- Revise and Resubmit Work may proceed, subject to incorporation of changes noted.
- Work may not proceed. Revise and Resubmit.
- Review not required. Work may proceed.

Contract No. 207254
By *Del. Laurent* Date 1-15-86

MATERIAL: R 3/16 x 5/8 x 12 ; SA 240 GR. 304L
LETTER SIZE 5/32"

① NAMEPLATE

FOR CUSTOMERS APPROVAL

JAN 10 1986

SCALE: FULL

TITLE SLAB TANK NAMEPLATE
VES-FC-184

DATE 1-9-86

DRAWN m2

©

S.O. 6-10-001

DWG AB 20207

FILE 52

FORM U-1A MANUFACTURER'S DATA REPORT FOR PRESSURE VESSELS
(Alternative Form for Single Chamber, Completely Shop-Fabricated Vessels Only)
As Required by the Provisions of the ASME Code Rules, Section VIII, Division 1

1. Manufactured and certified by SILVER ENGINEERING WORKS INC. 14800 E. MONCRIEFF PL., AURORA, CO 80011
(Name and address of manufacturer)

2. Manufactured for WESTINGHOUSE IDAHO NUCLEAR CO. INC., BOX 4000, IDAHO FALLS, IDAHO 83403
(Name and address of purchaser)

3. Location of installation SAME
(Name and address)

4. Type HORIZ RECT TANK 86-10-001 - DB 20204 - 1986
(Horiz. or vert., tank) (Mfg's serial No.) (CRN) (Drawing No.) (Nat'l Bd. No.) (Year built)

5. The chemical and physical properties of all parts meet the requirements of material specifications of the ASME BOILER AND PRESSURE VESSEL CODE. The design, construction, and workmanship conform to ASME Rules, Section VIII, Division 1.

to JUNE 30, 1985
Addenda (Date)

6. Shell: SA 240-304L 0.75 0.125 2 1/2" x 60" 96"
Mat'l. (Spec. No., Grade) (Nom. Thk. (in.)) (Corr. Allow. (in.)) (Diam. I.D. (ft. & in.)) (Length overall (ft. & in.))

7. Seams: SNGL BUTT WELD SPOT - - SNGL BUTT WELD SPOT 1
Long. (Welded, Del., Sngl., Lap, Butt) R.T. (Spot or Full) Eff. (%) H.T. Temp. (F) Time (hr) Girth (Welded, Del., Sngl., Lap, Butt) R.T. (Spot, Partial, or Full) No. of Courses

8. Heads: (a) Mat'l. SA 240-304L (b) Mat'l. SA 240-304L
(Spec. No., Grade) (Spec. No., Grade)

	Location (Top, Bottom, Ends)	Minimum Thickness	Corrosion Allowance	Crown Radius	Knuckle Radius	Elliptical Ratio	Conical Apex Angle	Hemispherical Radius	Flat Diameter	Side to Pressure (Convex or Concave)
(a)	ENDS	0.75	0.125	2.5	-	-	-	-	-	CONCAVE
(b)										

If removable, bolts used (describe other fastenings) N/A
(Mat'l., Spec. No., Gr., Size, No.)

9. MAWP 100 psi at max. temp. 104 °F
 Min. temp. (when less than -20°F) - °F. Hydro., pneu., or comb. test pressure (VERT) 150 psi

10. Nozzles, inspection and safety valve openings:

Purpose (Inlet, Outlet, Drain)	No.	Diam. or Size	Type	Mat'l.	Nom. Thk.	Reinforcement Mat'l.	How Attached	Location
ATMOS VERT	1	2"	1501bFLG	SA 479-304L	0.218	NONE	WELDED	TOP
PROCESS	4	1"	BUTT WELD	SA 479-304L	0.250	NONE	WELDED	TOP
PROCESS	1	3/4"	BUTT WELD	SA 479-304L	0.218	NONE	WELDED	TOP
PROCESS	1	1/2"	BUTT WELD	SA 479-304L	0.187	NONE	WELDED	TOP

11. Supports: Skirt - Lugs 4 Legs - Other - Attached WELDED BOTT. & TOP
(Yes or no) (No.) (No.) (No.) (Describe) (Where and how)

12. Remarks: Manufacturer's Partial Data Reports properly identified and signed by Commissioned Inspectors have been furnished for the following items of the report:
(Name of part, item number, Mfg's name and identifying stamp)

CERTIFICATE OF SHOP COMPLIANCE

We certify that the statements made in this report are correct and that all details of design, material, construction, and workmanship of this vessel conform to the ASME Code for Pressure Vessels, Section VIII, Division 1. "U" Certificate of Authorization No. 5767 expires JUNE 4, 1988.
 Date 2-22-86 Co. name SILVER ENGINEERING WORKS, INC. Signed Howard Lee Kelly
(Manufacturer) (Representative)

CERTIFICATE OF SHOP INSPECTION

Vessel constructed by SILVER ENGINEERING WORKS, INC. at AURORA, COLORADO
 I, the undersigned, holding a valid commission issued by the National Board of Boiler and Pressure Vessel Inspectors and/or the State or Province of COLORADO and employed by LUMBERMENS MUTUAL CASUALTY CO.
 have inspected the component described in this Manufacturer's Data Report on 222, 1986, and state that, to the best of my knowledge and belief, the Manufacturer has constructed this pressure vessel in accordance with ASME Code, Section VIII, Division 1. By signing this certificate neither the Inspector nor his employer makes any warranty, expressed or implied, concerning the pressure vessel described in this Manufacturer's Data Report. Furthermore, neither the Inspector nor his employer shall be liable in any manner for any personal injury or property damage or a loss of any kind arising from or connected with this inspection.
 Date 2-22-86 Signed [Signature] Commissions COLO #420
(Authorized Inspector) (Nat'l Board (incl. endorsements), State, Prov. and No.)

FORM U-4 MANUFACTURER'S DATA REPORT SUPPLEMENTARY SHEET
As Required by the Provisions of the ASME Code Rules, Section VIII, Division 1

1. Manufactured and certified by SILVER ENGINEERING WORKS INC. 14800 E. MONCRIEFF PLACE, AURORA, CO 80011
(Name and address of manufacturer)
2. Manufactured for WESTINGHOUSE IDAHO NUCLEAR CO. INC., Box 4000, IDAHO FALLS, IDAHO 83403
(Name and address of purchaser)
3. Location of Installation SAME
(Name and address)
4. Type HORIZ. RECT. TANK 86-10-006 - DB 20204 - 1986
(Horiz., vert., tank, etc.) (Mfg'r. serial No.) (CRN) (Dwg) (Nat'l. Bd. No.) (Year built)

Data Report Item Number	Remarks
10	PROCESS 2 ea. 1" BUTT. WELD SA 479-304L 0.218 NONE WELDED BOTTOM
NOZZLES	PROCESS 4 ea. 1/2" BUTT. WELD SB 622-C22 0.187 NONE WELDED TOP
CONT.	PROCESS 1 ea. 3/4" BUTT. WELDED SB 622-C22 0.218 NONE WELDED TOP
	PROCESS 3 ea. 1" BUTT. WELDED SB 622-C22 0.250 NONE WELDED TOP

Westinghouse Idaho Nuclear Co., Inc.

Permitted to proceed, subject to acceptance of inspection, test, and analysis reports, methods, or materials developed by the supplier and does not relieve supplier from full compliance with construction conditions.

Work may proceed.

Review and Resubmit. Work may proceed subject to incorporation of changes noted.

Work may not proceed. Revise and Resubmit.

Review not required. Work may proceed.

Contract No. 207254

By J. I. Pruitt / VCS Date 3/7/86

Date Feb 22, 1986 Co. name SILVER ENGINEERING WORKS, INC. Signed Howard Dan Kelly
(Manufacturer) (Representative)

Date 2-22-86 Signed [Signature] Commissions CO 420
(Authorized Inspector) (Nat'l. Board incl. endorsement, State, Prov., and No.)

REPRODUCTION
RECORD COPY

ORIGINAL LOST



Westinghouse Idaho
Nuclear Company, Inc.

QUALITY ENGINEERING INSPECTION PLANNING

FORM WINCO-7071 (6-85)

Plan No. 51299 Rev. e

1. Source 2. Receiving 3. Construction 4. Production 5. Quality Level I

6. Item/Title/Description: SLAB TANK JES-FC-184

7. Project FDP MODS 8. Dwg./Spec. No. 30000-M1 Rev 3 30002-W3, 30442-W5-S43 Rev. —

9. P.O. Subcontract MJR Job EA No. 207254 Rev. 0

10. Prepared By W.J. BOYINGTON Date 2-4-86 11. Reviewed By WJB Date 2-4-86

12. Approved By J.I. PRUITT Date —

13. Char. No.	14. Inspection Characteristic	15. Inspection Status	16. General Remarks
<u>1</u>	Perform 2 dimensional inspection Per "QA" Marked dwg - Tolerances per dwg and Spec 30000-M-1 Sec 2. Note: Nozzles shall not be located in any seam without prior written approval	<u>WJB</u> 	See report P.027 by <u>D. Adam</u> <u>WJB</u>
<u>2</u>	Perform a visual inspection of all accessible welds. Reject welds that have not been properly contoured/finished for the applicable inspection method. Reject excessive undercut and excessive reinforcement Reject fillet welds that are under size or under run	<u>WJB</u> 	see report P.027 by <u>D. Adam</u> <u>WJB</u>
<u>3</u>	NON-DESTRUCTIVE EXAMINATION a) WITNESS W.T. of NOZZLE WELDS	<u>WJB</u> 	See report P.027 by <u>D. Adam</u> <u>WJB</u>

17. Inspections Reviewed/Completed
for J.L. Trujillo 2-26-86
Insp. Supvr. Date

18. Final Quality Engineering Review/Approval
—
Quality Engineer Date

INSPECTION
RECORD COPY



QUALITY ENGINEERING INSPECTION PLANNING
(Continuation Sheet)

FORM WINCO-7071B (6-85)

Plan No. 51299


13. Char. No.	14. Inspection Characteristic	15. Inspection Status	16. General Remarks
3.	<p><i>Non-Destructive Examination</i></p> <p>b) L. P. Verify by review of test reports that the root and final passes of all pressure retaining welds have been inspected and accepted by the L.P. Method.</p> <p>c) R. T. Interpret radiographic film per ASME SEC VIII DIV 1 Para UW-51 Punch film to indicate accept-reject of film + welds.</p>	<p><i>WJ</i> </p> <p><i>SOA #2</i></p> <p><i>WJ</i> </p>	<p><i>See report P-027</i> <i>by J. Adams</i> <i>WJ</i></p> <p><i>See report 6027</i> <i>by J. Adams</i> <i>WJ</i></p>
4	<p>INSPECTION HOLD POINT WITNESS: CPL - dimension inspection</p>	<p><i>WJ</i> </p>	<p><i>See report P-027</i> <i>by J. Adams</i> <i>WJ</i></p>
5.	<p>INSPECTION HOLD POINT WITNESS. FIT-UP and welding final CLOSURE</p>	<p><i>WJ</i> </p>	<p><i>See report P-027</i> <i>by J. Adams</i> <i>WJ</i></p>

INSPECTION RECORD COPY

QUALITY ENGINEERING INSPECTION PLANNING (Continuation Sheet)

FORM WINCO-7071B (6-85)

Plan No. 51299

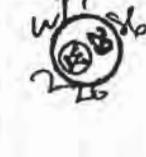13. Char. No.	14. Inspection Characteristic	15. Inspection Status	16. General Remarks
6	INSPECT NOZZLES FOR CORRECT LENGTH, SIZE, SCHEDULE AND ORIENTATION, VERIFY I.D. OF NOZZLE IS ALIGNED WITH THROUGH HOLE		See Report P-027 by J. Adam w/h
7	WITNESS HYDROSTATIC TEST PER THE VENDOR'S PROJECT APPROVED PROCEDURE, SPEC 30000 MI 3.05 D		See report P-027 by J. Adam w/h
8	WITNESS FREE IRON TEST SPEC 30000 MI 3.05 E		See Report P-027 by J. Adam w/h
9	WITNESS FINAL CLEANING SPEC 30000 MI 3.06		See report P-027 by J. Adam w/h
10.	INSPECT NAME PLATE SPEC 30000 MI 2.03 VENDOR'S PROJECT APPROVED DWGS		See 2022 dated 2-22-86 by J. Adam w/h
11.	WITNESS PREPERATION FOR SHIPMENT <u>OR</u> REVIEW REQUIREMENTS WITH SUPPLIER REP.		See report P-027 by J. Adam w/h
12	ISSUE FORM WINCO 7022 SUPPLIER QA RELEASE		See Report P-027 by J. Adam w/h

6.5



Idaho National Engineering Laboratory

CLP-10-93

From : C. L. Porter
Phone : 6-3101/MS 5119
Date : April 20, 1993
Subject: FAST Integrity Assessment



To : S. A. Birrer
J. E. Hevlow

Richard Lo - ETAS Corporation (2 attachments)

cc: S. A. Drewes*
J. E. Kaylor*
S. A. Heath - ETAS Corporation*
J. S. Kilburn - ETAS Corporation*

* - w/o Attachments

This letter transmits your copy of the completed documents associated with the certification of the integrity of the FAST Facility. This satisfies the requirement of 40 CFR 265.193 and 265.191 for an annual integrity assessment.

A handwritten signature in cursive script, appearing to read "C. L. Porter for CLP".

C. L. Porter, Project Manager
Environmental Compliance Projects

/mh

Attachments



Westinghouse Idaho Nuclear Company, Inc.

SECONDARY CONTAINMENT ASSESSMENT
FOR THE
FLUORINEL AND FUEL STORAGE FACILITY (FAST)

APRIL 1993

PREPARED BY:

C. L. Porter
C. L. PORTER, SENIOR ENGINEER
ENVIRONMENTAL COMPLIANCE PROJECTS

4-20-93

DATE

WESTINGHOUSE IDAHO NUCLEAR CORPORATION
CO-OPERATOR OF THE IDAHO CHEMICAL PROCESSING PLANT
FOR THE
U. S. DEPARTMENT OF ENERGY
IDAHO FALLS, IDAHO

**INDEPENDENT, QUALIFIED,
REGISTERED PROFESSIONAL ENGINEER
ENDORSEMENT OF THE
SECONDARY CONTAINMENT ASSESSMENT
FOR THE
FLUORINEL AND FUEL STORAGE FACILITY (FAST)**

**IDAHO CHEMICAL PROCESSING PLANT
IDAHO NATIONAL ENGINEERING LABORATORY
IDAHO FALLS, IDAHO**

Based on review of this document, entitled "Secondary Containment Assessment for the Fluorinel and Fuel Storage Facility (FAST)", April 1993, prepared by C.L. Porter of WINCO, ETAS Corporation concurs with WINCO's conclusion that secondary containment, where present, is adequate.

Stanley A. Heath
Stanley A. Heath, ETAS Corporation
Project Manager

4/20/93
Date

James S. Kilburn, P.E.
James S. Kilburn, ETAS Corporation
Idaho P. E. Registration #4504

4/20/93
Date



SECONDARY CONTAINMENT ASSESSMENT
FOR THE
FLUORINEL AND FUEL STORAGE FACILITY (FAST)

INTRODUCTION

The Resource Conservation and Recovery Act (RCRA) per 40 CFR 265.191, requires an integrity assessment for existing hazardous waste tank systems that do not have secondary containment that meet the requirements of 40 CFR 265.193. The integrity assessment is limited to those facilities which are less than 15 years old and do not have secondary containment. The purpose of this secondary containment assessment is to define the boundaries of the hazardous waste system associated with FAST and determine which portions have secondary containment meeting the regulatory standards. This will establish the scope for the subsequent integrity assessment.

FACILITY DESCRIPTION

The Fluorinel and Fuel Storage Facility (FAST) is located in building CPP-666 at the Idaho Chemical Processing Plant (ICPP) is comprised of two separate operating areas: the Fuel Storage Area (FSA) and the Fluorinel Dissolution Process (FDP) area (see Figure 1).


The FDP area of FAST consists of facilities for converting a variety of spent nuclear reactor fuel elements into a liquid-feed solution for subsequent uranium recovery at other ICPP facilities. However, due to the 1992 mission change, spent nuclear fuel is no longer dissolved for uranium recovery at the ICPP.

The FSA of FAST provides facilities for receiving, preparing for storage, storing, transferring, and preparing for processing various fuels received at the ICPP.

FAST, along with its associated tankage and container storage has interim RCRA status. However, the tank systems associated with FDP are being closed under interim status and will be operated as <90 day generator storage units (40 CFR 262.34). The operation of such units requires compliance with the substantive portions of subpart J of 40 CFR part 265. To allow the greatest flexibility for future use of the facility those non-permitted tank systems will be included in this secondary containment assessment. As reflected by the current draft of the RCRA Part B Application for FAST, the only permitted unit within FAST is container storage in the FDP Cell. Since container storage is not subject to the subpart J requirements it will not be included in the scope of this assessment.

WASTE SYSTEM DESCRIPTIONS

FSA Waste Systems-The waste systems associated with FSA are the result of water treatment for the basin water. Two vessels (VES-FT-134 and VES-FT-135) and two sumps (chemical and service waste sumps) are used to collect waste

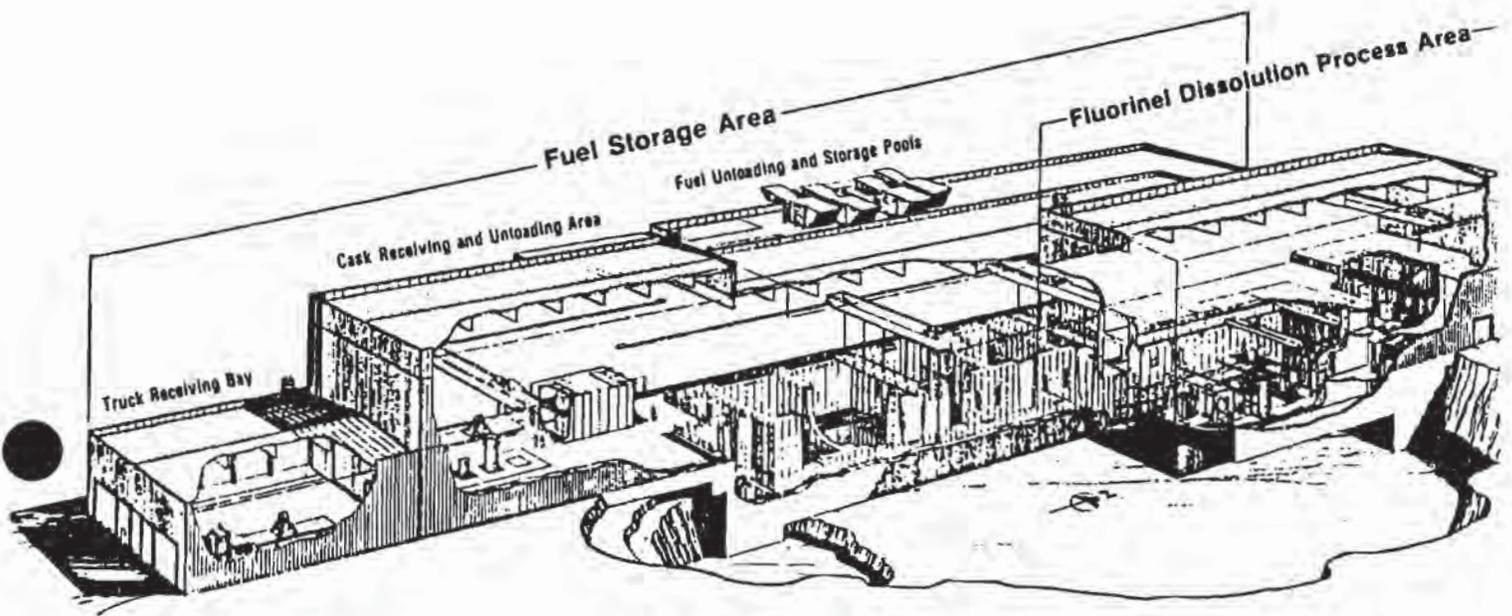

**FLUORINEL DISSOLUTION PROCESS AND
FUEL STORAGE FACILITY (cutaway view)**

Figure 1

solutions from the treatment activities. Elementary neutralization is performed in the vessels and the sumps to render the acid and caustic nonhazardous.¹ EPA has indicated that all storage and conveyance systems that are elementary neutralization units or are ancillary equipment to an elementary neutralization unit are exempted from RCRA subtitle C regulation.² Therefore further consideration of FSA waste systems from a secondary containment standpoint is not required.

FDP Waste Systems-Liquid waste can either be generated in-cell or out-of-cell. In-cell process and decontamination liquid waste is collected in the process vessels or the FDP cell sump collection tank (VES-FC-184, Slab Tank). Liquid waste from FDP operating floor drains, chemical receiving, storage, and makeup area drains, and utility sinks is collected in two waste collection tanks (VES-FA-141, -142) located outside the FDP cell in the corridor at the -31 foot elevation.

Occasionally, waste solutions are generated in the FDP cell, primarily from decontamination activities. Equipment rinse solution is collected on the stainless steel lined cell floor. The floor is sloped to a small diameter, stainless steel sump which is equipped with a liquid level detection instrument. The contents of the sump are transferred to either the slab tank or the product transfer vessel (PTV), which are both located within the stainless steel lined cell. From the in-cell vessels the waste solutions are transferred to the appropriate waste disposal facility: the process equipment waste evaporator or directly to the waste tank farm.

Each chemical makeup tank is provided with an overflow line to direct the flow of any excess solution added to the tank. The overflow lines of the tanks and the drain lines from the containment areas beneath the tanks are routed to either the fluoride collection tank (VES-FA-141) or the non-fluoride collection tank (VES-FA-142). Each of these tanks is located in a stainless steel lined containment area which is equipped with a liquid level detector. Solutions from the tanks can either be transferred to the process equipment waste evaporator, the tank farm, or drummed out for off-site disposal.

SECONDARY CONTAINMENT STANDARDS

Secondary containment systems must meet all the requirements of 40 CFR 265.193. These include:

- 1) General Design - The secondary containment must be designed, installed, and operated to prevent any migration of wastes or accumulated liquid out of the system to the soil, groundwater, or surface water [40 CFR 265.193 (b)(1)]. Any accumulated liquid wastes resulting from leaks, spills, or precipitation must be drained and removed within 24 hours [40 CFR 265.193 (c)(4)].
- 2) Type of Secondary Containment - Secondary containment for tanks must include, at a minimum, a liner external to the tank, a vault, a double-walled tank, or an approved equivalent device [40 CFR 265.193 (d)]. Examples of full secondary containment for ancillary equipment are a trench, jacketing, or double-walled piping [40 CFR 265.193 (f)].

- 3) Design Capacity - Secondary containment for tanks must be designed with the capacity to contain all of the potentially released liquid should a tank (or pipe) fail [40 CFR 265.193 (e)(1)(i), (e)(2)(i), and (e)(3)(i)].
- 4) Runoff Diversion/Moisture Barrier - The secondary containment must be designed to prevent runoff or infiltration of precipitation into the secondary containment and must be provided with an exterior moisture barrier to prevent moisture migration into the secondary containment [40 CFR 265.193 (e)(1)(ii), (e)(2)(ii), and (e)(2)(vi)].
- 5) Foundation - The secondary containment must be supported by an adequate foundation [40 CFR 265.193 (c)(2)].
- 6) Liner - The secondary containment must be constructed of or lined with materials that are compatible with the waste(s) [40 CFR 265.193 (c)(1)]. The liner must be free of cracks or gaps [40 CFR 265.193 (e)(1)(iii)] and prevent migration of waste into the concrete [40 CFR 265.193 (e)(2)(iv)].
- 7) Leak Detection - Leak detection systems must be able to detect the failure of either the primary or the secondary containment structure or any release of hazardous waste or accumulated liquid in the secondary containment system within 24 hours [40 CFR 265.193 (b)(2) and (c)(3)].
- 8) Spill Removal - Secondary containment systems must be designed or operated to remove accumulated liquids from the system within 24 hours [40 CFR 265.193(c)(4)].

SECONDARY CONTAINMENT ASSESSMENT

In 1989 the ICPP conducted an assessment of the FDP facility to determine compliance status with RCRA requirements.³ Among other requirements the assessment addressed the secondary containment requirements of 40 CFR 265.193. The assessment concluded that the requirements for secondary containment were met for all areas except the chemical receiving, storage, and makeup area drains which pass through the soil before they enter the -31 level. A discussion of the salient aspects of the secondary containment requirements follows:

Types of secondary containment - The process cell at FDP is equipped with leaktight 304L stainless steel liner systems which slope to the cell sump and which serve as secondary containment to the tanks within. The stainless steel plates conform to ASTM A240. Stainless steel angles, bars and shapes conform to ASTM A276. All liner welds were examined for leak tightness by the vacuum box method in accordance with Article 1 of Section V of the ASME Code. As described previously the sump receives some wastes directly and hence also functions as primary containment. Since the sump itself does not have secondary containment it will need to be included in the integrity assessment.

The fluoride and non-fluoride waste tanks are located inside a curbed, 304L

stainless steel lined drip pan with a capacity greater than the capacity of the largest tank.

Most of the ancillary equipment and piping for the tank systems at FAST are contained in the same cells or rooms as the waste tanks. Waste lines outside the cells are generally doubly encased in stainless steel pipe. Those piping systems that are not located within secondary containment or double encasement systems are visually inspected daily. One exception to the above are the waste drainlines from the chemical receiving, storage and preparation rooms. Some of these lines pass singly contained through the soil between where they exit the floor of the area and penetrate the wall of the main building in the -31 ft. level. Another exception is a short section of two waste transfer lines within the Product/Transfer Vault, an unlined concrete vault where the lines tie into stainless steel encased transfer lines.

Design Capacity - The secondary containment systems at FAST are designed to contain the released liquid should the tank or piping system fail. The Slab Tank, the PTV, and the ancillary piping located within the FDP Cell are but a fraction of the volume of the cell. The capacity of the lined drippan for the fluoride and non-fluoride tanks is greater than the capacity of the largest tank.

Runoff diversion/moisture barrier - Exterior concrete surfaces below grade were coated with a hot-applied bituminous dampproofing.⁴ A 6-mil polyethylene vapor barrier was installed beneath concrete slabs on grade.⁵ All construction joints in external walls and in floor slabs have waterstops.⁵ Flood protection for all the FAST equipment located below grade is provided by the natural arid features of the INEL, a flood diversion system for the Big Lost River, and the facility being designed to withstand the 4916.6 ft standard datum flood (10,000 year flood) without allowing water to enter the facility.⁶

Foundation - Support for the liner systems is provided by concrete floor slabs and foundations. The facility was designed to meet the requirements of the 1976 edition of the Uniform Building Code. In addition, the building was designed to withstand the effects of the design basis natural phenomena specified in the project design criteria.⁴ The Design Basis Earthquake (DBE) was defined to have a resultant vertical bedrock acceleration of 0.16g and horizontal acceleration of 0.24g.

Liner compatibility - Materials of construction were selected following a comprehensive materials testing program that included experimentally determining corrosion rates of the various materials using simulated process solutions^{7,8,9,10}. Use of hydrofluoric acid (HF) in the process resulted in extensive use of Hastelloy materials. Although the liners are 304L stainless steel, which is not as resistant to HF as Hastelloy materials, the corrosion rate is such that there is sufficient time to respond to any breach of the primary before the secondary containment is breached. The secondary containment for piping passing through occupied areas is provided by the respective building rooms. The floors and walls of the rooms are coated with polyamide-cured catalyzed epoxy (such as Amercoat 66).¹¹ The same principle

applies in those areas; the containment material is sufficiently resistant to any possible waste solution leakage that actions can be taken before breach of the secondary containment occurs.

Leak detection and spill removal - Leak detection is accomplished in one of two ways; 1) by visual inspection in normally occupied areas and 2) by collection in instrumented sumps for non-accessible areas. The instrumentation is a bubbler probe leak detection system with a high level alarm. Spill removal is accomplished by jetting accumulated liquids from collection sumps/vessels.

CONCLUSION

Based on the above information, the only portions of FAST that do not have secondary containment meeting the requirements of 40 CFR 265.193 are 1) the underground sections of the drainlines originating in the chemical receiving, storage, and preparation areas, 2) the sections of the waste transfer lines within the Product/Transfer Vault that are not doubly contained, and 3) the sump of the FDP Cell. Therefore, the scope of the integrity assessment for FAST will be limited to those areas.

REFERENCES

1. Fuel Handling and Storage Assessment, LFE-204-89, dated Sep 1989.
2. US EPA, Hazardous Waste Management System; Standards for Hazardous Waste Storage and Treatment Tank Systems, Federal Register Vol. 53 No. 171, September 2, 1988.
3. Fluorinel Dissolution Process Assessment, LFE-229-89, September 12, 1989.
4. Technical Specifications for Fluorinel Dissolution Process and Metal-Clad Fuels Storage Facility, Sub-division A2, Section 1, "Bituminous Dampproofing", Ralph M. Parsons Company, Rev. 1, 12/18/80.
5. Technical Specification S1.3 "Cast-in-place Concrete", Ralph M. Parsons Company, Rev. 2, 10/31/81.
6. Design Criteria for Fluorinel Process, E.H. Smith, editor, Exxon Nuclear Idaho Company, Inc., ENI-103, Rev. 5, Nov. 5, 1979.
7. R.E. Mizia, letter to J.D. Christian, "Results of Fluorinel Cyclic Corrosion Test", dated December 9, 1983.
8. R.E. Mizia, letter REM-17-84 to J.D. Christian, "Corrosion Test Results of Stainless Dissolution at Varying Temperatures", dated July 5, 1984.

9. W.J. Dirk, letter Dirk-18-84 to R.E. Mizia, "Results for Corrosion Evaluation of Hastelloy C-4 in Fluorinel Complexer Rinse Solution", dated August 3, 1984.
10. W.J. Dirk, letter Dirk-27-84 to R.E. Mizia, "Results of Immersion Corrosion Testing of Type 304L Stainless Steel in FAST Process Transfer Vessel (PTV) Solutions with Additional Chloride", dated September 10, 1984.
11. Technical Specification A4-5 "Special Coatings", Ralph M. Parsons Company, Rev. 11, 9/26/83.

INTEGRITY ASSESSMENT PLAN
FOR THE
FLUORINEL AND FUEL STORAGE FACILITY (FAST)

APRIL 1993

PREPARED BY:

CLP
C. L. PORTER, SENIOR ENGINEER
ENVIRONMENTAL COMPLIANCE PROJECTS

4-20-93

DATE

WESTINGHOUSE IDAHO NUCLEAR CORPORATION
CO-OPERATOR OF THE IDAHO CHEMICAL PROCESSING PLANT
FOR THE
U. S. DEPARTMENT OF ENERGY
IDAHO FALLS, IDAHO

**INDEPENDENT, QUALIFIED,
REGISTERED PROFESSIONAL ENGINEER
APPROVAL OF THE
INTEGRITY ASSESSMENT PLAN
FOR THE
FLUORINEL AND FUEL STORAGE FACILITY (FAST)**

**IDAHO CHEMICAL PROCESSING PLANT
IDAHO NATIONAL ENGINEERING LABORATORY
IDAHO FALLS, IDAHO**


I have reviewed this document and believe the proposed inspections, tests and analyses described herein to be sufficient for assessment of the integrity of the Fluorinel and Fuel Storage Facility (Fast). I understand the integrity assessment will be performed in accordance with this Integrity Assessment Plan, and that as the Independent, Qualified, Registered Professional Engineer (IQRPE), I will be asked to certify the report generated by this assessment. I also understand that the inspections, tests, and analyses described herein are based on currently available information and are subject to change during the performance of this assessment. As the IQRPE, I will exercise sound engineering principles in authorizing required changes to these inspections, tests, and analyses.

Stanley A. Heath
Stanley A. Heath, ETAS Corporation
Project Manager

4/20/93
Date

James S. Kilburn, P.E.
James S. Kilburn, ETAS Corporation
Idaho P. E. Registration #4504

4/20/93
Date

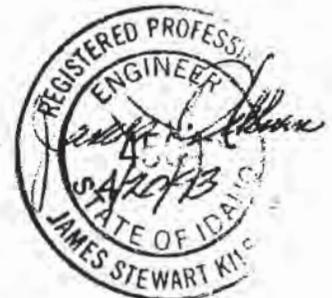

INTEGRITY ASSESSMENT PLAN
FOR THE
FLUORINEL AND FUEL STORAGE FACILITY (FAST)

INTRODUCTION

The Westinghouse Idaho Nuclear Corporation (WINCO) operates the Idaho Chemical Processing Plant (ICPP) for the United States Department of Energy (DOE). Various facilities at the ICPP handle hazardous waste as defined by the Resource Conservation and Recovery Act (RCRA). RCRA requires an integrity assessment per 40 CFR 265.191 for existing facilities which are less than 15 years old and do not have secondary containment that meets the requirements of 40 CFR 265.193. One such facility is the Fluorinel and Fuel Storage Facility (FAST).

SCOPE

The scope of this Integrity Assessment Plan (IAP) is to identify the strategy used to evaluate the integrity of the hazardous ancillary piping and equipment associated with FAST. Only those portions of the system which do not have secondary containment, as documented in the Secondary Containment Assessment for the Fluorinel and Fuel Storage Facility¹, will be included in the integrity assessment. This IAP describes the inspections, tests, rationale, and criteria for the integrity evaluation of the subject ancillary equipment.

SYSTEM DESCRIPTION

As originally designed the Fluorinel and Fuel Storage Facility (FAST) served two distinct functions at the ICPP. The Fuel Storage Area (FSA) provides facilities for receiving, preparing for storage, storing, transferring, and preparing for processing spent nuclear fuels from a variety of sources. This area is currently operating. The second function provided by FAST, the Fluorinel Dissolution Process (FDP), has not been actively operated since 1988. The FDP facilities were used to convert various spent nuclear reactor elements into a liquid feed solution for subsequent uranium recovery at other ICPP facilities.

The hazardous waste solutions generated in the FSA are only hazardous due to corrosivity. Therefore the waste solutions are treated in elementary neutralization units and are not subject to hazardous waste tank regulations.

To allow for future alternative usage of the FDP facilities the hazardous waste tank systems are being operated as <90-day generator accumulation areas. The wastes originate from various drippans and drains located throughout the facility. The collection points are two tanks in a normally occupied area and two waste tanks with an intermediate sump located within the dissolution cell. As concluded in Reference 1, the portions of the tank systems that do not have secondary containment are 1) the underground sections of the drainlines originating in the chemical receiving, storage, and preparation areas, 2) the sections of two waste transfer lines within the Product/Transfer Vault that

are not doubly contained, and 3) the sump of the FDP cell. The scope of this Integrity Assessment Plan (IAP) is therefore limited to those portions of the waste systems.

INTEGRITY ASSESSMENT APPROACH

The integrity assessment required by RCRA specifies five areas that must be considered:

1. design standards
2. hazardous characteristics of the waste
3. corrosion protection measures
4. documented age of the tank system
5. results of a leak test, internal inspection or other integrity examination.

The integrity assessment for FAST must determine if the underground drain piping and sump have sufficient structural strength and compatibility with the waste to ensure that they will not collapse, rupture, or fail under normal operating conditions. This section describes how each of the areas will be considered in the overall integrity assessment.

DESIGN STANDARDS

The design codes and standards to which FAST was built are well documented in the project documents and drawings. The integrity assessment will summarize the results of a review of the project documentation relative to the design codes and standards.

HAZARDOUS CHARACTERISTICS OF WASTE

The original process flowsheets guided the materials selection for the design. Future alternative uses must be enveloped by the original design basis. Additionally, since the waste tank systems were included on the original RCRA Part A permit various RCRA documents cover the hazardous characteristics of the waste.^{2,3} These sources of information will be used to address the waste characteristics and the compatibility of the materials of construction.

CORROSION PROTECTION MEASURES

Corrosion protection of the subject ancillary equipment is limited to the selection of corrosion resistant materials of construction, consequently the integrity assessment document will address this area as part of the materials compatibility discussion.

DOCUMENTED AGE OF TANK

The age of the system is known and documented, both in the original project documentation and in subsequent correspondence from the Environmental Department of WINCO. These documents will be utilized to cover this aspect of the integrity assessment.

INTEGRITY EXAMINATIONS

The FDP ancillary piping under consideration are portions of primarily gravity drain systems and as such have limited capabilities for isolation. Consequently, performing a leak test on selected portions of the systems is not possible without adding numerous isolation valves. Performing a leak test of the subject piping by filling the entire system would generate large quantities of mixed waste unnecessarily and would be at odds with waste minimization efforts. Since FAST is a relatively new facility (8-1/4 years old) with a known usage history, it is well suited for an integrity evaluation other than a leak test.

For the piping this integrity evaluation is based on three assumptions. First, any threat to underground piping is internal, not external, i.e., corrosion of the piping will be more severe from the internal contents than from the exposure to the underground environment. Second, that process knowledge is sufficient to determine "worst case" portions of the respective systems. As long as the "worst case" areas are intact the other piping within the system would be intact. Third, that corrosion of the subject systems is uniform.

The first assumption is supported by a knowledge of corrosion mechanisms and the nature of the internal solutions vs. the external environment. The assumption was validated during the integrity assessment of the Remote Analytical Laboratory (RAL), a facility with underground stainless steel drainlines built during the same time period as FAST. The validity of the second assumption will be confirmed as the process knowledge is compared between different lines. If a clear "worst case" section cannot be determined then a statistically determined sampling of piping will be examined for integrity. The third assumption is based on the fact that the drain systems are not subject to turbulent fluid flow conditions with abrasive particles. Therefore erosion at elbows and bends is not a concern. The primary mechanism of corrosion is attack of the pipe wall by the internal fluid. The result of that mechanism is uniform corrosion.

Ultrasonic wall thickness measurements will be taken at locations determined by the "worst case" analysis. The thickness measurements will be compared against original design wall thickness to determine integrity.

The integrity of the dissolution cell sump will be determined by a standing water leak test. Since the sump is in a remote, high radiation area, the leak test is the simplest and most direct way to evaluate integrity. The sump is instrumented with a level detector. A level will be established and recorded. Once the test begins all sources of input will be secured as well as transfers from the sump. As long as the decline over a two week period does not exceed the established evaporation rate the test will be considered successful.

QUALITY ASSURANCE

The ultrasonic testing will be performed by qualified personnel from the Quality and Performance Assurance Department (QA) of WINCO. The leak test of the in-cell sump will be conducted by trained and qualified operators of the

process equipment. The level of quality of the historical data is governed by the formal quality program plan of the project that designed and built the facility, and the quality controls on the operation of the process.

REFERENCES

1. C.L.Porter, "Secondary Containment Assessment for the Fluorinel and Fuel Storage Facility (FAST), WINCO, April 1993.
2. RCRA Interim Status Waste Analysis Plan for the FAST Facility, WAP-FAST, Rev 0, October 1990.
3. Draft RCRA Closure Plan for the Fluorinel Dissolution Process Waste Tanks at the Idaho National Engineering Laboratory, CLO-FDPW, Rev 0, September 1992.

INTEGRITY ASSESSMENT DOCUMENT
FOR THE
FLUORINEL AND FUEL STORAGE FACILITY (FAST)

APRIL 1993

PREPARED BY:

C. L. Porter
C. L. PORTER, SENIOR ENGINEER
ENVIRONMENTAL COMPLIANCE PROJECTS

4-20-93

DATE

WESTINGHOUSE IDAHO NUCLEAR CORPORATION
CO-OPERATOR OF THE IDAHO CHEMICAL PROCESSING PLANT
FOR THE
U. S. DEPARTMENT OF ENERGY
IDAHO FALLS, IDAHO

INTEGRITY ASSESSMENT DOCUMENT
FOR THE
FLUORINEL AND FUEL STORAGE FACILITY (FAST)

INTRODUCTION

The Westinghouse Idaho Nuclear Corporation (WINCO) operates the Idaho Chemical Processing Plant (ICPP) for the United States Department of Energy (DOE). Various facilities at the ICPP handle hazardous waste as defined by the Resource Conservation and Recovery Act (RCRA). RCRA requires an Integrity Assessment per 40 CFR 265.191 for existing facilities that do not have secondary containment meeting the requirements of 40 CFR 265.193. A Secondary Containment Assessment¹ was performed for FAST to determine those portions of the hazardous waste systems of the facility that required an Integrity Assessment. An Integrity Assessment Plan² was formulated for the evaluation of the integrity of the ancillary piping and equipment identified in Reference 1. The results of the testing and evaluation are reported in this document.

SCOPE

Reference 1 concluded that the only portions of the FAST hazardous waste systems that do not have secondary containment meeting the requirements of 40 CFR 265.193 are 1) the underground sections of the drainlines originating in the chemical receiving, storage, and preparation areas, 2) the sections of the waste transfer lines within the Product/Transfer Vault that are not doubly contained, and 3) the sump of the Dissolution Cell. Therefore, the scope of this Integrity Assessment is limited to those three areas.

SYSTEM DESCRIPTION

GENERAL

FAST is located in building CPP-666. The facility is comprised of two separate operating areas, the Fuel Storage Area (FSA) and the Fuel Dissolution Process (FDP) area. The FSA portion is in active operation while the FDP portion of the facility is inactive due to the DOE change in mission. The original RCRA interim status documentation for FAST included two hazardous waste tank systems associated with FSA and three systems associated with FDP. The tank systems associated with FSA have subsequently been reclassified as elementary neutralization units and therefore are not subject to the hazardous waste tank regulations, subpart J of 40 CFR 264 and 265. The hazardous waste tank systems within the FDP area are currently awaiting approval of the RCRA closure plan. Following RCRA closure the units will be operated as <90-day generator accumulation areas. To allow for flexibility in potential alternate applications for the FDP area, the liquid waste systems, although not included in the RCRA Part B Application, are included in the scope of this integrity assessment.

The following discussion will focus on the FDP hazardous liquid waste systems. The operations described, although not currently performed at the facility, envelope any potential uses of the facility, relative to this integrity assessment.

FDP PROCESS

The FDP is a batch process which converts spent nuclear reactor fuel elements into a liquid feed solution for subsequent uranium recovery at other ICPP facilities. Typical processing steps which take place within the shielded dissolution cell are summarized as follows:

1. An irradiated Fuel Handling Unit (FHU - one or more pieces of fuel assembled in a fuel handling fixture) is transferred to the FDP cell from FSA; fuel may be placed in an interim storage rack before it is charged.
2. The fuel may be measured for uranium content in the delayed neutron interrogator.
3. The FHU is charged to a dissolver.
4. The fuel is dissolved in the dissolvers with hydrofluoric (HF) acid. Toward the end of the dissolution process, nitric acid is added for final dissolution in complexers. Aluminum nitrate is added to complex free-fluoride ions and to prepare the product for subsequent uranium recovery.
5. After dissolution, all but a small heel of solution is transferred from the dissolver to the complexer. The dissolver is then flushed to the complexer with cadmium containing water for criticality safety. The solution is adjusted for nitrate with additional nitric acid and sampled for uranium and free HF. If necessary, the solution is adjusted for free HF to maintain corrosion control and solution stability.
6. The dissolved product is transferred to the Product Transfer Vessel (PTV). The dissolver and complexer vessels are flushed with cadmium-poisoned water in successive cycles in which the dissolver and complexer vessels are rinsed several times. Each flush is transferred to the PTV.
7. The dissolver product in the PTV is sampled for uranium accountability purposes.
8. The dissolved product is transferred from the PTV to CPP-601 for uranium recovery operations.

LIQUID WASTE SYSTEMS

The liquid waste handling system is comprised of three separate systems. The high fluoride liquid wastes are collected in VES-FA-141. The non-fluoride liquid wastes are collected in VES-FA-142. Radioactive liquid wastes are collected in the three vessels in the FDP cell, the sump, VES-FC-184 (Slab

Tank), and VES-FC-147 (PTV). The system contains equipment for the collection of all liquid wastes produced during reagent makeup, fuel processing, and decontamination or cleanup operations. Because the FDP contains no waste treatment or disposal facilities, each of the liquid waste systems includes equipment to transfer the FDP waste to existing ICPP waste treatment facilities.

Liquid wastes handled by the high fluoride liquid waste system are nonradioactive liquid wastes containing either HF or fluoboric (HBF₄). These wastes are collected from FM Area vessels, piping, and pumps used in the HF makeup and feed system. The piping and equipment for this system are primarily fabricated from Hastelloy C-4. The wastes include: out-of-specification reagent solutions that cannot be adjusted to meet process requirements; leaks from FM Area piping, pumps, and vessels; and waste produced when FM Area equipment is drained for maintenance or repairs. All the waste streams drain to two collection headers which drain to VES-FA-141 (see Table 1). Aluminum nitrate is added to VES-FA-141 to complex excess fluoride, limiting corrosion of downstream stainless steel piping and treatment facilities.

TABLE 1 - HIGH FLUORIDE WASTE SOURCES FOR VES-FA-141

Waste Collection Header	Vessels, Equipment, or Drains
1-1/2"-XW-HC-0528	Scrubber SCR-FH-180 Scrubber pump P-FH-280 Overflows from HF Tanks VES-FM-156, -166 Overflows from recirc/transfer pumps P-FM-256, -266 Drain line for HF distribution header HF-HC-6064
2"-XW-HC-1143	Drains under VES-FM-156 and -166

The non-fluoride liquid waste system collects and transfers waste from numerous areas throughout the FDP. These areas include the FM Area, corridor and open area floor drains, and drainage wastes from service sinks located at various levels in the FDP. The drains feed two collection headers which drain to VES-FA-142 (see Table 2).

TABLE 2 - NON-FLUORIDE WASTE SOURCES FOR VES-FA-142

Waste Collection Header	Vessels, Equipment, or Drains
4"-XW-AD-0530	6 drains located under walkway (Rm. 114B) 2 drains in chemical storage area (Rm. 116) 2 drains in Rm. 114A 2 floor drains (Rm. 114C) 1 drain in loading/loadout area (Rm. 115) 4 drains in the east corridor (one per level) 4 drains in the west corridor (one per level) Utility sink drains in the northwest corridor (3 levels)
4"-XW-AD-0529	Drains for VES-FM-103,-151,-152,-157,-158,-161,-162, and -167 Drains for pumps P-FM-201,-204,-251,-252,-257,-258,-261,-262, and -267 Drain lines for poison water (PW) headers Drain for HE-FM-305 Drain for mist eliminator DM-FM-404 Condensate drain line from 4"-HS-NC-7575-1 Drain line from sump pump P-FM-279B

Although the primary function of the PTV is to transfer complexed dissolver product to CPP-601, it also serves as one of two subsystems for handling radioactive liquid wastes. The dissolution cell sump and the sump hold tank or Slab tank is the other. All wastes from the process equipment in the cell are collected in the PTV and transferred to the appropriate disposal system. Other wastes generated in the cell, such as leakage and decontamination solutions are collected in the cell sump and transferred to the Slab tank for sampling prior to transferring them to the process or to CPP-601 for disposal. The wastes are of two general types: those with high fluoride content and those containing no fluoride. Table 3 shows the sources of liquid waste for the dissolution cell sump.

TABLE 3 - LIQUID WASTE SOURCES FOR CELL SUMP

Type of Drain	Source of Area, Equipment, or Pump Drains
Area Drains	Liquid sample cell drains H ₂ /O ₂ analyzer drain Crane maintenance area floor drain Waste loadout room, B-4
Equipment Drains	Neutron interrogator drain Transmitter enclosure drains Interim storage tubes Crane door drains
Pump Drains	P-FC-216, DOG scrubber P-FC-226, DOG scrubber P-FC-236, DOG scrubber P-FC-247, PTV pump P-FC-248, PTV pump

INTEGRITY ASSESSMENT

The Integrity Assessment required by RCRA specifies five areas that must be considered:

1. Design Standards
2. Hazardous Characteristics of the Waste
3. Corrosion Protection Measures
4. Documented age of the Tank System
5. Results of a leak test, internal inspection or other integrity examination.

In accordance with the Integrity Assessment Plan², this section summarizes the consideration of each of the above areas relative to the integrity of the subject piping.

DESIGN STANDARDS

Construction drawings and design specifications for FAST were developed by the Ralph M. Parsons Company, as part of the FAST Project, and approved by the ICPP operating contractor (EXXON Nuclear Company, Inc.). These documents were developed in accordance with the FAST Project Design Criteria (PDC)³.

Structural requirements of the PDC included a building design life of 40 years and a 20 year design life for the FDP; that all new construction be designed to meet the requirements of the Uniform Building Code (1976 Edition); and that the building, safety related systems, and all essential mechanical equipment and supports be designed to withstand the effects of the design basis natural phenomena as defined in the PDC. The Design Basis Earthquake (DBE) was defined

to have a resultant vertical bedrock acceleration of 0.16g and horizontal acceleration of 0.24g.

Design, construction, testing, and operation of the facility was required by the PDC "To be in compliance with the current DOE-ID Engineering Standards and other DOE, Federal, State, local, and national consensus regulations, standards, and codes...". Piping and valves were designed and installed in accordance with applicable sections of the ASME/ANSI B31.1, "Power Piping".

The Design Criteria, drawings, and specifications, together with the QA Inspection documentation from the construction activity, adequately document that the FAST liquid waste handling systems have sufficient structural strength to ensure that they will not collapse, rupture, or fail under normal operating conditions.

HAZARDOUS CHARACTERISTICS OF THE WASTE

From a materials compatibility standpoint the hazardous characteristics of the wastes that are of primary concern result from the reagents used in the dissolution process. Table 4 provides details of the process solutions:

TABLE 4 - STOCK SOLUTIONS AND PROCESS REAGENTS FOR FDP⁴

STOCK SOLUTIONS	PROCESS REAGENTS
44 M hydrofluoric acid (HF)	HF dissolvent (13.3 M HF, 10.8 g/l boron)
2.2 M aluminum nitrate	HNO ₃ dissolvent [13 M HNO ₃ , 0.214 M Cd(NO ₃) ₂]
cadmium sulfate (CdSO ₄)	aluminum nitrate solution [2.2 M Al(NO ₃) ₃ , 0.214 M Cd(NO ₃) ₂]
13.2 M nitric acid	Cd-poisoned water (heel and rinse water) (0.214 M CdSO ₄)
cadmium nitrate [Cd(NO ₃) ₂]	zirconium carbonate solution [29% wt ZrO ₂ CO ₂ , 13 M HNO ₃ , 4 M Cd(NO ₃) ₂]
1.8 M zirconium nitrate [Zr(NO ₃) ₄]	*H ₂ SO ₄ dissolvent (17.35 M H ₂ SO ₄ , 0.214 CdSO ₄)
*17.35 M sulfuric acid (H ₂ SO ₄)	

* only used during cold operation

From a RCRA standpoint the waste codes associated with the tank systems are D002 (pH), corrosive hazard from the acids and D006 (cadmium), toxic hazard. Although the reagents listed in Table 4 may not be the exact solutions used in future alternative uses of the facility they certainly envelope any possibilities. Therefore, they are the basis for the materials compatibility evaluation.

CORROSION PROTECTION MEASURES

Several design and operating features combine to ensure integrity from a corrosion protection standpoint. As detailed in Reference 1 the materials of construction were selected following an extensive materials testing program based on the process flowsheets. The corrosive nature of the reagents was the basis for the selection of respective types of corrosion resistant materials. The systems that handle HF utilize Hastelloy C-4 for the piping. All other waste piping is constructed of 304L stainless steel. The materials selection is supplemented with procedural requirements to complex the free-HF before it is transferred out of Hastelloy C-4 equipment and into 304L stainless steel equipment which is less resistant to HF. Protection from exterior corrosion is provided by corrosion resistant coatings (high density polyethylene) applied to the exterior surfaces of piping in direct buried service.⁵ Cathodic protection was also required for underground piping.⁶

The combination of corrosion resistant materials, external corrosion protection measures, and operating procedures ensures that the subject systems will not collapse, rupture, or fail under normal operating conditions.

DOCUMENTED AGE OF THE TANK SYSTEM

The age of an ICPP RCRA Tank System is defined as the date of first service for its intended purpose. This includes initial cold chemical operations. The FDP first operated in December of 1984. Therefore the documented age of the tank systems is 8-1/4 years. The start date is documented in WINCO letter, ECT-25-92,⁷ dated September 8, 1992. It should be noted that the FDP process has not been operated since 1988.

INTEGRITY EXAMINATION

As noted in the Integrity Assessment Plan, the FDP has had limited and well known usage since its construction. It is basically a new facility. The initial integrity of the subject waste systems were demonstrated by the initial hydrostatic and pneumatic testing following construction. To confirm current integrity, all of the lines feeding the respective tank systems were evaluated for "worst case" usage. Worst case was clearly 2"-XW-HC-1143 due to the fact that a dolomite plug in the drippan drain for VES-FM-166 occurred in 1989. To clear the plug an aggressive ammonium nitrate/nitric acid solution was used. When the plug was dissolved the line was rinsed 3 times to VES-FA-141. Ultrasonic thickness measurements were therefore taken just below the subject drain and where the pipe is first accessible after exiting from the underground in the overhead of the -31' level. Attachments 1 and 2 give the results of ultrasonic (UT) thickness measurements. Due to easy access of most of the waste piping additional measurements were taken to validate the assumption that any corrosion would be uniform. Attachment 3 compares the UT results with the nominal wall thicknesses. With the exception of some of the readings on the "worst case" pipe, all readings are within the 12.5% manufacturing tolerance for new pipe or fittings. In the drain region of 2"-XW-HC-1143 a 1% wall loss is indicated. On the 304L side of the transition

from Hastelloy a significant wall loss of about 50% is indicated. Additional readings (Attachment 4) were taken to confirm that a portion of the original 304L piping remained in service when a later modification tied 2"-XW-HC-1143 into 1-1/2"-XW-HC-0528. Since the tie-in required a loop over an adjacent 4" line a P-trap was effectively added to the system. The retention of the 304L section with reduced wall provides a weak link that ensures failure within a secondarily contained area before a failure in the underground portion of piping. This 304L SS section of pipe does not require integrity assessment because it is entirely within the -31' level room, which provides the required secondary containment.

Attachment 5 contains the results of the leak test on the sump. The data shows that the level remained constant, within the accuracy of the level instrumentation, for the two week test period.

CONCLUSIONS

Based on the background information reviewed and summarized in the foregoing sections, together with the results of the integrity examinations, it is concluded that the integrity of the subject piping is sufficient to ensure that it will not collapse, rupture, or fail under normal operating conditions.

REFERENCES

1. C.L. Porter, "Secondary Containment Assessment for the Fluorinel and Fuel Storage Facility (FAST)", WINCO, April 1993.
2. C.L. Porter, "Integrity Assessment Plan for the Fluorinel and Fuel Storage Facility (FAST)", WINCO, April 1993.
3. Design Criteria for Fluorinel Process, E.H. Smith, editor, Exxon Nuclear Idaho Company, Inc., ENI-103, Rev. 5, November 5, 1979.
4. Draft RCRA Closure Plan for the Fluorinel Dissolution Process Waste Tanks at the Idaho National Engineering Laboratory, CLO-FDPW, Rev. 0, WINCO, 9/8/92.
5. Technical Specifications for Fluorinel Dissolution Process and Metal-Clad Fuels Storage Facility, Sub-division P-06, "Coating and Wrapping of Direct Buried Piping", Ralph M. Parsons Company, Rev.0, 4/26/79.
6. Technical Specification E-9, "Cathodic Protection", Ralph M. Parsons Company, Rev. 11, 3/9/82.
7. E.C.Thiel, letter ECT-25-92 to J.E. Kaylor, "Ages of RCRA Tank Systems", dated September 8, 1992.

Form WINCO-7025 (10/92)		QUALITY INSPECTION REPORT																																																																							
IR#: IR 93-018	SUBJECT: Drain Line UT Thickness Measurement	ADDRESSEE: Tom Byrnes MS-5114																																																																							
Page 1 of: 1	PROJECT EA#/WORK ORDER/PURCHASE ORDER: W.O. 150104	EQUIPMENT/SYSTEM/LOCATION: VES-FM-152/166 @ CPP-666 Rm-114B																																																																							
OBSERVATION/DESCRIPTION:																																																																									
<p>The above referenced work order requested RCRA assessment of VES-FM-152 and VES-FM-166 drain lines using UT thickness measurement. The drains were 2" Hasteloy and 4" 304 SST.</p> <p>Visual inspection of the drain internals revealed no scale or other associated corrosion products. Liquid was present in both lines in the "P" trap area. The side walls above the trap were dry. UT thickness measurements were obtained using a Panametrics model 26DL thickness tester ser.# 0158112 and a 0.20" 10 MHz transducer, model D973 ser.# 129016. The unit was calibrated before and after use using a 304L SST step wedge ser.# 0305 and a Hasteloy C-4 step wedge ser.# 704104. Readings were taken at 90 degree intervals around the inside circumference at 6" depth increments. Reference points were North, East, South, and West. The following measurements were obtained:</p> <table border="0"> <tr> <td>2" Hasteloy</td> <td>6"</td> <td>(N)</td> <td>0.192</td> <td>(E)</td> <td>0.190</td> <td>(S)</td> <td>0.193</td> <td>(W)</td> <td>0.188</td> </tr> <tr> <td></td> <td>12"</td> <td></td> <td>0.190</td> <td></td> <td>0.194</td> <td></td> <td>0.188</td> <td></td> <td>0.188</td> </tr> <tr> <td></td> <td>18"</td> <td></td> <td>0.189</td> <td></td> <td>0.184</td> <td></td> <td>0.186</td> <td></td> <td>0.192</td> </tr> <tr> <td>4" 304 SST</td> <td>6"</td> <td>(N)</td> <td>0.252</td> <td>(E)</td> <td>0.241</td> <td>(S)</td> <td>0.251</td> <td>(W)</td> <td>0.248</td> </tr> <tr> <td></td> <td>12"</td> <td></td> <td>0.250</td> <td></td> <td>0.252</td> <td></td> <td>0.251</td> <td></td> <td>0.247</td> </tr> <tr> <td></td> <td>18"</td> <td></td> <td>0.253</td> <td></td> <td>0.233</td> <td></td> <td>0.254</td> <td></td> <td>0.249</td> </tr> <tr> <td></td> <td>24"</td> <td></td> <td>0.252</td> <td></td> <td>0.235</td> <td></td> <td>0.250</td> <td></td> <td>0.254</td> </tr> </table> <p>Measurements were not taken at the 24" level in the 2" pipe because of concerns of wetting the probe with liquid from the "P" trap.</p>				2" Hasteloy	6"	(N)	0.192	(E)	0.190	(S)	0.193	(W)	0.188		12"		0.190		0.194		0.188		0.188		18"		0.189		0.184		0.186		0.192	4" 304 SST	6"	(N)	0.252	(E)	0.241	(S)	0.251	(W)	0.248		12"		0.250		0.252		0.251		0.247		18"		0.253		0.233		0.254		0.249		24"		0.252		0.235		0.250		0.254
2" Hasteloy	6"	(N)	0.192	(E)	0.190	(S)	0.193	(W)	0.188																																																																
	12"		0.190		0.194		0.188		0.188																																																																
	18"		0.189		0.184		0.186		0.192																																																																
4" 304 SST	6"	(N)	0.252	(E)	0.241	(S)	0.251	(W)	0.248																																																																
	12"		0.250		0.252		0.251		0.247																																																																
	18"		0.253		0.233		0.254		0.249																																																																
	24"		0.252		0.235		0.250		0.254																																																																
INSPECTOR/DATE: <i>A. Kluniger</i> 2/11/93		SUPERVISOR/DATE: <i>[Signature]</i> 2/11/93																																																																							
ADDRESSEE RESPONSE REQUIRED: <input type="checkbox"/> YES <input checked="" type="checkbox"/> NO		DISTRIBUTION: ADDRESSEE QE FILE J. Roberts N. PORTER																																																																							
ADDRESSEE REMARKS/RESPONSE:																																																																									
NCR REQUIRED: <input type="checkbox"/> YES <input type="checkbox"/> NO		(ADDRESSEE/RESPONDER) NAME/DATE:																																																																							
DISTRIBUTION: INSPECTOR																																																																									

QUALITY ASSURANCE
ULTRASONIC EXAMINATION REPORT



FORM WINGO-7101 (10-84)

Inspection Plan No. <i>NA</i>		Identification <i>304L & Hastalloy CH</i>		Material Type <i>Sec. 192</i> of <i>6</i>		Thickness <i>To be determined</i>		Surface Condition <i>Factory Smooth</i>				
Equipment Type and Number <i>Pins 26DL s/n 158112</i>		Couplant <i>Sonotech</i>		Calibration Reference Block No. <i>3042</i>		Material Type <i>NA</i>		Procedure <i>8.9.6</i>				
Saddles, Wedges, or Shoes (Where Applicable) <i>NA</i>		Scanning Mechanism (Where Applicable) <i>NA</i>		Material Type <i>NA</i>		Scanning Method <i>Static</i>		Scanning Level <i>NA</i>				
Item/Component Description <i>See Attached Sheet</i>		Scanning Mechanism (Where Applicable) <i>NA</i>		Calibration Start <i>0900</i> , 1000, 1100		Finish <i>1230, 1400</i>						
SKETCH OF ITEM INSPECTED (Where Applicable)												
<p><i>See Attached Sheets for Thickness Readings & Sketch of Pipe.</i></p> <p><i>Note 1 Add dimensions in Inches</i></p> <p><i>Note 2 Location of UT Readings marked on Pipe</i></p>												
Instrument Settings (Where Applicable)												
Frequency	<i>NA</i>											
Pulse Length/Energy												
Material/Sweep Delay												
Test Range/Sweep Length												
Suppression/Reject												
Swept Gain/DAC Curve												
Calibrated Gain in db												
Uncalibrated Gain												
Reject Level/Limit												
Reference Level												
Tran. Mode												
Search Units (Where Applicable)												
Brand	<i>Panometrics</i>											
Serial Number	<i>128908</i>											
Nominal Angle	<i>Normal</i>											
Size	<i>0.20"</i>											
Nominal Freq. (MHZ)	<i>5.0 MHZ</i>											
Disposition:	<input type="checkbox"/> Accept	<input type="checkbox"/> Reject	<input type="checkbox"/> Acceptance Standard Used	<i>NA</i>						QA Inspector <i>[Signature]</i>	Level <i>IV</i>	Date <i>7/29/92</i>
Remarks: <i>Thickness Test for Base line Data.</i>												
QA Supervisor <i>[Signature]</i>			Date <i>7/21/92</i>			Distribution: <i>T. Byrnes, C.L. Baxter, J.E. Kaylor</i>			File			

NOTEGRAM

DATE: FEBRUARY 18, 1992

TO: B.J. ARCHIBALD
FROM: C.L. PORTER
SUBJECT: UT MEASUREMENTS FOR FDP INTEGRITY ASSESSMENT

THE HAZARDOUS WASTE LINES AT FDP NEED TO BE ASSESSED FOR INTEGRITY. IN ORDER TO DETERMINE THE AMOUNT OF NDE NECESSARY TO PROPERLY PERFORM THE INTEGRITY ASSESSMENT SOME PRELIMINARY WALL THICKNESS MEASUREMENTS ARE NEEDED. THE INITIAL LOCATIONS ARE SUMMARIZED BELOW:

<u>LINE NUMBER</u>	<u>MATERIAL</u>	<u>APPROX. LOCATION</u>
2"-XW-HC-121143	HASTELLOY C-4 SCHEDULE 80S	-31 FT LEVEL WHERE PIPE EXITS WALL
1"-XW-HC-120519	HASTELLOY C-4 SCHEDULE 80S	PIPING ON BOTH SIDES OF VALVE V-FO-8058
1"-XW-HC-120518	HASTELLOY C-4 SCHEDULE 80S	PIPING ON BOTH SIDES OF VALVE V-FO-8057
1 1/2"-XW-HC-120528	HASTELLOY C-4 SCHEDULE 80S	NEAR 121143 TIE-IN AND ALSO NEAR TANK END.
1 1/2"-XW-AD-121134	304L SS SCHEDULE 40S	JUST PRIOR TO WALL PENETRATION INTO VALVE CUBICLE (-13FT LEVEL)
1"-XW-AD-128425	304L SS SCHEDULE 40S	SAME AREA AS LINE 121134
4"-XW-AD-120529	304L SS SCHEDULE 40S	NEAR WALL PENETRATION AND ALSO NEAR TANK END (-31FT LEVEL)
3"-XW-AD-121145	304L SS SCHEDULE 40S	-31FT LEVEL UTILITY SINK DRAIN


CONTACT TOM BYRNES, 6-3308, FOR SPECIFIC LOCATIONS.

THE CHARGE NUMBER FOR THIS WORK IS 15970-700-131.

PLEASE DOCUMENT THE EXACT LOCATIONS IN THE EVENT THESE MEASUREMENTS NEED TO BE REPEATED IN SUBSEQUENT YEARS.

TO SUPPORT THE CURRENT SCHEDULE FOR THE ASSESSMENT WE NEED THESE PRELIMINARY WALL THICKNESS MEASUREMENTS BY 2/21/92.

cc: T. R. BYRNES
J. A. DOWALO
J. E. KAYLOR

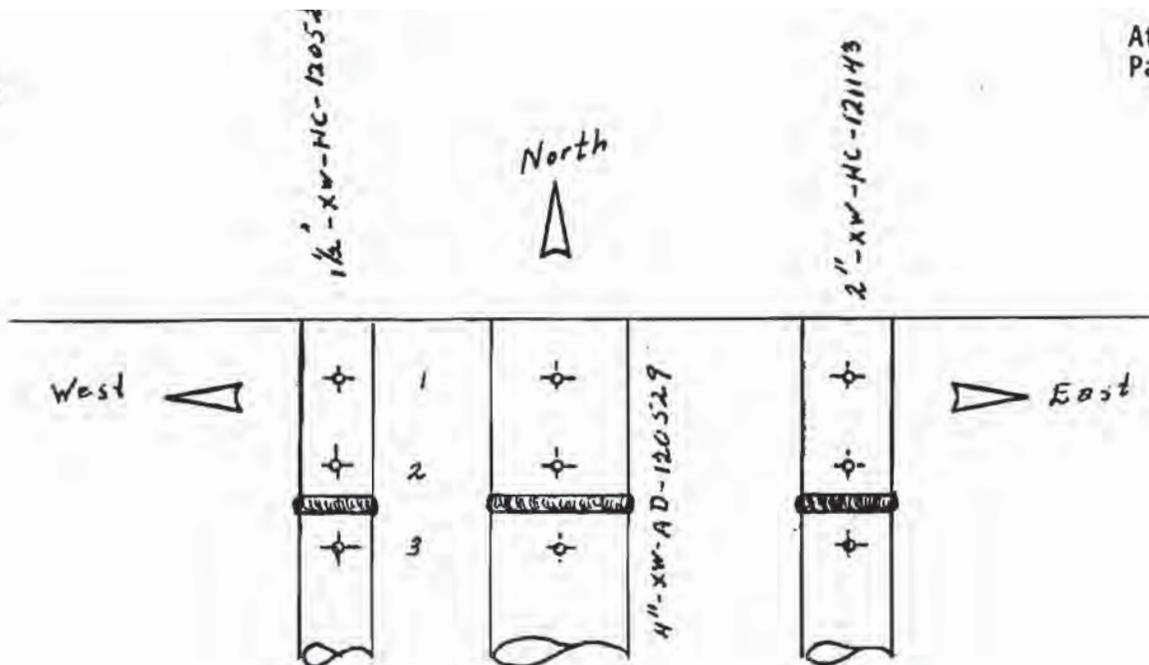

	TOP	EAST	BOT	WEST
1	0.352	0.352	0.352	0.350
2	0.352	0.355	0.354	0.357
3	0.123	0.092	0.093	0.138


PIPE 1143

1	0.245	0.243	0.243	0.250
2	0.250	0.249	0.247	0.250
3	0.263	0.260	0.263	0.260

PIPE 1529

1	0.299	0.298	0.301	0.301
2	0.300	0.298	0.300	0.303
3	0.199	0.197	0.198	0.200

PIPE 0528

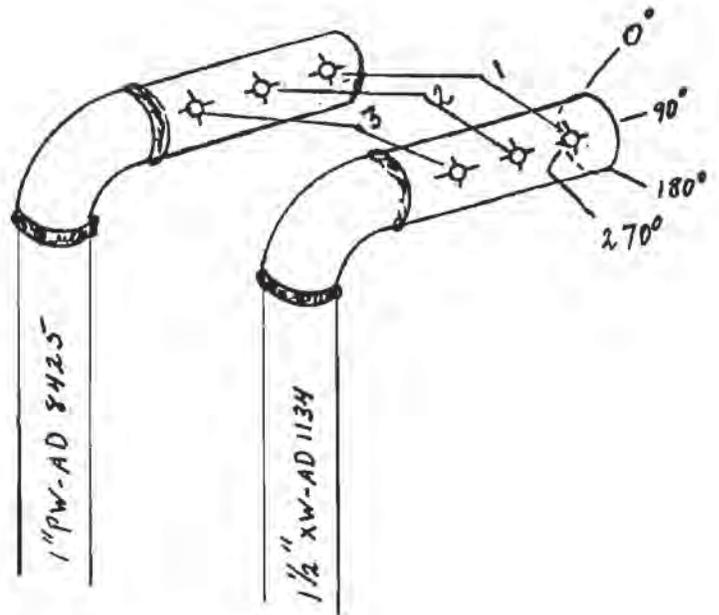


0° 90° 180° 270°

1	0.135	0.135	0.128	0.130
2	0.135	0.133	0.131	0.130
3	0.136	0.135	0.128	0.136

Pipe 8425


Pipe 1134

1	0.139	0.148	0.146	0.148
2	0.140	0.147	0.145	0.141
3	0.141	0.148	0.145	0.142

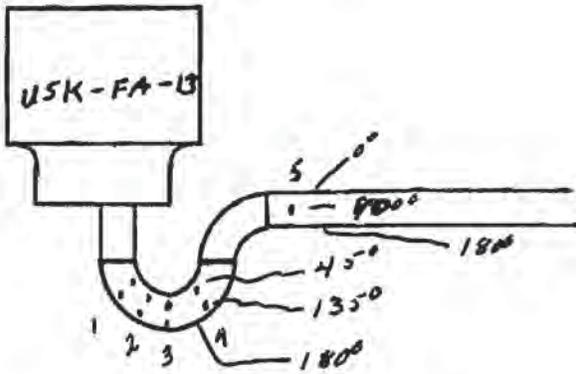


	45°	135°	180°	270°
1	0.277	0.246	0.226	0.240
2	0.285	0.247	0.222	0.255
3	0.264	0.243	0.222	0.288
4	0.258	0.262	0.225	0.252


	0°	90°	180°	270°
5	0.215	0.212	0.213	0.210

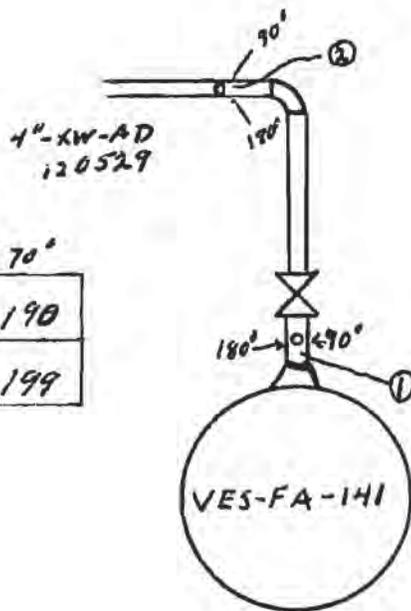

	0°	90°	180°	270°
1	0.192	0.204	0.196	0.198
2	0.198	0.198	0.196	0.199

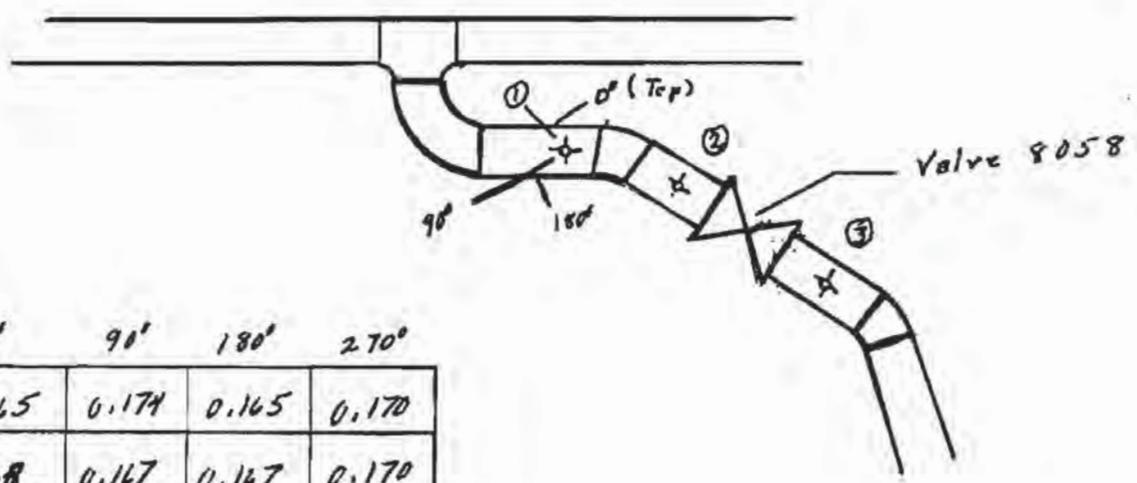

	0°	90°	180°	270°
1	0.165	0.174	0.165	0.170
2	0.168	0.167	0.167	0.170
3	0.174	0.174	0.177	0.170

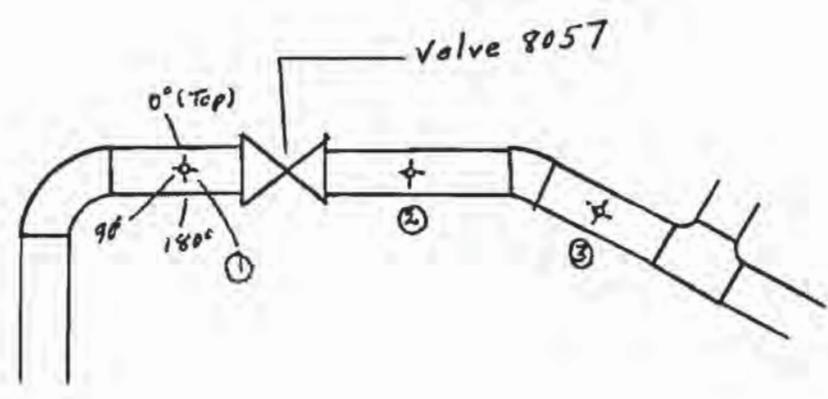

	0°	90°	180°	270°
1	0.174	0.176	0.176	0.178
2	0.175	0.181	0.177	0.177
3	0.180	0.180	0.178	0.181

FDP INTEGRITY ASSESSMENT DATA REDUCTION

						AVE	NOMINAL	% REDUCTION
2" NASTALLOY	6"	0.192	0.190	0.193	0.188	0.191	0.218	12.50%
	12"	0.190	0.194	0.188	0.188	0.190	0.218	12.84%
	18"	0.189	0.184	0.186	0.192	0.188	0.218	13.88%
4" 304 SS	6"	0.252	0.241	0.251	0.248	0.248	0.237	-4.64%*
	12"	0.25	0.252	0.251	0.247	0.250	0.237	-5.49%*
	18"	0.253	0.233	0.254	0.249	0.247	0.237	-4.32%*
	24"	0.252	0.235	0.25	0.254	0.248	0.237	-4.54%*
2"-XW-HC-1143		0.352	0.352	0.352	0.35	0.352	0.344	-2.18%*
		0.352	0.355	0.354	0.351	0.353	0.344	-2.62%*
		0.123	0.092	0.093	0.138	0.112	0.218	48.85%
4"-XW-AD-0529		0.245	0.243	0.243	0.25	0.245	0.237	-3.48%*
		0.25	0.249	0.247	0.25	0.249	0.237	-5.06%*
		0.263	0.26	0.263	0.26	0.262	0.237	-10.34%*
1-1/2"-XW-HC-0528		0.299	0.298	0.301	0.301	0.300	0.281	-6.67%*
		0.3	0.298	0.3	0.303	0.300	0.281	-6.85%*
		0.199	0.197	0.198	0.2	0.199	0.200	0.75%*
1"-XW-AD-8425		0.135	0.135	0.128	0.13	0.132	0.133	0.75%*
		0.135	0.133	0.131	0.13	0.132	0.133	0.56%*
		0.136	0.135	0.128	0.13	0.132	0.133	0.56%*
1-1/2"-XW-AD-1134		0.139	0.148	0.146	0.14	0.143	0.145	1.21%*
		0.14	0.147	0.145	0.141	0.143	0.145	1.21%*
		0.141	0.148	0.145	0.142	0.144	0.145	0.69%*
UTILITY SINK P-TRAP		0.277	0.246	0.226	0.24	0.247	0.216	-14.47%*
		0.285	0.247	0.222	0.255	0.252	0.216	-16.78%*
		0.264	0.243	0.222	0.28	0.252	0.216	-16.78%*
		0.258	0.262	0.225	0.251	0.249	0.216	-15.28%*
		0.215	0.212	0.213	0.21	0.213	0.216	1.62%*
1-1/2"-XW-HC-0528 (NEAR VES-FA-141)		0.192	0.204	0.196	0.19	0.196	0.200	2.25%*
		0.198	0.198	0.196	0.199	0.198	0.200	1.13%*
1"-XW-HC-0519		0.165	0.174	0.165	0.17	0.169	0.179	5.87%*
		0.168	0.167	0.167	0.17	0.168	0.179	6.15%*
		0.174	0.174	0.177	0.17	0.174	0.179	2.93%*
1"-XW-HC-0519		0.179	0.176	0.176	0.178	0.177	0.179	0.98%*
		0.175	0.181	0.177	0.177	0.178	0.179	0.84%*
		0.18	0.18	0.178	0.181	0.180	0.179	-0.42%*
4"-XW-AD-0529 (NEAR VES-FA-142)		0.211	0.221	0.227	0.221	0.220	0.237	7.17%*
		0.224	0.23	0.228	0.226	0.227	0.237	4.22%*

* NO REDUCTION BELOW NOMINAL, STILL WITHIN MANUFACTURER'S TOLERANCES

Form WINCO-7025
(10/92)

QUALITY INSPECTION REPORT

IR#: IR 93-052	SUBJECT: 2" XW-HC-1143 UT THICKNESS	ADDRESSEE: CRAIG L. PORTER
Page 1 of: 2	PROJECT EA#/WORK ORDER/PURCHASE ORDER: W.O. 151680	EQUIPMENT/SYSTEM/LOCATION: CPP666 RM -31' LEVEL N. WALL

OBSERVATION/DESCRIPTION:

THE ABOVE REFERENCED WORK ORDER REQUESTED ADDITIONAL ULTRASONIC THICKNESS MEASUREMENTS OF 2" XW-HC-1143 PIPING IN FAST TO SUPPORT FDP INTEGRITY ASSESSMENT.

ULTRASONIC THICKNESS MEASUREMENTS AND LOCATIONS ARE ANNOTATED ON THE ATTACHED DRAWING. THESE MEASUREMENTS ARE FOR ENGINEERING EVALUATION ONLY.

THE THICKNESSES WERE OBTAINED USING A PANAMETRICS MODEL 26DL THICKNESS TESTER SER.# 0121405 AND A 0.312", 5MHZ TRANSDUCER MODEL D971 SER.#109139. THE UNIT WAS CALIBRATED BEFORE AND AFTER USE, USING A 304L STEP WEDGE SER.# 0325, AND A HAST.,C4 STEP WEDGE SER.# 704104 AND 704105.

INSPECTOR/DATE: <i>DK Kluge</i> 4-19-93	SUPERVISOR/DATE: <i>[Signature]</i> 4/19/93
--	--

ADDRESSEE RESPONSE REQUIRED: <input type="checkbox"/> YES <input checked="" type="checkbox"/> NO	DISTRIBUTION: ADDRESSEE QE FILE J.ROBERTS CRAIG PORTER
---	--


ADDRESSEE REMARKS/RESPONSE:

NCR REQUIRED: <input type="checkbox"/> YES <input type="checkbox"/> NO	(ADDRESSEE/RESPONDER) NAME/DATE:
DISTRIBUTION: INSPECTOR	



LOC TOP RIGHT BOT. LEFT

LOC	TOP	RIGHT	BOT.	LEFT
1	.340	.358	.355	.355
2	.142	.103	.085	.092
3	.142	.134	.081	.143
4	.146	.123	.085	.095
5	N/A	.224	.225	.241
6	N/A	.235	.224	.237
7	N/A	.239	.224	.239
8	N/A	.231	.229	.230
9	.221	.218	.218	.221
10	.217	.223	.220	.215
11	.221	.228	N/A	.246
12	.222	.232	N/A	.240
13	N/A	.247	N/A	.241

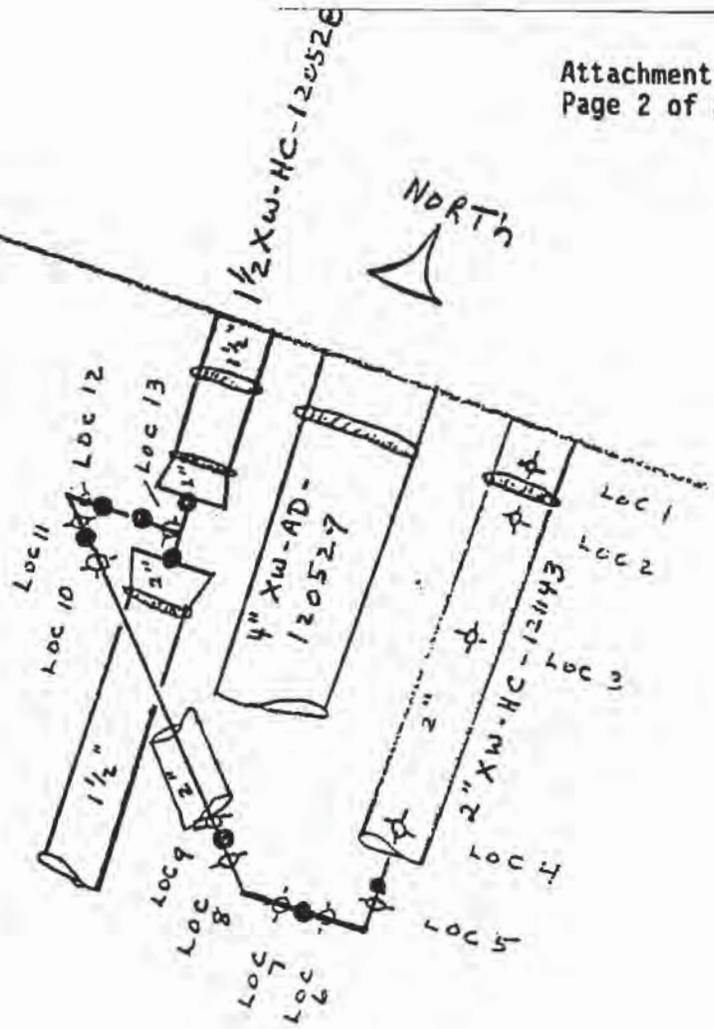

FDP IN-CELL SUMP

